

O.D.O.T. DISTRICT 2 SURVEY OFFICE (USE ONLY)

PERSONNEL _____ REFERENCE NO. 12 AA SHEET 7 OF 26

NOTES RHOADES _____ DATE 5/1/18 ROUTE SR 108
 H.C. O'DONNELL _____ WEATHER SUNNY COUNTY FULTON
 R.C. SEAMAN _____ TEMP. 63° TOWNSHIP DOVER
 _____ SECTION 2
 _____ T 7 N R 6 E

TYPE MONUMENT MAG/WASHER


ON SURFACE - ~~BELOW~~ ON _____

~~LEFT~~ - CL PAV'T - ~~RIGHT~~ ON _____

12.1' TO LT EDGE PAVEMENT


S.L.M. 435+77

GPS: NORTHING: 708449.074 EASTING: 1517519.340

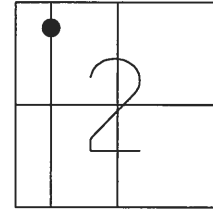

12AA TO 12= 269.61"

RECORD:
 FD SM. R.R. SPIKE
 5-12-92
 SET P.K./WASHER
 9-16-93
 SET MAG/WASHER
 10-30-07, BWC
 FD MAG/NAIL
 REFAB12
 1-30-17, JFO
 SET MAG/WASHER
 8-7-18, JFO

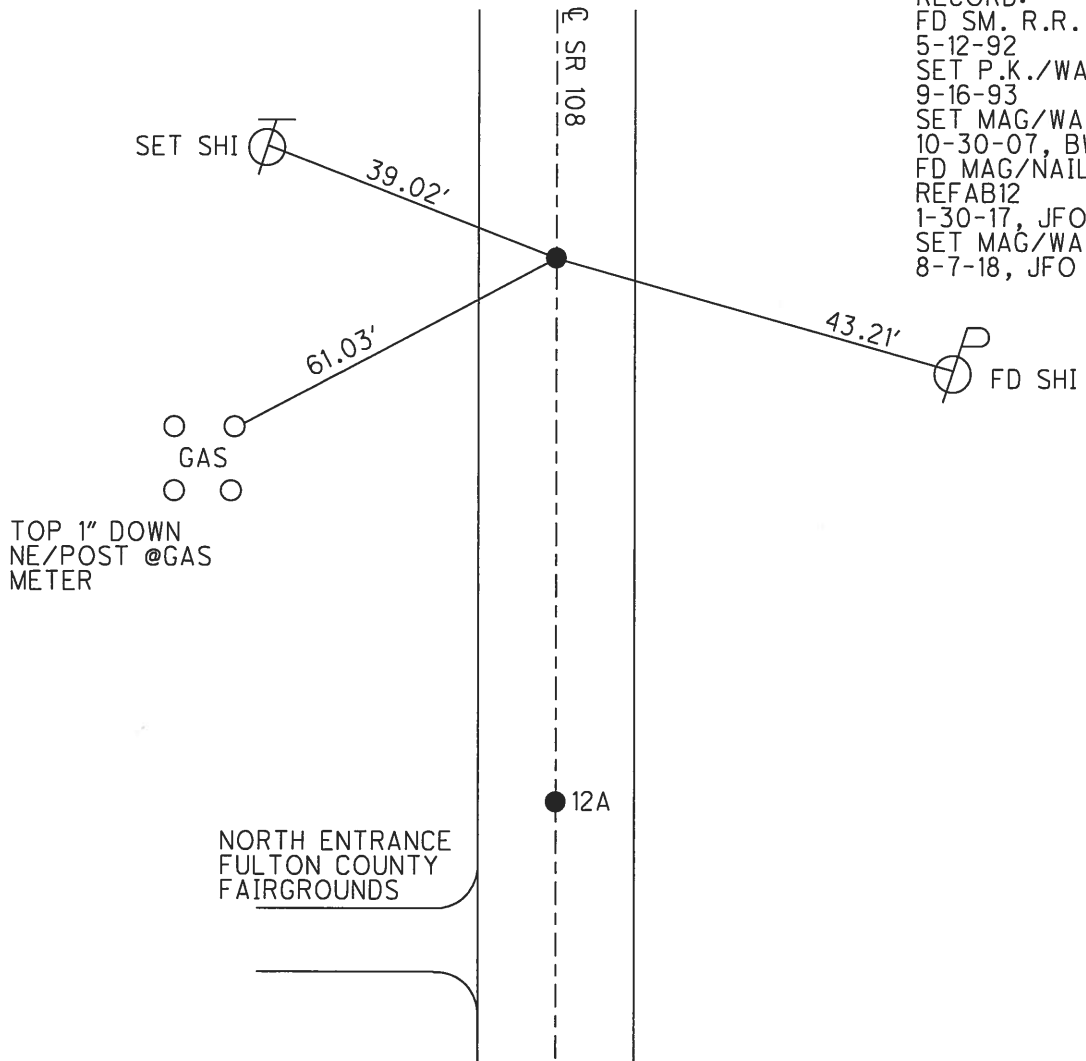


NORTH ENTRANCE
 FULTON COUNTY
 FAIRGROUNDS

O.D.O.T. DISTRICT 2 SURVEY OFFICE (USE ONLY)


PERSONNEL _____ REFERENCE NO. 12 AA SHEET 5 OF 22
 NOTES HOMAN DATE 6/18/07 ROUTE SR 108
 H.C. CORDES WEATHER SUNNY COUNTY FULTON
 R.C. VIETH TEMP. 90° TOWNSHIP DOVER
 _____ SECTION 2
 _____ T 7 N R 6 E

TYPE MONUMENT P.K./WASHER
 ON SURFACE - ~~BELOW~~ ON _____
~~LEFT~~ - C PAV'T - ~~RIGHT~~ ON _____
12.1' TO LT EDGE PAVEMENT
 S.L.M. 435+77
 GPS: NORTHING: 708449.089 EASTING: 1517519.333

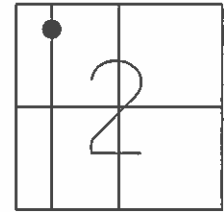

FD. SM RR SPK
5-12-92

SET PK/WASHER
9-16-93
SET MAG/WASHER
10-30-07, BWC

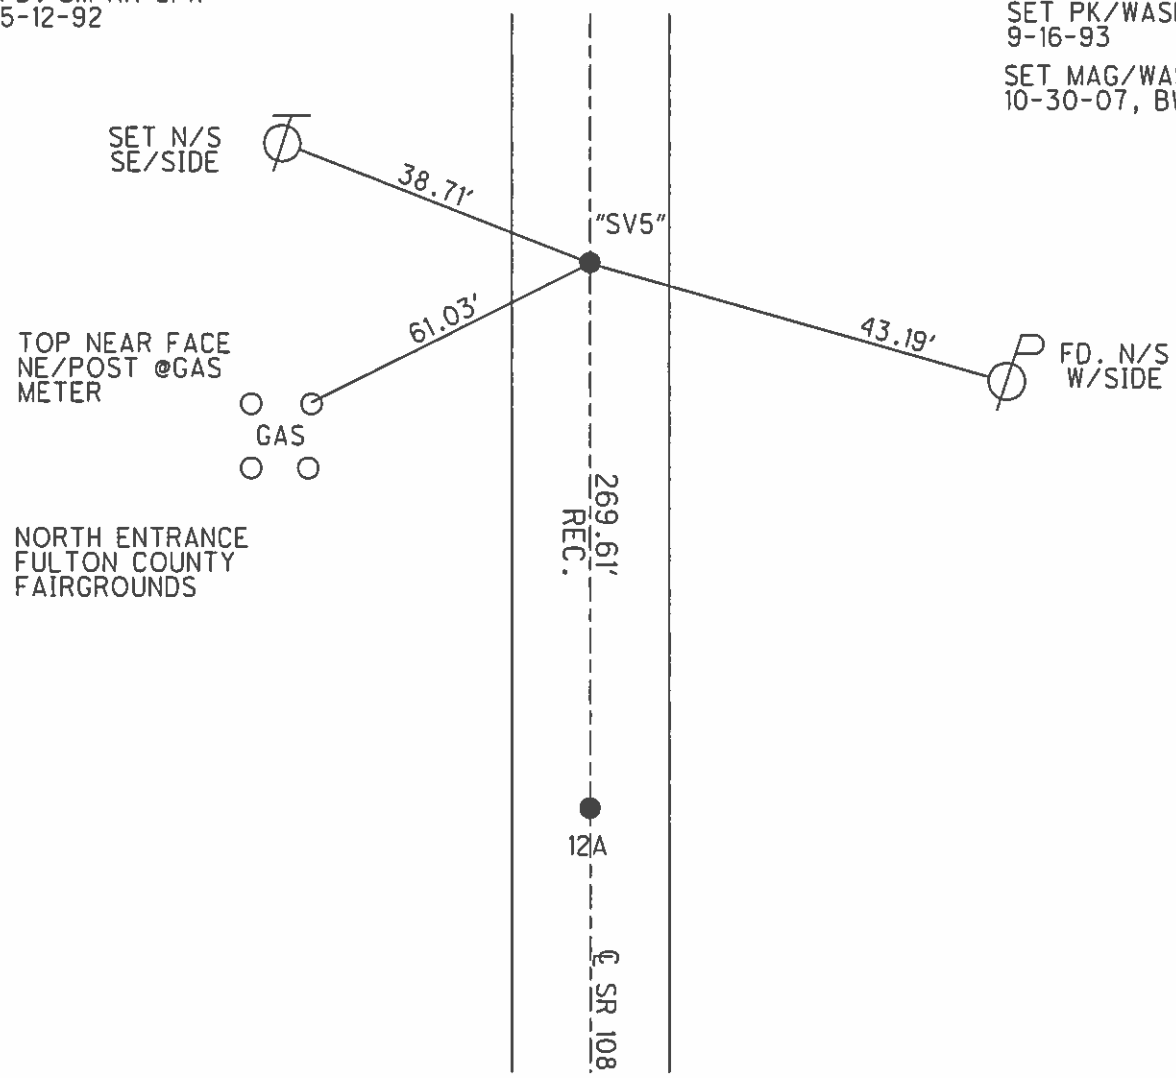

NORTH ENTRANCE
FULTON COUNTY
FAIRGROUNDS



O.D.O.T. DISTRICT 2 SURVEY OFFICE

PERSONNEL

REFERENCE NO. 12A

SHEET 4 OF 11

NOTES LOEHRKE

H.C. CURTIS

DATE 5-12-92

ROUTE 108

R.C. ROMETO

WEATHER CLEAR

COUNTY FULTON

TEMP. +75

TOWNSHIP DOVER

SECTION 2

Set. P.K. / WASHER

T. 7 N. R. 6 E


TYPE MONUMENT A - Sm R.R. Spike B - P.K. WASHER

ON SURFACE - ~~BELOW~~ Yes


LEFT - 0 PAV'T. - RIGHT 0.3' Rt

12.1 TO Rt EDGE PAVEMENT

S.L.M. 433+07 & 435+77

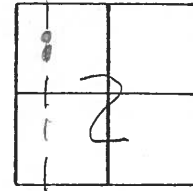

1/4 mile South C.R. 5"

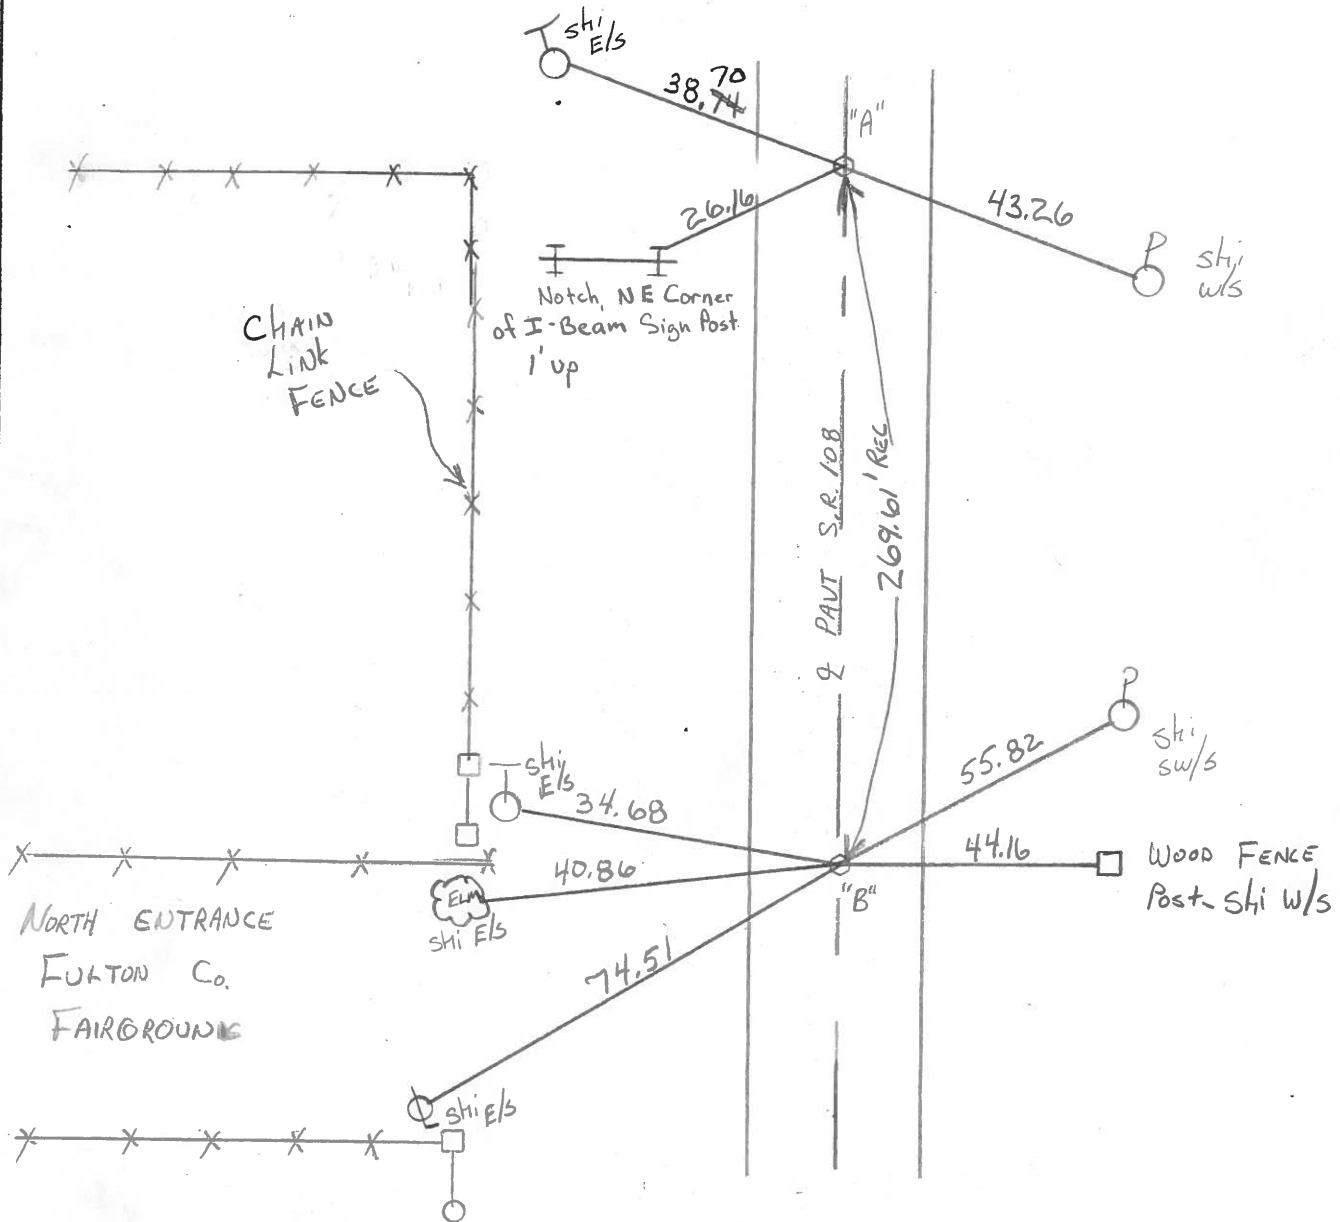

County FULTON S.R. 108

Date 4-8-82

Township DOVER

Weather cloudy

Section 2


Temp. +40°

TIN, R6E


Personnel Hoffman

Crew

12-A

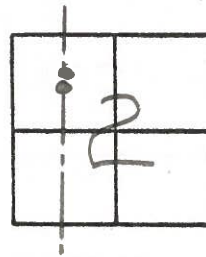

1/4 mile S. of Co. Rd. J = "A" = 3/4" I.D. PIPE 0.15' Below Surface, Project Stat 435+74
 12.0 TO W.E.P.
 12.2 TO E.E.P.
 "B" = P.K. Rd. 0.11' Below Surface.
 12.2' TO W.E.P.
 12.2' TO E.E.P.

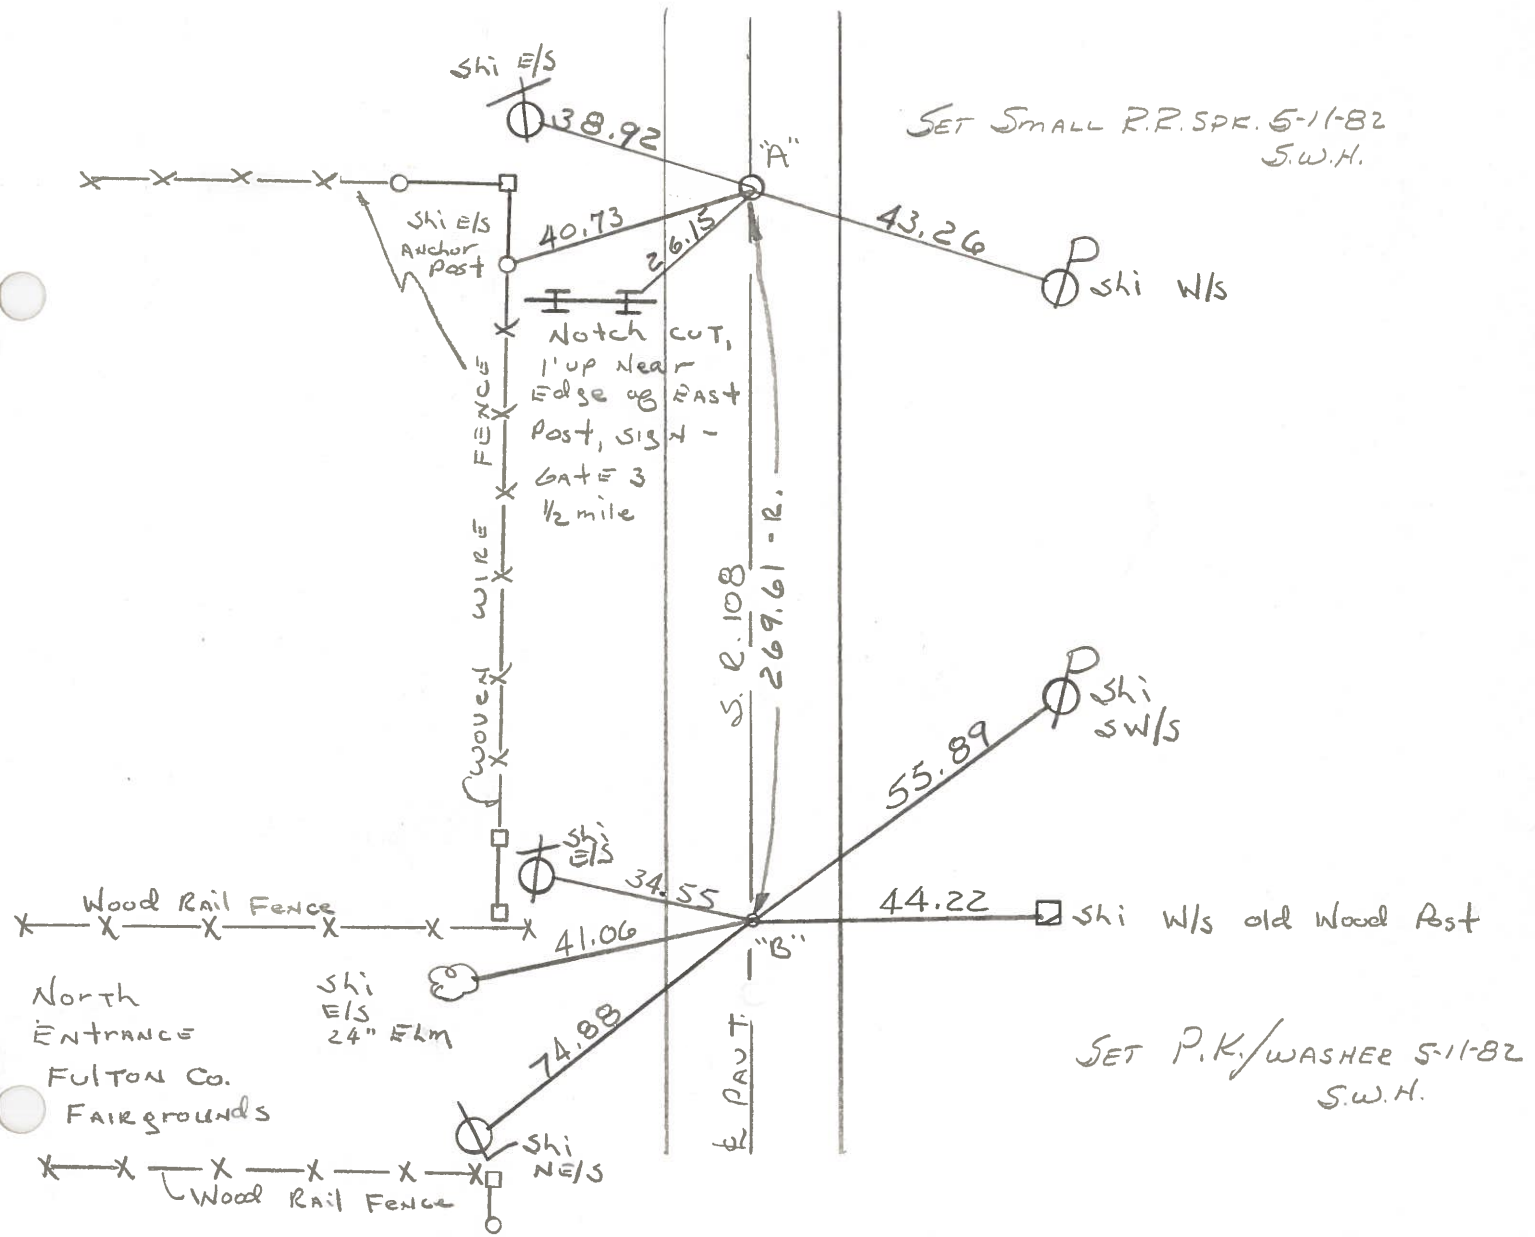

SET SMALL P.R. SPR. 5-11-82 S.W.H.

SET P.K./WASHER 5-11-82 S.W.H.

North Entrance
 FULTON Co.
 FAIRGROUNDS