

O.D.O.T. DISTRICT 2 SURVEY OFFICE (USE ONLY)


PERSONNEL _____ REFERENCE NO. 15 SHEET 13 OF 26

NOTES RHOADES _____ DATE 5/1/18 ROUTE SR 108
 H.C. O'DONNELL _____ WEATHER SUNNY COUNTY FULTON
 R.C. SEAMAN _____ TEMP. 63° TOWNSHIP DOVER
 _____ SECTION 35
 _____ T 8 N R 6 E

TYPE MONUMENT HARROW TOOTH SPIKE W/DIMPLE
 ON SURFACE - ~~BELOW~~ ON
~~LEFT~~ - ℄ PAV'T - RIGHT 50.6'
 _____ TO _____ EDGE PAVEMENT


S.L.M. 501+32

GPS NORTHING: 715003.259 GPS EASTING: 1517670.835

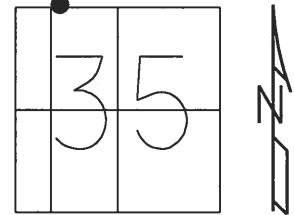

RECORD: P.I.
 STA. 215+19.10
 1941 PLAN
 FD HARROW TOOTH SPIKE
 5-12-92
 FD HARROW TOOTH SPIKE
 10-30-07, BWC
 FD HARROW TOOTH SPIKE
 REF15
 1-27-17, JFO
 NOT COVERED
 8-7-18, JFO


15 TO NAIL/SHI = 22.91'

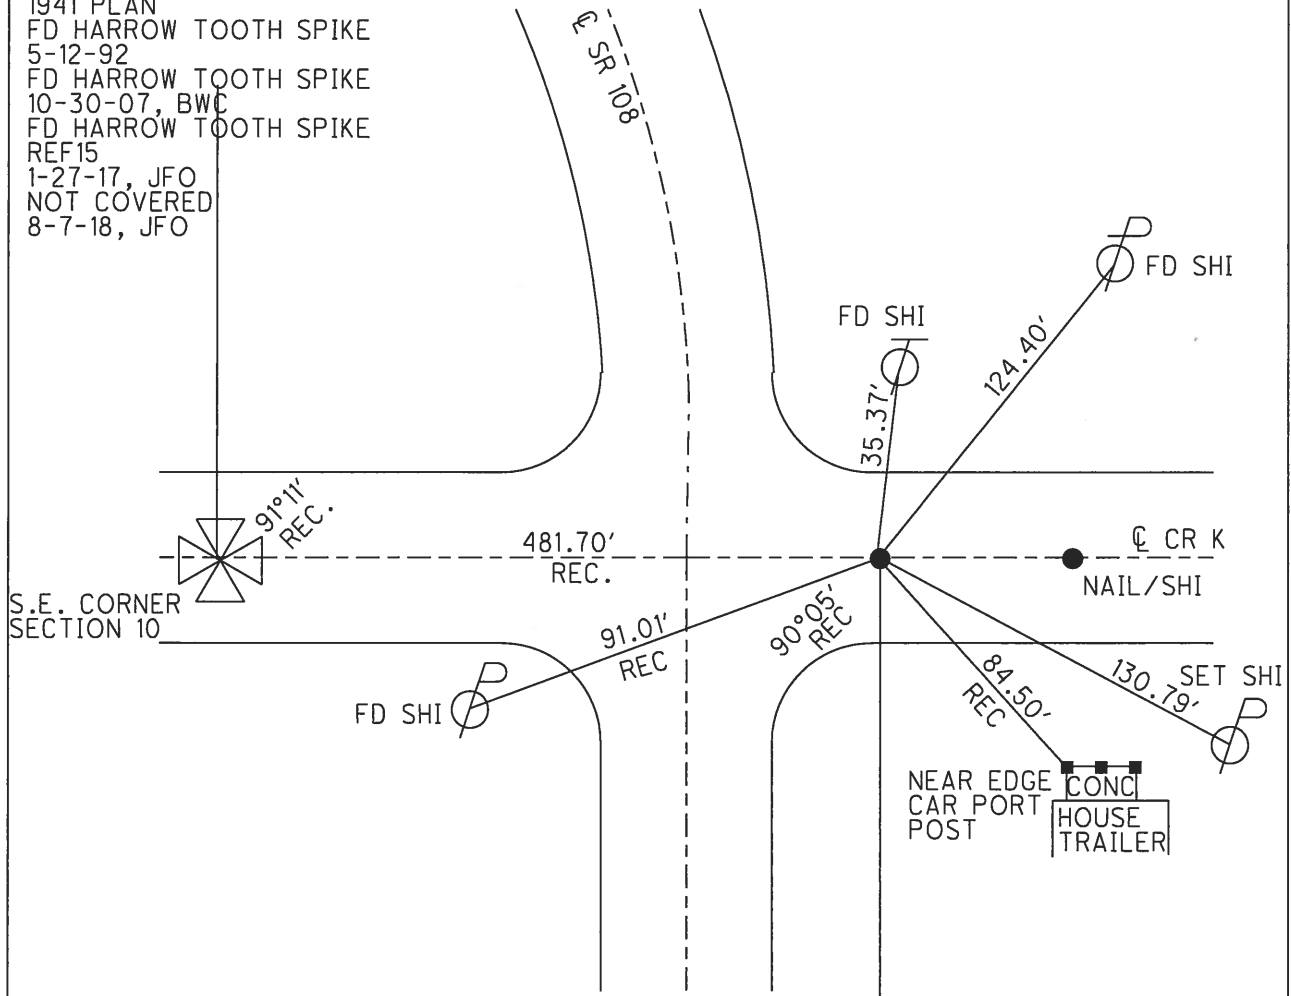

O.D.O.T. DISTRICT 2 SURVEY OFFICE (USE ONLY)

PERSONNEL _____ REFERENCE NO. 15 SHEET 11 OF 22
 NOTES CORDES DATE 6/19/07 ROUTE SR 108
 H.C. HOMAN WEATHER CLOUDY/RAIN COUNTY FULTON
 R.C. VIETH TEMP. 78° TOWNSHIP DOVER
 _____ SECTION 35
 _____ T 8 N R 6 E


TYPE MONUMENT HARROW TOOTH SPIKE
 ON SURFACE - ~~BELOW~~ ON
~~LEFT - C PAVT~~ - RIGHT 50.6'
 - TO - EDGE PAVEMENT
 S.L.M. 501+32
 GPS NORTHING: 715003.239 GPS EASTING: 1517670.769

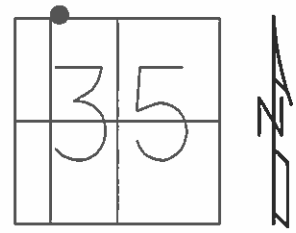

FD. HARROW TOOTH SPK.
5-12-92

NOTE: RECORD PI 215+19.10
1941 PLAN

FD. HARROW TOOTH SPK.
10-30-07 BWC

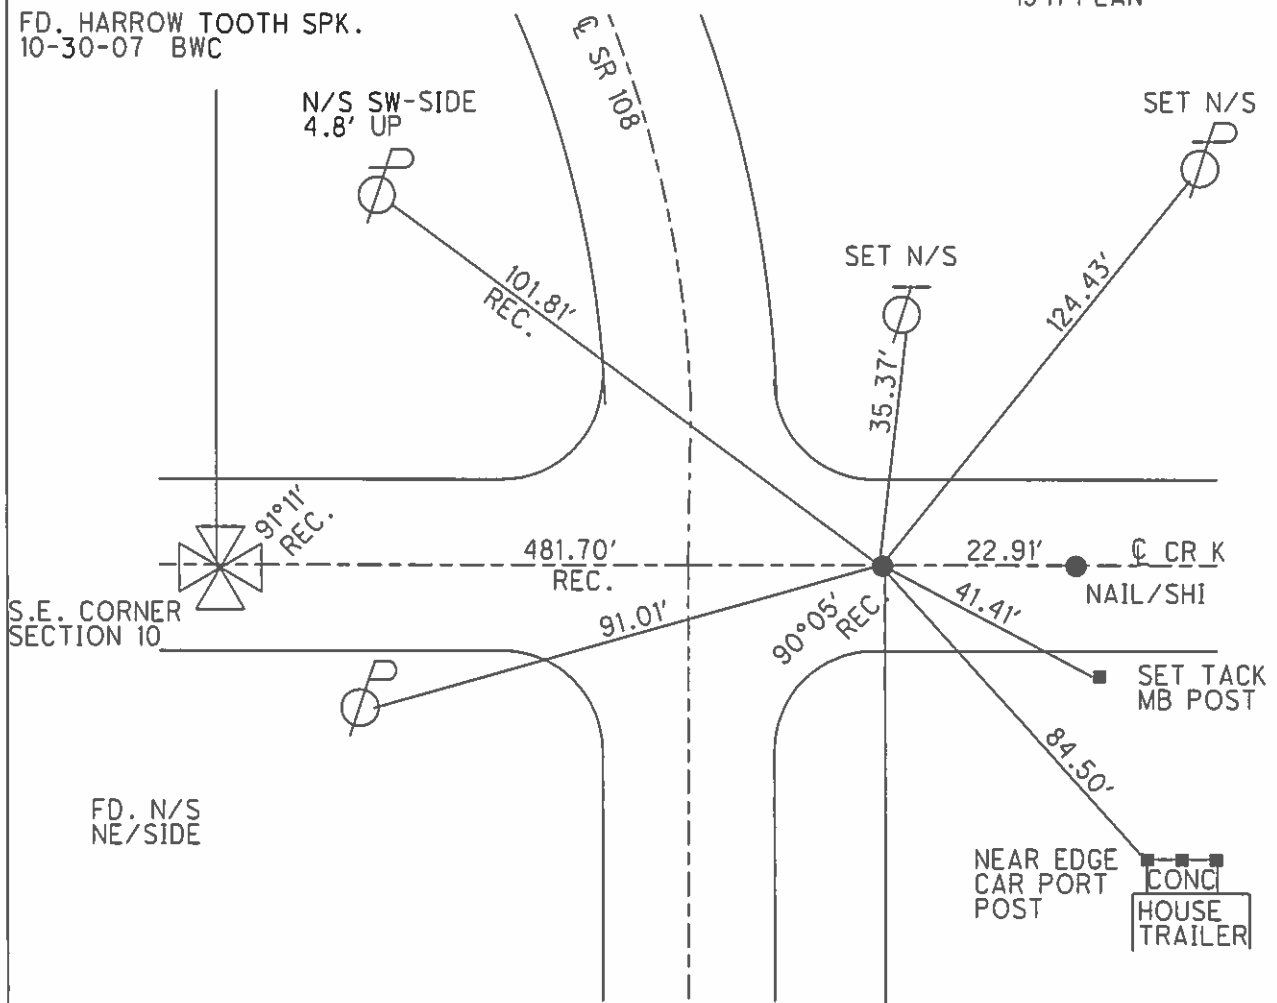

O.D.O.T. DISTRICT 2 SURVEY OFFICE

PERSONNEL

REFERENCE NO. 15

SHEET 9 OF 11

NOTES LOEHRKE

H.C. CURTIS

R.C. ROMETO

DATE 5-12-92

WEATHER CLEAR

TEMP. +80

ROUTE S.R. 108

COUNTY FULTON

TOWNSHIP DOVER

SECTION 35

T.B.N.R. 6 E


TYPE MONUMENT HARROW Tooth Spike

ON SURFACE - ~~BELOW~~ Yes

~~LEFT~~ - PAV'T. - RIGHT 50.6

TO EDGE PAVEMENT

S.L.M. 50/432

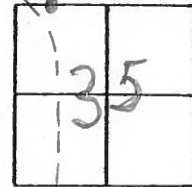

P.I. Sta 215+19.10
RECORD 1941 PLAN

