

O.D.O.T. DISTRICT 2 SURVEY OFFICE (USE ONLY)

PERSONNEL _____ REFERENCE NO. 17 SHEET 17 OF 26

NOTES RHOADES _____ DATE 5/1/18 ROUTE SR 108
 H.C. O'DONNELL _____ WEATHER WIND COUNTY FULTON
 R.C. SEAMAN _____ TEMP. 79° TOWNSHIP DOVER
 _____ SECTION 2
 _____ T 10 S R 2 E

TYPE MONUMENT MAG/WASHER


ON SURFACE - ~~BELOW~~ ON

~~LEFT~~ - CL PAV'T - RIGHT 1.0'


- TO - EDGE PAVEMENT

S.L.M. 550+98

GPS NORTHING: 719888.123 GPS EASTING: 1517172.064

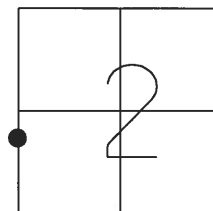


RECORD:
 FD R.R. SPIKE
 10-21-86
 SET SM. R.R. SPIKE
 5-21-87
 SET MAG/WASHER
 11-06-07, BWC
 FD MAG/WASHER
 REF17
 1-27-17, JFO
 SET MAG/WASHER
 8-7-18, JFO

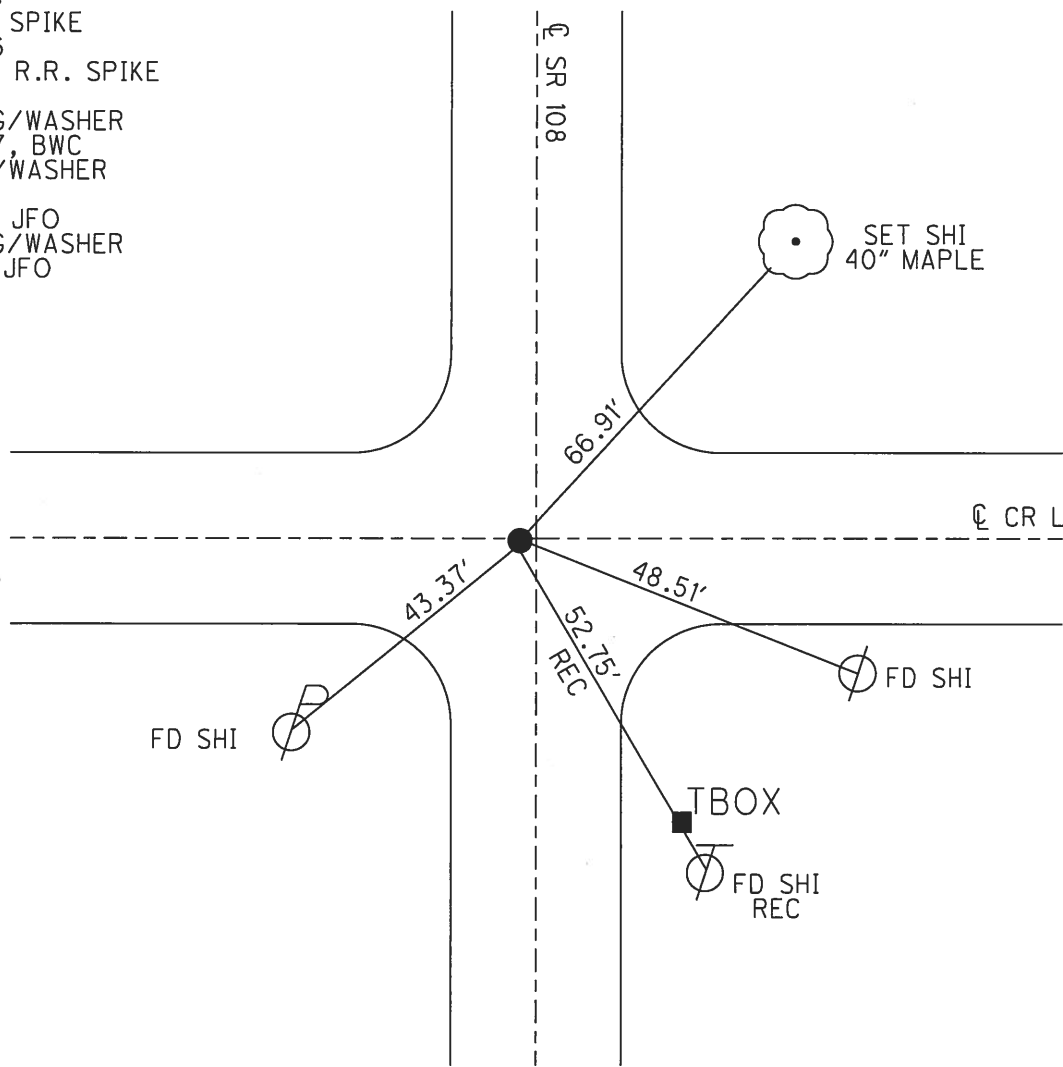


O.D.O.T. DISTRICT 2 SURVEY OFFICE (USE ONLY)

PERSONNEL _____ REFERENCE NO. 17 SHEET 15 OF 22
 NOTES CORDES DATE 6/19/07 ROUTE SR 108
 H.C. HOMAN WEATHER SUNNY COUNTY FULTON
 R.C. VIETH TEMP. 80° TOWNSHIP DOVER
 SECTION 2
 T 10 S R 2 E

TYPE MONUMENT SM.R.R.SPIKE
 ON SURFACE - ~~BELOW~~ ON _____
 LEFT - ~~C PAV'T~~ - RIGHT 1.5'
 - TO - EDGE PAVEMENT
 S.L.M. 550+98
 GPS NORTHING: 719888.083 GPS EASTING: 1517172.011

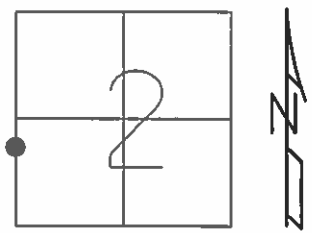

FD. RR.SP.K.
 10-21-86
 SET SM RR SPK
 5-21-87
 SET MAG/WASHER
 11-06-07 BWC

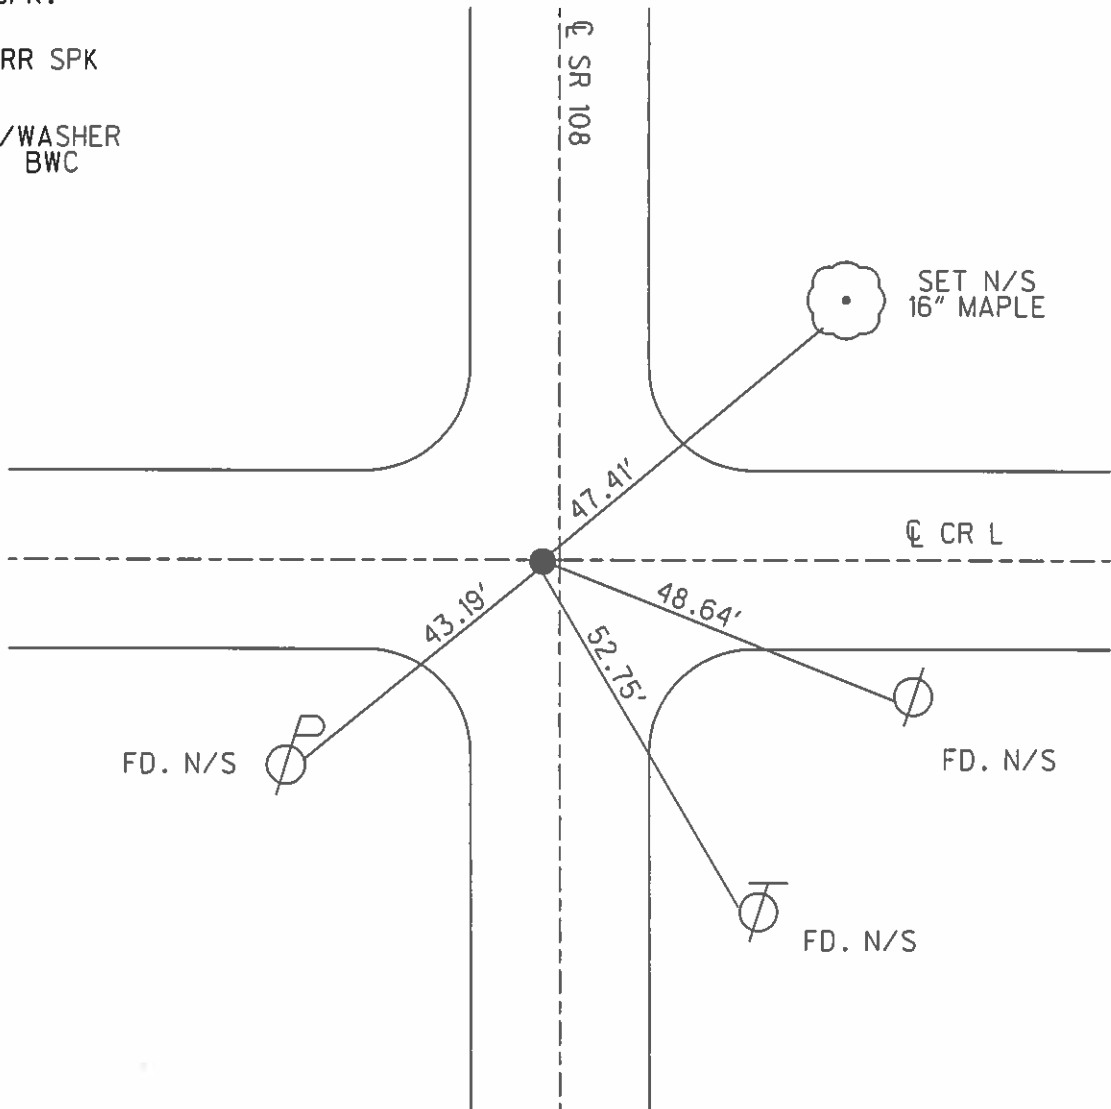

O.D.O.T. DISTRICT 2 SURVEY OFFICE

PERSONNEL

REFERENCE NO. 17

SHEET 2 OF

NOTES 1. Stone

H.C. D. Curtis

R.C. J. Householder

DATE 21 Oct. 86

WEATHER Cloudy

TEMP. 47.0

ROUTE SR#108

COUNTY Fulton

TOWNSHIP Dover

SECTION 2

T. R.


TYPE MONUMENT R.R. Spk.

ON SURFACE - BELOW 1" deep

LEFT - & PAV'T. - RIGHT

TO EDGE PAVEMENT

S.L.M. 550+76

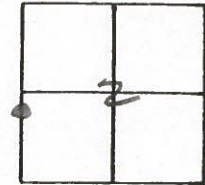

Set Small R.R. Spk. To Surface
5-21-87

