

O.D.O.T. DISTRICT 2 SURVEY OFFICE (USE ONLY)

PERSONNEL

REFERENCE NO. 23

SHEET 3 OF 6

NOTES LEU
 H.C. HOMAN
 R.C. LEU

DATE 4/15/16
 WEATHER SUNNY
 TEMP. 65°

ROUTE SR 108
 COUNTY FULTON
 TOWNSHIP CHESTERFIELD
 SECTION 20
 T 9 S R 2 E

DWG BY NIESE PID PAVETRAIN

TYPE MONUMENT MAG/WASHER

ON SURFACE - ~~BELOW~~ ON

OFFSET C PAVEMENT ON LT : RT

10.4' TO LT EDGE PAVEMENT 3.0' N OF C CR S


STATION: 901+33

HORZ. DATUM: NAD83(2011)


GEOID: NAVD88 2012A

GRID: NORTHING: 738953.833

EASTING: 1501195.958

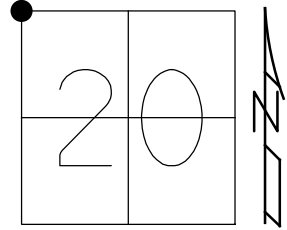

RECORD:
 FD P.K./WASHER
 5/6/04, DCH
 SET MAG/WASHER
 6/2/04, RGN
 FD MAG/WASHER
 4/15/16, DCH
 FD MAG NAIL
 REF23
 6/16/21
 9/17/21, TDN

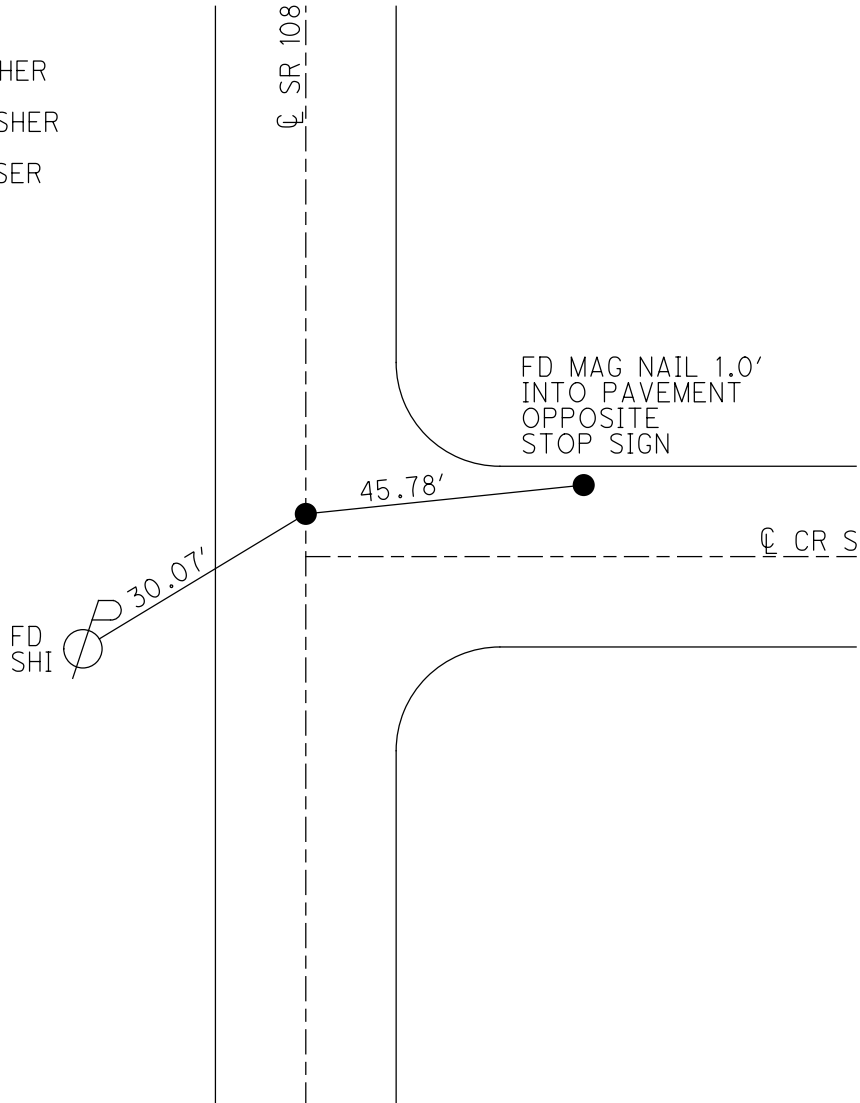

O.D.O.T. DISTRICT 2 SURVEY OFFICE (USE ONLY)

PERSONNEL _____ REFERENCE NO. 23 SHEET 4 OF 7

NOTES LEU DATE 04-15-2016 ROUTE SR 108
 H.C. HOMAN WEATHER SUNNY COUNTY FULTON
 R.C. LEU TEMP. 65°F TOWNSHIP CHESTERFIELD
 SECTION 20
T 9 S R 2 E


TYPE MONUMENT MAG/WASHER

ON SURFACE - ~~BELOW~~ ON

~~LEFT~~ - Q PAV'T ~~RIGHT~~ ON, 3' N OF Q CR S


10.4' TOLT EDGE PAVEMENT

S.L.M. 901+33

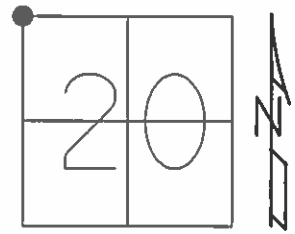

GRID: NORTHING: 738953.868 EASTING: 1501195.971

RECORD:
 FD P.K./WASHER
 5/6/04, DCH
 SET MAG/WASHER
 6/2/04, RGN
 FD MAG/WASHER
 REF23
 4/15/16, DCH

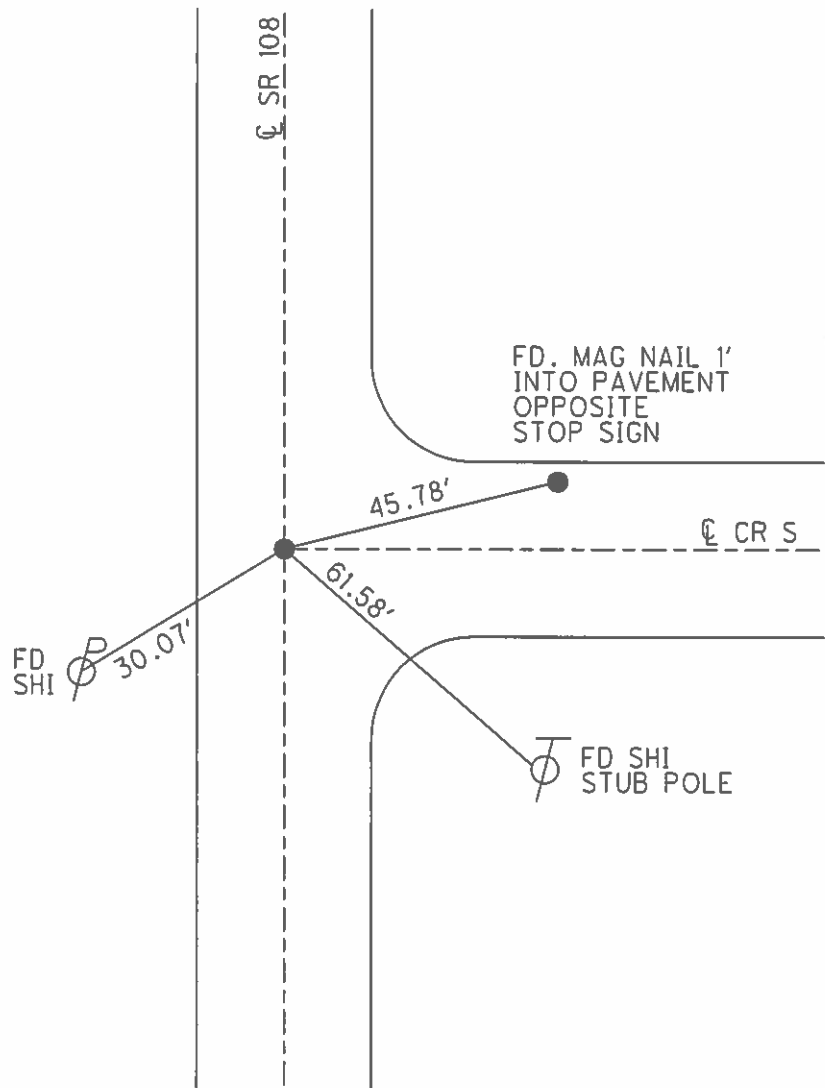

O.D.O.T. DISTRICT 2 SURVEY OFFICE

PERSONNEL

REFERENCE NO. 23

SHEET 4 OF 7

NOTES HUSS

DATE 5-06-04

ROUTE SR 108

H.C. HOMAN

WEATHER SUNNY

COUNTY FULTON

R.C. HOOKER

TEMP. 67°

TOWNSHIP CHESTERFIELD

SECTION 17-18-19-20

T 9 S R 2 E



TYPE MONUMENT PK & WASHER

ON SURFACE - ~~BELOW~~ ON

~~LEFT~~ - Q PAV'T - ~~RIGHT~~ ON


10.4' TO LT EDGE PAVEMENT

S.L.M. 901+33

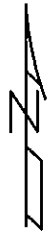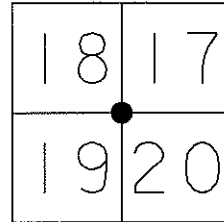

3' N OF Q CRS

SET MAG NAIL
& WASHER
6-02-04
RGN

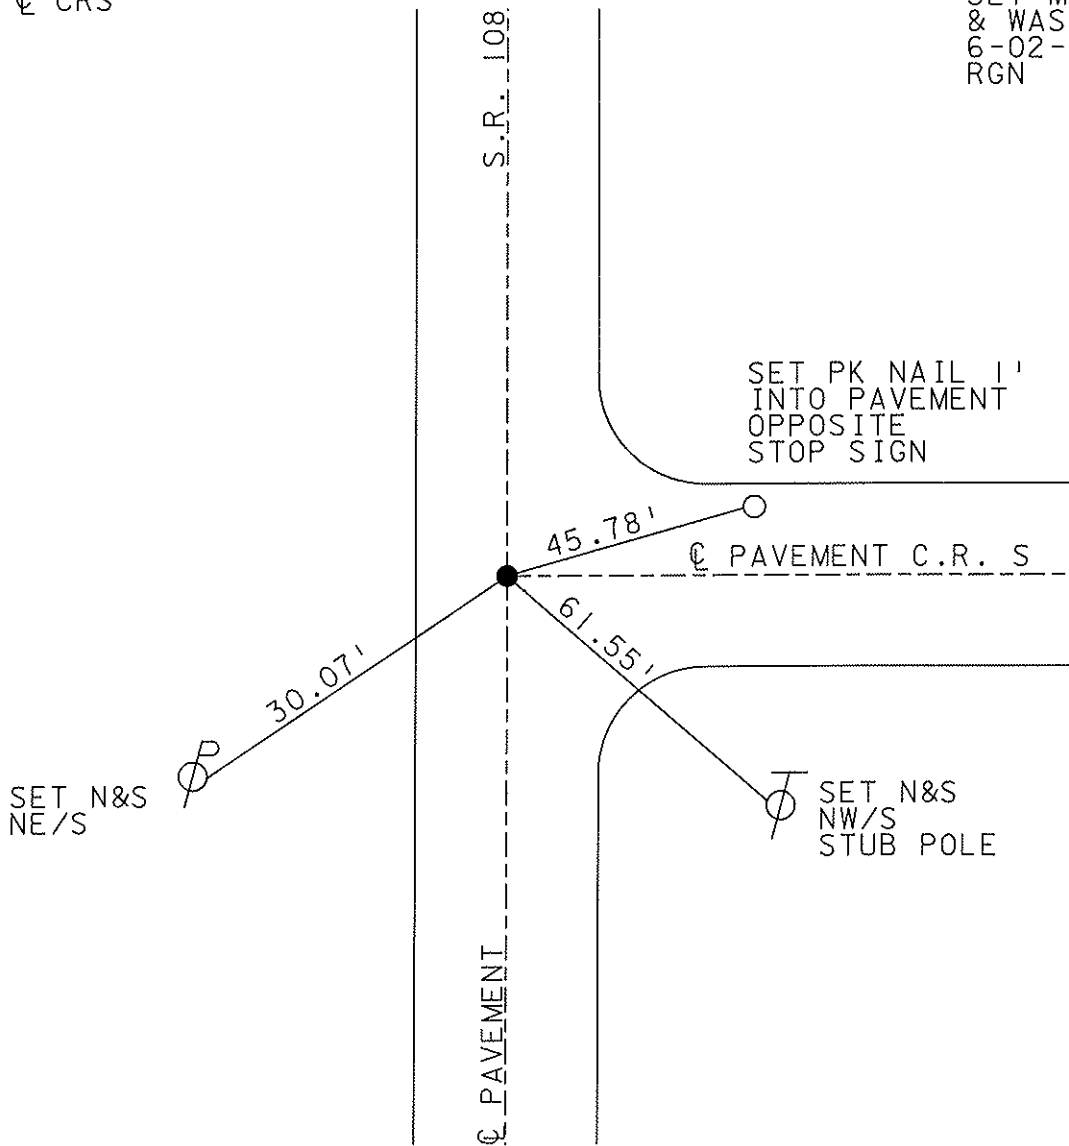

O.D.O.T. DISTRICT 2 SURVEY OFFICE

PERSONNEL _____

REFERENCE NO. 23

SHEET 3 OF 6

NOTES D. CURTIS

H.C. J. HOUSEHOLDER

DATE 5-31-88

ROUTE S.R. #108

R.C. _____

WEATHER WARM

COUNTY FULTON

TEMP. 90° ±

TOWNSHIP CHESTERFIELD

SECTION 17-18-19-20

T _____ R _____

TYPE MONUMENT P.K. NAIL


ON SURFACE - BELOW ON SURFACE

LEFT - PAV'T. - RIGHT PAV'T.

10.4 TO W EDGE PAVEMENT

S.L.M. 901 + 33

18	17
19	20

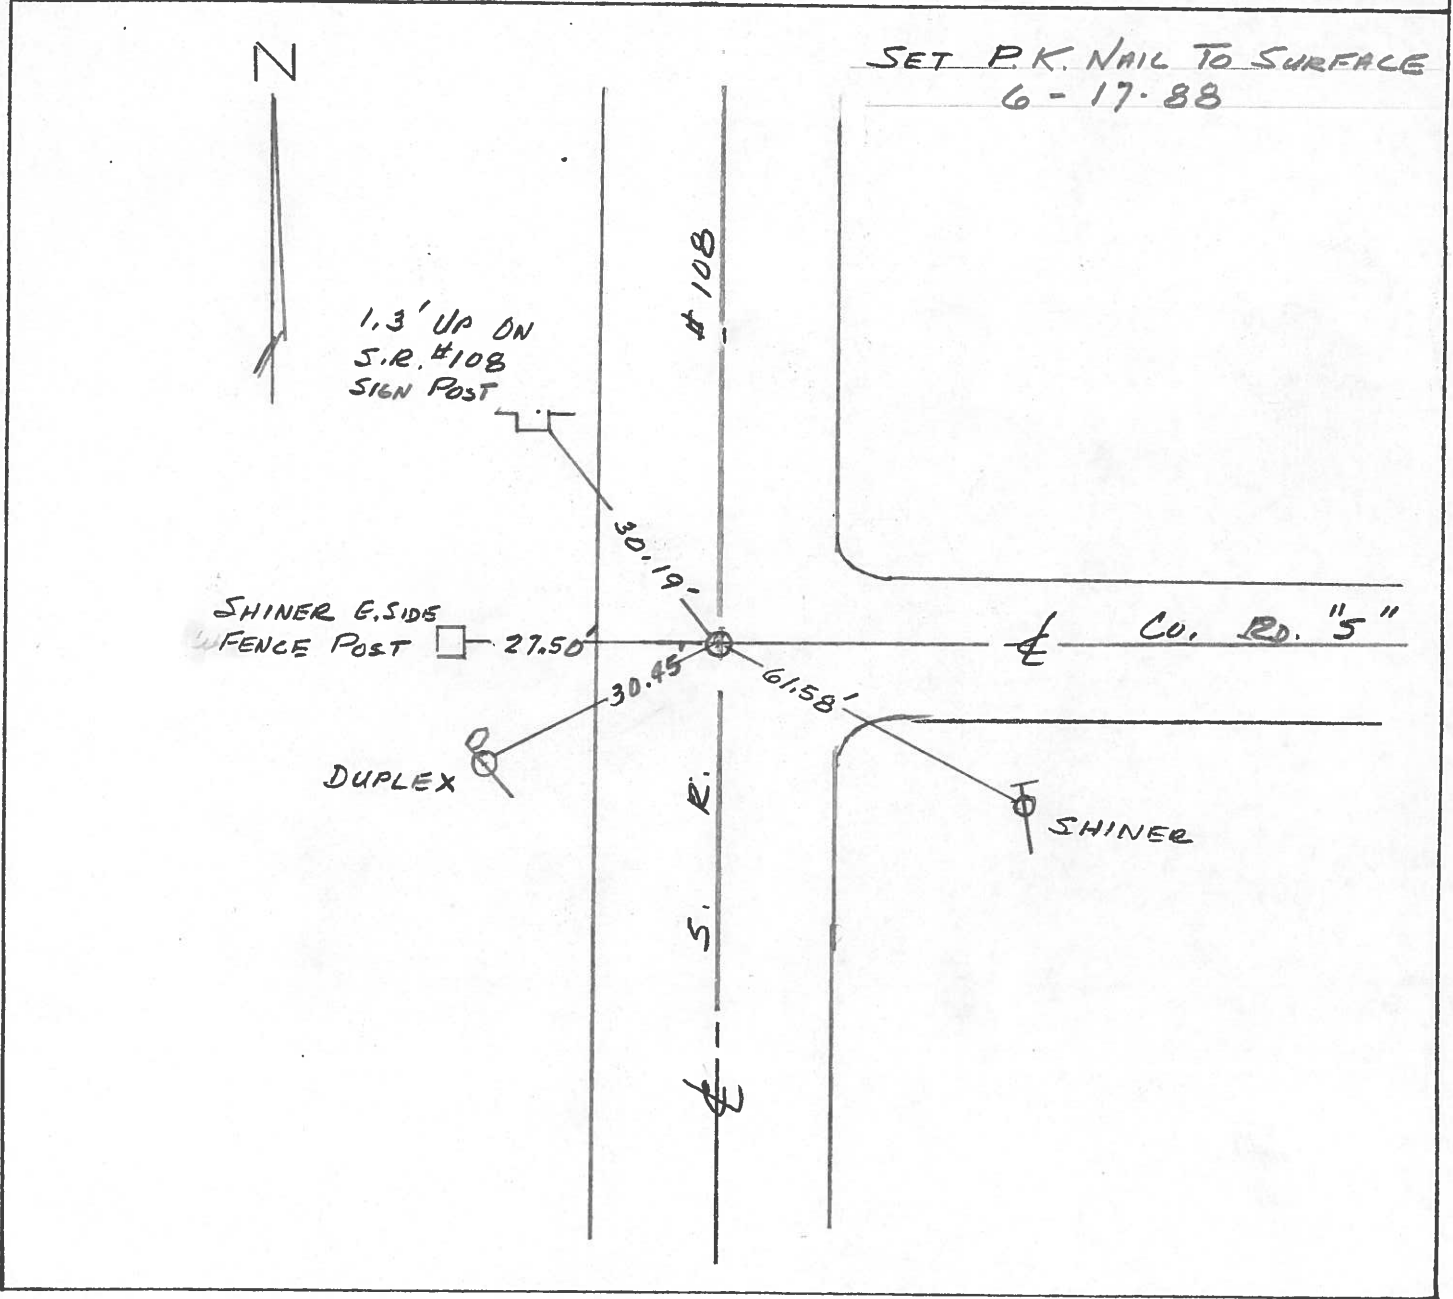

ODOT. DISTRICT 2 SURVEY OFFICE

SHEET 3 OF

County Fulton S.R. 108

Date 11 May 81

Township Chesterfield

Weather Cloudy

Section 17-18-19-20

Temp. 45°

T_N, R_E

Personnel I. Stone


P. Neuser

D. Curtis

18	17
19	20



REF. No. 23

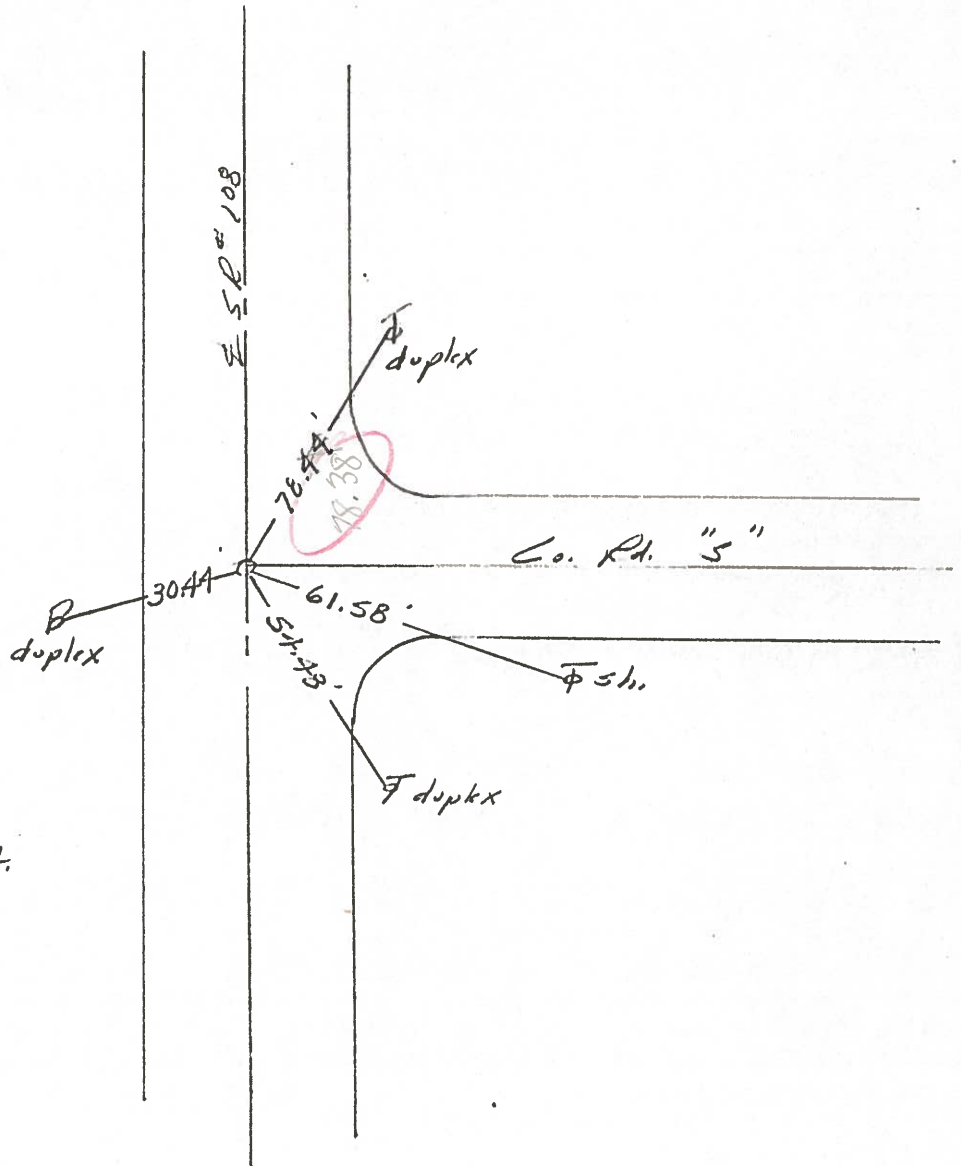

Ed. 1" Square Bolt
To Surface

~~10.4~~ to w. edge put.

12.6

Set P.K.

O.D.O.T. DISTRICT 2 SURVEY OFFICE

SHEET 3 OF

County Fulton S.R. 108

Township Chesterfield

Section 17-18-19-20

T N, R E

Personnel I. Stone

P. Neuser

D. Curtis

Date OK 6-1-81 SW.H.
11 May 81


Weather Cloudy

Temp. 75°

18	17
19	20



REF. No. 23

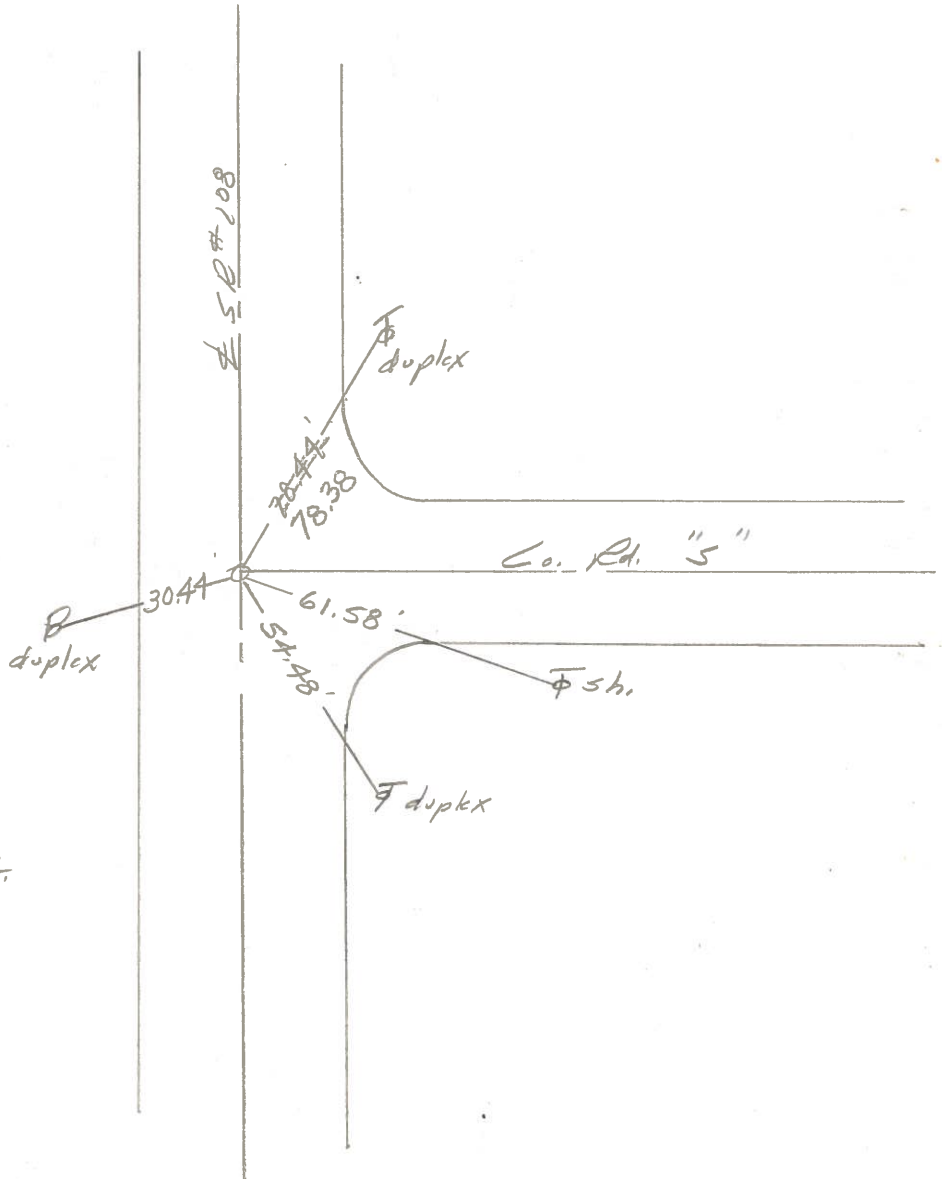

RE. SET P.K. NAIL

Ed. 1" Square Bolt
To Surface

10.4' to w. edge put.
12.6