

O.D.O.T. DISTRICT 2 SURVEY OFFICE (USE ONLY)

PERSONNEL

REFERENCE NO. 24

SHEET 4 OF 6

NOTES NIESE

DATE 9/17/21

ROUTE SR 108

H.C. AUBLE

WEATHER SUNNY

COUNTY FULTON

R.C. NIESE

TEMP. 60°

TOWNSHIP CHESTERFIELD

DWG BY NIESE PID PAVETRAIN

SECTION 17

T 9 S R 2 E

TYPE MONUMENT MAG SHANK

ON SURFACE - ~~BELOW~~ ON

OFFSET \varnothing PAVEMENT 0.5' LT : ~~RT~~

9.5' TO LT EDGE PAVEMENT


STATION: 928+12

HORZ.DATUM: NAD83(2011)


GEOID: NAVD88 2012A

GRID: NORTHING: 741614.197

EASTING: 1501417.617

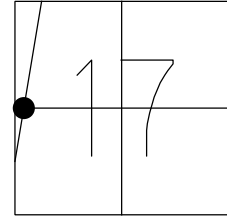

RECORD:
 FD P.K. NAIL
 5/6/04, DCH
 SET MAG/WASHER
 6/2/04, RGN
 FD MAG/WASHER
 4/15/16, DCH
 FD MAG/WASHER
 REF24
 6/16/21
 FD MAG SHANK
 9/17/21, TDN

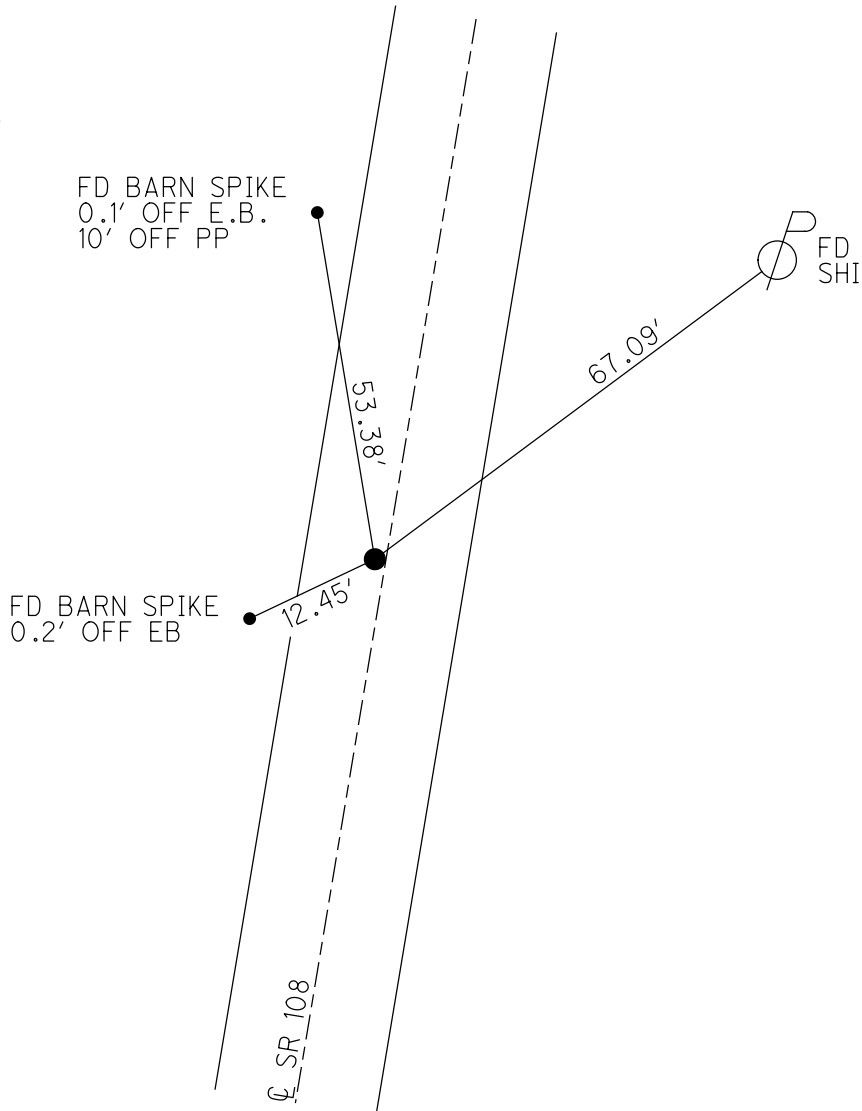


O.D.O.T. DISTRICT 2 SURVEY OFFICE (USE ONLY)

PERSONNEL _____ REFERENCE NO. 24 SHEET 5 OF 7

NOTES LEU DATE 4/15/16 ROUTE SR 108
 H.C. HOMAN WEATHER SUNNY COUNTY FULTON
 R.C. LEU TEMP. 65° TOWNSHIP CHESTERFIELD
 _____ SECTION 17
 _____ T 9 S R 2 E

TYPE MONUMENT MAG/WASHER
~~ON SURFACE~~ BELOW ON
 LEFT - ~~C PAV'T~~ RIGHT 0.5'
9.5' TOLT EDGE PAVEMENT
 S.L.M. 928+12

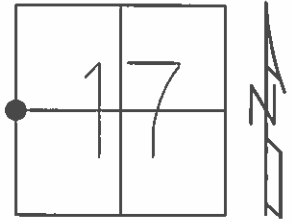


GRID: NORTHING: 741614.234 EASTING: 1501417.650

RECORD:
 FD P.K.NAIL
 5/6/04, DCH
 SET MAG/WASHER
 6/2/04, RGN
 FD MAG/WASHER
 REF24
 4/15/16, DCH

SET BARN SPIKE
 0.1' OFF E.B.
 10' OF PP

SET BARN SPIKE
 0.2' OFF EB

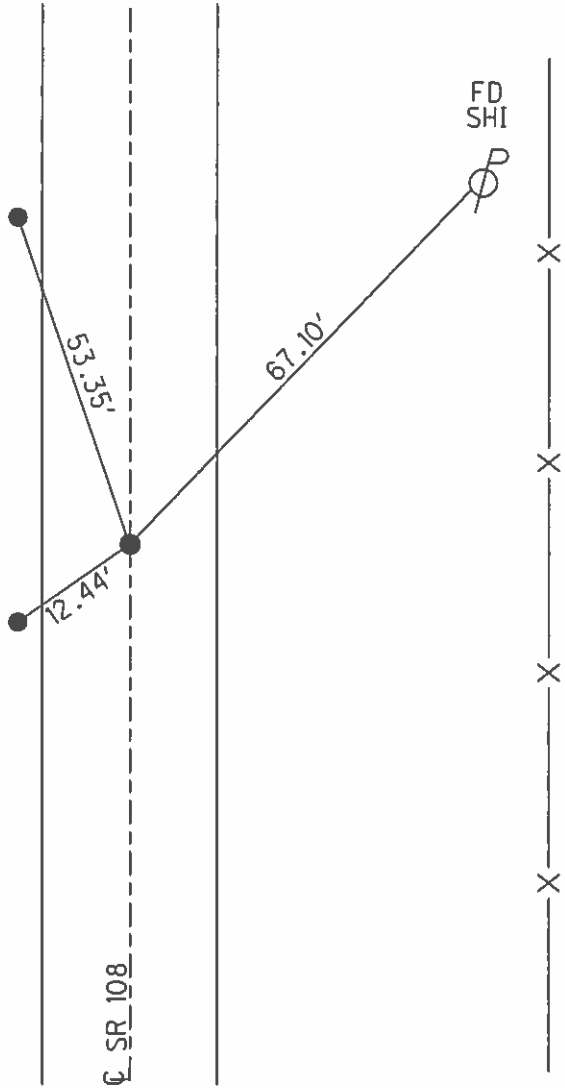

O.D.O.T. DISTRICT 2 SURVEY OFFICE

PERSONNEL

REFERENCE NO. 24

SHEET 5 OF 7

NOTES HUSS

DATE 5-06-04

ROUTE SR 108

H.C. HOMAN

WEATHER SUNNY

COUNTY FULTON

R.C. HOOKER

TEMP. 68°

TOWNSHIP CHESTERFIELD

SECTION 17

T 9 S R 2 E



TYPE MONUMENT PK NAIL

~~ON SURFACE~~ - BELOW 3"


~~LEFT - C PAVT~~ ~~RIGHT~~ 0.5' LT

9.5' TO LT EDGE PAVEMENT

S.L.M. 928+12

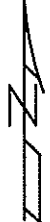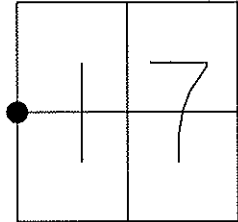

SET MAG NAIL
& WASHER
6-02-04
RGN

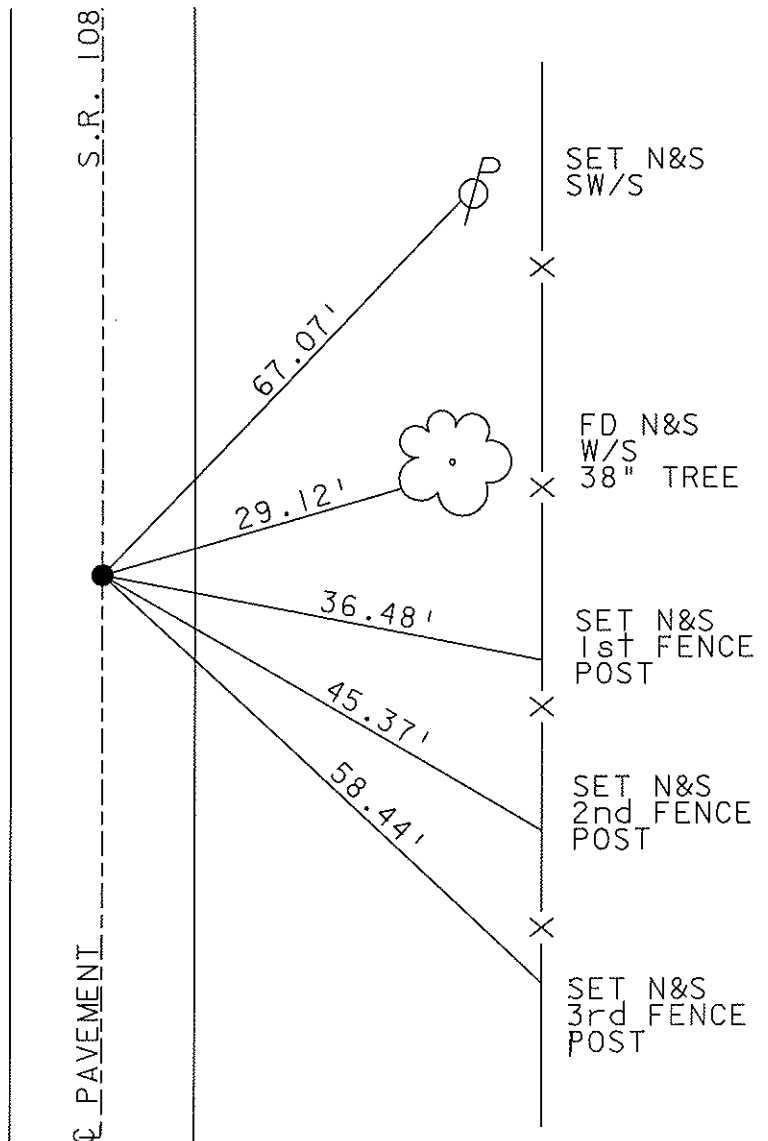

O.D.O.T. DISTRICT 2 SURVEY OFFICE

PERSONNEL _____

REFERENCE NO. 24

SHEET 4 OF 6

NOTES D. CURTIS

H.C. J. HOUSEHOLDER DATE 5-31-88

R.C. _____ WEATHER WARM

_____ TEMP. 90°±

ROUTE S.R. #108

COUNTY FULTON

TOWNSHIP CHESTERFIELD

SECTION 17

T _____ R _____


TYPE MONUMENT P.K. NAIL

ON SURFACE - ~~BELOW~~ ON SURFACE


LEFT- & PAV'T. - RIGHT & PAVT

12.65 TO W. EDGE PAVEMENT

S.L.M. 928 + 12

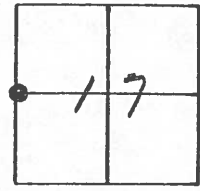

SET P.K. NAIL TO SURFACE
6-17-88

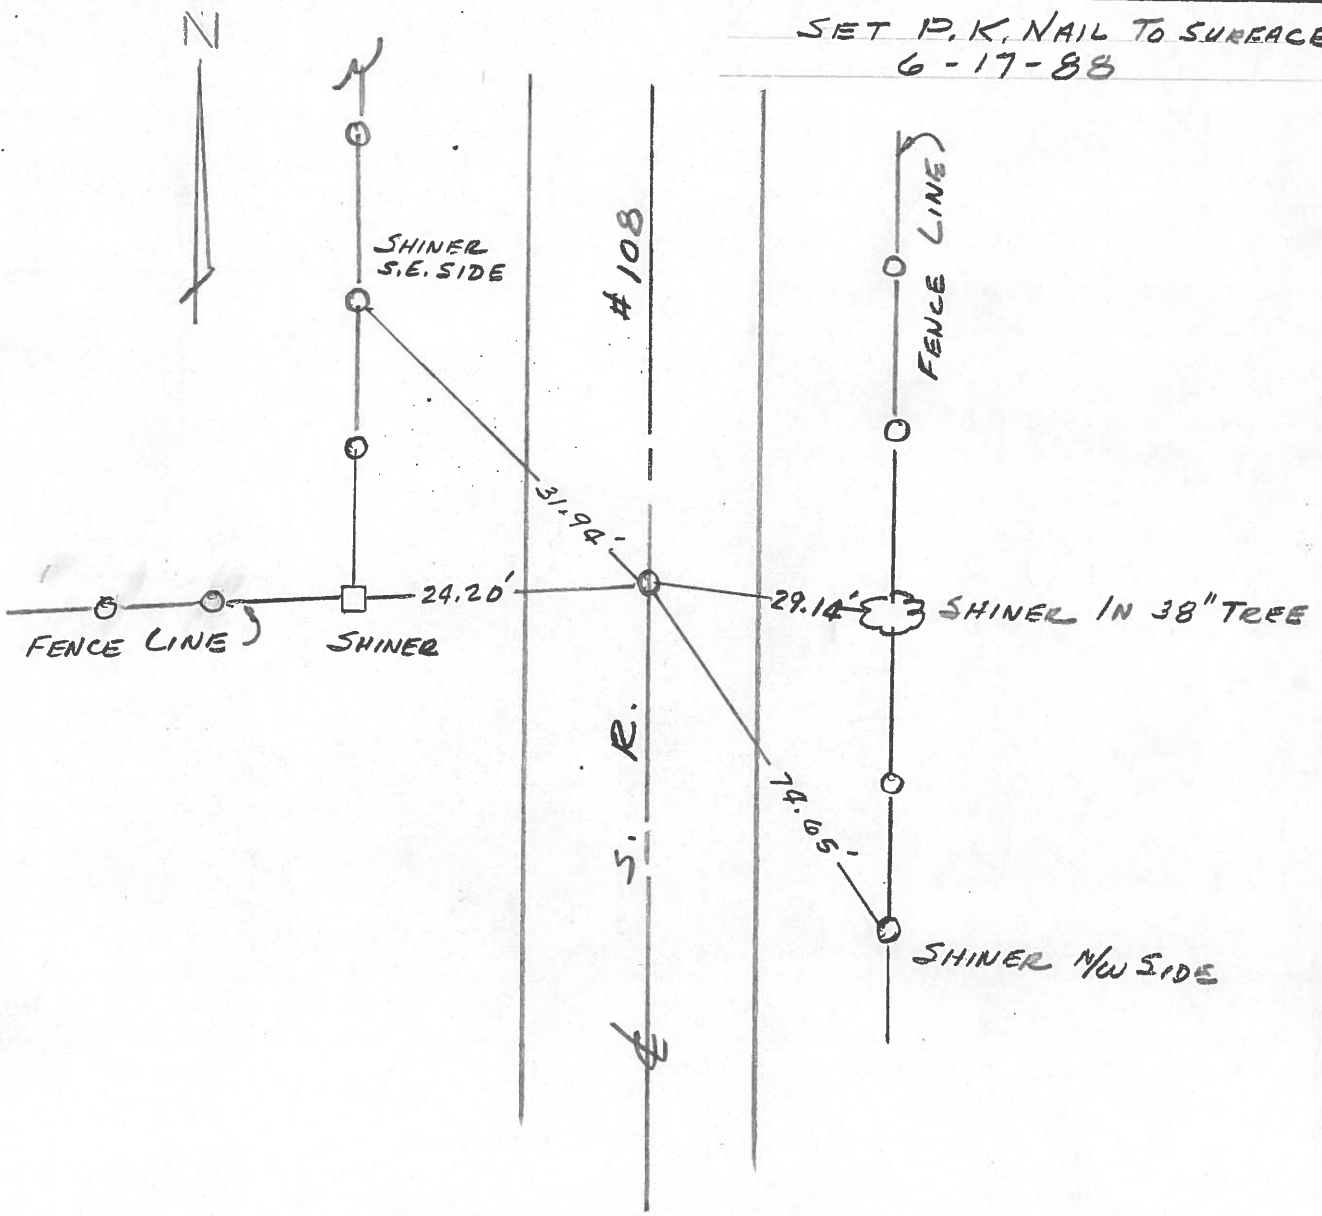

O.D.O.T. DISTRICT 2 SURVEY OFFICE

SHEET 4 OF

County Fulton S.R. 108

Township Chesterfield

Section 17

T N, R E

Personnel I. Stone


P. Neuse

D. Curtis

Date OK-6-1-81 - S.W.H.
11 May 81


Weather Cloudy

Temp. 75°

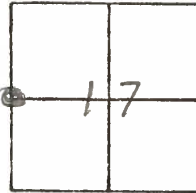

927+90±

REF. No. 24

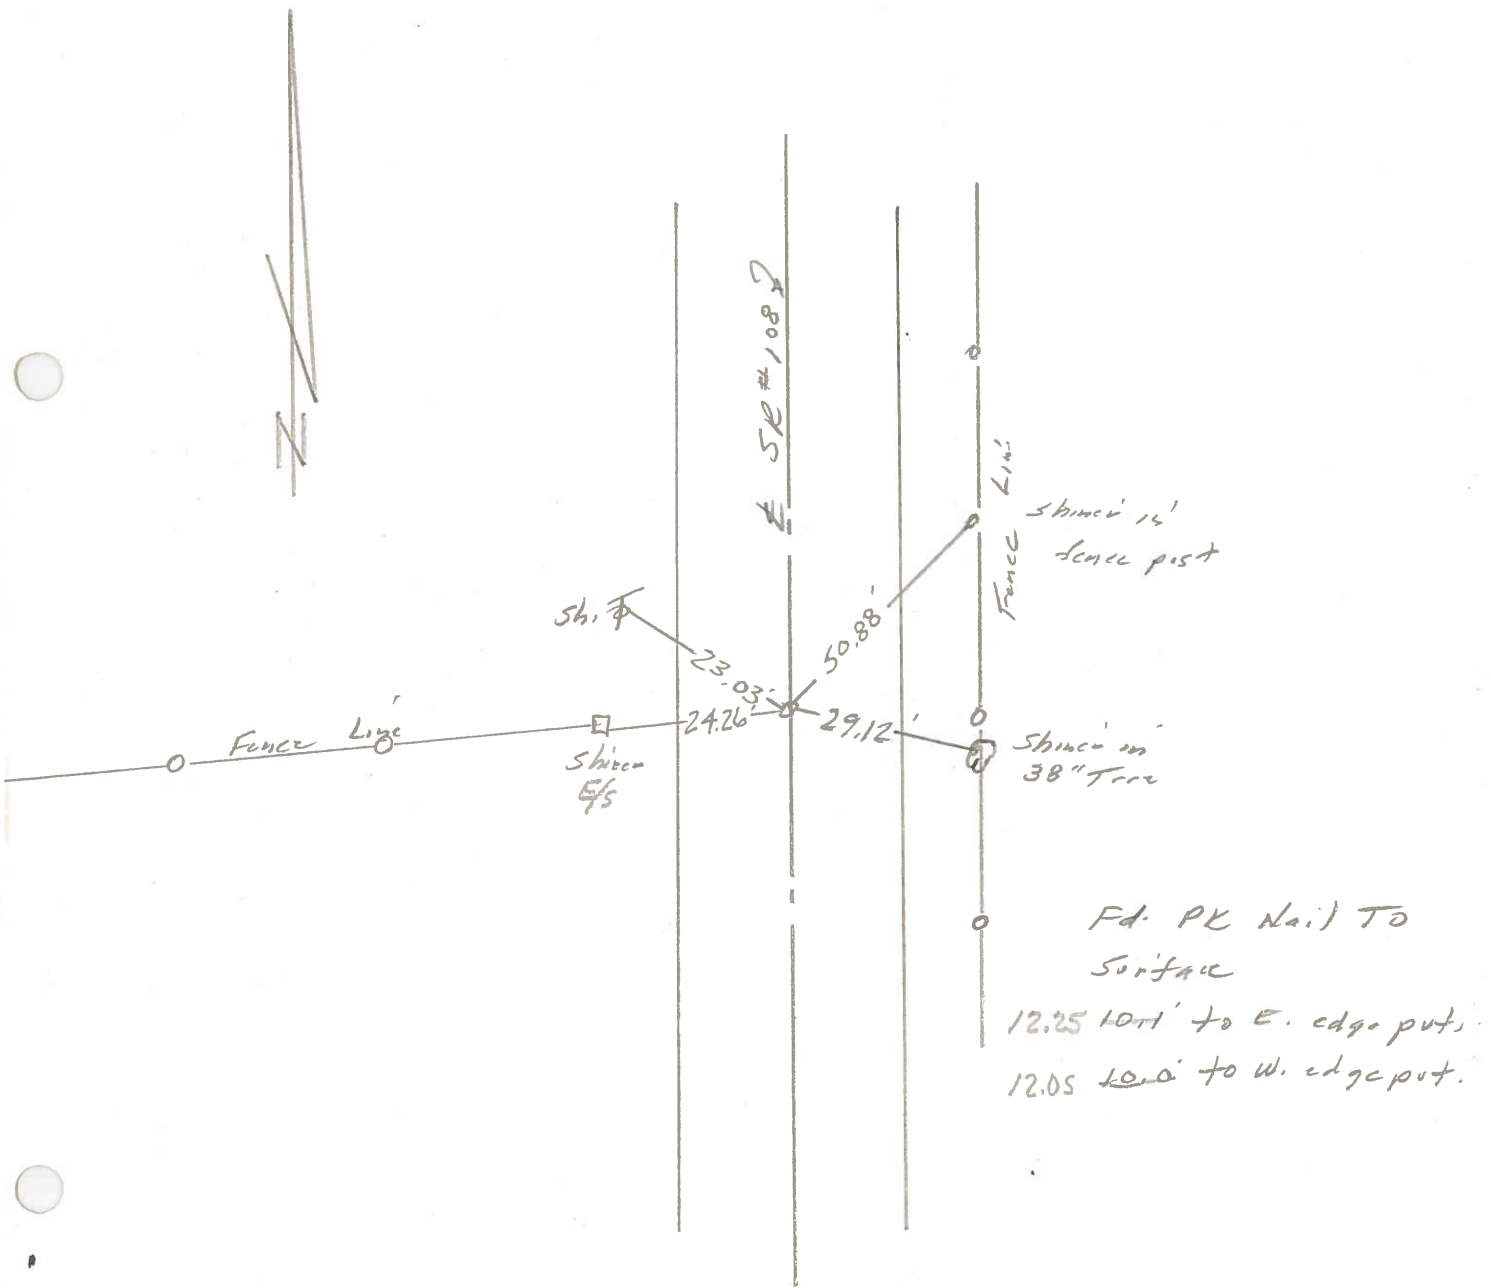

ODOT. DISTRICT 2 SURVEY OFFICE

SHEET 7 OF

County Fulton S.R. 108

Date 11 May 81

Township Chesterfield


Weather Cloudy

Section 17

Temp. 75°

T_N, R_E

Personnel L. Stone

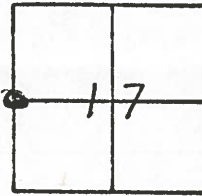


P. Neuse

D. Curtis

927190d

REF. No. 24

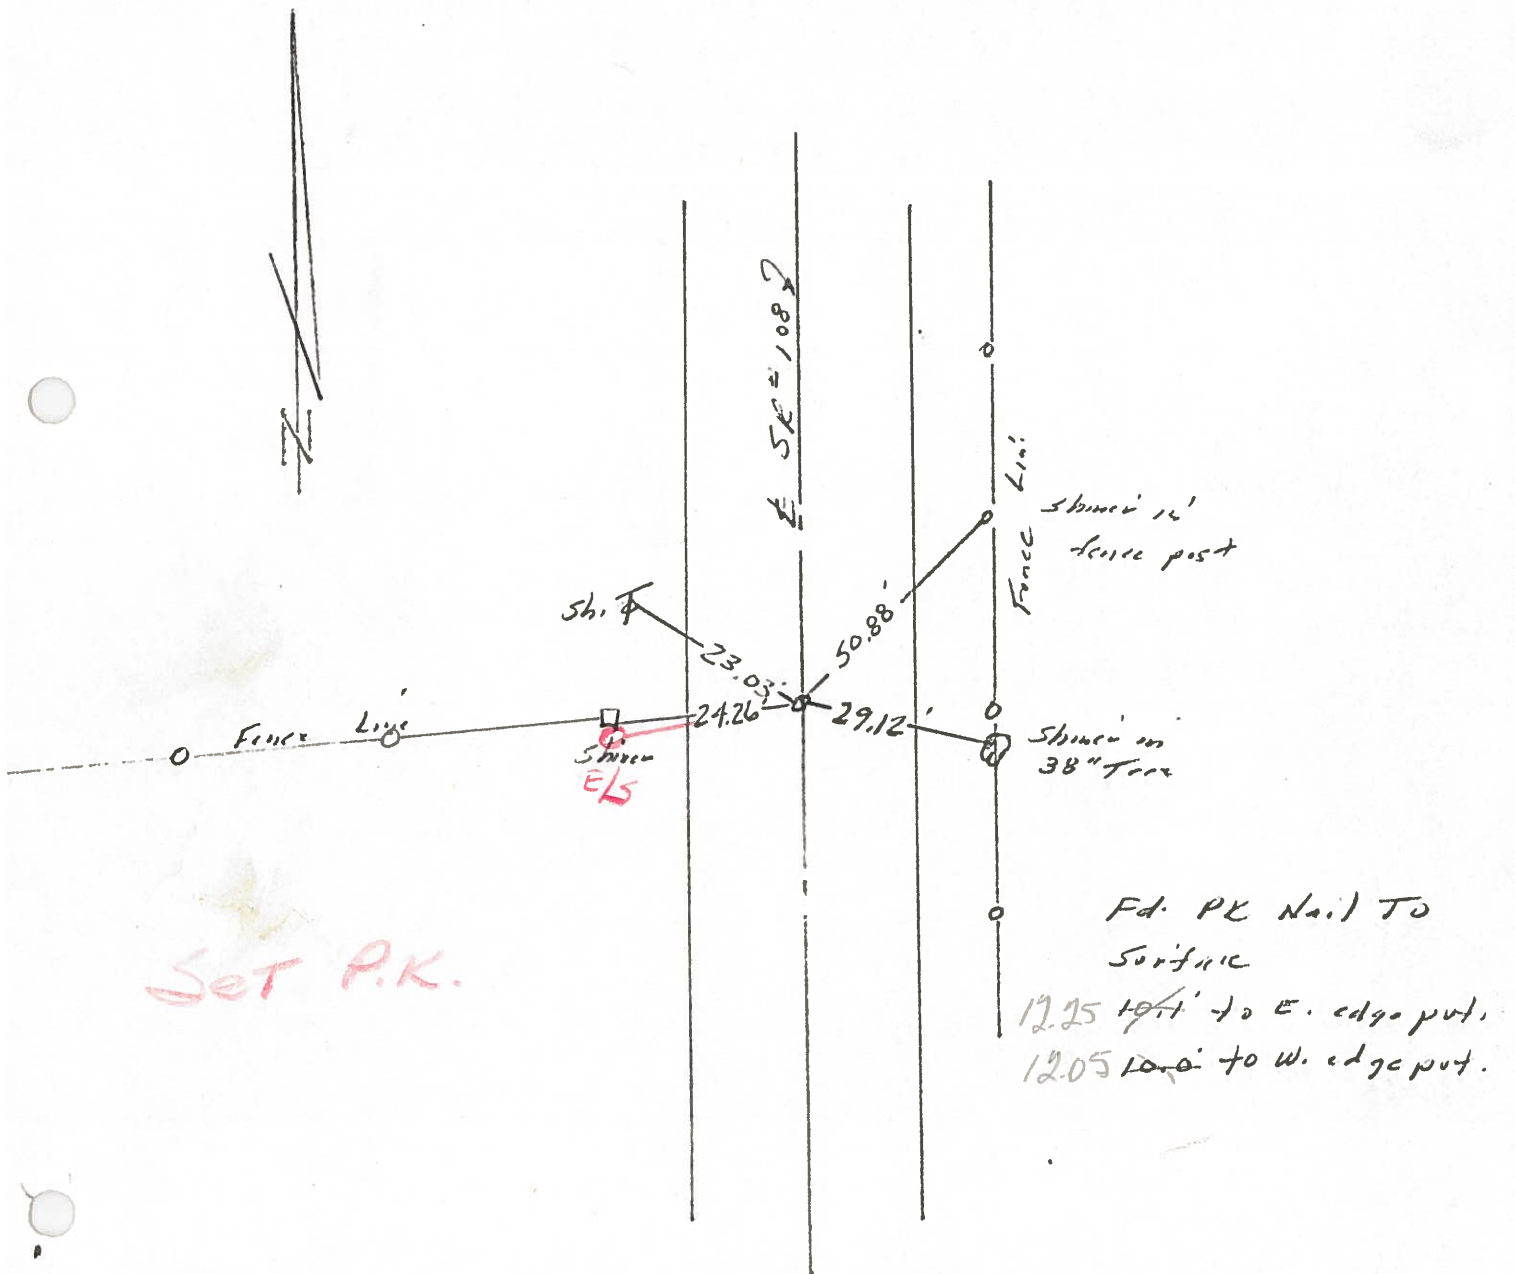

Set P.K.

Fd. PK Nail TO
Surface
12.25 to E. edge put.
12.05 to W. edge put.

PERSONNEL TITLE PERSONNEL TITLE

COUNTY Fulton DATE 25 Aug 1977

S. R. #108 WEATHER Fair

SEC. 05#20 N. to Mich Line TEMP. 70°

DESCRIPTION _____

LEFT CENTER LINE RIGHT JOB NO. _____

