

PERSONNEL	TITLE	PERSONNEL	TITLE
<u>Schneider</u>			
<u>Masser</u>			
<u>Barbour</u>			

COUNTY Fulton DATE 3-11-81

S. R. 109 WEATHER Cloudy


SEC. 14.89 TEMP. 32°

DESCRIPTION Maint. Program (Guardrail runs) JOB NO. \_\_\_\_\_

LEFT

CENTER LINE

RIGHT

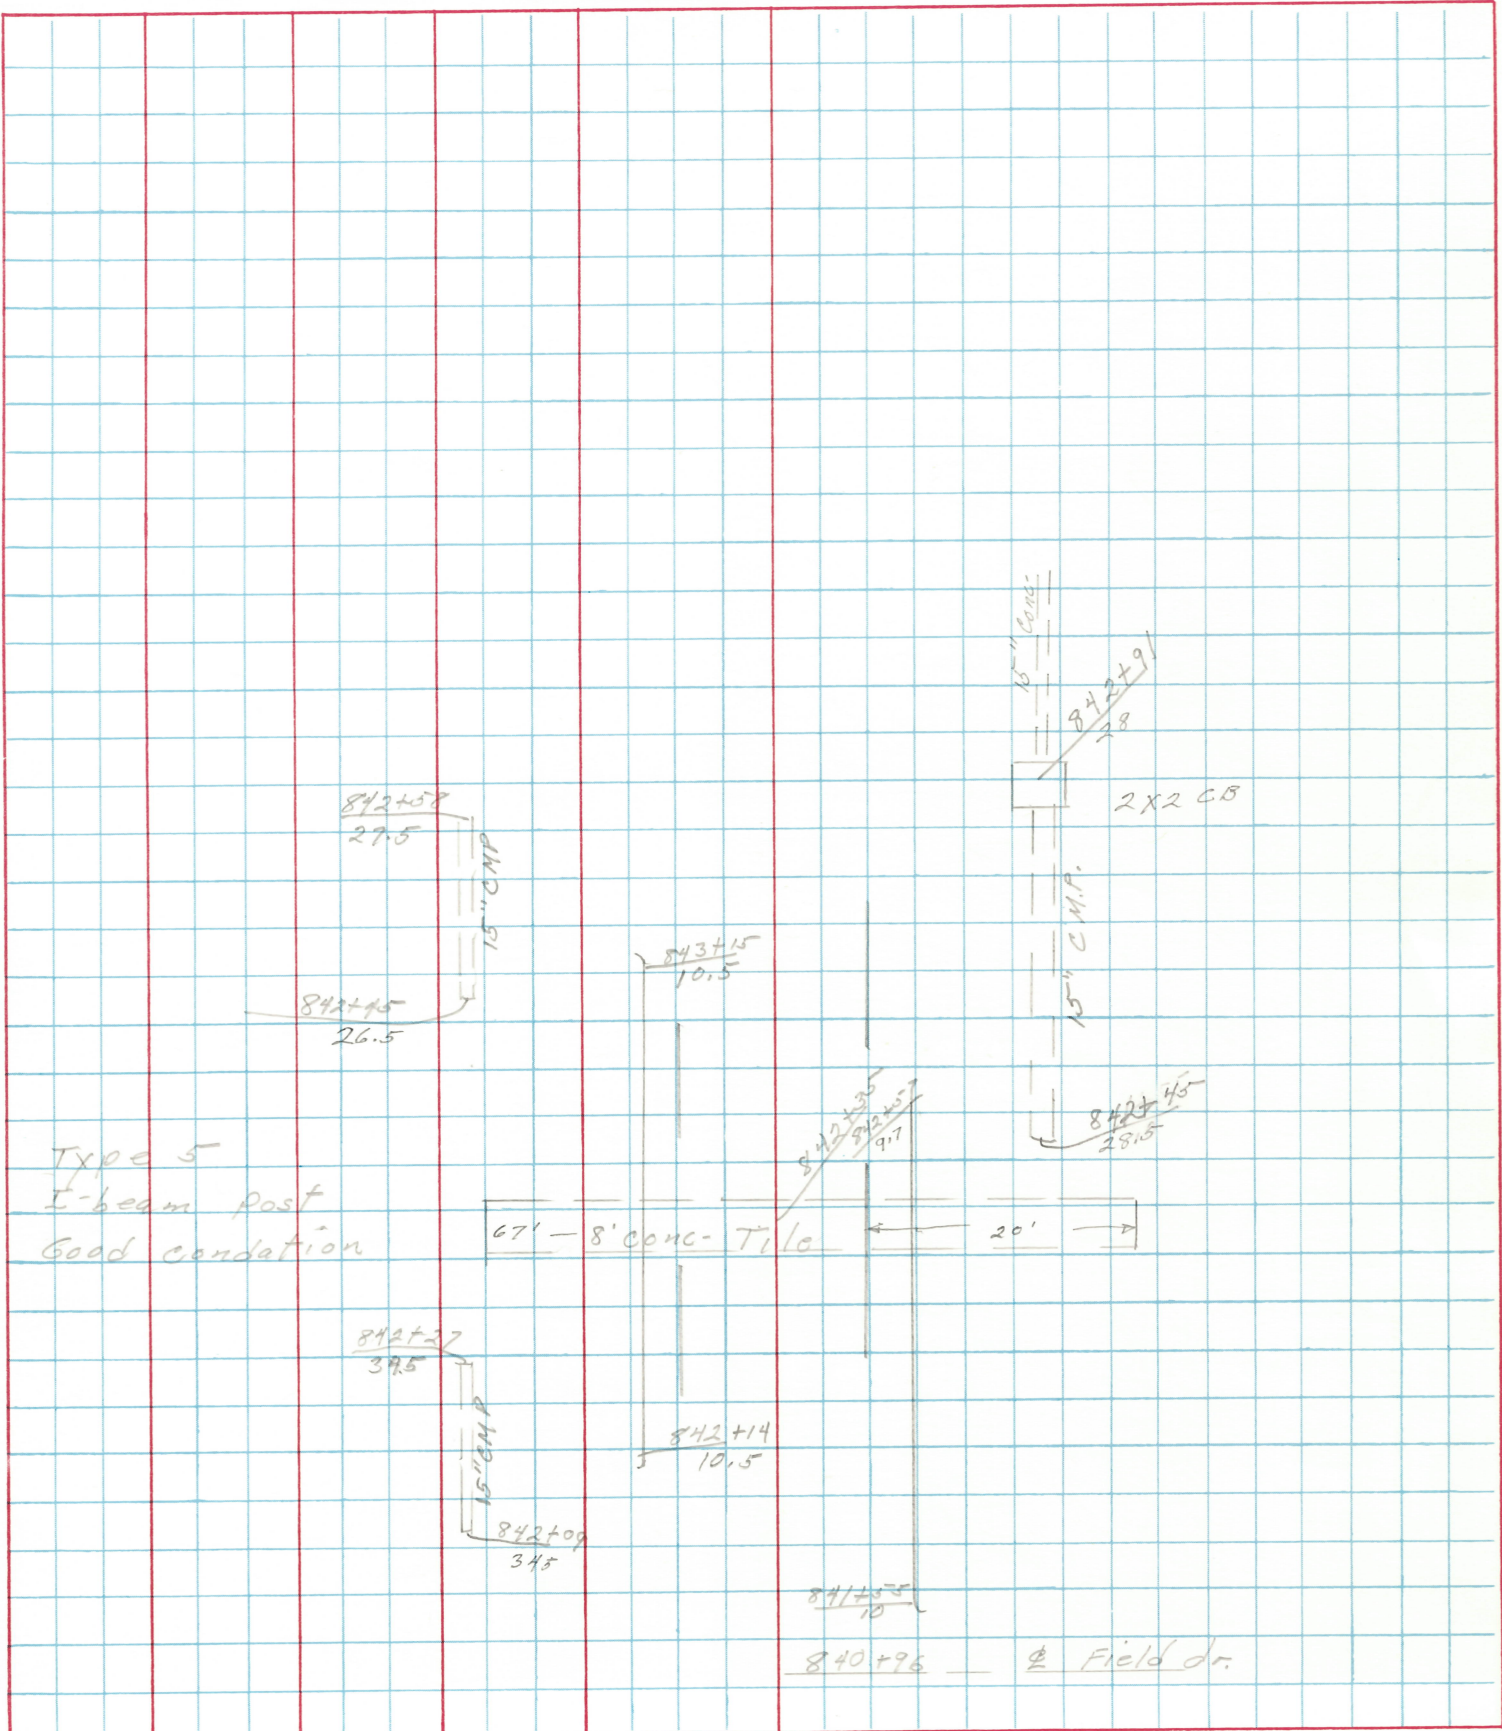

Type 5  
I-beam Post  
Good condation


67'-8' conc. Tile ← 20' →

840+96 — 20' — Field dr.

PERSONNEL	TITLE	PERSONNEL	TITLE
Schneider			
Mosser			
Barbour			

COUNTY Fulton DATE 3-11-81  
 S. R. 109 WEATHER Cloudy-Windy  
 SEC. 1698 TEMP. 32°  
 COLD

DESCRIPTION Maint. Program (Guardrail runs) JOB NO. \_\_\_\_\_  
 LEFT CENTER LINE RIGHT

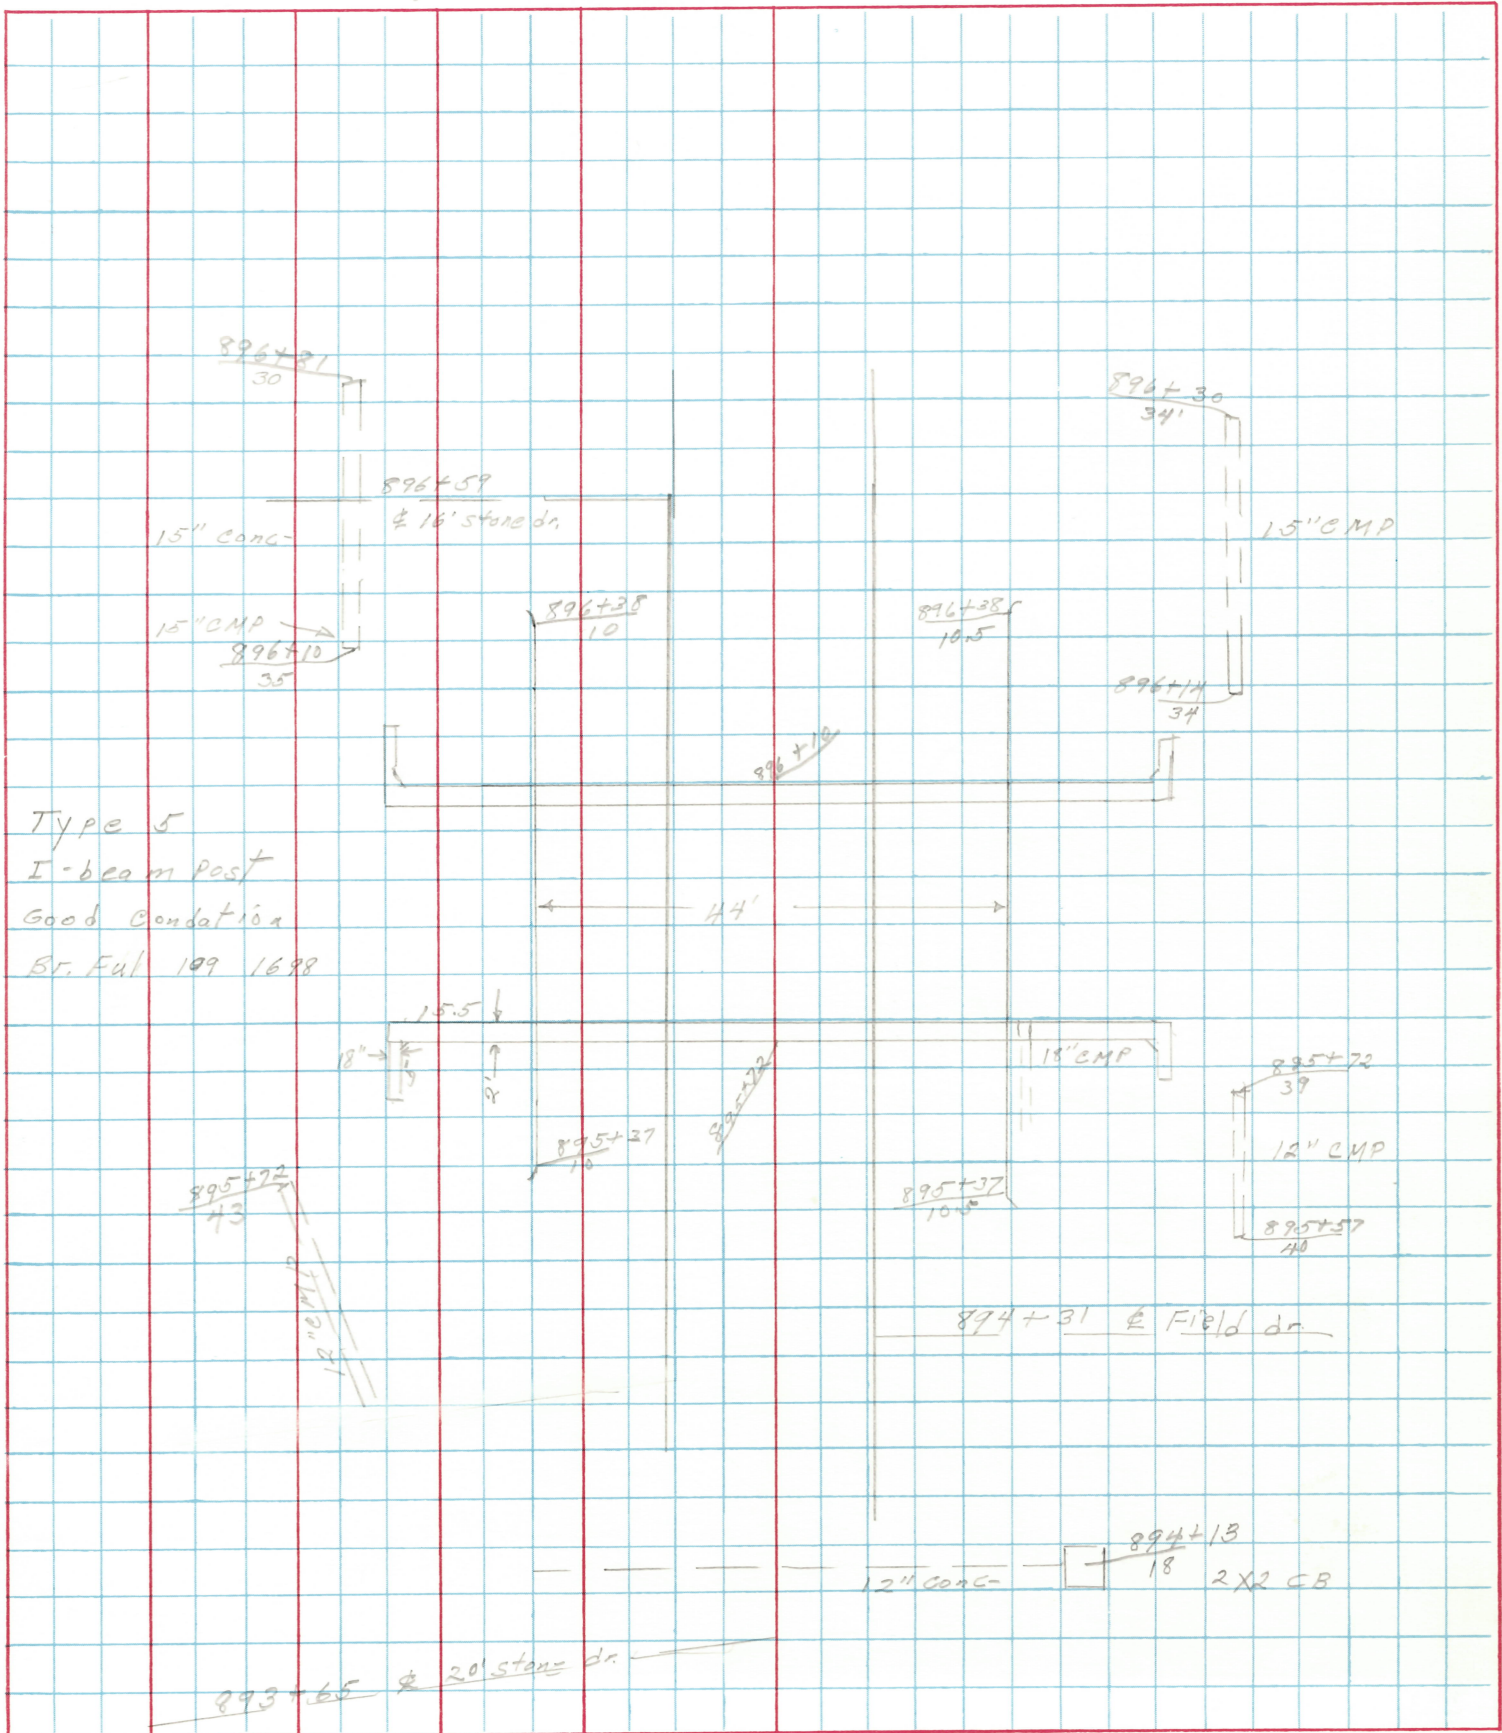

Type 5  
 I-beam Post  
 Good Condition  
 Br. Ful 109 1698

893+65 & 20' stone dr.

PERSONNEL	TITLE	PERSONNEL	TITLE
<u>Schneider</u>			
<u>Mosser</u>			
<u>Barbour</u>			

COUNTY Fulton DATE 3-11-81  
 S. R. 109 WEATHER Cloudy - Windy - 6/8  
 SEC. 16.98 TEMP. 32°

DESCRIPTION Maintenance Program (Guardrail runs) JOB NO. \_\_\_\_\_  
 LEFT CENTER LINE RIGHT

