


O.D.O.T. DISTRICT 2 SURVEY OFFICE (USE ONLY)

PERSONNEL	REFERENCE NO. <u>2</u>	SHEET <u>2</u> OF <u>14</u>
NOTES <u>HUSS</u>	DATE <u>07-08-10</u>	ROUTE <u>SR 109</u>
H.C. <u>HUSS</u>	WEATHER <u>SUNNY</u>	COUNTY <u>FULTON</u>
R.C. <u>CANTERBURY</u>	TEMP. <u>94°</u>	TOWNSHIP <u>YORK</u>
		SECTION <u>12</u>
		T <u>6</u> N R <u>7</u> E

TYPE MONUMENT _____ SM RR/SPK _____
 ON SURFACE - BELOW _____ ON _____
 LEFT - Q PAV'T - RIGHT _____ ON _____
10.1' TO RT EDGE PAVEMENT
 S.L.M. _____ 13+40 _____

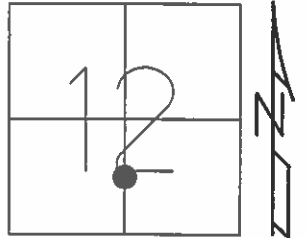


Grid: Northing: 667972.085 Easting: 1555175.234

RECORD:

S.E. COR; N.E. 1/4;
 S.W. 1/4 SEC 12

03-25-83 FD 2.25" ROUND
 HEAD IROD 2.75" DEEP, HOFFMAN
 10-13-94 SET PK/WASHER, BVD
 09-16-10 SET MAG. WASHER, EF

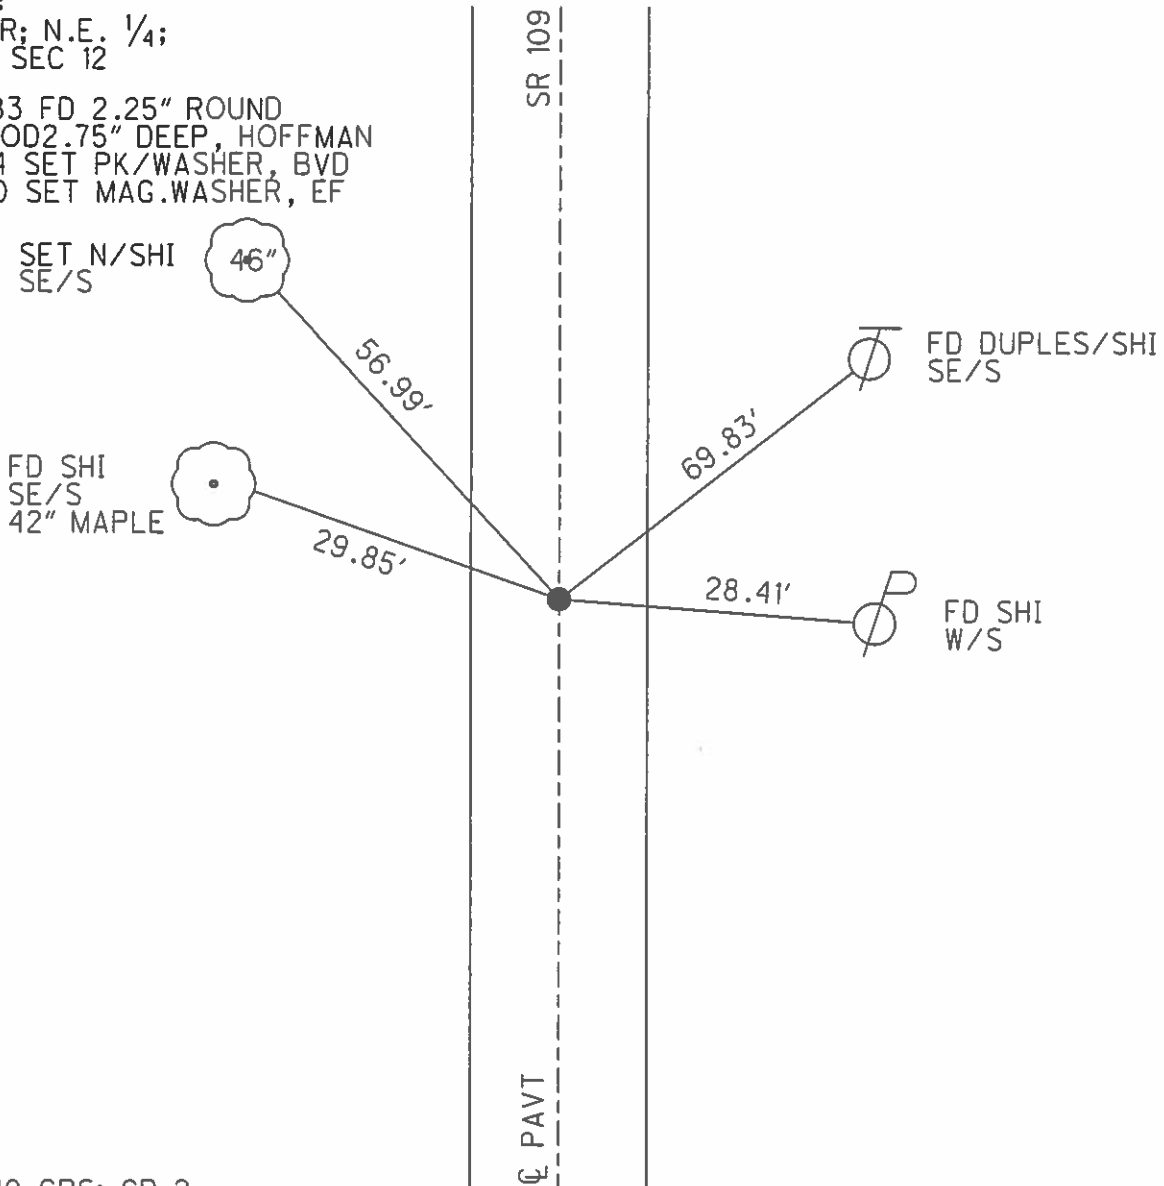

O.D.O.T. DISTRICT 2 SURVEY OFFICE

PERSONNEL _____

REFERENCE NO. 2

SHEET 1 OF 27

NOTES BARNHISEL

H.C. CORDES

R.C. SILOVAK

VAN DUSEN DJ

DATE 8-9-94

WEATHER Cloudy

TEMP. +60°

ROUTE 109

COUNTY FULTON

TOWNSHIP YORK

SECTION 12

T 6 N R 7 E


TYPE MONUMENT Sm. RR Spk

ON SURFACE - ~~YES~~ yes

~~PAV'T. - RIGHT~~ yes

10.1 TO R+ EDGE PAVEMENT

S.L.M. 13+40

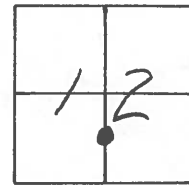

RECORD:

S.E. COR; N.E. 1/4;

S.W. 1/4 Sec 12

Fd 2 1/4" ROUND HEAD I-ROD

2 3/4" DEEP


3-25-83

HOFFMAN

SET PK & WASHER

10-13-94

BVD

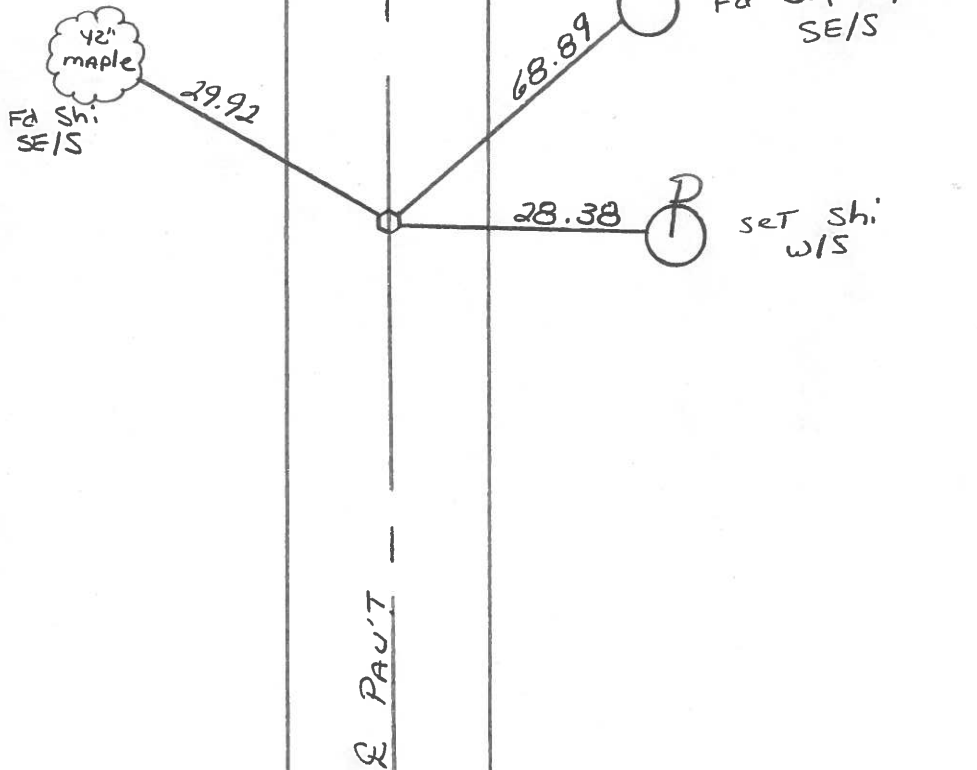

Resurfaced
1994

Q.D.O.T. DISTRICT 2 SURVEY OFFICE

SHEET _____ OF _____

County FULTON S.R. 109

Date MARCH 25, 83

Township YORK

Weather CLEAR

Section 12

Temp. +25°


T6N, R7E

Personnel HOFFMAN

HOUSEHOLDER

BARNISEL

#2

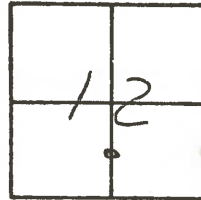


Fd IRON ROD / 2 1/4" ROUND HEAD 2 3/4" below surface

ON & PAUT
9.0 TO W. EP.
9.4 TO E. EP.

S. 2. M. 13 + 39

RECORD:
S. E. COR; N. E. 1/4;
S. W. 1/4 Sec. 12

SET SMALL R.R. SPK
S-17-83
S.W.H.

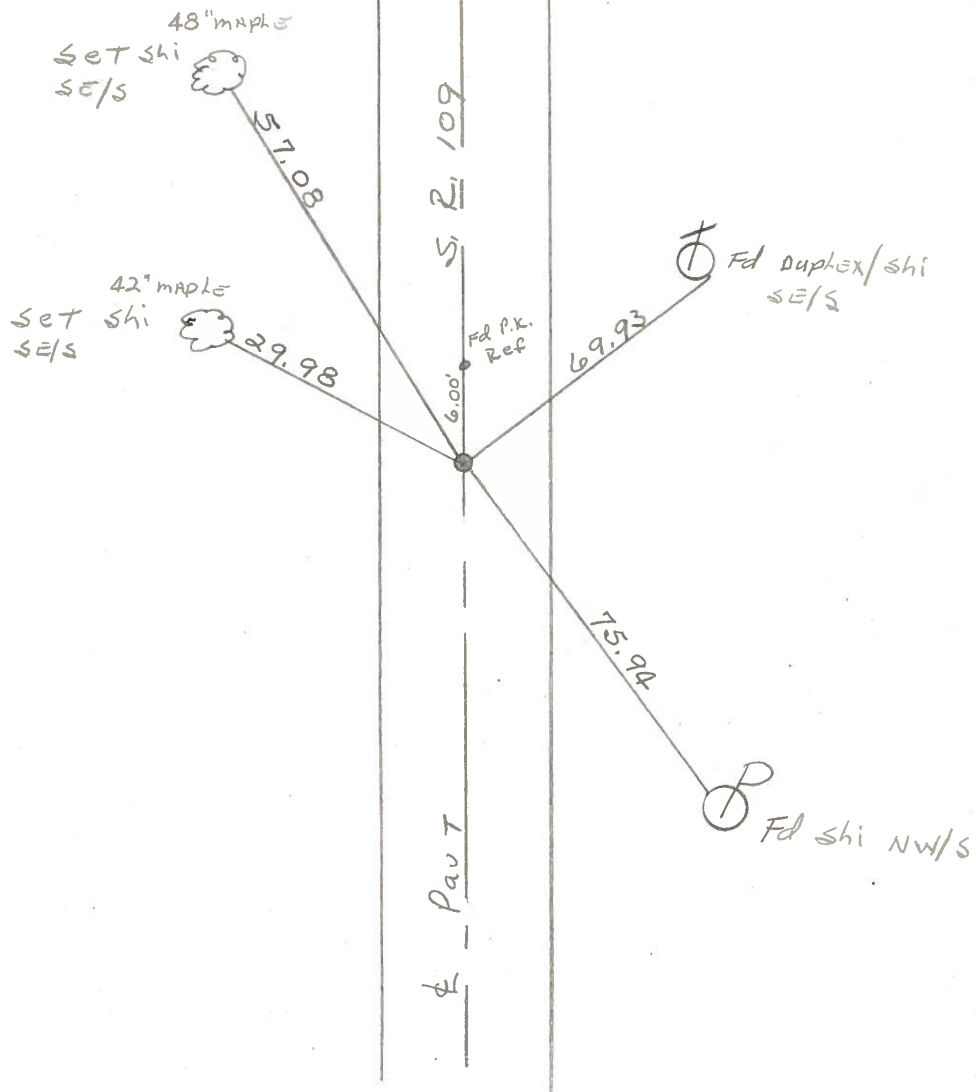

S.R. 109 FULTON

PERSONNEL	TITLE	PERSONNEL	TITLE	COUNTY	DATE	WEATHER	TEMP.
Trause				Fulton	July 12, 1973		
Geonata				S. R. 109			
Vano				SEC. YORK TWP			
Boyle							

DESCRIPTION _____ LEFT _____ CENTER LINE _____ RIGHT _____ JOB NO. _____

