


O.D.O.T. DISTRICT 2 SURVEY OFFICE (USE ONLY)

PERSONNEL	REFERENCE NO. <u>3</u>	SHEET <u>3</u> OF <u>14</u>
NOTES <u>CANTERBURY</u>	DATE <u>07-12-10</u>	ROUTE <u>SR 109</u>
H.C. <u>GOBLE</u>	WEATHER <u>FAIR</u>	COUNTY <u>FULTON</u>
R.C. <u>CANTERBURY</u>	TEMP. <u>80°</u>	TOWNSHIP <u>YORK</u>
		SECTION <u>12</u>
		T <u>6</u> N R <u>7</u> E

TYPE MONUMENT _____ PK NAIL _____
 ON SURFACE - ~~BELOW~~ _____ ON _____
 LEFT - Q PAV'T - RIGHT _____ ON _____
10.0' TO RT EDGE PAVEMENT
 S.L.M. _____ 26+80 _____

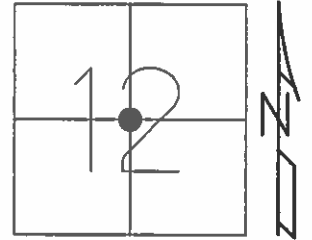

Grid: Northing: 669310.387 Easting: 1555195.827

RECORD:
 MID-POST SEC 12
 FD 1" I-PIPE 2" BELOW SURFACE

07-08-10 GPS: CP 3

05-17-93 SET SMALL RR SPK, SWH
 10-13-94 SET PK/WASHER, BVD
 07-12-10 FD PK NAIL
 09-16-10 SET MAG/WASHER, EF

FD SHI SE/S
 40" OAK



48.67'

METAL FENCE POST
 4TH NOTCH UP



31.37'

SR 109

Q PAVT

110.81'



FD SHI SW/S

30.48'

SET TACK
 4" WOOD POST

111.11'



FD SHI
 NW/S

O.D.O.T. DISTRICT 2 SURVEY OFFICE

PERSONNEL

REFERENCE NO. 3

SHEET 2 OF 27

NOTES BARNHISEL

H.C. CORDES

DATE 8-9-94

ROUTE 109

R.C. Slouak

WEATHER Cloudy

COUNTY Fulton

VAN DUSEN

TEMP. +60°

TOWNSHIP York

SECTION 12

T 6 N R 7 E


TYPE MONUMENT Sm. RR Spk

ON SURFACE - ~~BELOW~~ YES

~~LEFT - & PAV'T. - RIGHT~~ YES

10.2 TO RT EDGE PAVEMENT

S.L.M. 26+80

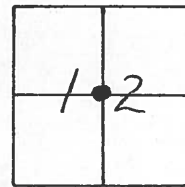


RECORD:
MID-POST Sec. 12
Fd 1" I. Pipe 2" Below Surface

SET PK & WASHER
10-13-94
BYD

Set Small RR Spk
5-17-83
SWH

40" OAK Fd Shi SEIS

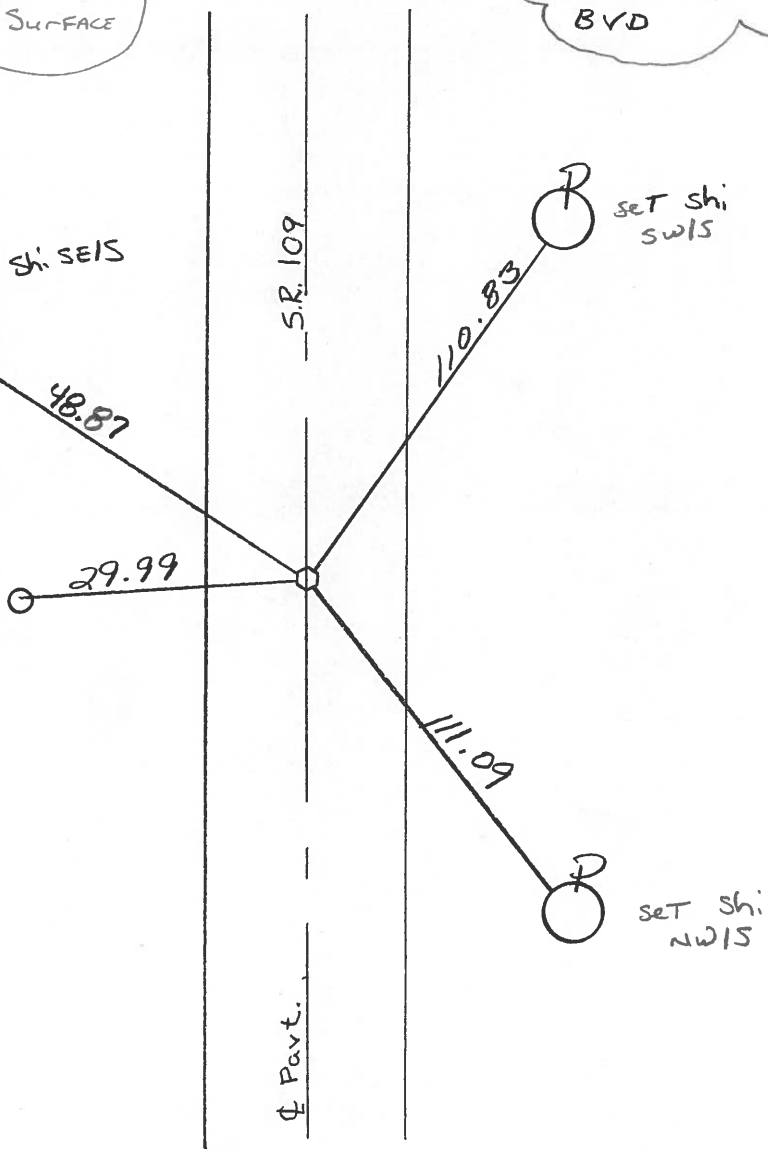

O.D.O.T. DISTRICT 2 SURVEY OFFICE

SHEET _____ OF _____

County FALTON S.R. 109

Date MARCH 25, 83

Township YORK


Weather CLEAR

Section 12

Temp. +25°

T6N, R7E

Personnel HOFFMAN

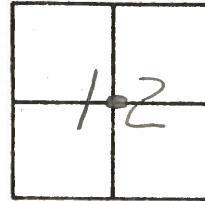

HOUSEHOLDER

#3

BARNHISEL

Fd 1" I.D. IRON PIPE 2" Below surface

S.L.M. 26+78

ON & PAUT
9.3 TO W.E.P.
8.4 TO E.E.P.

Record:
Mid Post Sec. 12

Set shi sw/s
40" OAK

49.05

SET SMALL R.R. SPK.
5-17-83
S.W.H.



S.R. 109

PAUT & PAUT

97.55
P Set shi sw/s


52.31
Set shi w/s 18" TRUNK MAPLE

51.29
Fd shi NW/s

S.R. 109 FULTON





SHEET NO. _____

PERSONNEL	TITLE	PERSONNEL	TITLE	COUNTY	DATE
TAMMISIC				Fulton	July 12, 1973
Granato				S. R. 109	WEATHER _____
Vaino				SEC. YORK TWP	TEMP. _____
Dyke					

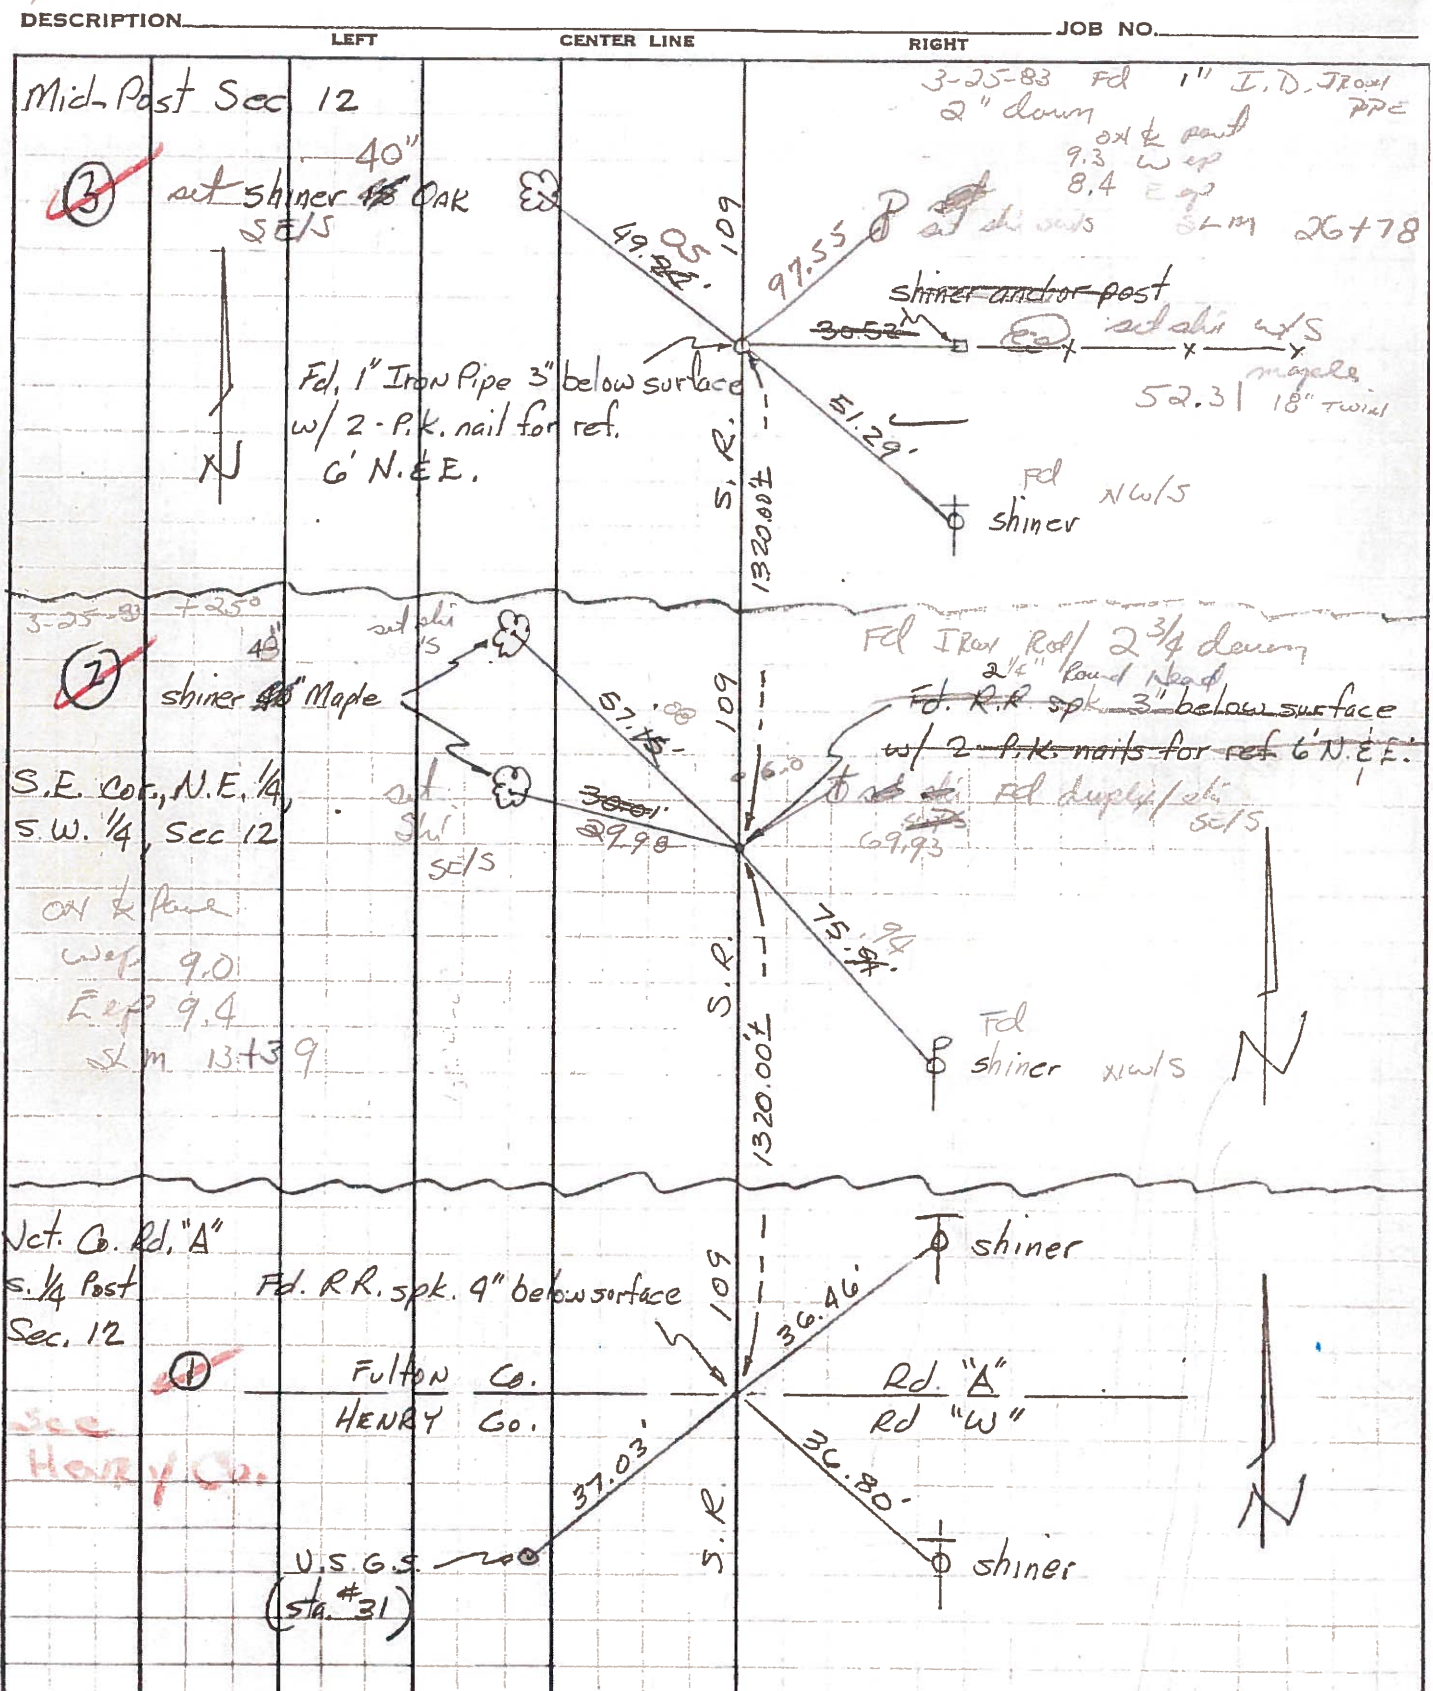

PERSONNEL	TITLE	PERSONNEL	TITLE	COUNTY	DATE
Red Beach				Fulton	July 1970
Newcomb				S. R. 109	WEATHER
Knape				SEC Liberty Center - Delta	TEMP.
Wise					

CONTROL POINTS

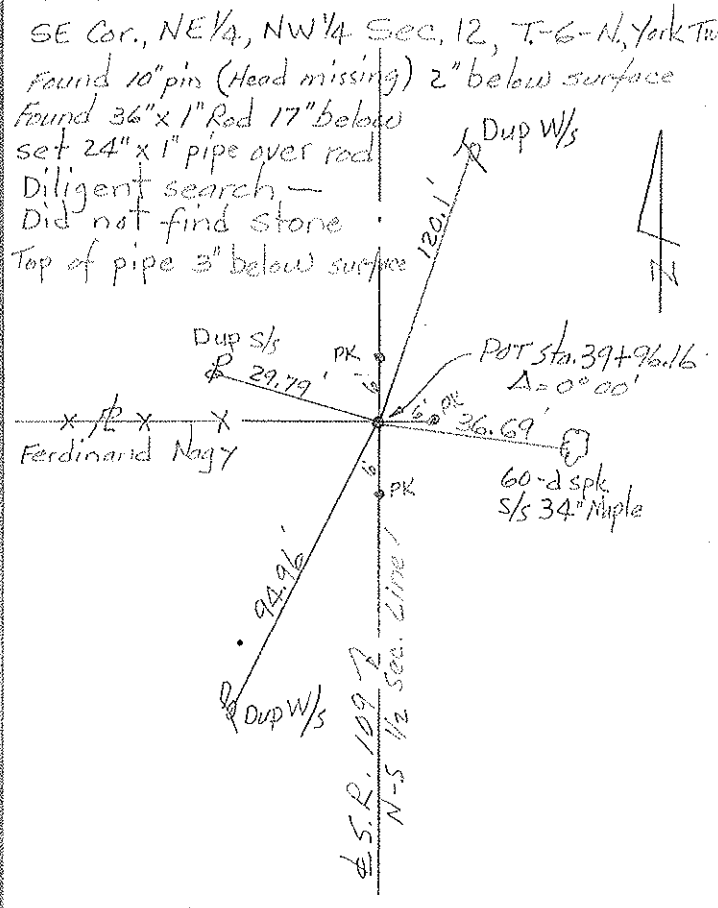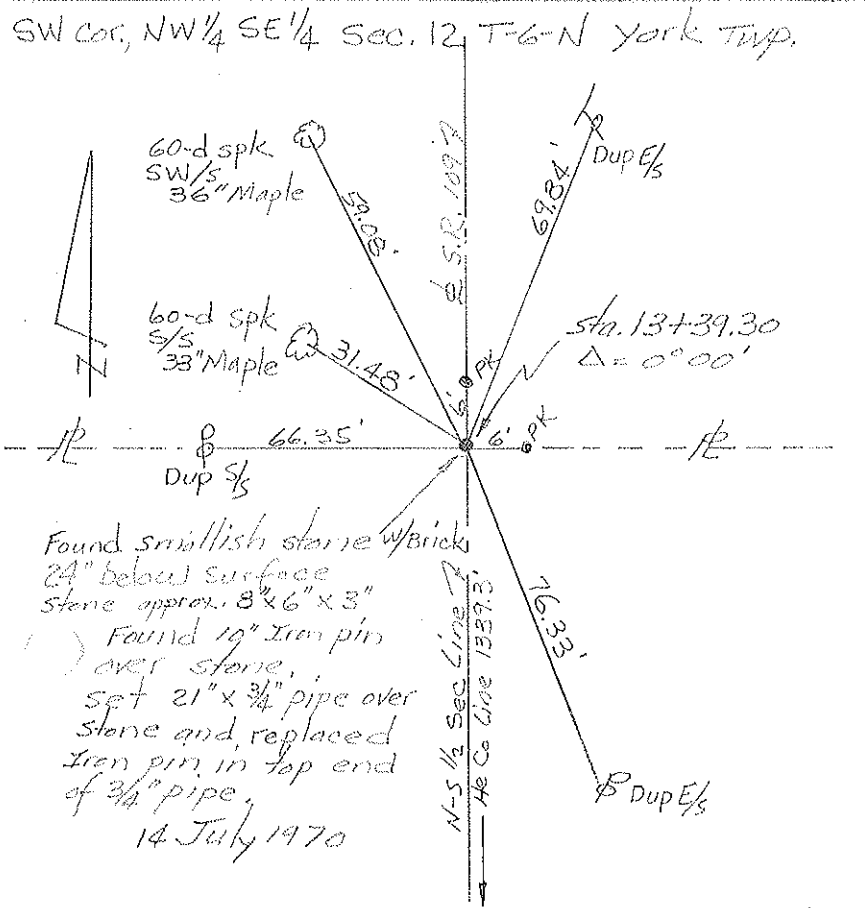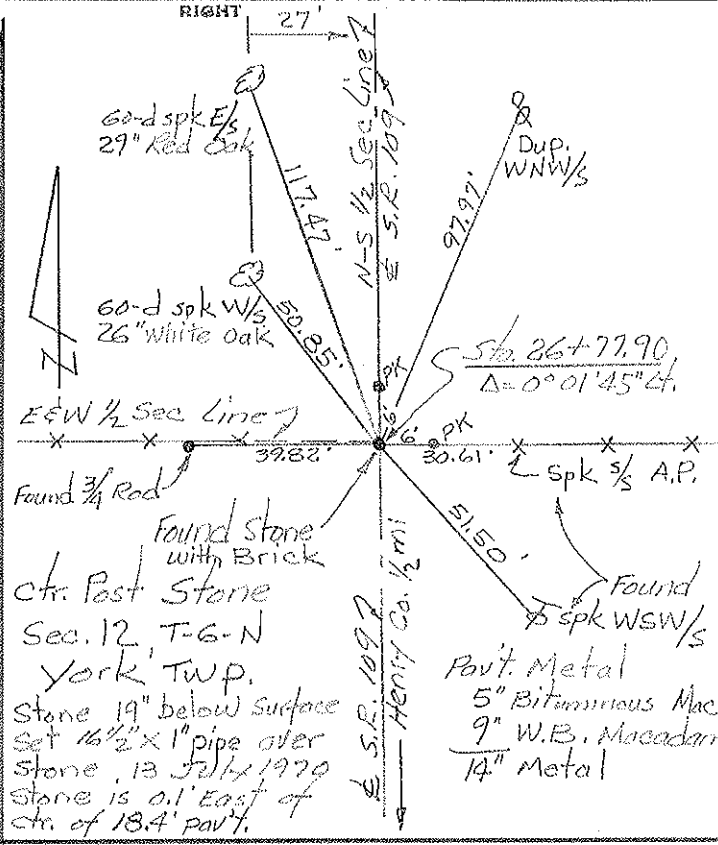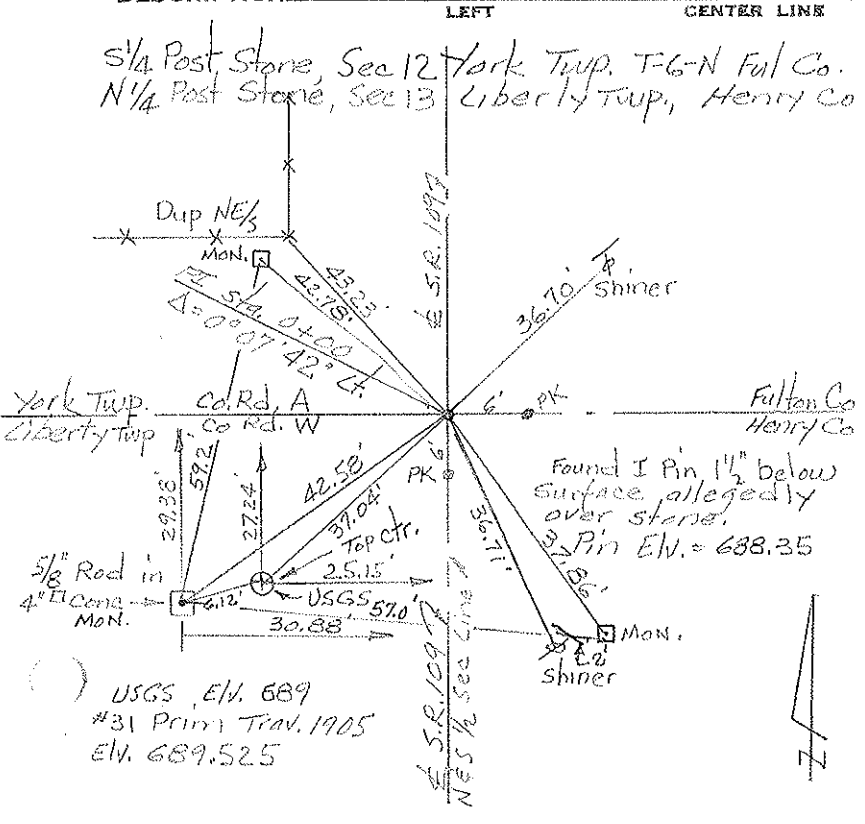

PERSONNEL	TITLE	PERSONNEL	TITLE	COUNTY	DATE
Red Beach				FULTON	JULY 1970
Newcomb				S. R. 109	WEATHER
Knape				SEC. 12, YORK TWP., T-6-N	TEMP.
Wise					

DESCRIPTION **ALIGNMENT & CONTROLS** JOB NO.

