


O.D.O.T. DISTRICT 2 SURVEY OFFICE (USE ONLY)


| | | |
|-------------------------|------------------------|-----------------------------|
| PERSONNEL | REFERENCE NO. <u>4</u> | SHEET <u>4</u> OF <u>14</u> |
| NOTES <u>CANTERBURY</u> | DATE <u>07-12-10</u> | ROUTE <u>SR 109</u> |
| H.C. <u>GOBLE</u> | WEATHER <u>FAIR</u> | COUNTY <u>FULTON</u> |
| R.C. <u>CANTERBURY</u> | TEMP. <u>80°</u> | TOWNSHIP <u>YORK</u> |
| | | SECTION <u>12</u> |
| | | T <u>6</u> N R <u>7</u> E |

TYPE MONUMENT _____ PK/WASHER _____
 ON SURFACE - BELOW _____ ON _____
 LEFT - CL PAV'T - RIGHT _____ ON _____
9.8' TO RT EDGE PAVEMENT
 S.L.M. _____ 40+00
 Grid: Northing: 670628.152 Easting: 1555215.464

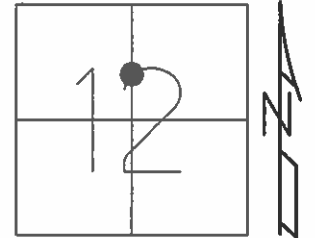

RECORD: 07-08-10 GPS: CP 4
 S.W. COR: NW 1/4;
 N.E. 1/4 SEC 12
 FD I-PIPE 2" BELOW SURFACE

- 05-17-93 SET SMALL RR SPK, SWH
- 10-13-94 SET PK/WASHER, BVD
- 07-12-10 FD PK/WASHER
- 09-16-10 SET MAG/WASHER, EF

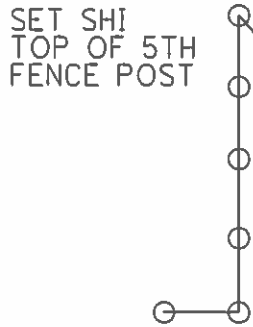

SR 109

CL PAVT

O.D.O.T. DISTRICT 2 SURVEY OFFICE

PERSONNEL

REFERENCE NO. 4

SHEET 3 OF 27

NOTES BARNHISEL

H.C. CORDS

DATE 8-9-94

ROUTE 109

R.C. SLOVAK

WEATHER Cloudy

COUNTY Fulton

VAN DUSEN

TEMP. +60°

TOWNSHIP York

SECTION 12

T 6 N R 7 E


TYPE MONUMENT Sm. RR Spk

ON SURFACE - ~~BELOW~~ yes

~~LEFT~~ - PAV'T. - ~~RIGHT~~ yes

10.2 TO Rt. EDGE PAVEMENT

S.L.M. 40+00

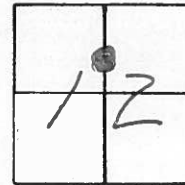


RECORD:

S.W. Cor: NW 1/4;
NE 1/4 Sec 12
Fd I-Pipe 2" Below Surface

SET PK & WASHER
10-13-94
BVD

SET SMALL RR SPK
5-17-83
SWH

SET Shi in
4th FENCE
POST.

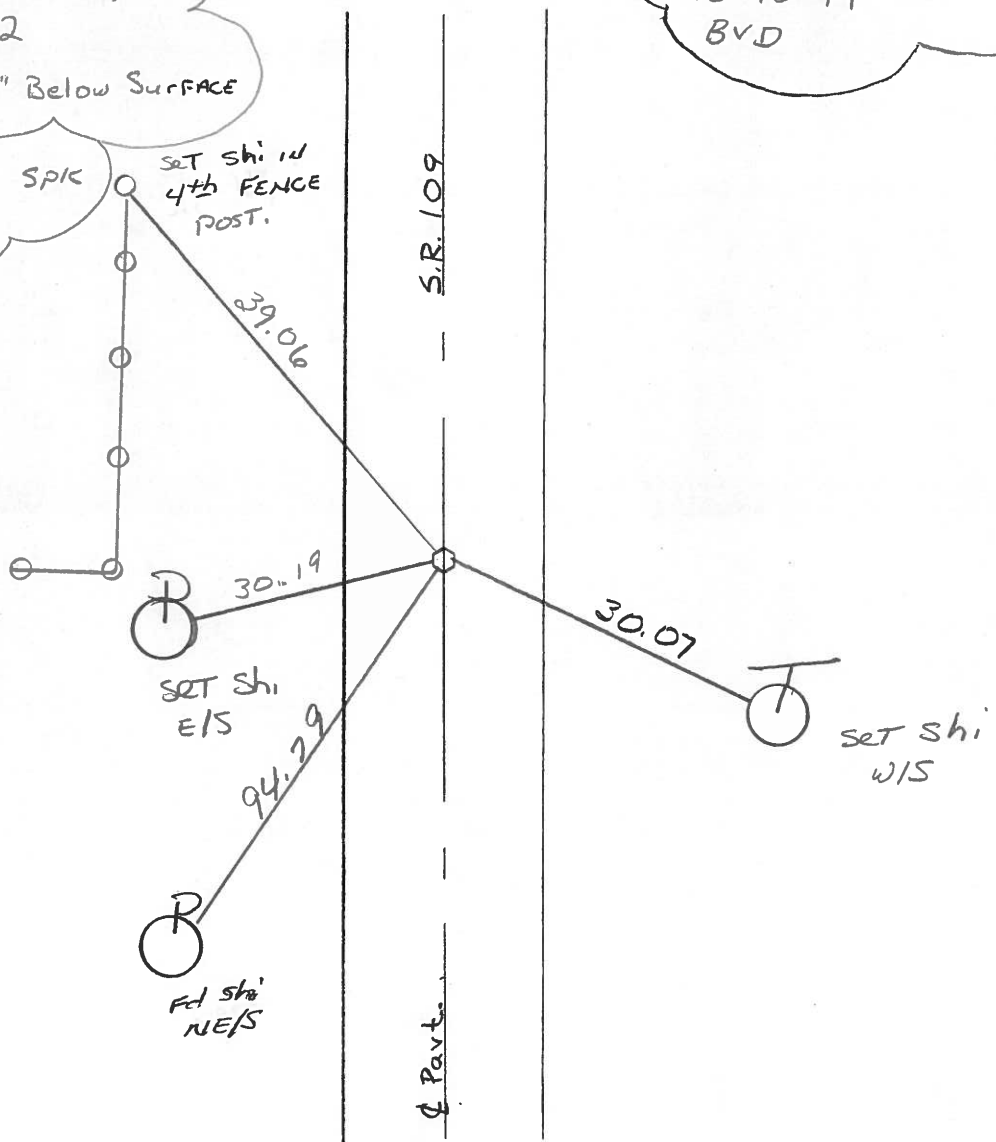

SET Shi
E/S

SET Shi
W/S

Fd Shi
NE/S

Q.D.O.T. DISTRICT 2 SURVEY OFFICE

SHEET _____ OF _____

County FULTON S.R. 109

Date MARCH 25, 83

Township YORK

Weather CLEAR

Section 12

Temp. +25°


T6N, R7E

Personnel HOFFMAN

HOUSEHOLDER

4

BARNHISEL

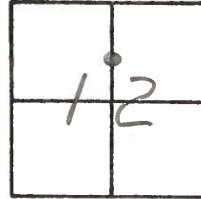


Fd 1" I.D. IRON PIPE 2" below surface
 ON & PAUT
 9.1 TO W.E.P.
 8.8 TO E.E.P.

S.L.M. 39+96

Record:
 SW COR; N.W. 1/4;
 N.E. 1/4 SEC. 12

SET SMALL R.P. SPK
 S-17-83
 S.W.H.

Fd Duplex
 S/S

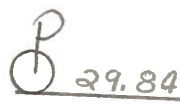

29.84


S. R. 109

& PAUT

62.95

Set shi
 s/s 24"
 maple

29.47

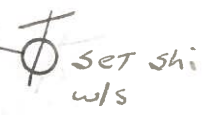

Set shi
w/s


94.77 - P (COVER SNOW BANK)

Fd shi
N/E/S



| PERSONNEL | TITLE | PERSONNEL | TITLE | COUNTY | DATE | WEATHER | TEMP. |
|-----------|-------|-----------|-------|----------------|---------------|---------|-------|
| TAMSU | | | | Fulton | July 12, 1973 | | |
| Granata | | | | S. R. 109 | | | |
| Varys | | | | SEC. YORK TWP. | | | |
| Boyle | | | | | | | |

| DESCRIPTION | LEFT | CENTER LINE | RIGHT | JOB NO. |
|-------------|------|-------------|-------|---------|
|-------------|------|-------------|-------|---------|

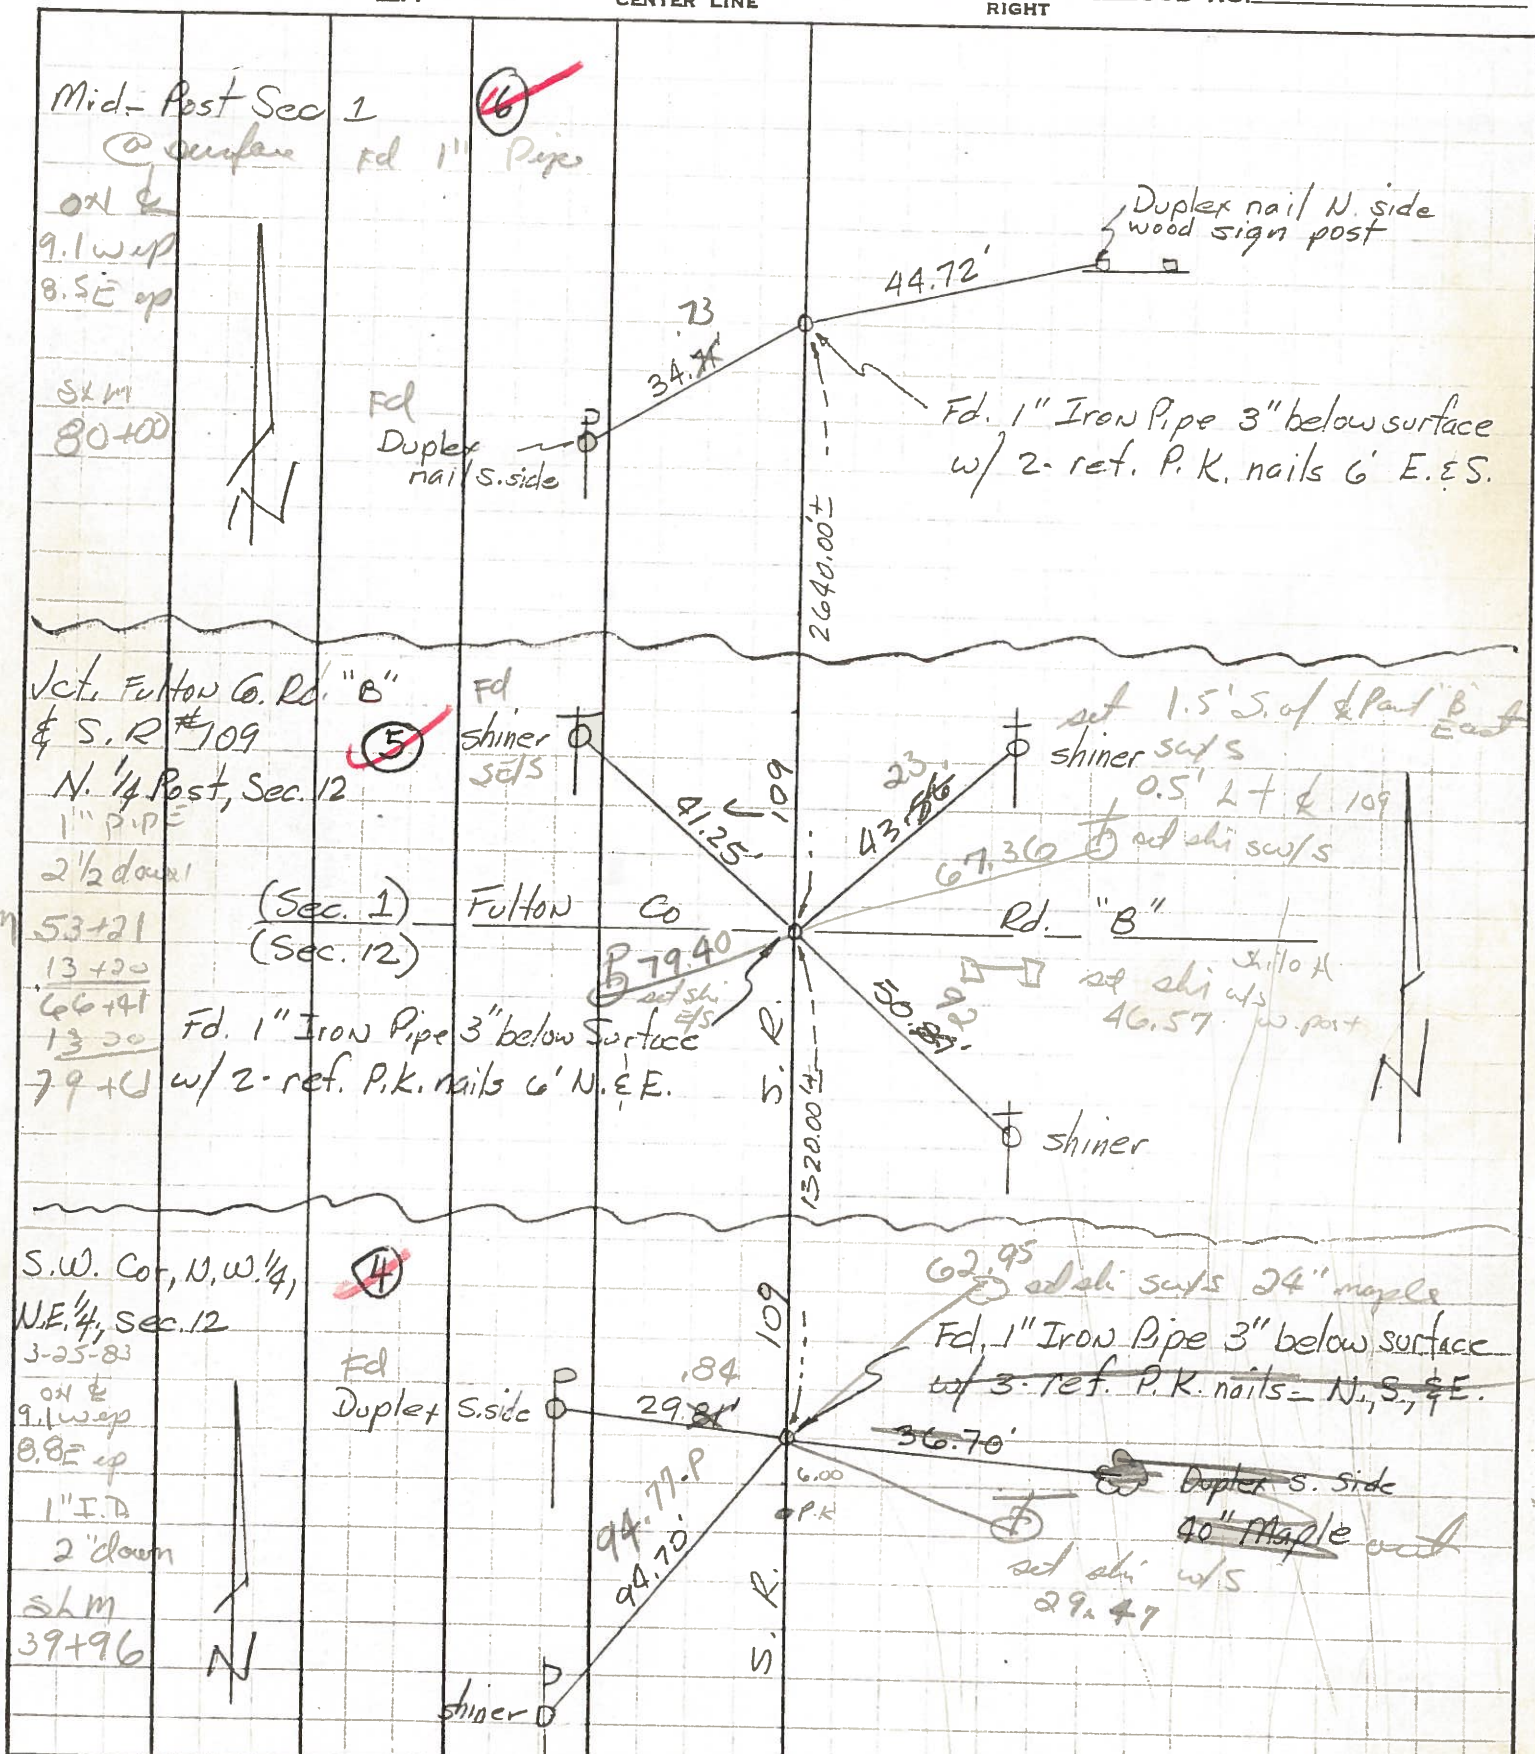

| PERSONNEL | TITLE | PERSONNEL | TITLE | COUNTY | DATE |
|-----------|-------|-----------|-------|--------------------------|-----------|
| Red Beach | | | | Fulton | July 1970 |
| Newcomb | | | | | |
| Knape | | | | S. R. 109 | WEATHER |
| Wise | | | | SEC Liberty Center-Delta | TEMP. |

CONTROL POINTS

