



O.D.O.T. DISTRICT 2 SURVEY OFFICE (USE ONLY)

PERSONNEL	REFERENCE NO. <u>5</u>	SHEET <u>5</u> OF <u>14</u>
NOTES <u>CANTERBURY</u>	DATE <u>07-12-10</u>	ROUTE <u>SR 109</u>
H.C. <u>GOBLE</u>	WEATHER <u>FAIR</u>	COUNTY <u>FULTON</u>
R.C. <u>CANTERBURY</u>	TEMP. <u>80°</u>	TOWNSHIP <u>YORK</u>
		SECTION <u>12</u>
		T <u>6</u> N R <u>7</u> E

TYPE MONUMENT \_\_\_\_\_ SM RR SPK  
 ON SURFACE - BELOW \_\_\_\_\_ 0.15'  
 LEFT - ☉ PAV'T - RIGHT \_\_\_\_\_ 0.5'  
10.4' TO RT EDGE PAVEMENT  
 S.L.M. \_\_\_\_\_ 53+21  
 Grid: Northing: 671952.532 Easting: 1555235.063

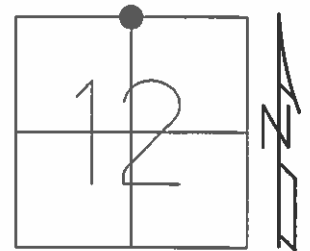

RECORD:  
 N 1/4 COR. SEC 12  
 05-17-83 FD 1" I-PIPE  
 2.5" BELOW, SWH  
 05-17-83 SET SMALL RR SPK, SWH  
 09-16-10 SET MAG/WASGER, EF  
 07-08-10 GPS: CP5

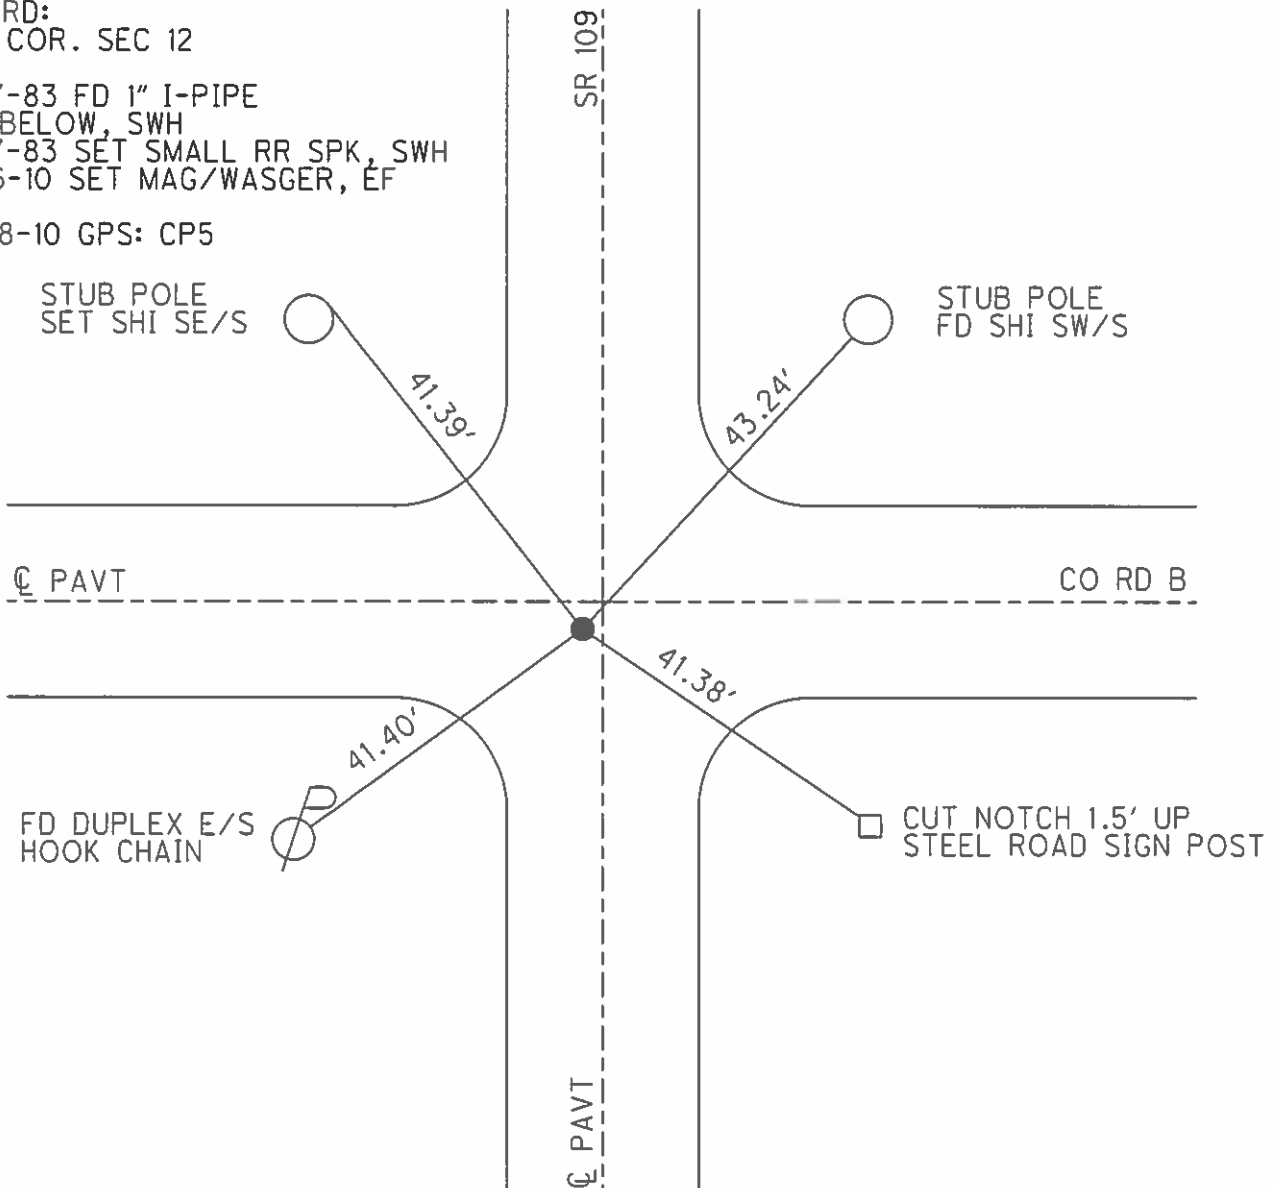

# O.D.O.T. DISTRICT 2 SURVEY OFFICE

PERSONNEL

REFERENCE NO. 5

SHEET 4 OF 27

NOTES BARNHISEL

H.C. COPDES

R.G. SLOVAK

Van Dusen M

DATE 8-9-94

WEATHER Cloudy

TEMP. +60°

ROUTE 109

COUNTY Fulton

TOWNSHIP York

SECTION 12

T 6 N R 7 E

TYPE MONUMENT Sm. RR SPK


ON SURFACE - ~~BELOW~~ YES

LEFT-℄ PAV'T. - ~~RIGHT~~ 0.6

10.4 TO RT EDGE PAVEMENT

S.L.M. 53+21

1.5 S. OF ℄ EAST

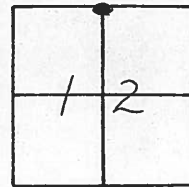

Record:


N. 1/4 COR. Sec 12

Fd 1" I-PIPE 2 1/2" Below

SET SMALL RR SPK

5-17-83

SWH

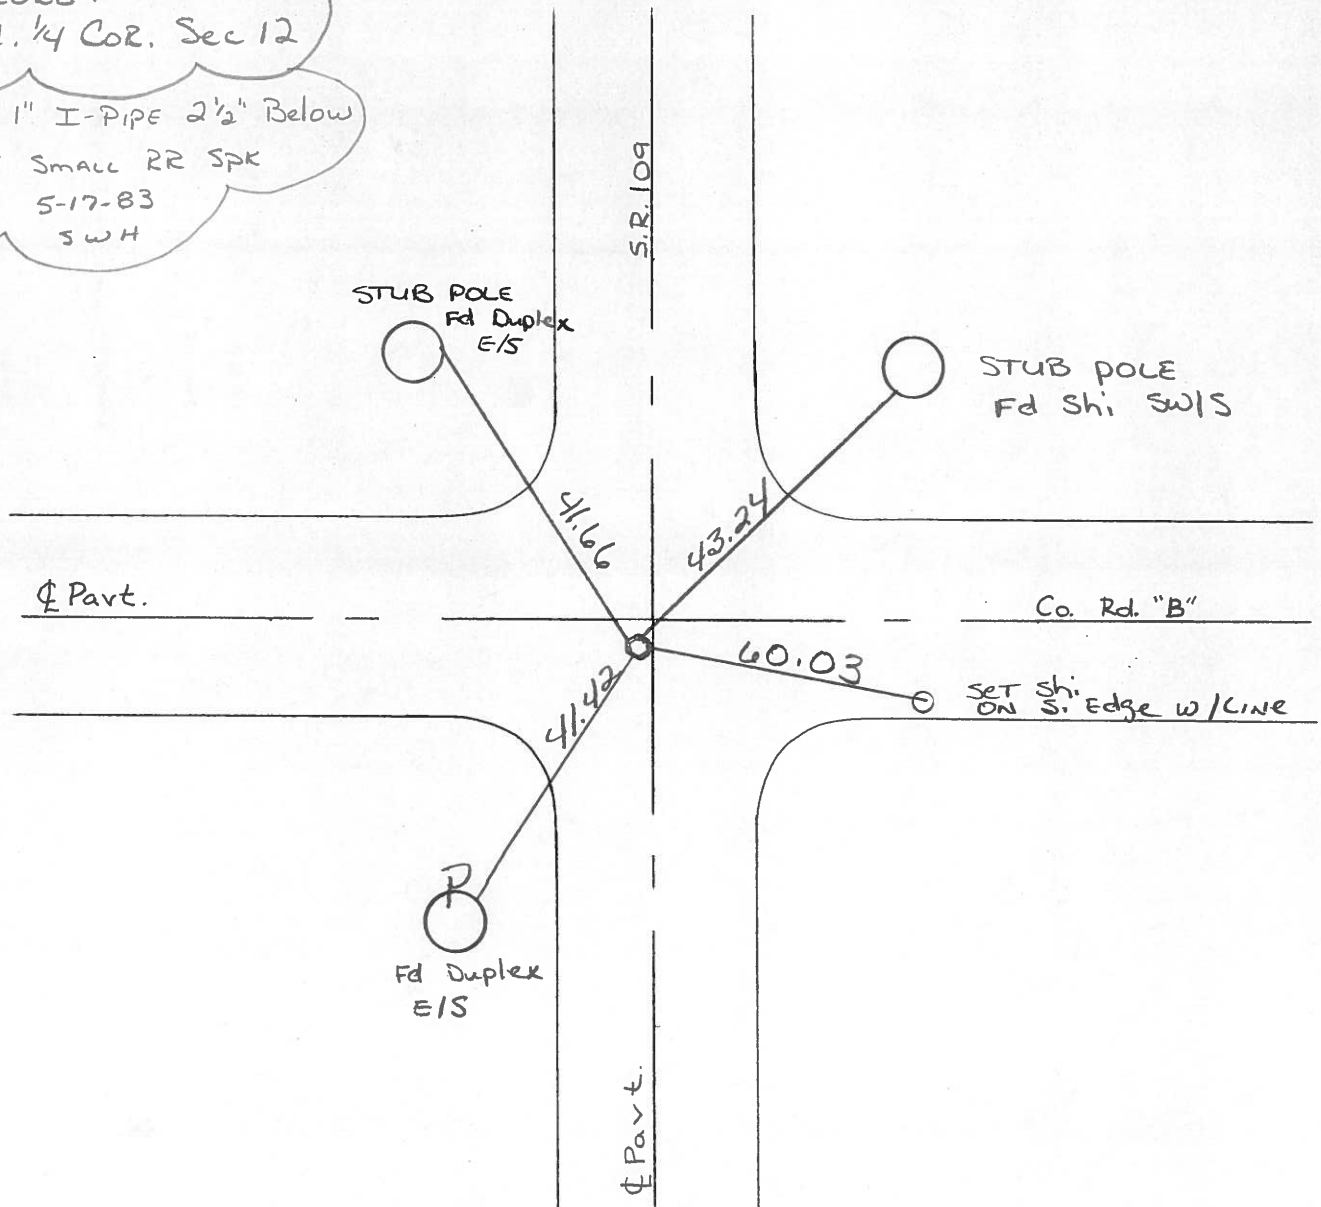

Q.D.O.T. DISTRICT 2 SURVEY OFFICE

SHEET \_\_\_\_\_ OF \_\_\_\_\_

County FULTON S.R. 109

Date MARCH 25, 83

Township YORK

Weather CLEAR

Section 12


Temp. +25°

T6N, R7E

Personnel HOFFMAN

HOUSEHOLDER

BARNHISEL

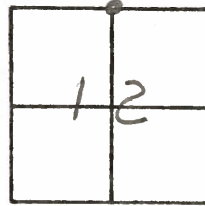

#5

Fd 1" I.D. IRON PIPE 2 1/2" Below SURFACE


SLM 53+21

0.5' N.T. of & PAUT S.R. 109

1.5' SOUTH of & PAUT Co. Rd. "B" EAST


SET SMALL R.R. SPK.  
5-17-83  
S.W.H.

Record:  
N. 1/4 COR SEC 12

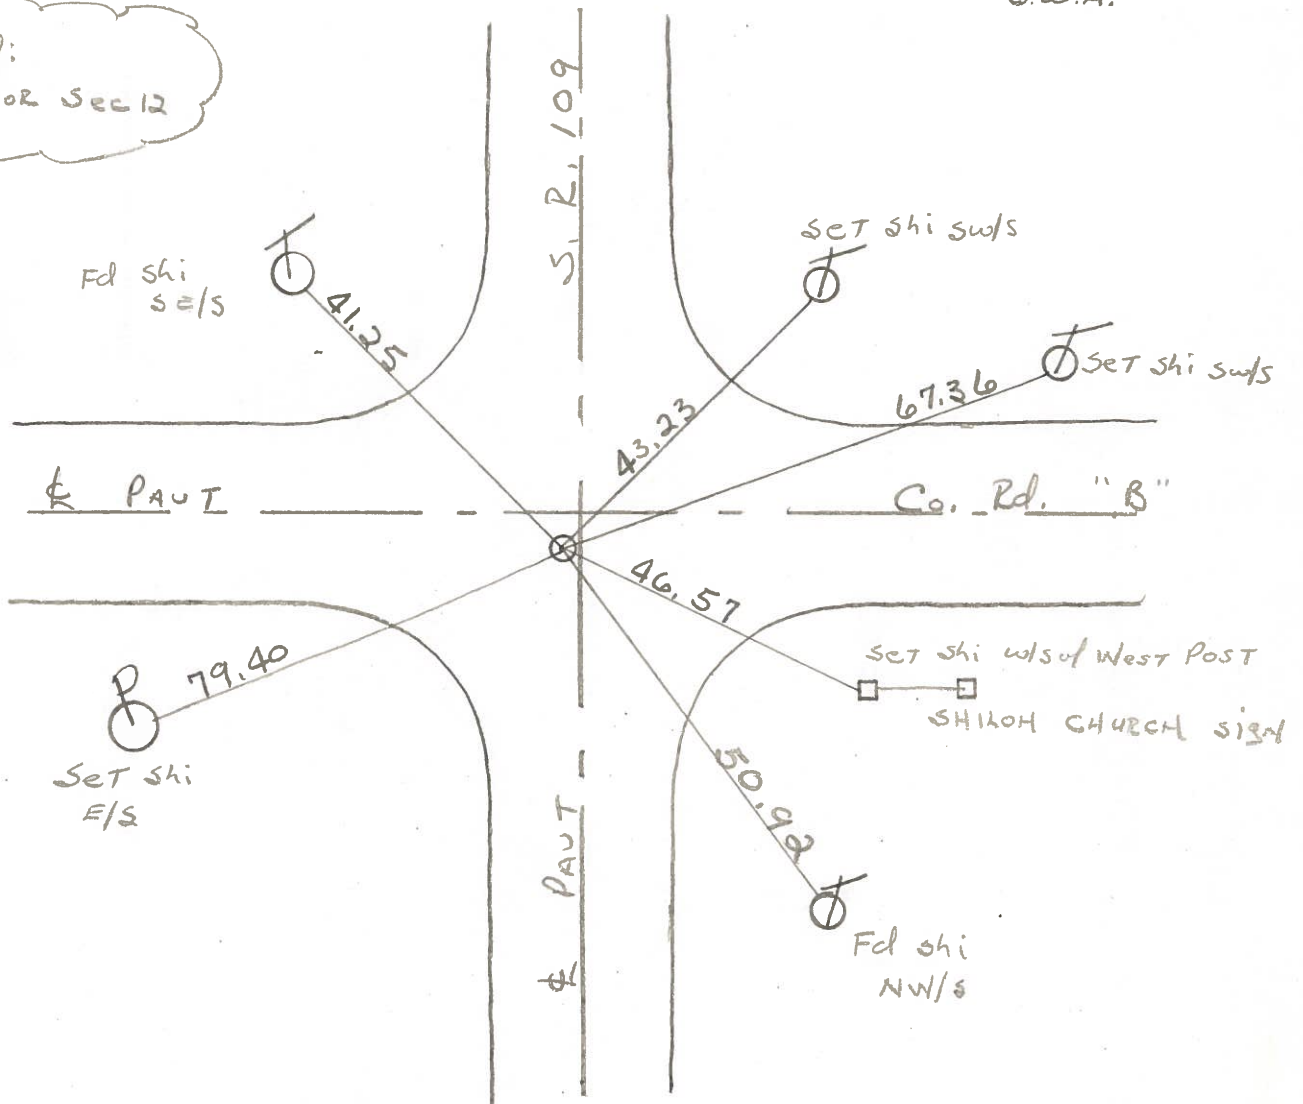

PERSONNEL	TITLE	PERSONNEL	TITLE	COUNTY	DATE	WEATHER	TEMP.
Torres				Fulton	July 12, 1973		
Granata				S. R. 109			
Vandy				SEC. YORK TWP.			
Boyle							

DESCRIPTION \_\_\_\_\_ LEFT \_\_\_\_\_ CENTER LINE \_\_\_\_\_ RIGHT \_\_\_\_\_ JOB NO. \_\_\_\_\_




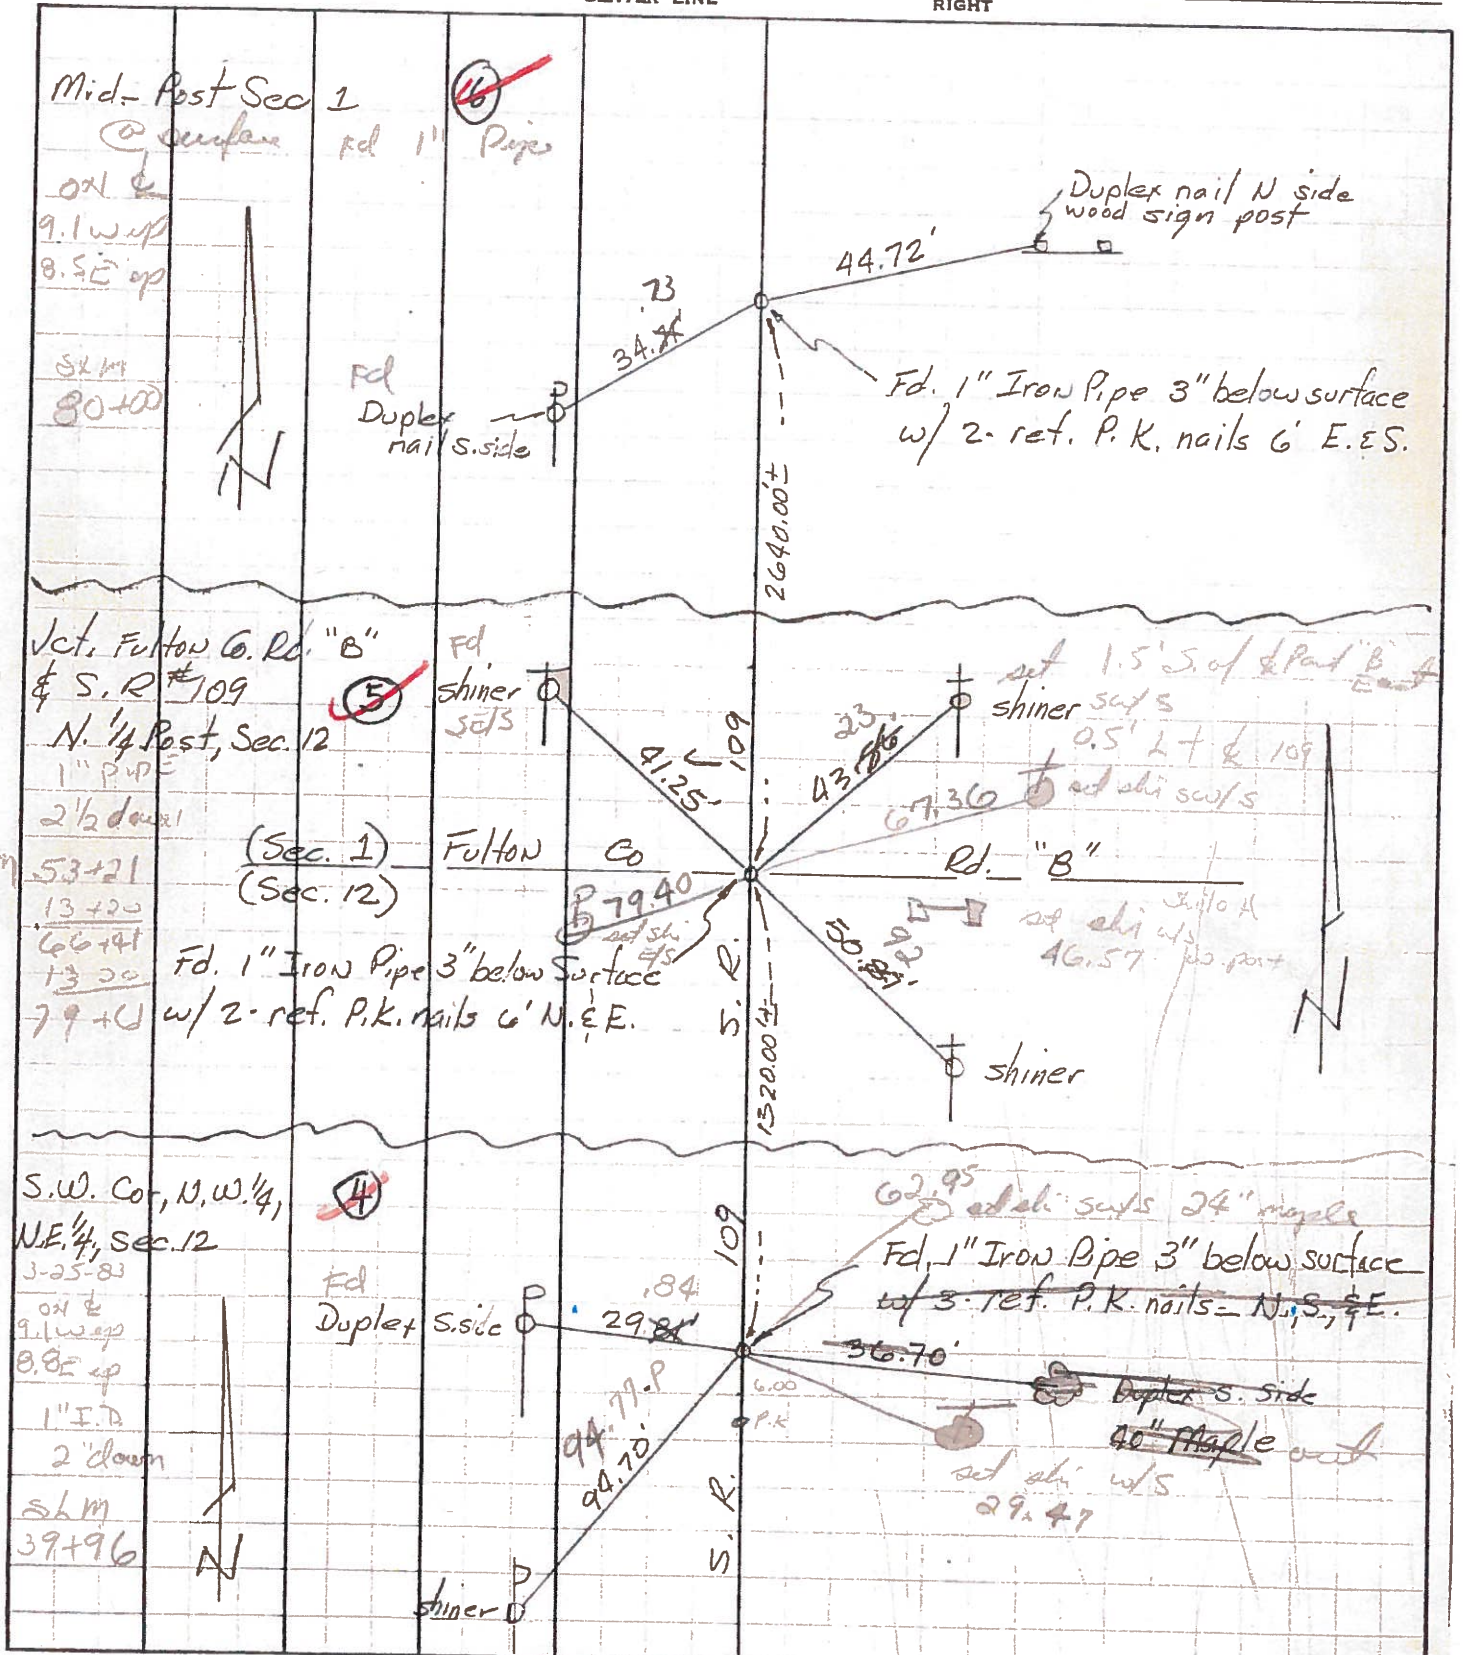




PERSONNEL	TITLE	PERSONNEL	TITLE	COUNTY	DATE
Red Beach				Fulton	July 1970
Newcomb				S. R. 109	WEATHER
Knappe				SEC. York Twp.	TEMP.
Wise					

CONTROL POINTS

DESCRIPTION LEFT CENTER LINE RIGHT JOB NO.

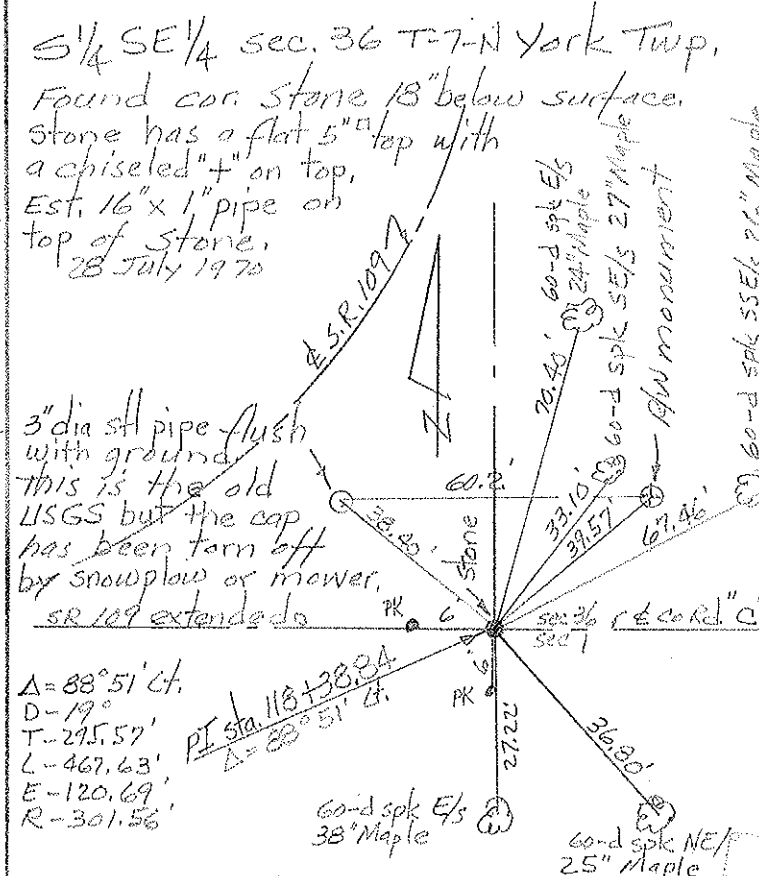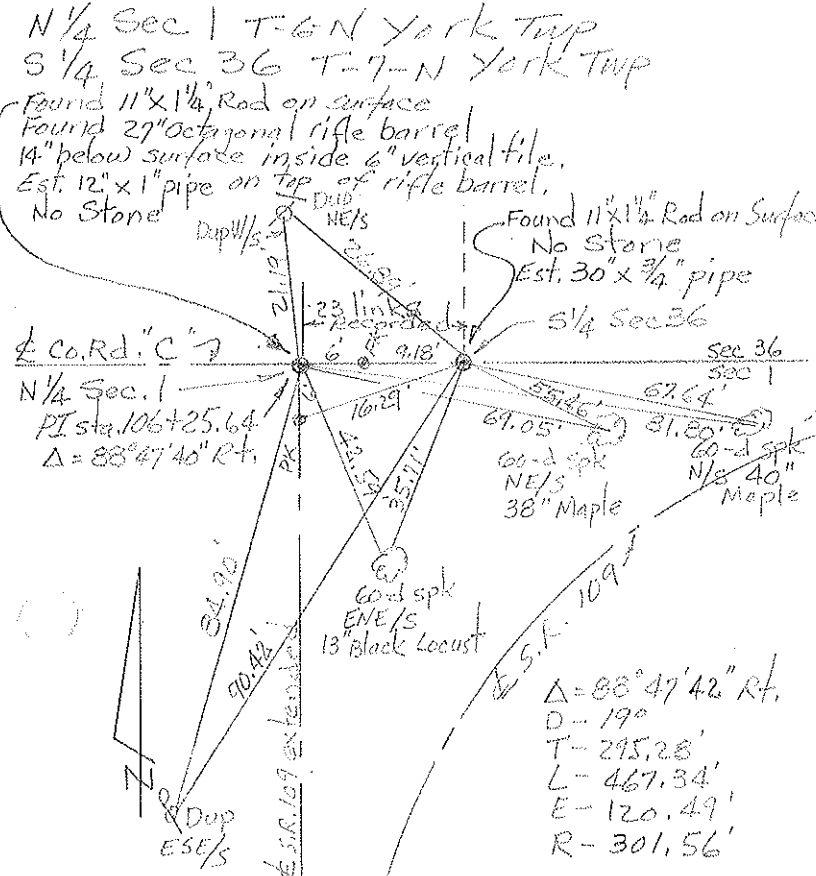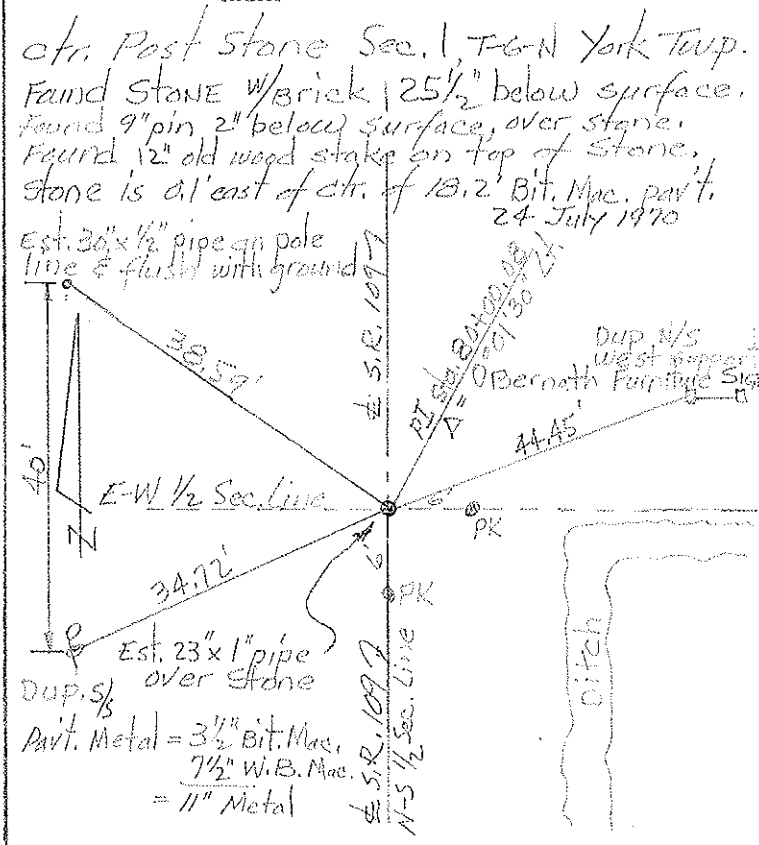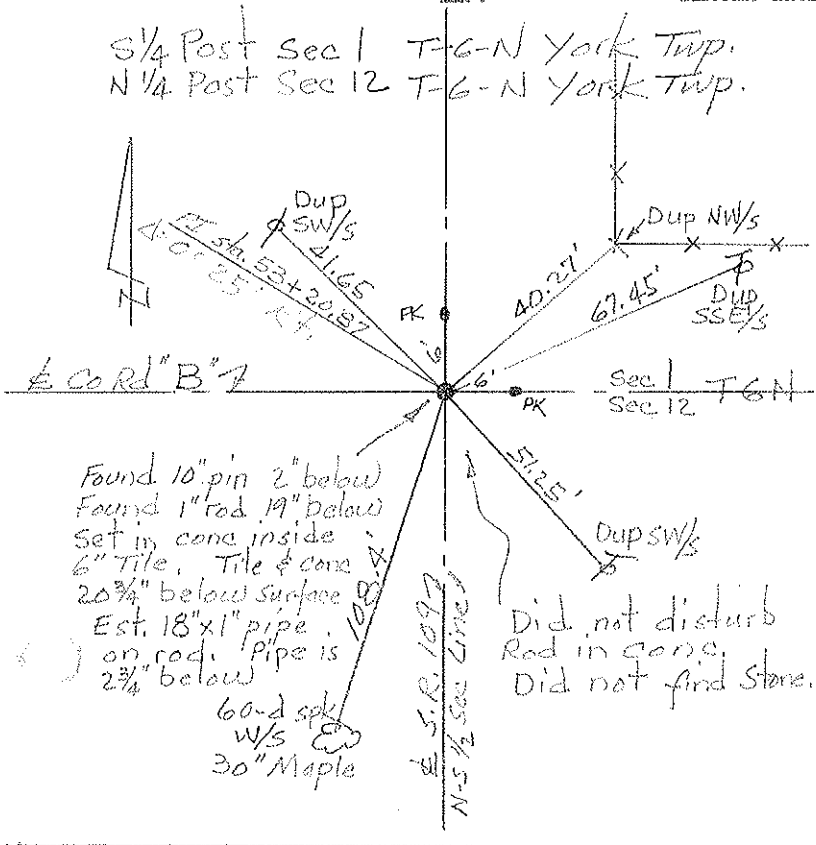

PERSONNEL	TITLE	PERSONNEL	TITLE
Red Beach			
Newcomb			
Knape			
Wise			

COUNTY FULTON DATE JULY 1970

S. R. 109 WEATHER \_\_\_\_\_

SEC. Sec. 12, York Twp, T-6-N TEMP. \_\_\_\_\_

DESCRIPTION ALIGNMENT & CONTROLS JOB NO. \_\_\_\_\_

