



O.D.O.T. DISTRICT 2 SURVEY OFFICE (USE ONLY)

PERSONNEL	REFERENCE NO. <u>6</u>	SHEET <u>6</u> OF <u>14</u>
NOTES <u>CANTERBURY</u>	DATE <u>07-12-10</u>	ROUTE <u>SR 109</u>
H.C. <u>GOBLE</u>	WEATHER <u>CLEAR</u>	COUNTY <u>FULTON</u>
R.C. <u>CANTERBURY</u>	TEMP. <u>82°</u>	TOWNSHIP <u>YORK</u>
		SECTION <u>1</u>
		T <u>6</u> N R <u>7</u> E

TYPE MONUMENT _____ PK/WASHER _____
 ON SURFACE - BELOW _____ ON _____
 LEFT - C PAV'T - RIGHT _____ ON _____
10.0' TO RT EDGE PAVEMENT
 S.L.M. _____ 80+01 _____

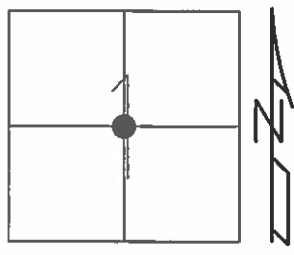

Grid: Northing: 674630.626 Easting: 1555294.136

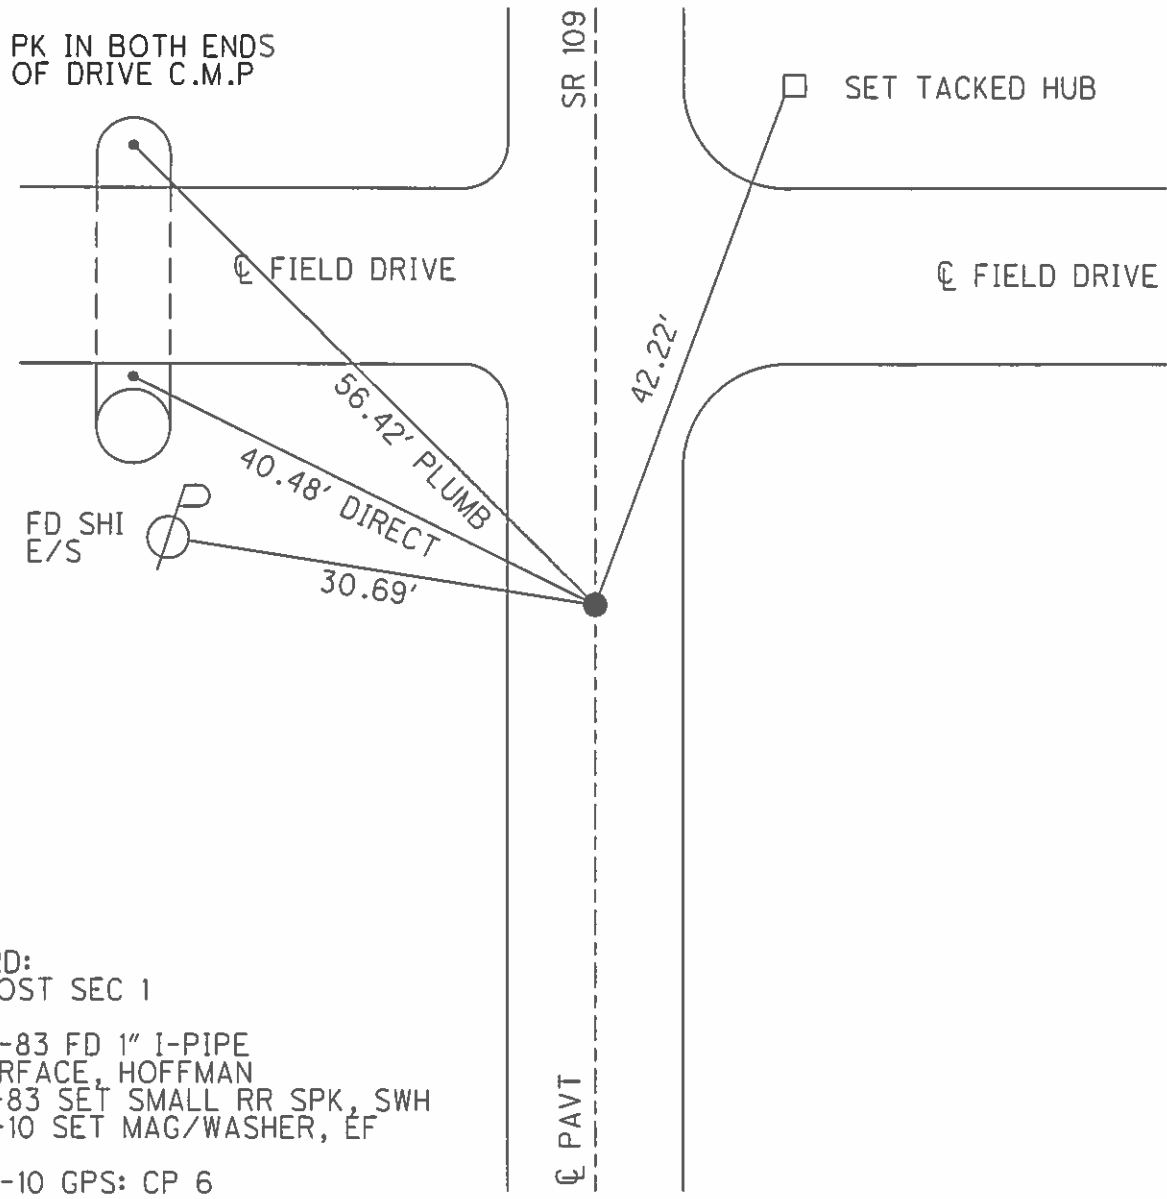

RECORD:
 MID-POST SEC 1
 03-25-83 FD 1" I-PIPE
 AT SURFACE, HOFFMAN
 05-17-83 SET SMALL RR SPK, SWH
 09-16-10 SET MAG/WASHER, EF
 07-08-10 GPS: CP 6

O.D.O.T. DISTRICT-2 SURVEY OFFICE

PERSONNEL

REFERENCE NO. 6

SHEET 5 OF 27

NOTES BARNHISEL

H.C. Hermiller

R.C. CANTERBURY

Cordes 

SLOUAK

DATE 8-10-94

WEATHER CLEAR

TEMP. +60°

ROUTE 109

COUNTY FULTON

TOWNSHIP YORK

SECTION 1

T6 NR 7 E


TYPE MONUMENT Sm RR Spk

ON SURFACE - ~~BELOW~~ yes

~~LEFT - & PAV'T. - RIGHT~~ yes

9.6 TO R+EDGE PAVEMENT

S.L.M. 80+01

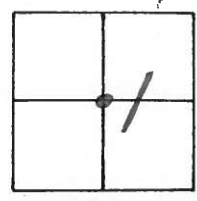


RECORD:
Mid-Post Sec 1

Fd 1" I-PIPE AT SURFACE
3-25-83
HOFFMAN

SET SMALL RR SPK
5-17-83
SWH

S.R. 109

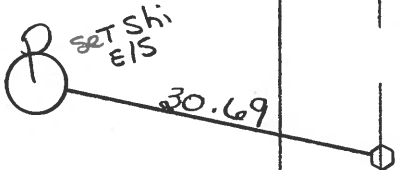

E PAV'T

Q.D.O.T. DISTRICT 2 SURVEY OFFICE

SHEET _____ OF _____

County FULTON S.R. 109

Date MARCH 25, 83

Township YORK

Weather CLEAR

Section 1

Temp. +30°


T4N, R7E

Personnel HOFFMAN

HOUSEHOLDER

BARNHISEL

6

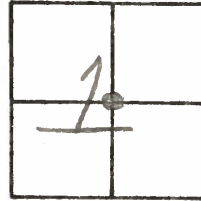

Fd 1" I.D. IRON PIPE @ SURFACE

ON & PAUT


9.1 TO W.E.P.

8.5 TO E.E.P.

S.L.M. 80+00


Record:
MID POST
Sec 1

SET SMALL R.P. SPK.
S-1183
S.W.H.

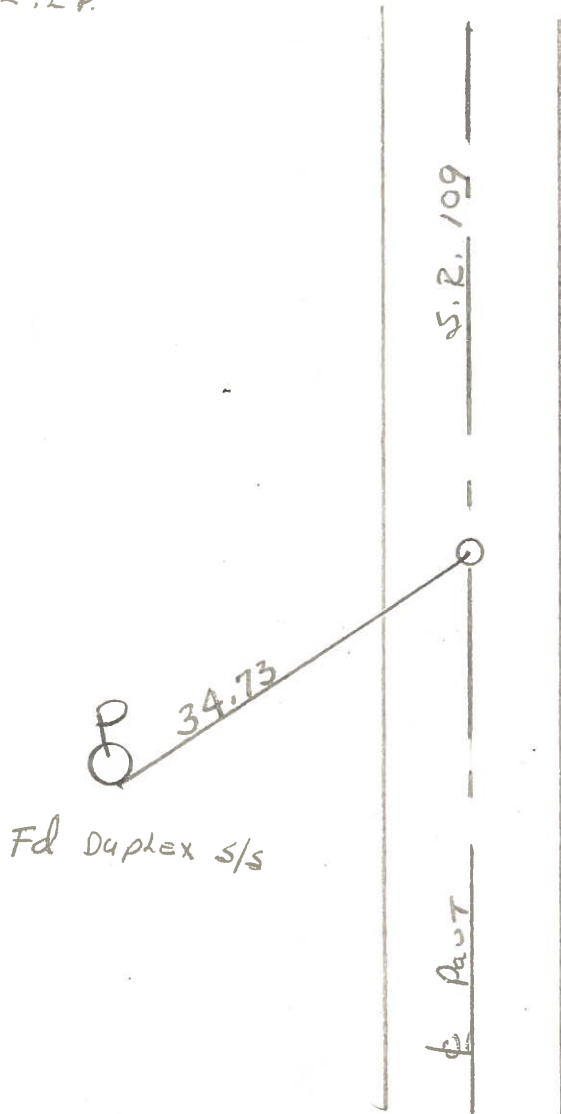

PERSONNEL	TITLE	PERSONNEL	TITLE	COUNTY	DATE	WEATHER	TEMP.
TAMMIE				Fulton	July 12, 1973		
Granata				S. R. 109			
Vince				SEC. YORK TWP.			
Boyle							

DESCRIPTION _____ LEFT _____ CENTER LINE _____ RIGHT _____ JOB NO. _____

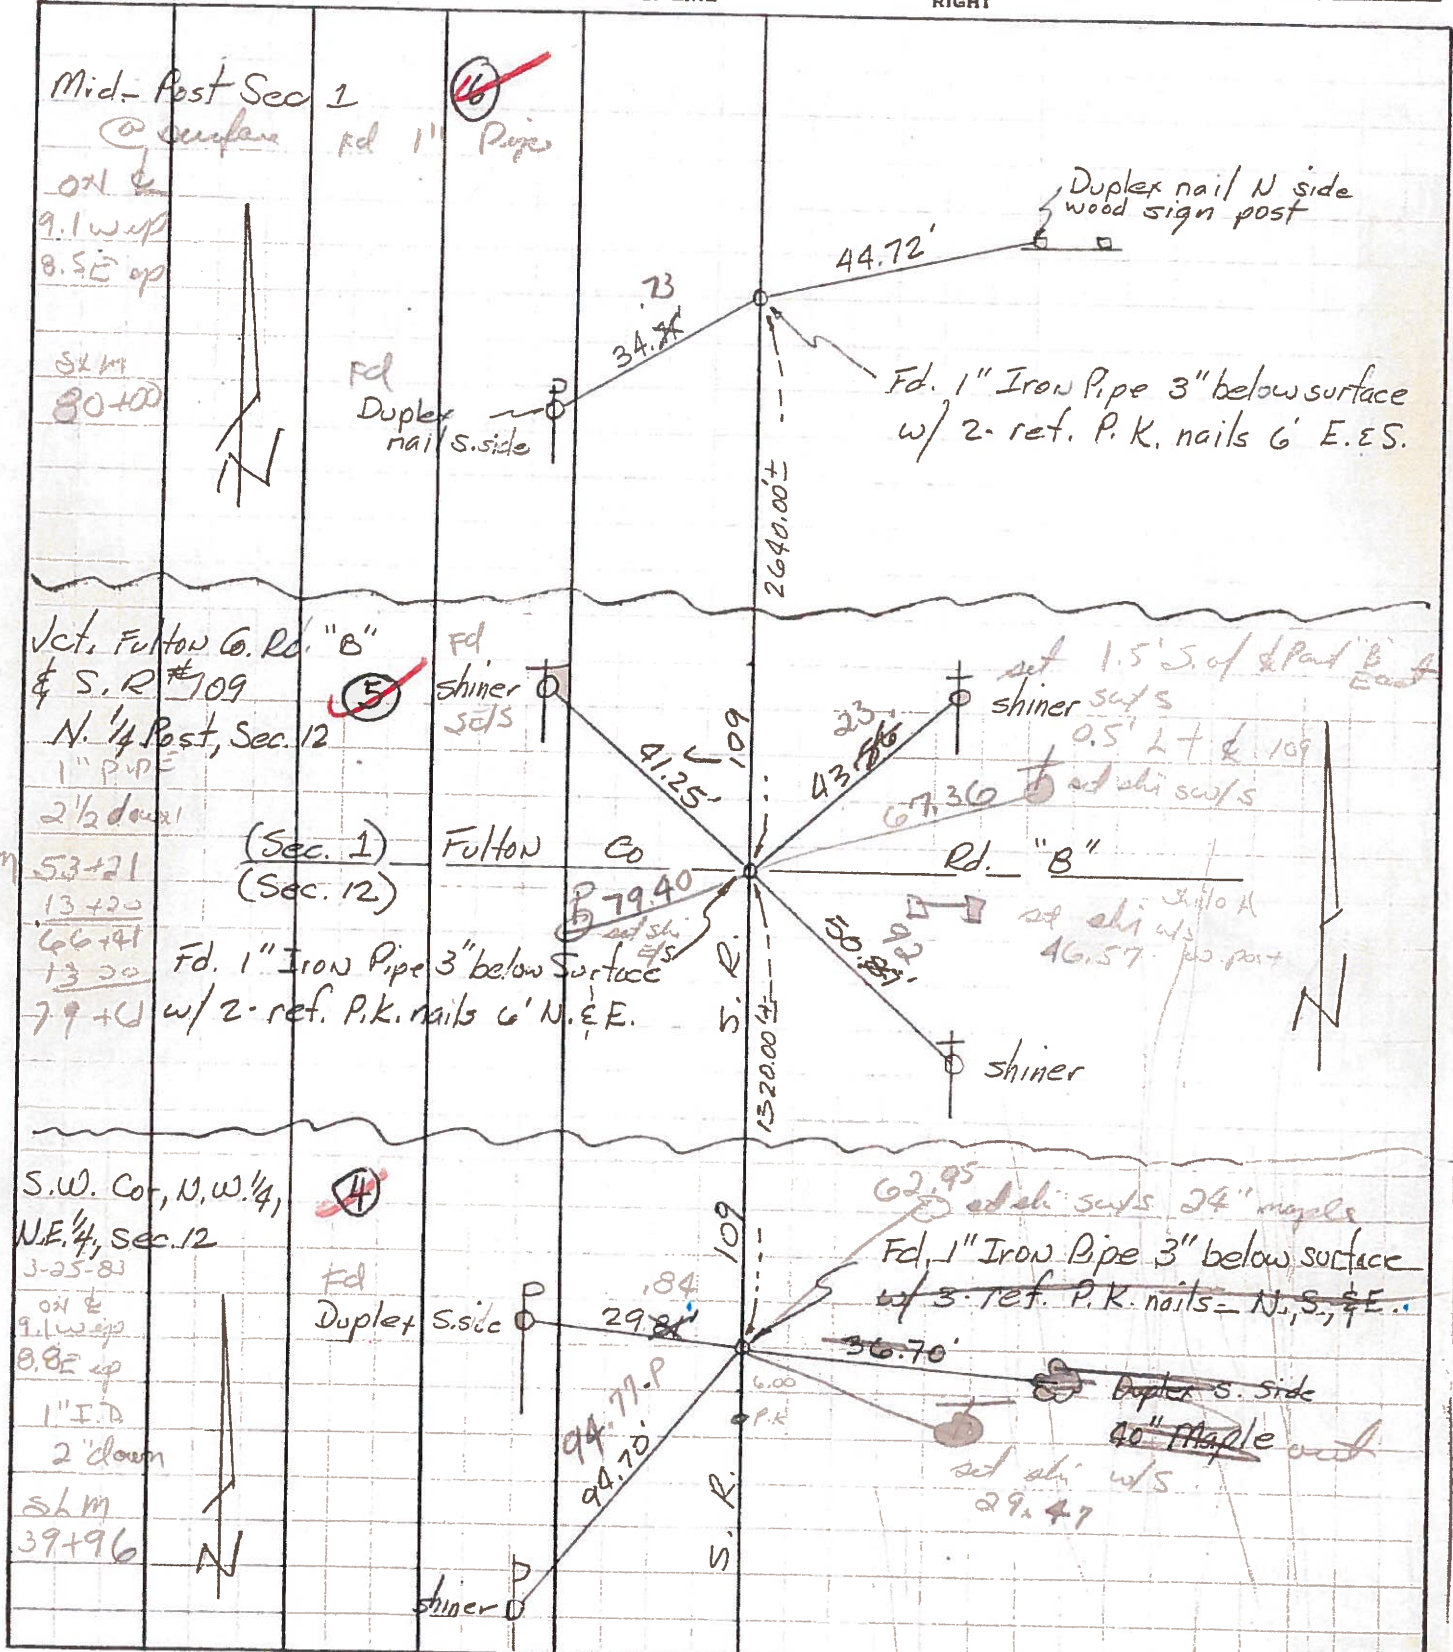

PERSONNEL	TITLE	PERSONNEL	TITLE	COUNTY	DATE
Red Beach				Fulton	July 1970
Newcomb					
Knape				S. R. 109	WEATHER
Wise				SEC. Sec. 1 T-6-N YORK Twp	TEMP.

ALIGNMENT & CONTROLS

