

O.D.O.T. DISTRICT 2 SURVEY OFFICE (USE ONLY)

PERSONNEL

REFERENCE NO. 7-A

SHEET 7 OF 14

NOTES HUSS

DATE 07-14-10

ROUTE SR 109

H.C. FINTEL

WEATHER CLEAR

COUNTY FULTON

R.C. CANTERBURY

TEMP. 87°

TOWNSHIP YORK

SECTION 1

T 6 N R 7 E

TYPE MONUMENT _____ LG SPK _____



ON SURFACE - BELOW _____ ON _____

LEFT - $\text{\textcircled{C}}$ PAV'T - RIGHT _____ ON _____

9.7' TO N EDGE PAVEMENT

S.L.M. _____

Grid: Northing: 677254.919 Easting: 1555350.897

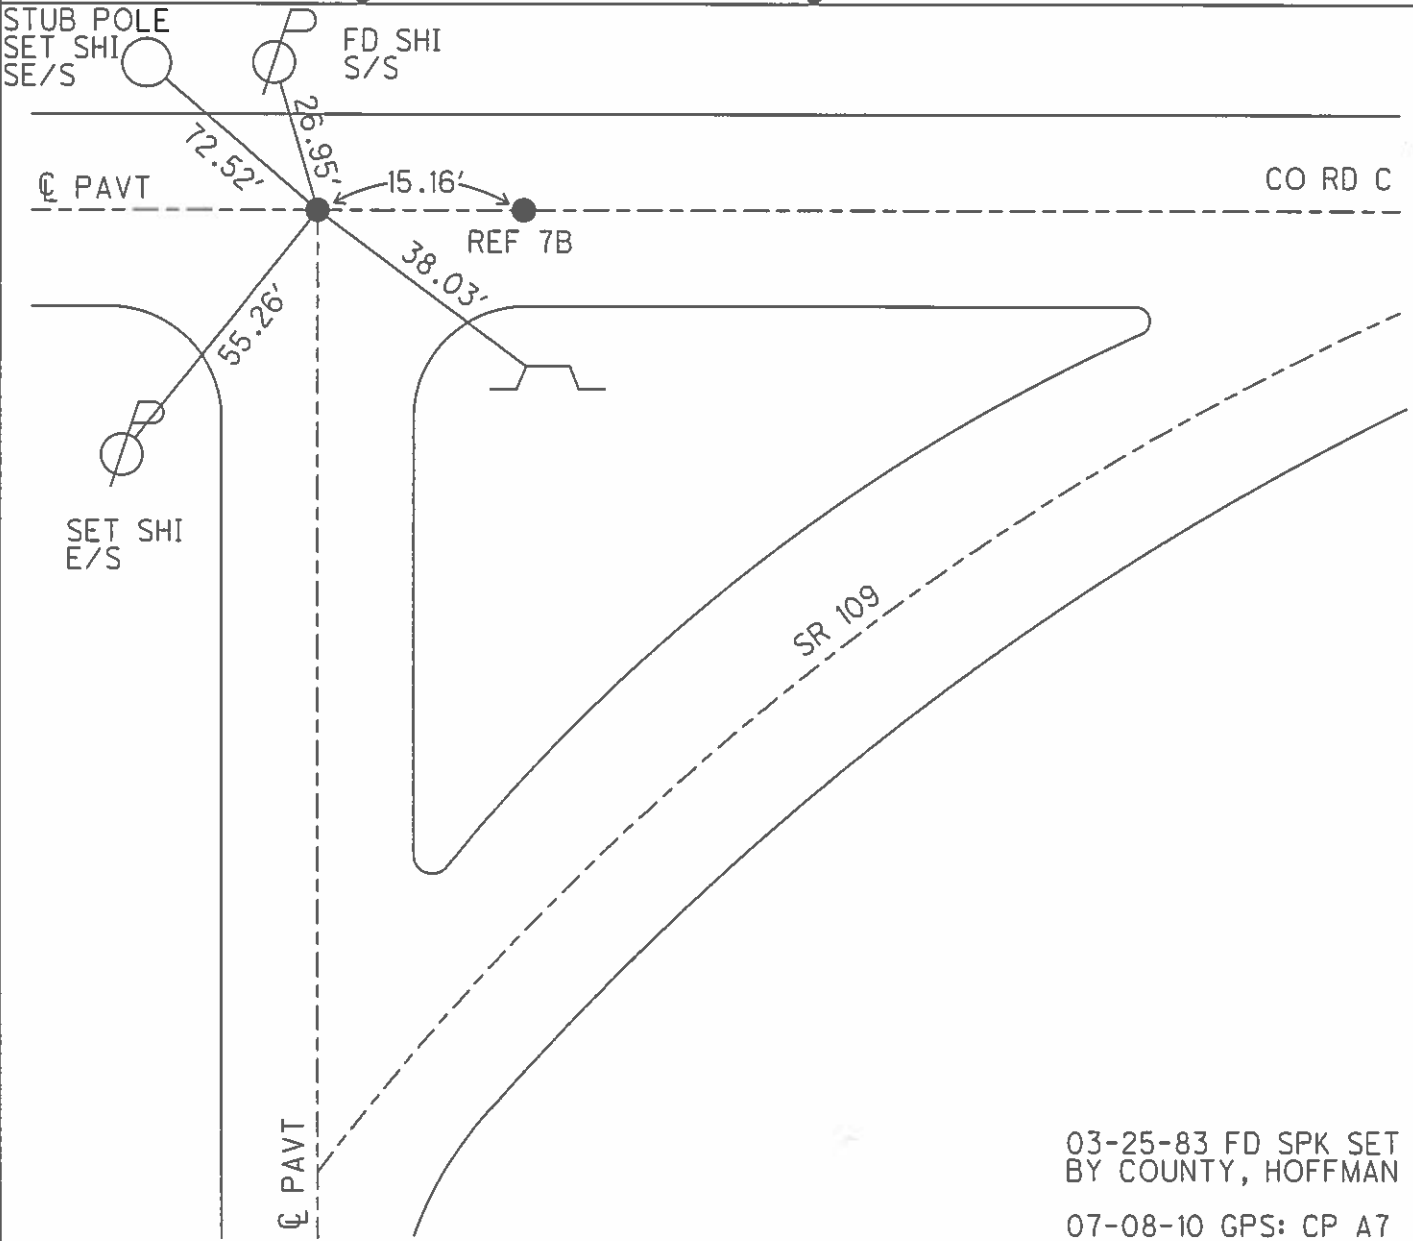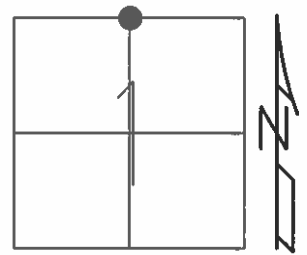

03-25-83 FD SPK SET
BY COUNTY, HOFFMAN
07-08-10 GPS: CP A7

O.D.O.T. DISTRICT 2 SURVEY OFFICE

PERSONNEL

REFERENCE NO. 7

SHEET 6 OF 27

NOTES BARNHISEL

H.C. CANTERBURY

DATE 8-10-94

ROUTE 109

R.C. HERMILLER

WEATHER clear

COUNTY FULTON

CORDS

TEMP. +60°

TOWNSHIP YORK

SLOVAK

SECTION 1

T6 NR 7 E


TYPE MONUMENT Lg Spk's

ON SURFACE - ~~NO~~ yes


LEFT - Q PAU'T - RIGHT -

^{9.7}
_{10.0} TO NORTH EDGE PAVEMENT

S.L.M. -

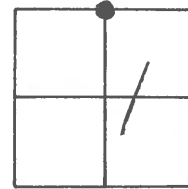

Fd Spk's SET BY COUNTY
3-25-83
HOFFMAN

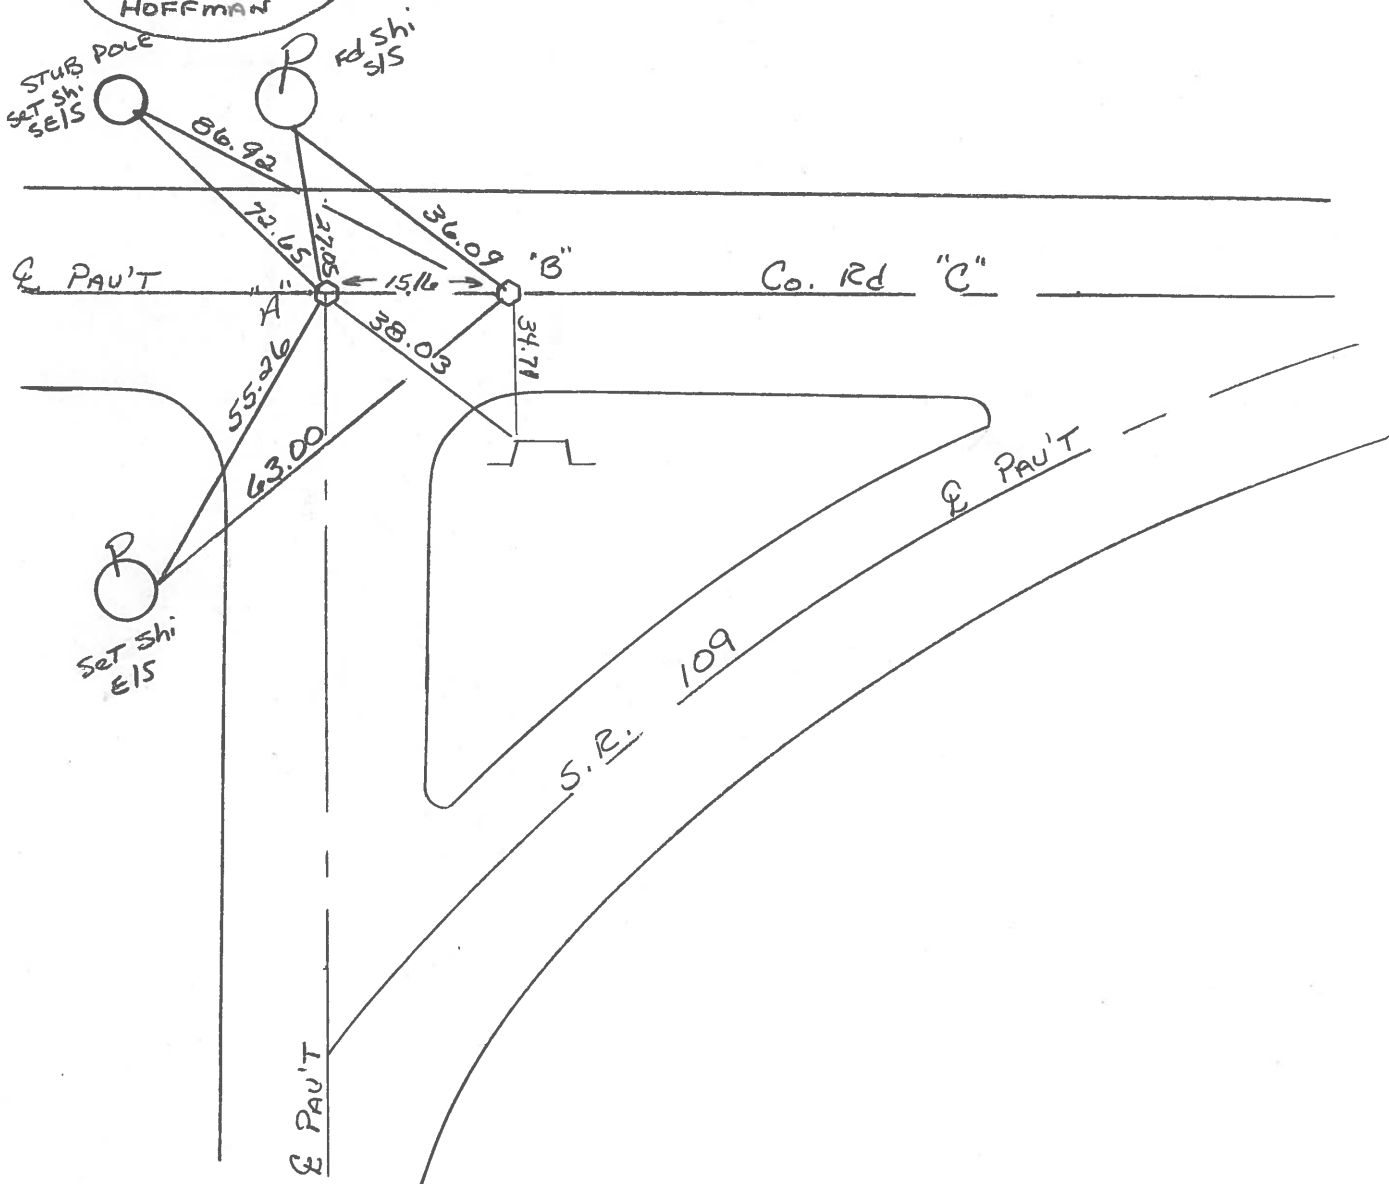

Q.D.O.T. DISTRICT 2 SURVEY OFFICE

SHEET _____ OF _____

County FULTON S.R. 109

Date MARCH 25, 83

Township YORK

Weather CLEAR

Section 1

Temp. +30°


T6N, R7E

Personnel HOFFMAN


HOUSEHOLDER

BARNHISEL

#7

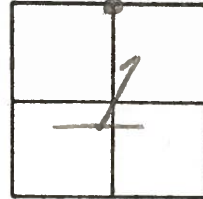


Fd spks AT SURFACE SET BY COUNTY
10.7' TO N.E.P. of Co. Rd "C"

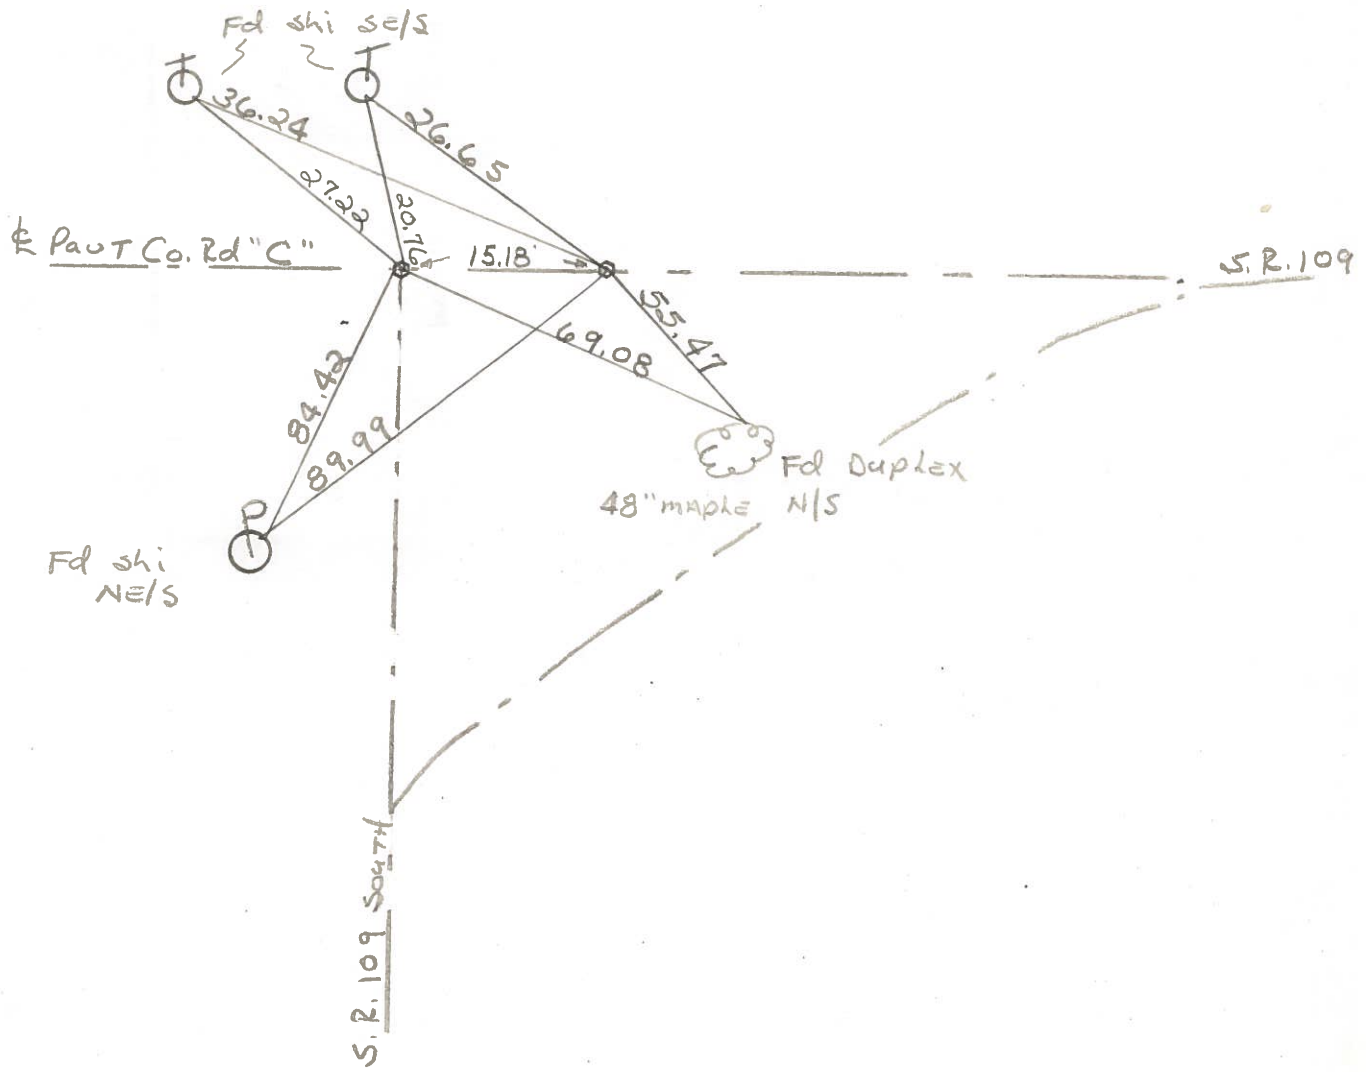

PERSONNEL	TITLE	PERSONNEL	TITLE	COUNTY	DATE	WEATHER	TEMP.
Truscio				Fulton	July 13, 1973		
Granata				S. R. 109			
Vanno				SEC. York TWD.			
Boyle							





DESCRIPTION _____ LEFT _____ CENTER LINE _____ RIGHT _____ JOB NO. _____

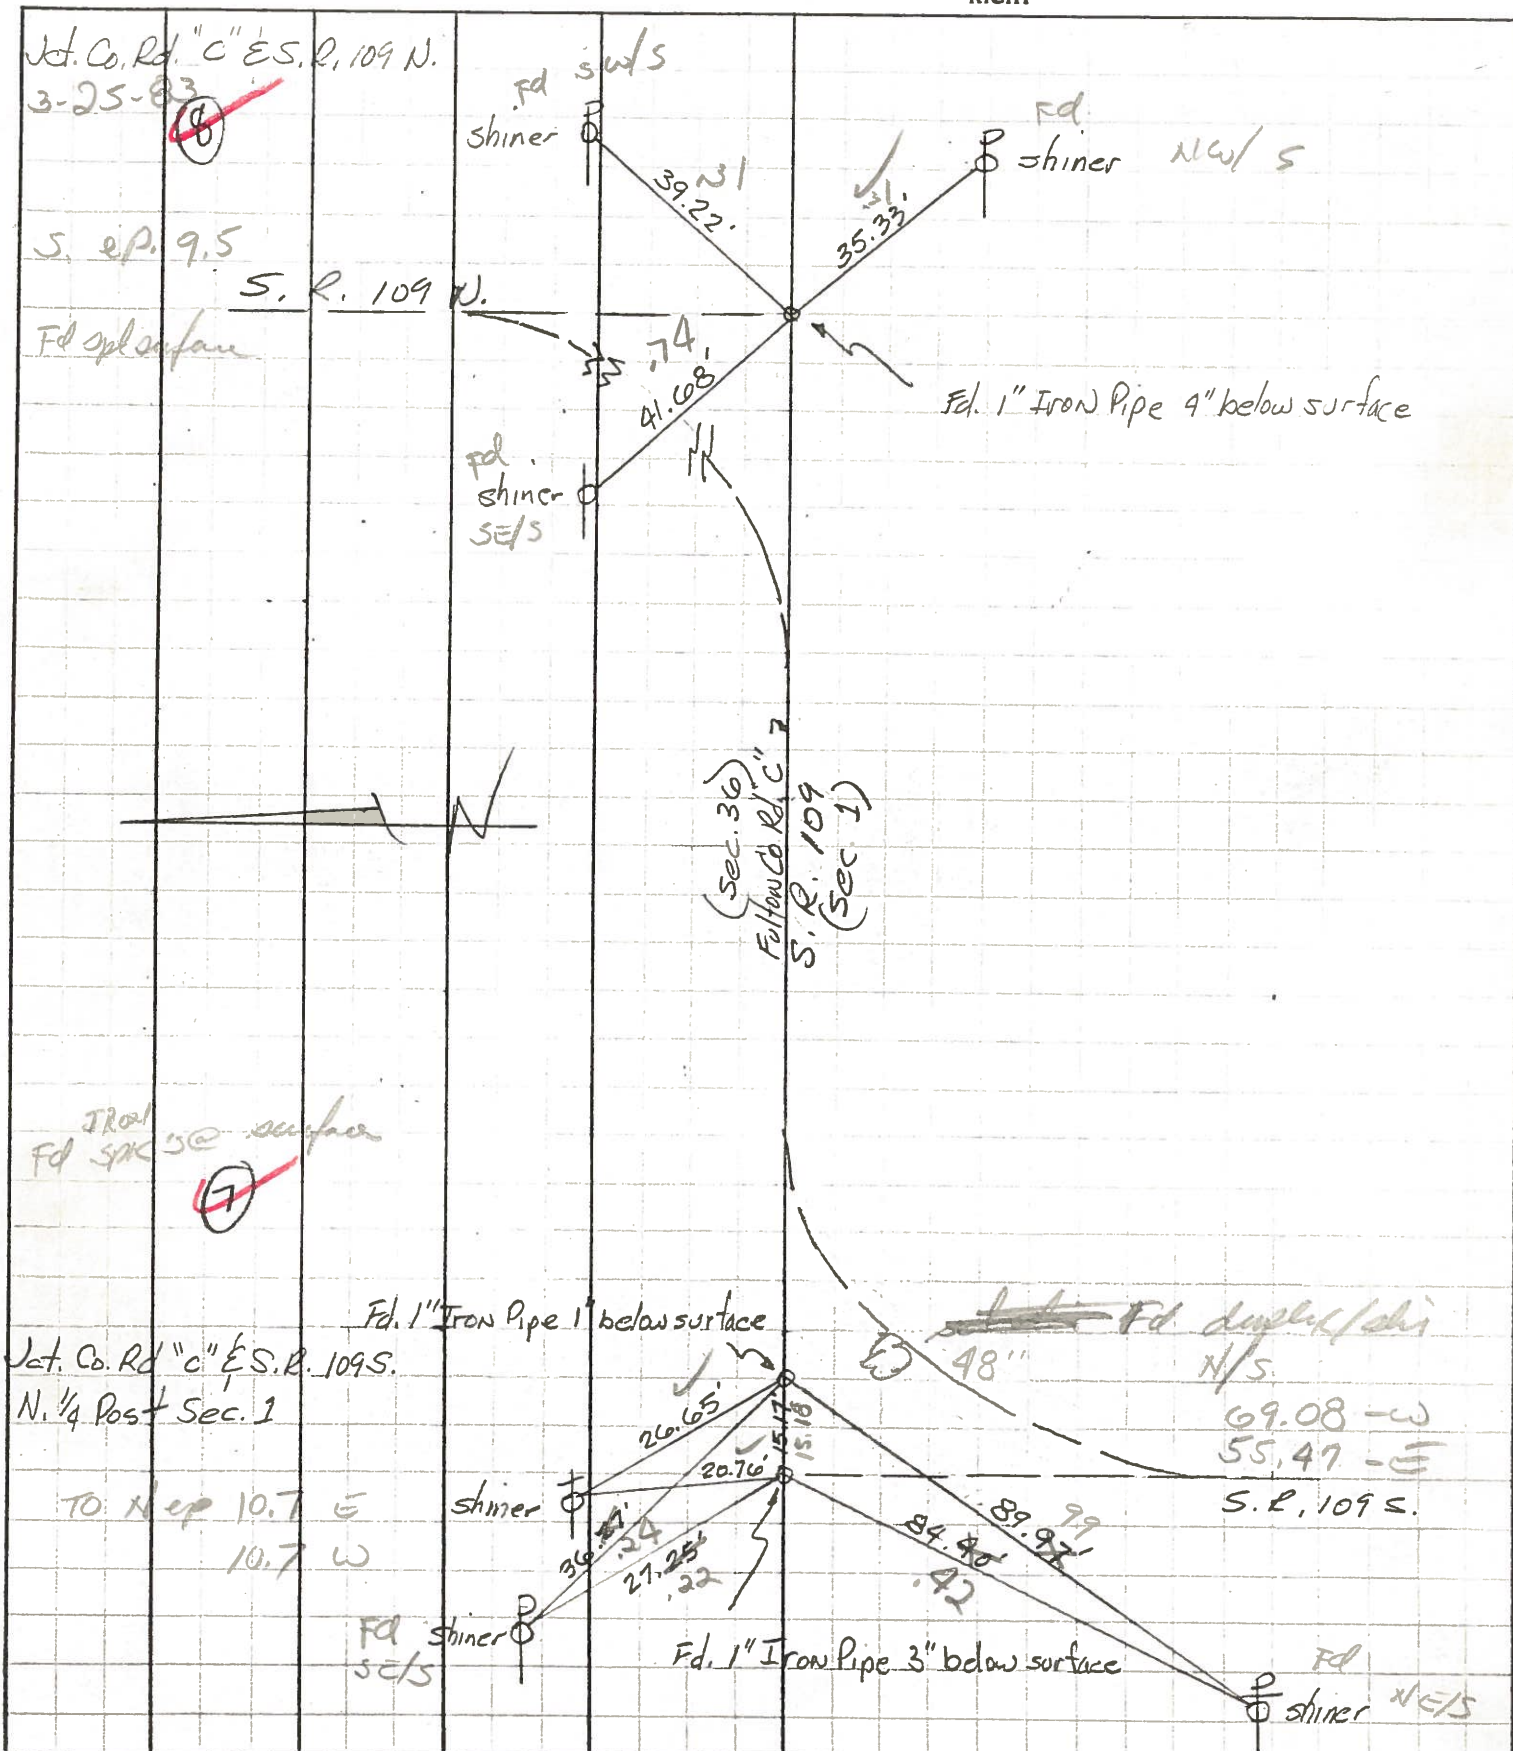

PERSONNEL	TITLE	PERSONNEL	TITLE	COUNTY	DATE
Red Beach				Fulton	July 1970
Newcomb				S. R. 109	WEATHER
Knappe				SEC. York Twp.	TEMP.
Wise					


CONTROL POINTS

DESCRIPTION LEFT CENTER LINE RIGHT JOB NO.

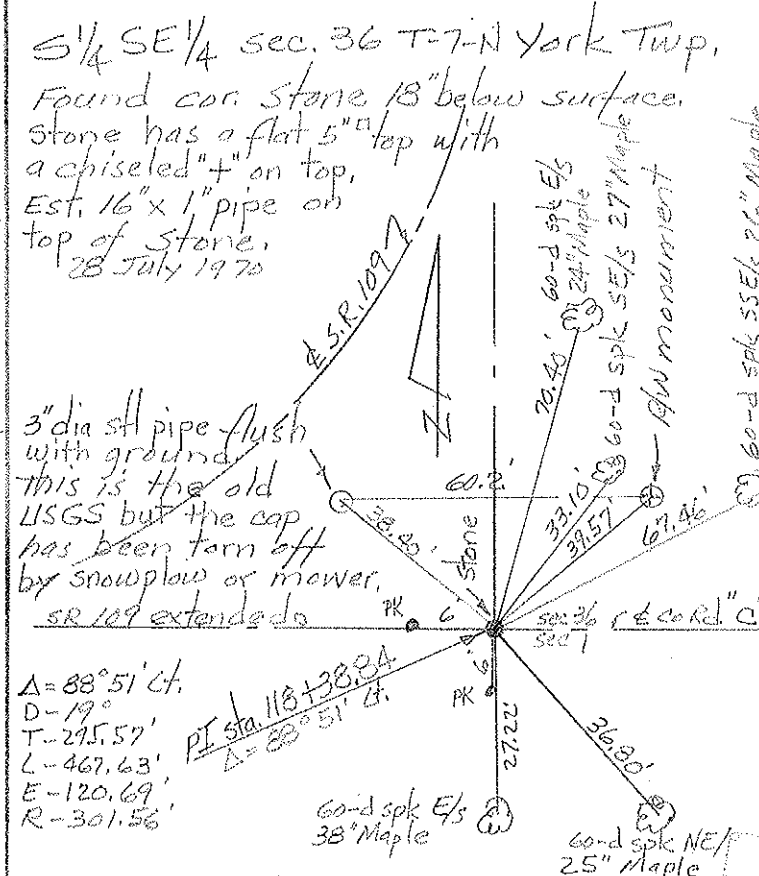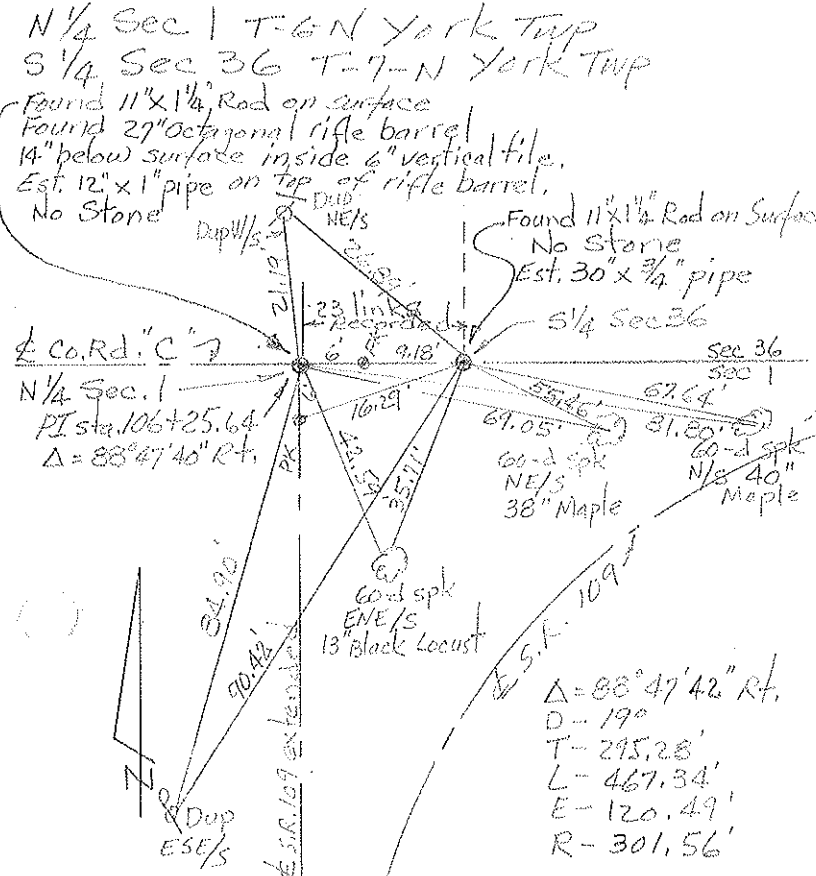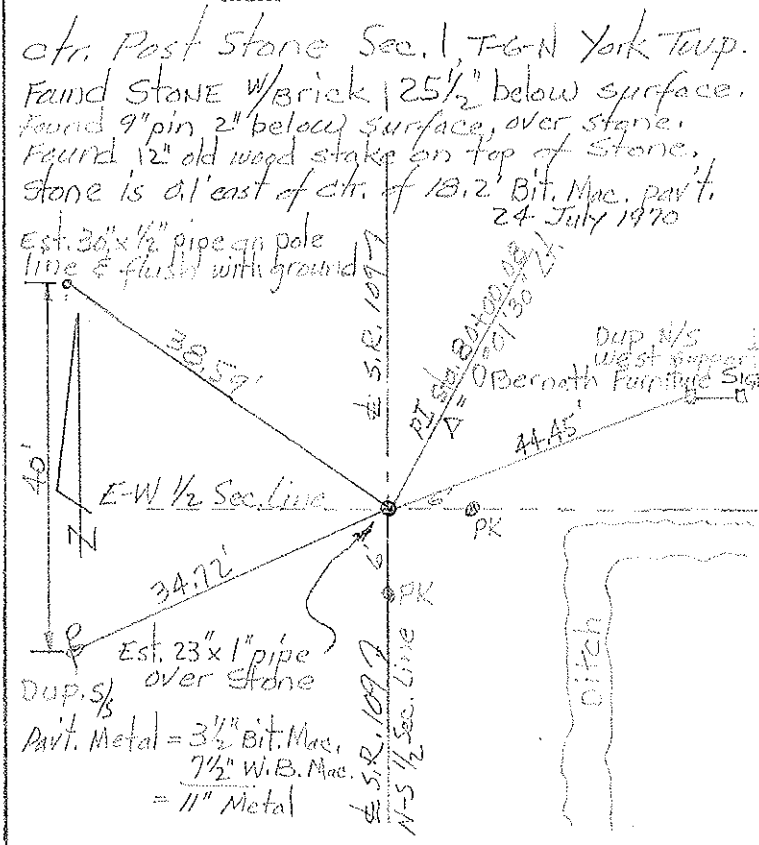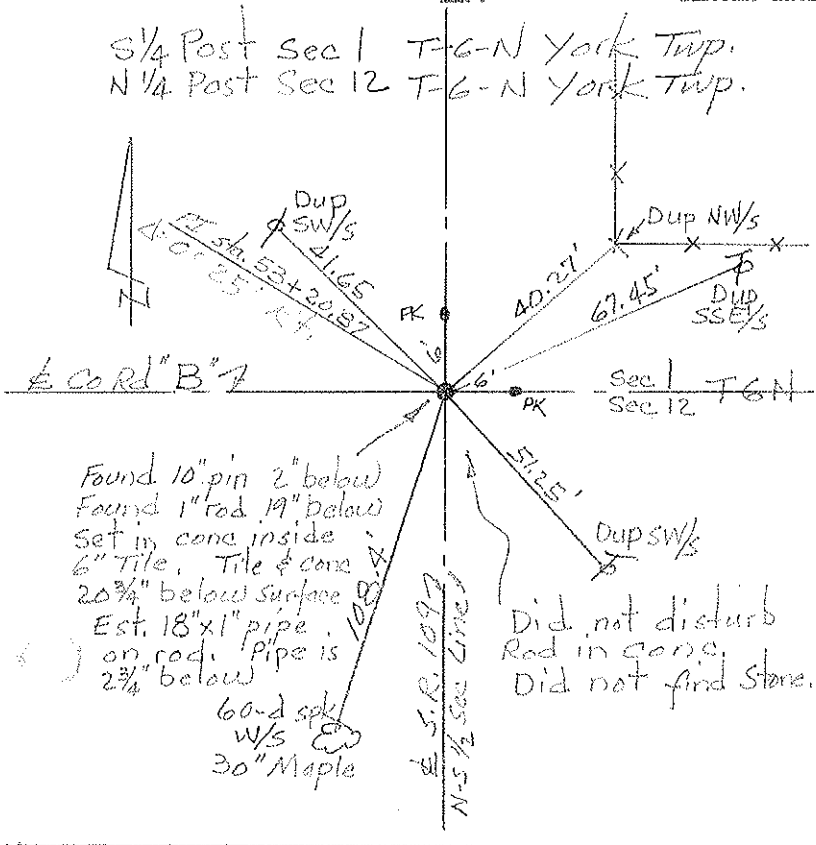

PERSONNEL	TITLE	PERSONNEL	TITLE	COUNTY	DATE
Red Beach				Fulton	July 1970
Newcomb				S. R. 109	WEATHER
Knape				SEC. Sec. 1 T-6-N YORK Twp	TEMP.
Wise					


ALIGNMENT & CONTROLS

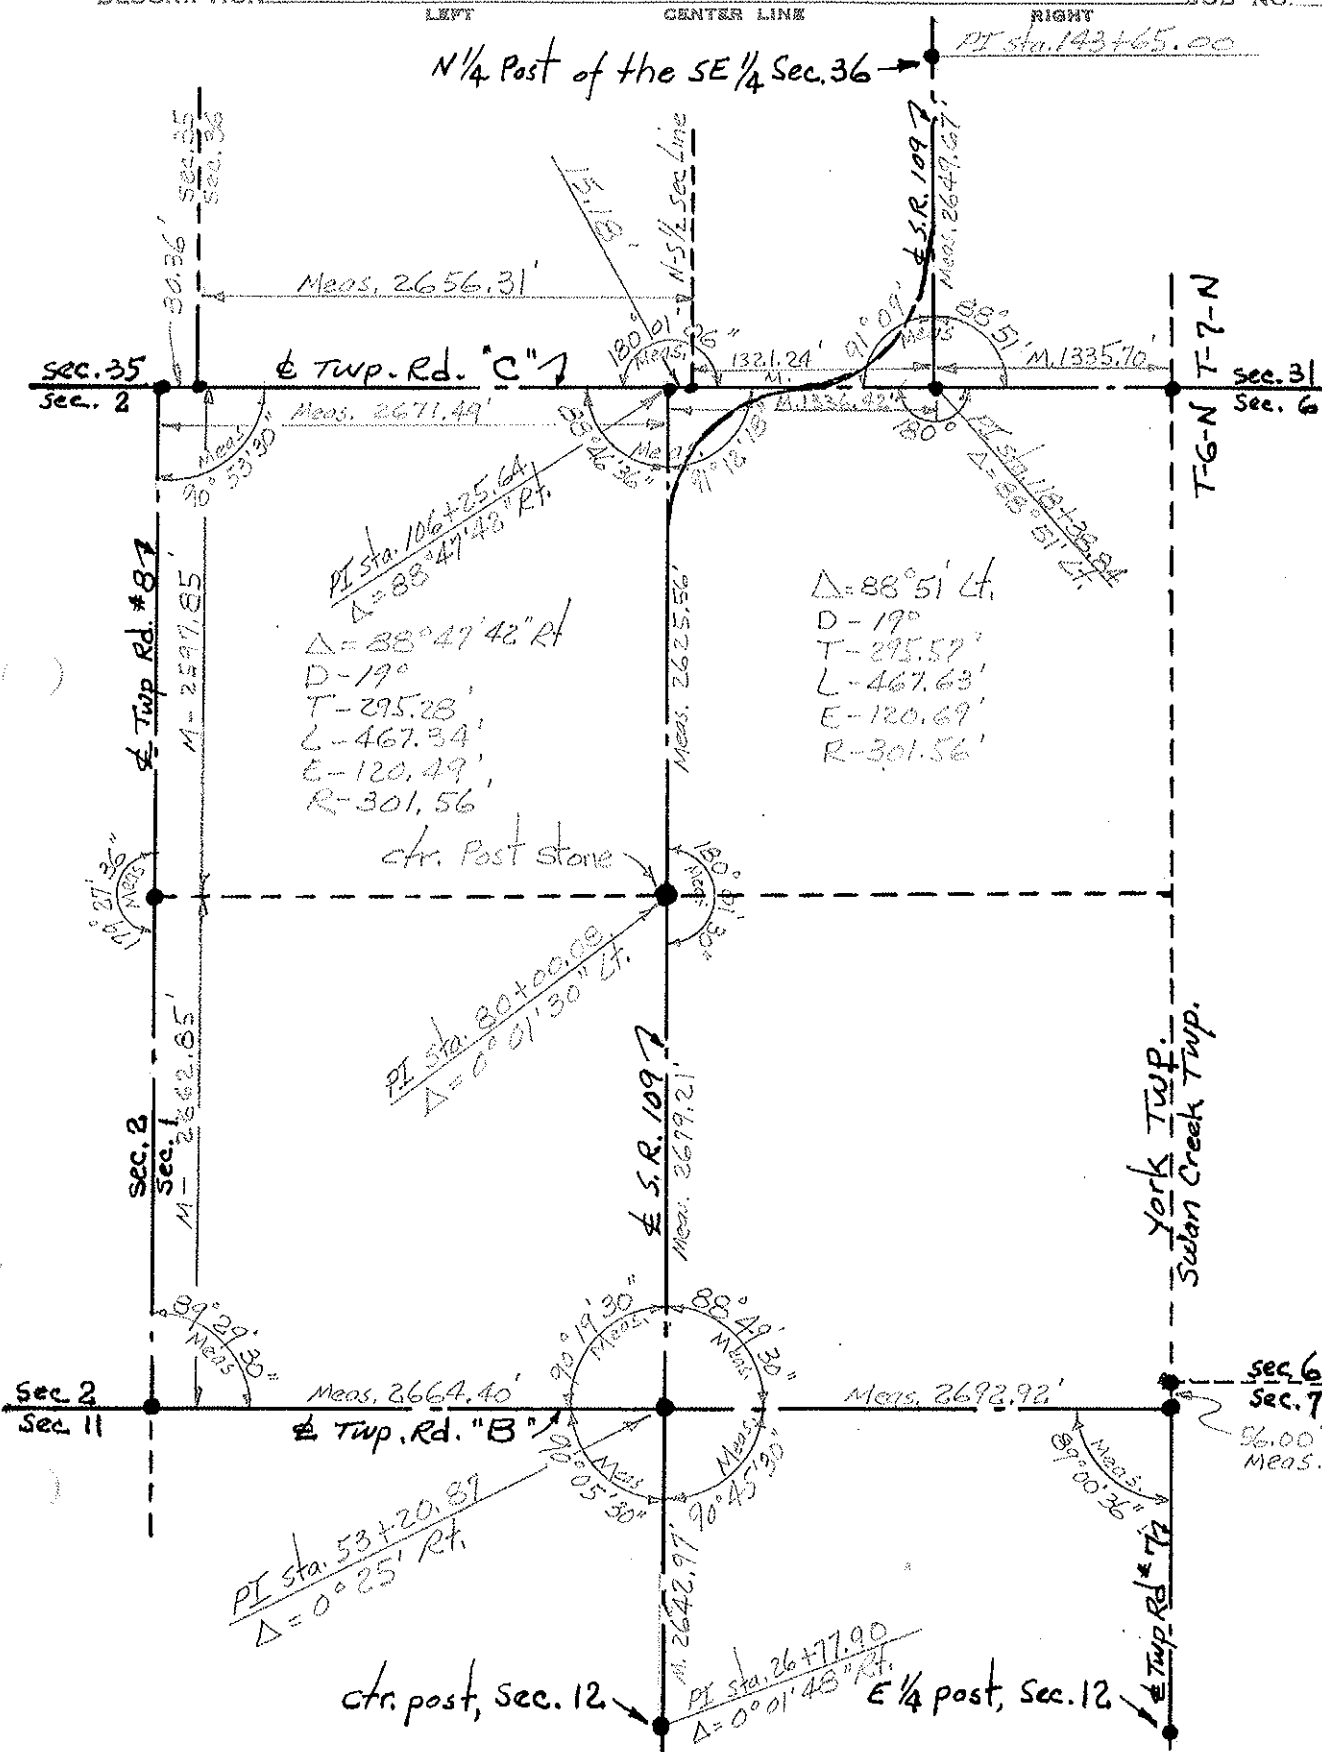

COMPUTATION SHEET

STATE OF OHIO - DEPARTMENT OF HIGHWAYS - BUREAU OF LOCATION AND DESIGN COLUMBUS, OHIO
 BY Dennis - Omev - Curtis - Granata DATE June 8, 1966 NO. OF SHEETS
 COUNTY Fulton SECTION
 DIV. NO. S.R. 109 U.S.R. I. R.
 SUBJECT OF THIS SHEET Ref. Monuments SR 109

①

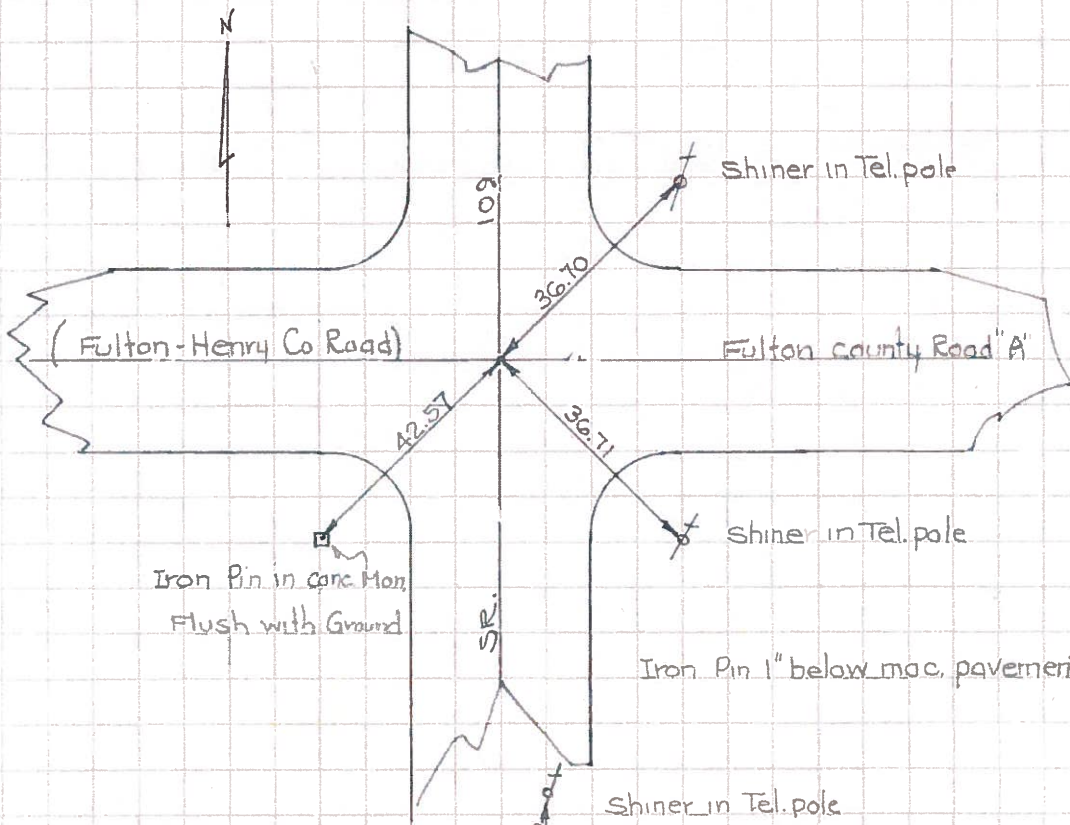

⑦A

