


O.D.O.T. DISTRICT 2 SURVEY OFFICE (USE ONLY)

PERSONNEL	REFERENCE NO. <u>8-AA</u>	SHEET <u>11</u> OF <u>14</u>
NOTES <u>HUSS</u>	DATE <u>01-14-10</u>	ROUTE <u>SR 109</u>
H.C. <u>FINTEL</u>	WEATHER <u>SUNNY</u>	COUNTY <u>FULTON</u>
R.C. <u>CANTERBURY</u>	TEMP. <u>87°</u>	TOWNSHIP <u>YORK</u>
		SECTION <u>36</u>
		T <u>7</u> N R <u>7</u> E


TYPE MONUMENT _____ PK/WASHER _____
 ON SURFACE - BELOW _____ ON _____
 LEFT - $\text{\textcircled{C}}$ PAV'T - RIGHT _____ 0.5' _____
9.7' TO RT EDGE PAVEMENT
 S.L.M. _____ 137+08 _____

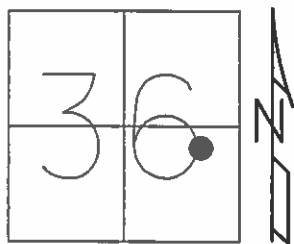

Grid: Northing: 679258.122 Easting: 1556728.373

03-25-83 FD RR SPK
 ON SURFACE, HOFFMAN
 05-11-83 SET PK NAIL, SWH
 10-13-94 SET PK/WASHER, BVD
 09-16-10 SET MAG/WASHER

07-08-10 GPS: CP AA8

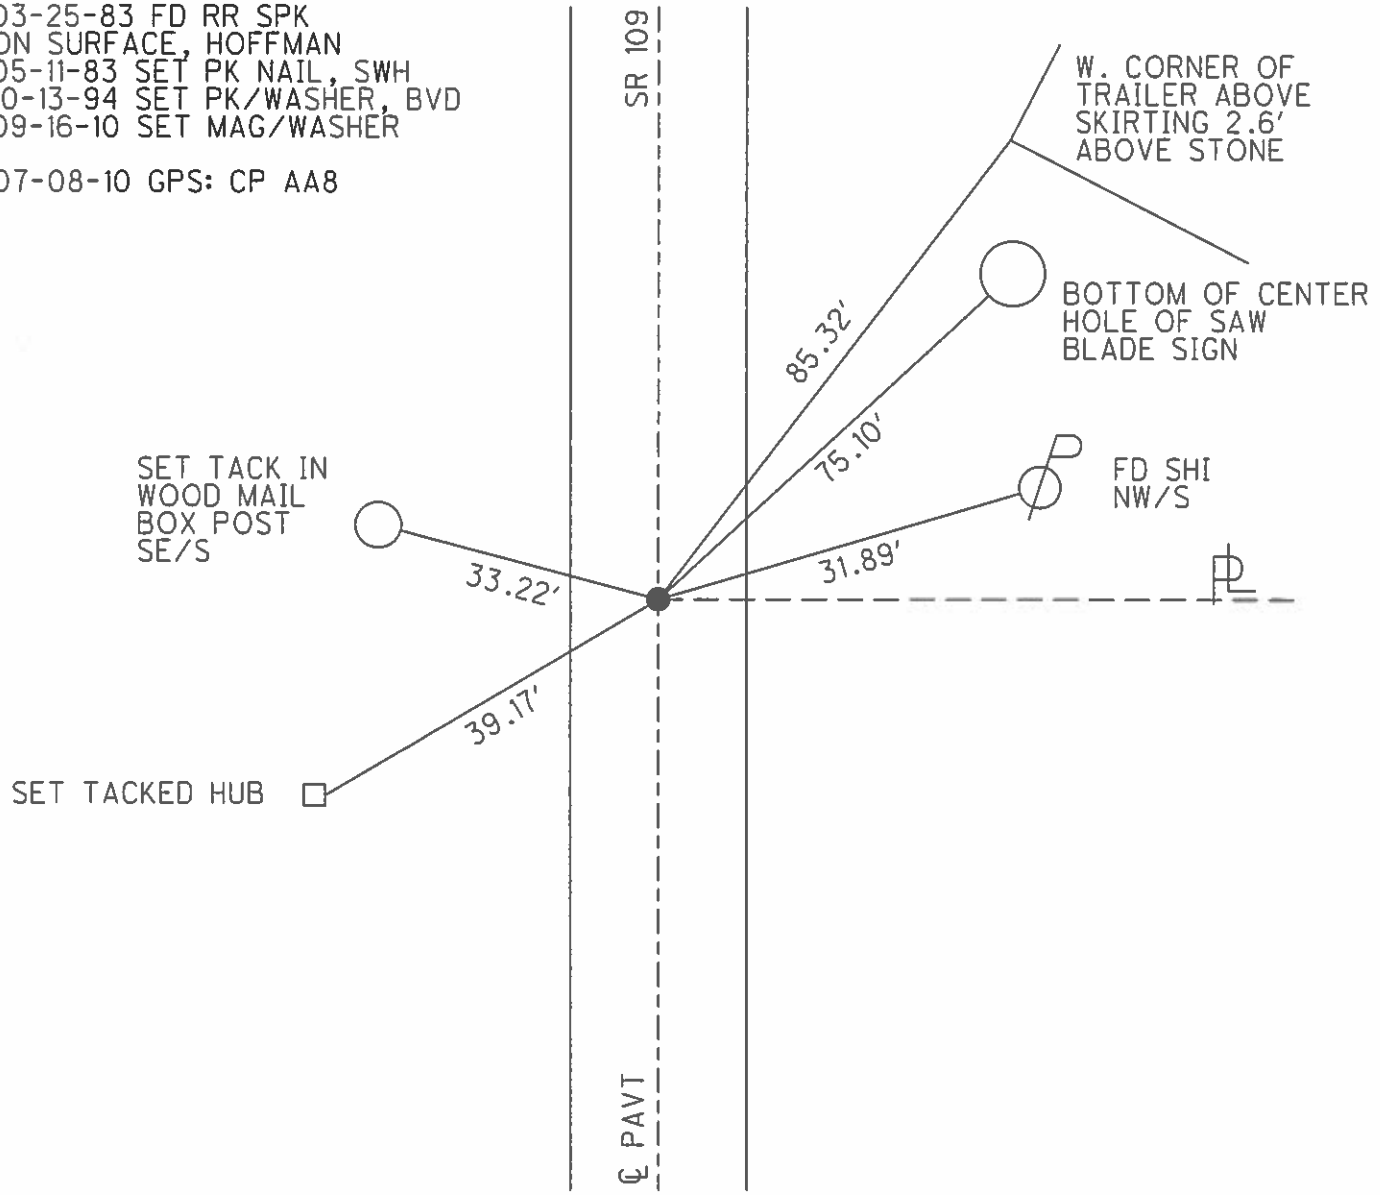

O.D.O.T. DISTRICT-2 SURVEY OFFICE

PERSONNEL

REFERENCE NO. 8-AA

SHEET 9 OF 27

NOTES CORDES

H.C. VAN DUSEN

DATE 8-15-94

ROUTE 109

R.C. BARNHISEL

WEATHER SUNNY

COUNTY FULTON

SLOVAK

TEMP. 65°F

TOWNSHIP YORK

SECTION 36

T 7 N R 7 E

TYPE MONUMENT LG. R.R. SPIKE


ORIGIN UNKNOWN

~~ON SURFACE~~ - BELOW 1 1/2"

~~LEFT 1/4 PAVT.~~ - RIGHT 0.5'

9.4' TO RT EDGE PAVEMENT

S.L.M. 137+08

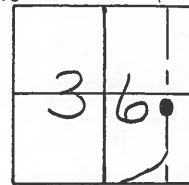

Fd R.R. SPK ON SURFACE

3-25-83
HOFFMAN

SET PK & WASHER
10-13-94
BVD

SET P.K. NAIL
5-11-83
SWH

MAIL BOX POST
4" CAST IRON PIPE

SET "+" CUT IN PIPE 1' UP

S.E. 109

E PAVT

W. CORNER OF TRAILER ABOVE SKIRTING
2.6' ABOVE STONE

SET SHI. NW/S

85.32

31.68

32.75



OD.O.T. DISTRICT 2 SURVEY OFFICE

SHEET _____ OF _____

County FULTON S.R. 109

Date MARCH 25 83

Township YORK

Weather CLEAR

Section 36

Temp. +30°


T7N, R7E

Personnel HOFFMAN

HOUSEHOLDER

BARNHISEL

#8-AA

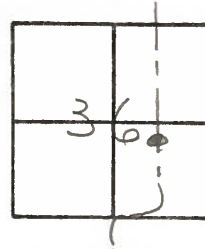

Fd R.R. SPR @ SURFACE ORIGIN UNKNOWN

SLM 137 +07

0.5' RT. of & PAUT

8.9' TO W. EP

8.4' TO E. EP

SET P.K. NAIL
5-11-83
S.W.H.

TRAILER
PARK

