



O.D.O.T. DISTRICT 2 SURVEY OFFICE (USE ONLY)

PERSONNEL _____ REFERENCE NO. 9 SHEET 12 OF 31
 NOTES HUSS DATE 07-14-10 ROUTE SR 109
 H.C. FINTEL WEATHER SUNNY COUNTY FULTON
 R.C. CANTERBURY TEMP. 87° TOWNSHIP YORK
 _____ SECTION 36
 _____ T 7 N R 7 E

TYPE MONUMENT P.K./WASHER
 ON SURFACE - ~~BELOW~~ ON _____
~~LEFT~~ - Q PAV'T - RIGHT 0.5'
9.8' TO RT EDGE PAVEMENT
 S.L.M. 143+55.66
 GRID: NORTHING: 679903.030 EASTING: 1556741.594

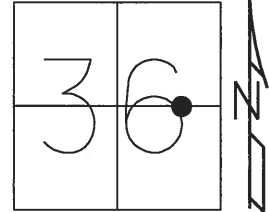


RECORD:
 FD 1" PIPE
 2.5" DOWN
 3-25-83, HOFFMAN
 SET SM.R.R.SPIKE
 5-17-94, SWH
 SET P.K./WASHER
 10-13-94, BVD
 FD P.K./WASHER
 CP9
 7-8-10, SAH
 SET MAG/WASHER
 9-16-10, SAH
 FD P.K./WASHER
 REF9
 10-29-15, JFO

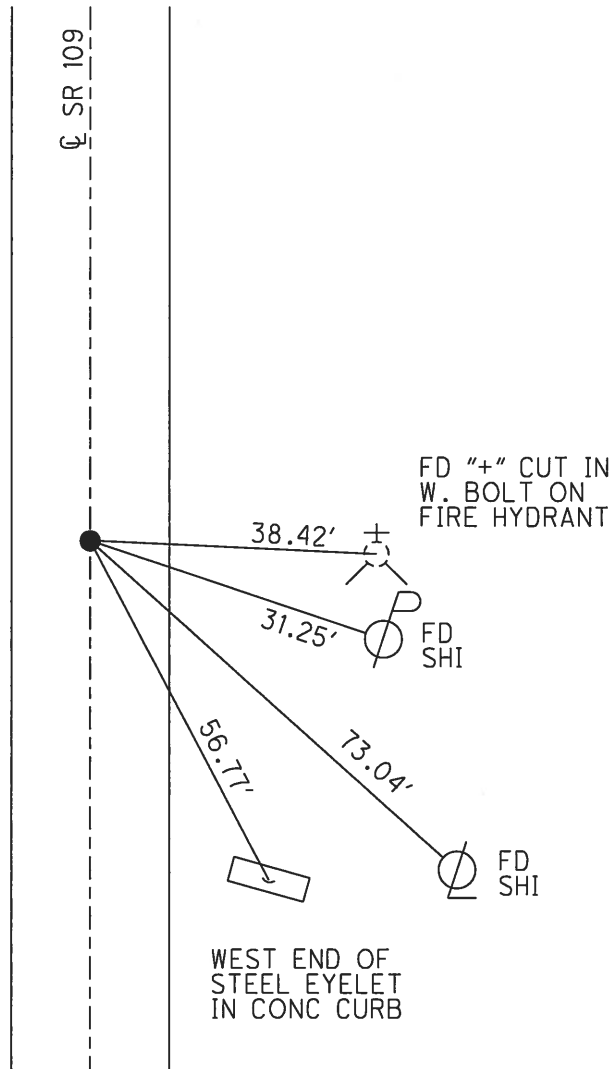

O.D.O.T. DISTRICT 2 SURVEY OFFICE (USE ONLY)


PERSONNEL _____	REFERENCE NO. <u>9</u>	SHEET <u>12</u> OF <u>14</u>
NOTES <u>HUSS</u>	DATE <u>07-14-10</u>	ROUTE <u>SR 109</u>
H.C. <u>FINTEL</u>	WEATHER <u>SUNNY</u>	COUNTY <u>FULTON</u>
R.C. <u>CANTERBURY</u>	TEMP. <u>87°</u>	TOWNSHIP <u>YORK</u>
_____	_____	SECTION <u>36</u>
_____	_____	T <u>7</u> N R <u>7</u> E

TYPE MONUMENT _____ PK/WASHER _____
 ON SURFACE - BELOW _____ ON _____
 LEFT - \odot PAV'T - RIGHT _____ 0.5' _____
9.8' TO RT EDGE PAVEMENT
 S.L.M. _____ 143+64 _____

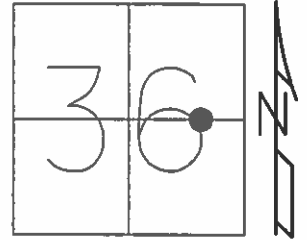

Grid: Northing: 679903.030 Easting: 1556741.594

03-25-83 FD 1" I-PIPE
 2.5" DEEP, HOFFMAN
 05-17-83 SET SMALL RR SPK, SWH
 10-13-94 SET PK/WASHER, BVD
 09-16-10 SET MAG/WASHER, EF
 07-08-10 GPS: CP 9

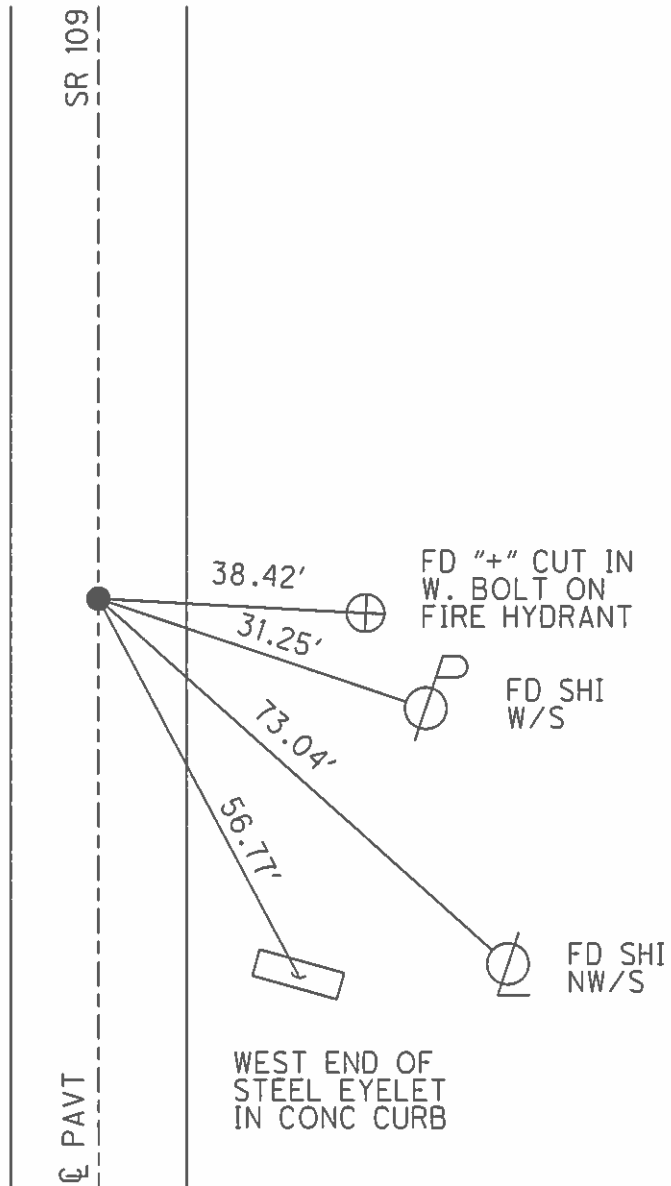

O.D.O.T. DISTRICT-2 SURVEY OFFICE

PERSONNEL

REFERENCE NO. 9

SHEET 10 OF 27

NOTES CORDES

H.C. CANTERBURY

DATE 8-10-94

ROUTE 109

R.C. HERMILLER

WEATHER SUNNY

COUNTY FULTON

F SLOVAK

TEMP. 65°F

TOWNSHIP YORK

SECTION 36

T 7 N R 7 E


TYPE MONUMENT SM. R.R. SPIKE

ON SURFACE - ~~BELOW~~ YES

~~LEFT - & PAV'T. - RIGHT~~ YES

9.4' TO RT EDGE PAVEMENT

S.L.M. 143 + 64

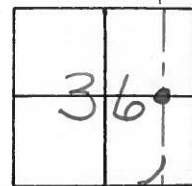


Fd 1" I. Pipe 2 1/2" DEEP
3-25-83
HOFFMAN

SET SMALL RR SPK
5-17-83
SWH

SET PK & WASHER
10-13-94
BVD

S.R. 109

& PAV'T.

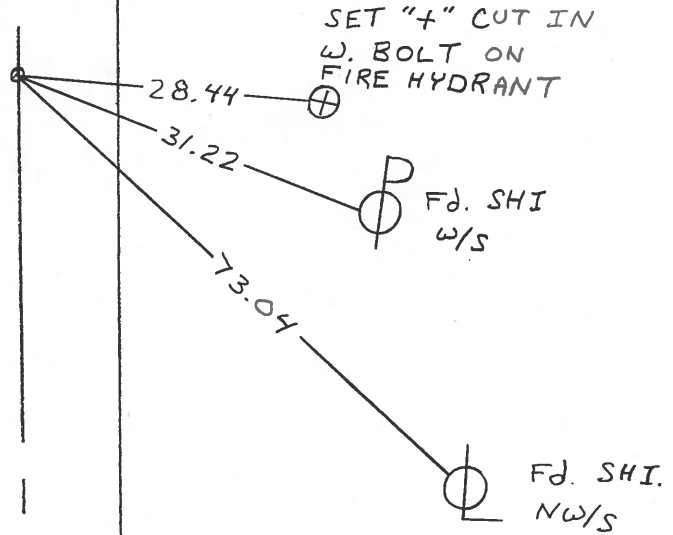

OD.O.T. DISTRICT 2 SURVEY OFFICE

SHEET _____ OF _____

County FULTON S.R. 109

Date MARCH 25, 83

Township YORK

Weather CLEAR

Section 36

Temp. +30°


TIN, RIE

Personnel HOFFMAN

HOUSEHOLDER

BARNHISEL

9

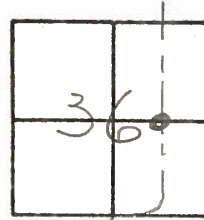

Fd 1" I.D. IRON PIPE 2 1/2" Below Surface

S.L.M 143 + 52

ON & PAUT

9.6 TO W.E.P.

8.6 TO E.E.P.

SET SMALL R.R. SPK.
5-17-83
S.W.H.

Fd shi E/S of EAST POST

33.37

WOOD SIGN

PLANT oyo

HYBRIDS

S. R. 109

PAUT.

30.04

Set shi W/S END POST

SPLIT RAIL

Fence R

TRAILER PARK

31.20

⊙ Fd shi W/S

73.00

⊙ Set shi NW/S

PERSONNEL	TITLE	PERSONNEL	TITLE
Tamsic			
Granata			
Vanyo			
Boyle			

COUNTY Fulton DATE July 13, 1972
 S. R. 109 WEATHER _____
 SEC. YORK TWP TEMP. _____


DESCRIPTION

LEFT

CENTER LINE

RIGHT





JOB NO. _____

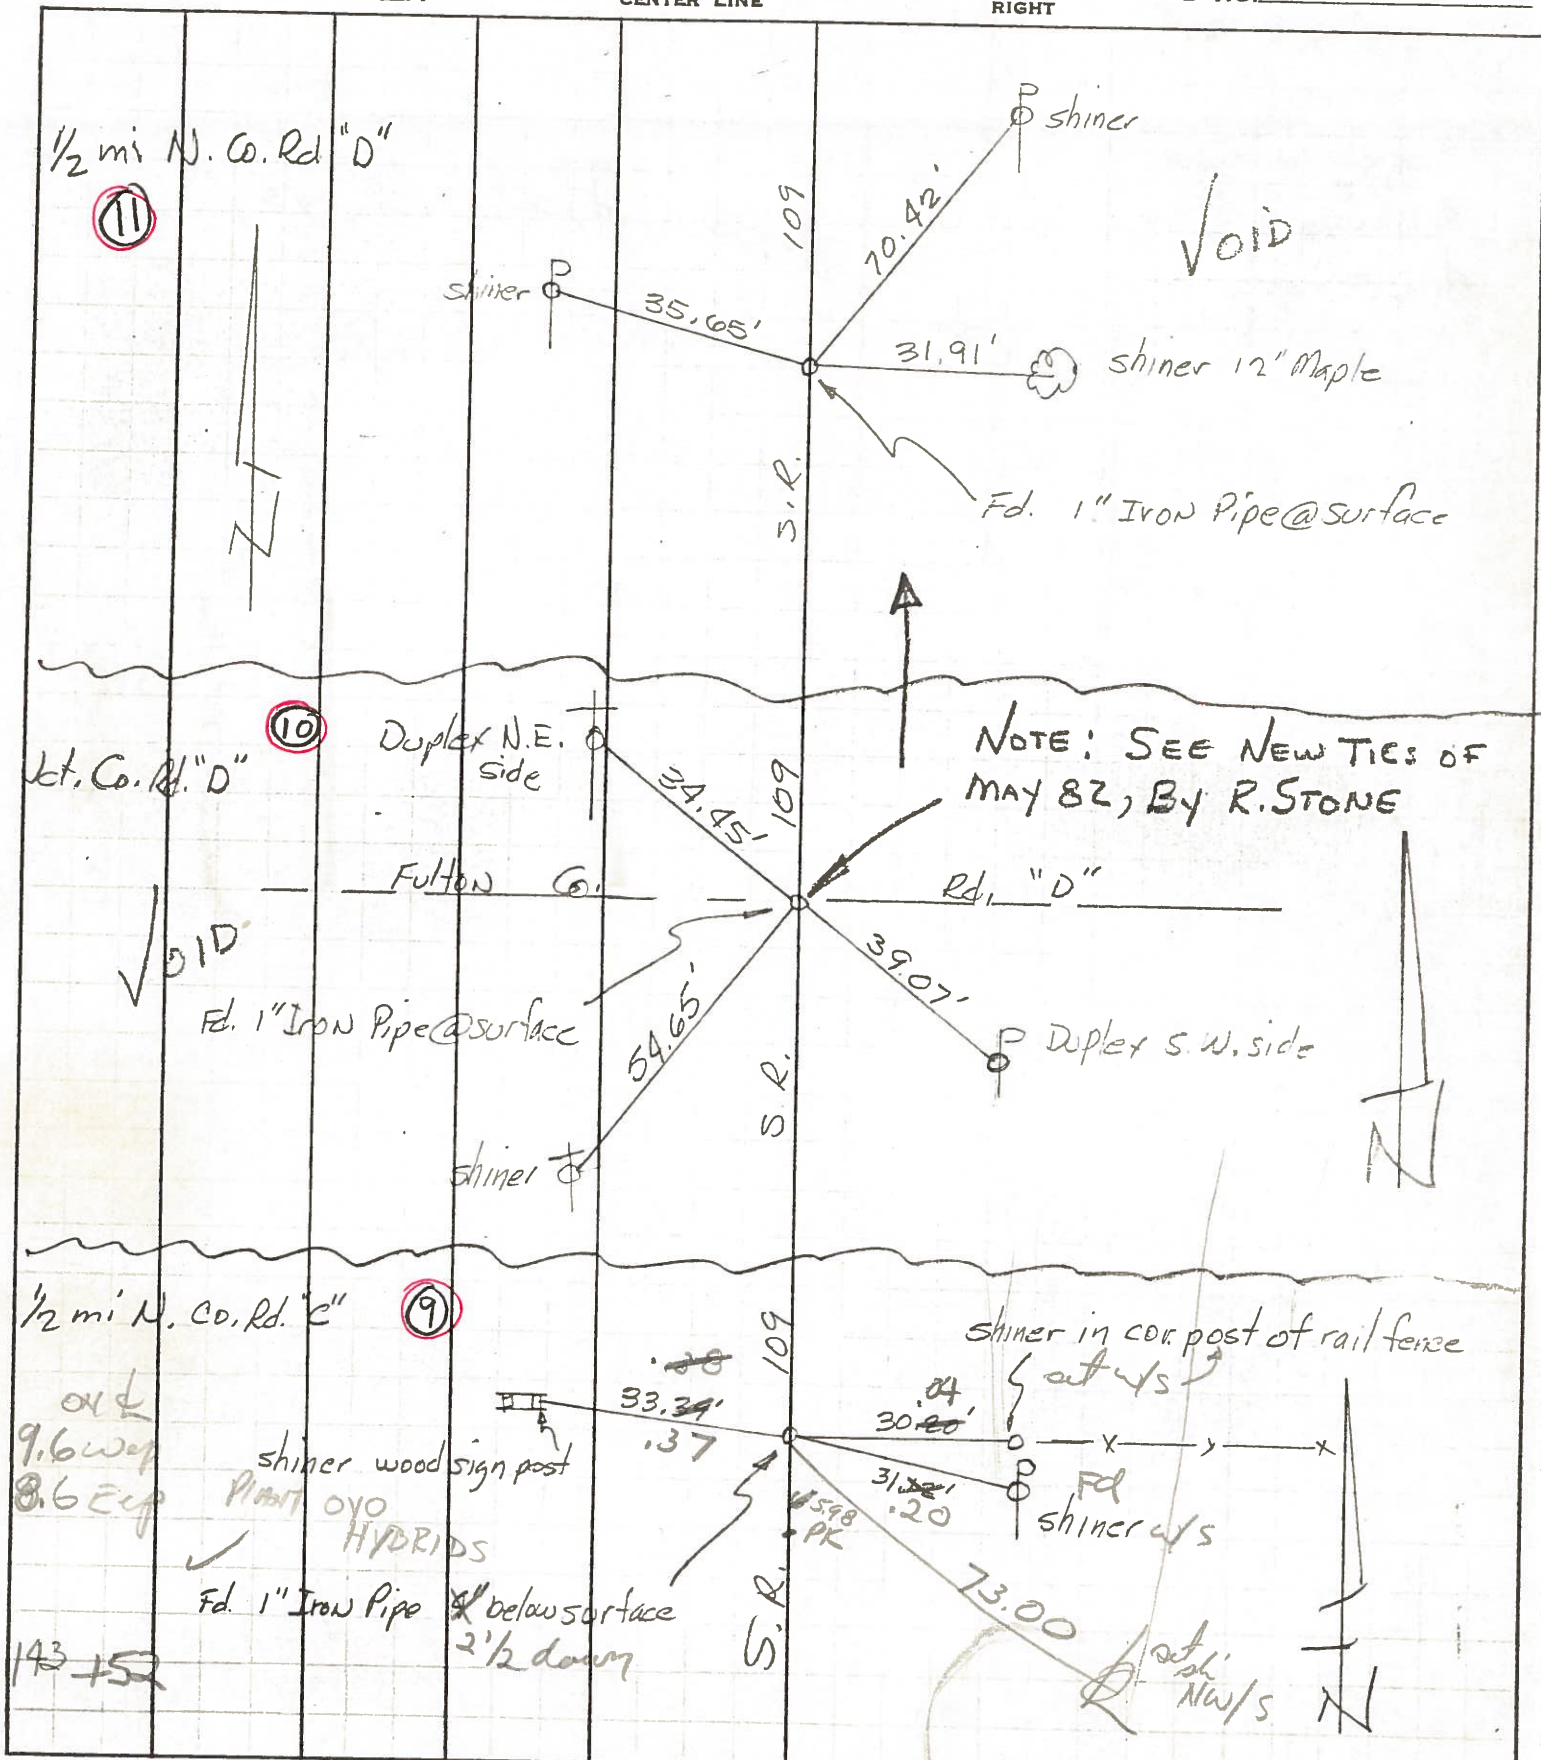

PERSONNEL	TITLE	PERSONNEL	TITLE
Red Beach			
Newcomb			
Knape			
Wise			


COUNTY Fulton DATE Aug 1970
 S. R. 109 WEATHER _____
 SEC. York Twp TEMP. _____

DESCRIPTION CONTROL POINTS JOB NO. _____

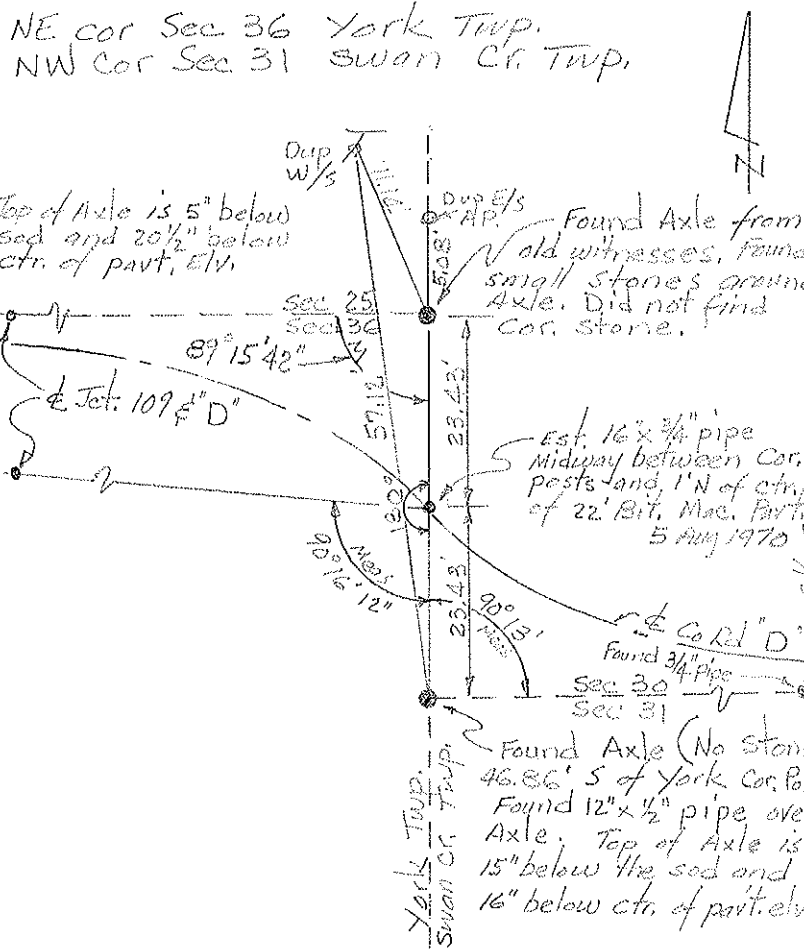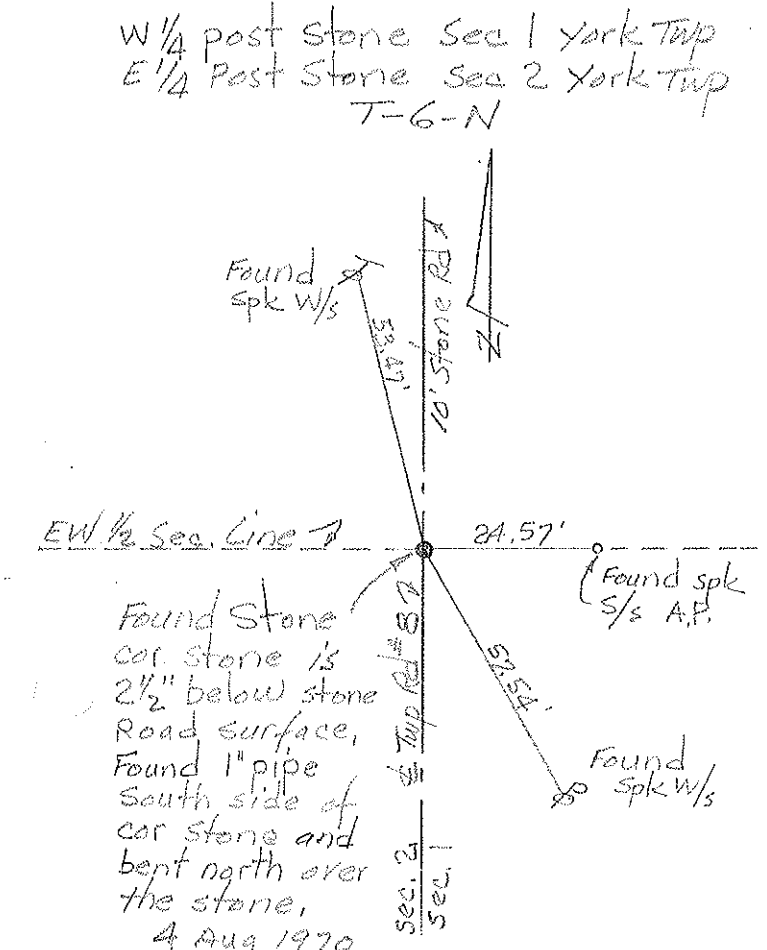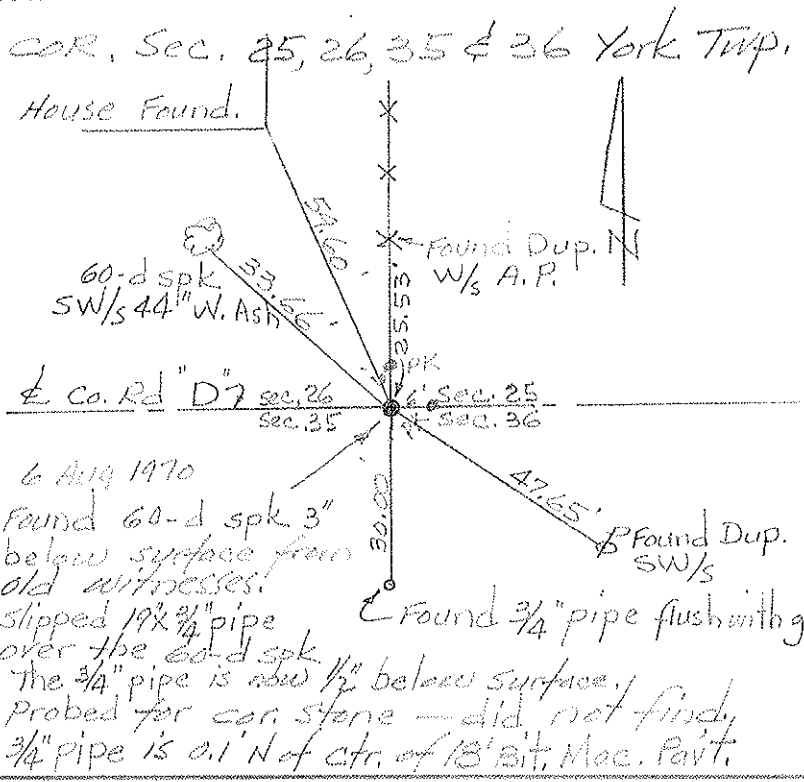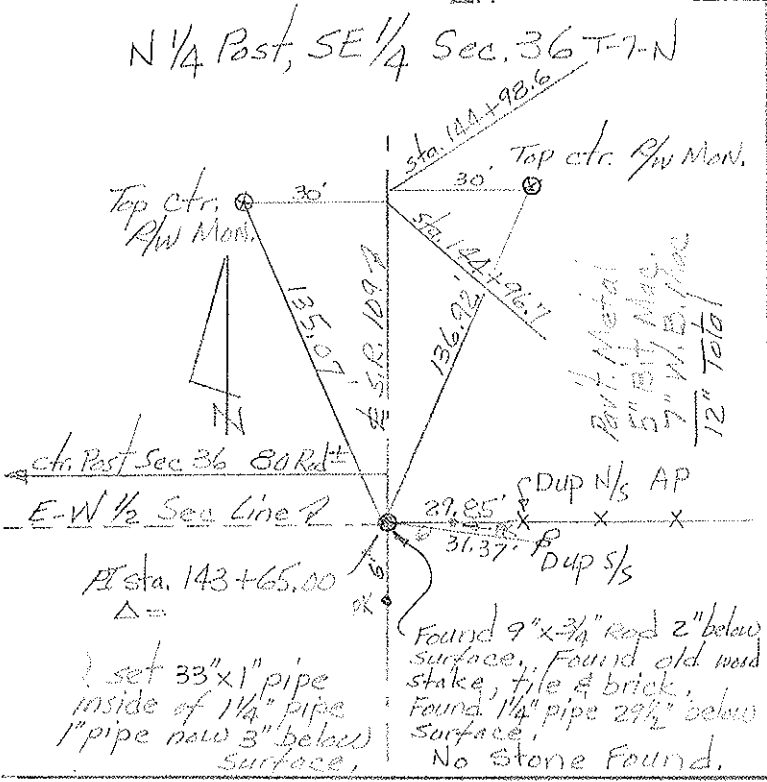

PERSONNEL	TITLE	PERSONNEL	TITLE	COUNTY	DATE
Red Beach				Fulton	Aug. 1970
Newcomb				S. R. 109	WEATHER
Knape				SEC. 36, T-7-N, YORK TWP.	TEMP.
Wise					

DESCRIPTION: **ALIGNMENT & CONTROLS** JOB NO.

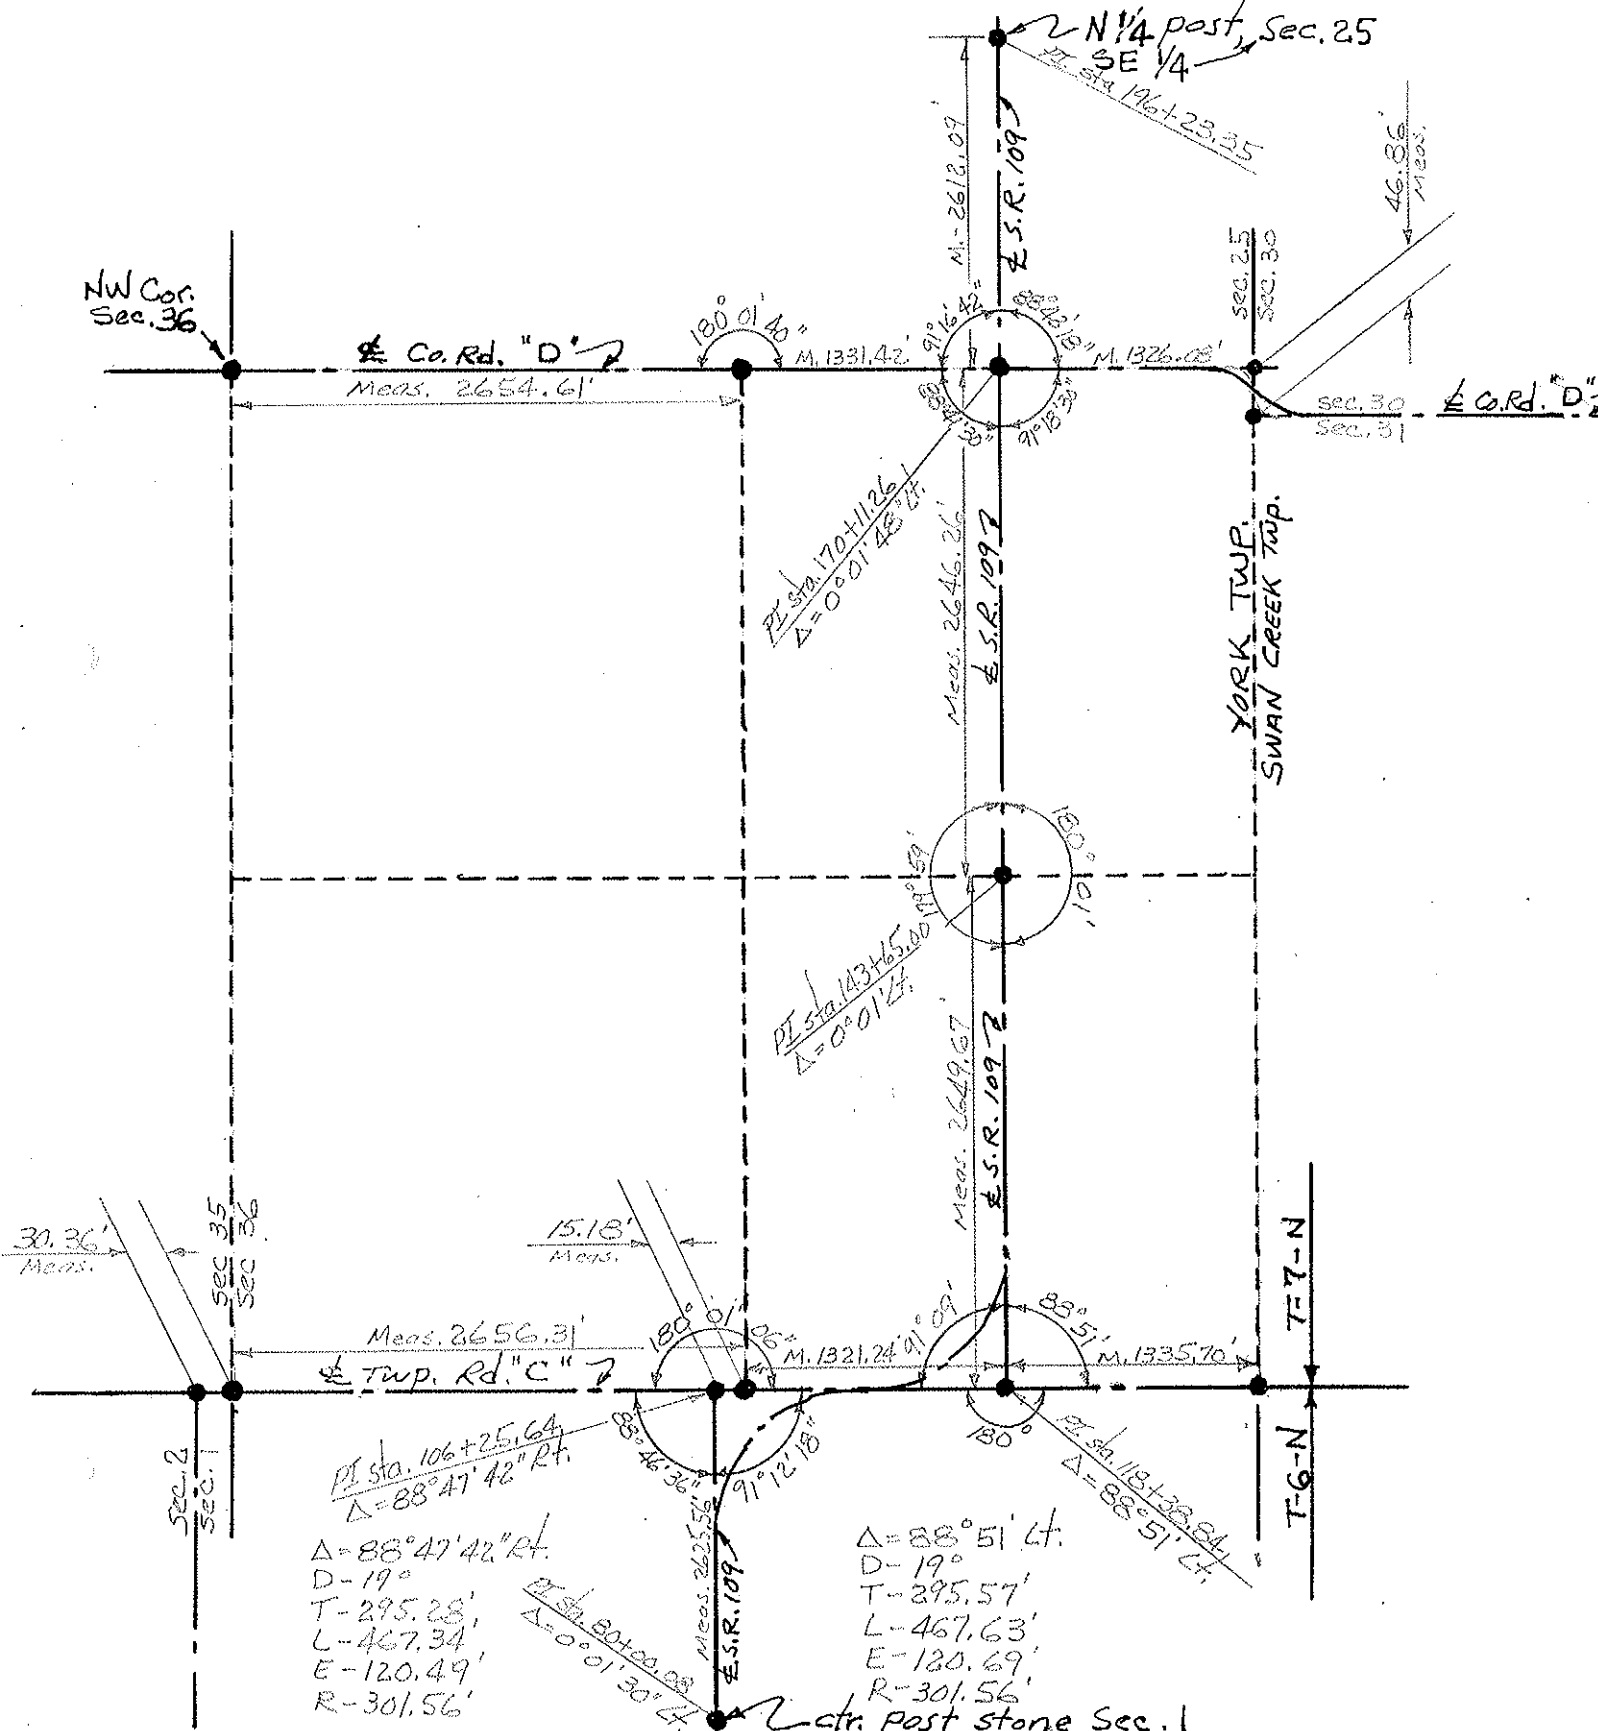

$PI Sta. 106+25.64$
 $\Delta = 88^{\circ} 47' 42'' Rt.$
 $D = 19^{\circ}$
 $T = 295.28'$
 $L = 467.34'$
 $E = 120.49'$
 $R = 301.56'$

$PI Sta. 118+38.84$
 $\Delta = 88^{\circ} 51' Lt.$
 $D = 19^{\circ}$
 $T = 295.57'$
 $L = 467.63'$
 $E = 120.69'$
 $R = 301.56'$

Center post stone, Sec. 1