


O.D.O.T. DISTRICT 2 SURVEY OFFICE (USE ONLY)


PERSONNEL _____ REFERENCE NO. 11 SHEET 15 OF 31
 NOTES RHOADES DATE 7-26-17 ROUTE SR 109
 H.C. O'DONNELL WEATHER SUNNY COUNTY FULTON
 R.C. CARSON TEMP. 67° TOWNSHIP YORK
 _____ SECTION 25
 _____ T 7 N R 7 E

TYPE MONUMENT SM.RR.SPIKE
 ON SURFACE - ~~BELOW~~ ON
 LEFT - ☉ PAV'T - ~~RIGHT~~ 0.5'
9.5' TO RT EDGE PAVEMENT
 S.L.M. 196+13.39

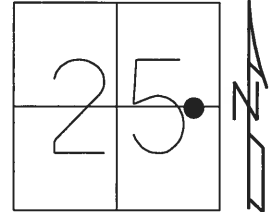

GRID: NORTHING: 685159.7034 EASTING: 1556847.0454

RECORD:
 RSET SM.RR.SPIKE
 8-23-01, MDB
 FD SM.RR.SPIKE
 10-29-15, JFO
 REF11
 12-18-15, JFO
 SET MAG/WASHER
 12-1-17, JMR

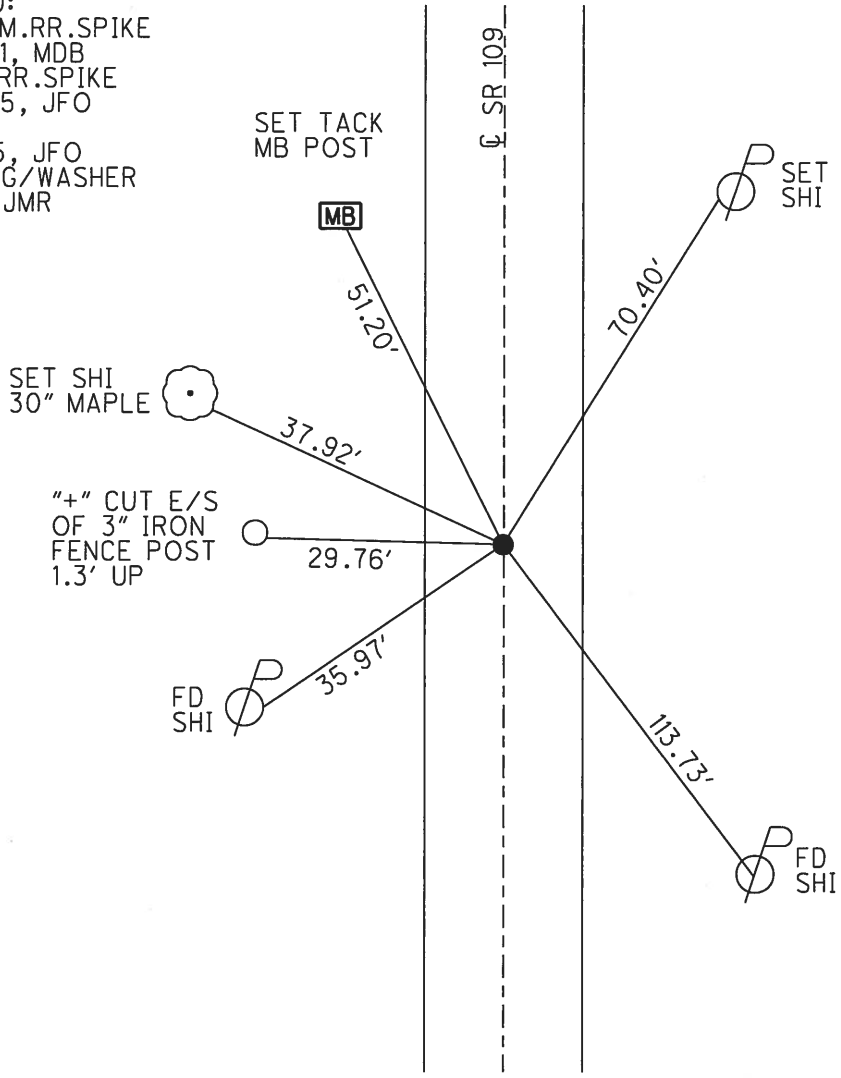

O.D.O.T. DISTRICT 2 SURVEY OFFICE

PERSONNEL _____

REFERENCE NO. 11

SHEET 3 OF 15

NOTES BARNHISEL RC

H.C. CORDES

R.C. _____

DATE 7-6-01

WEATHER SUNNY

TEMP. +75°

ROUTE 109

COUNTY FULTON

TOWNSHIP YORK

SECTION 25

T 7 N R 7 E


TYPE MONUMENT PK/WASHER

ON SURFACE - ~~BELOW~~ yes


LEFT-~~C~~ PAV'T. - ~~RIGHT~~ 0.5'

9.5' TO RT EDGE PAVEMENT

S.L.M. 196+13

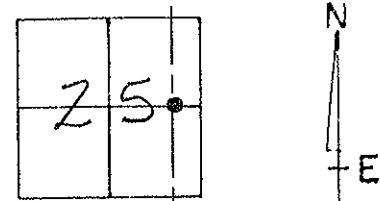

Reset Sm. RR SPIKE
8-23-01
MDB

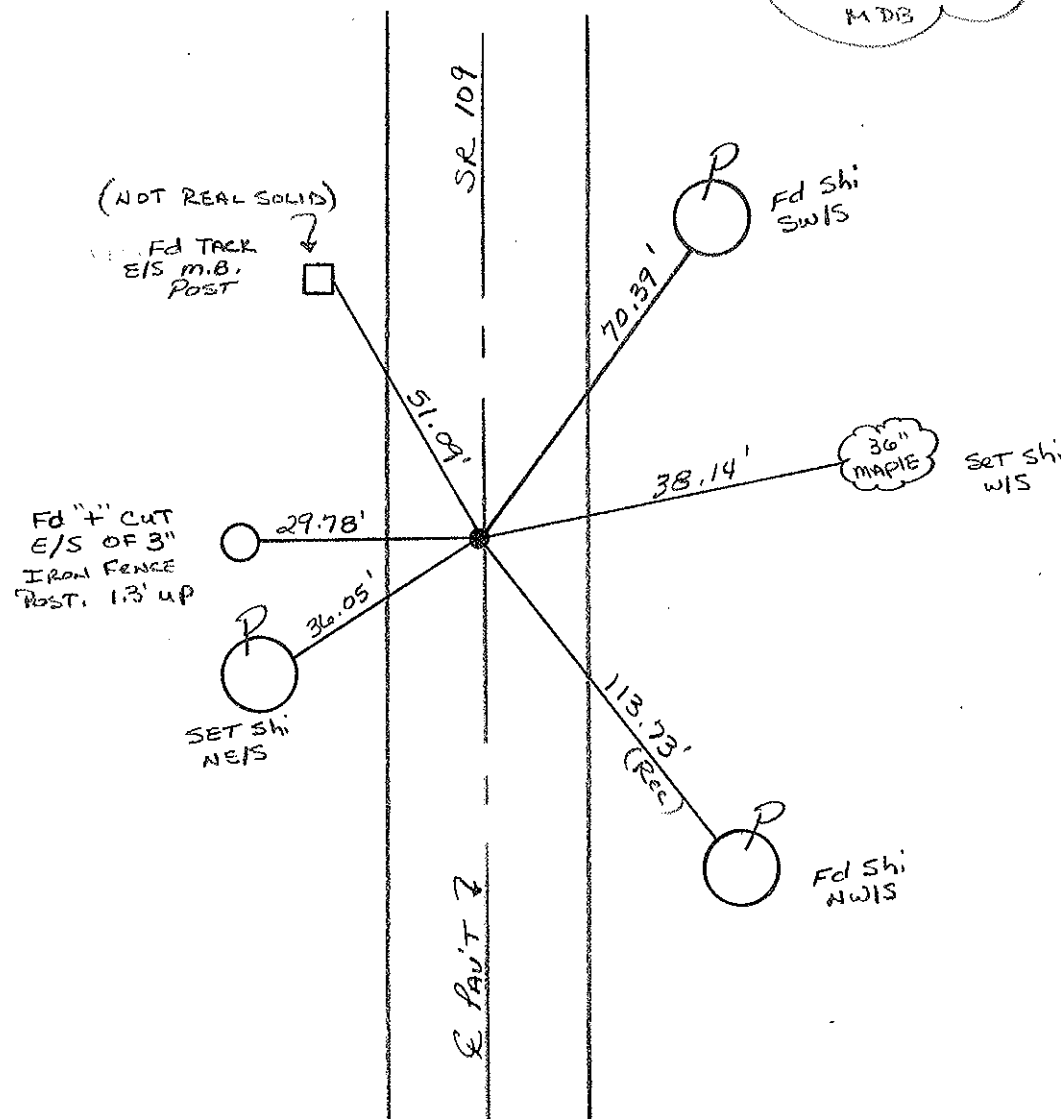

(NOT REAL SOLID)
Fd TACK
E/S m.B.
POST

Fd 7" CUT
E/S OF 3"
IRON FENCE
POST. 1.3' UP

SET Shi
NETS

Fd Shi
SWIS

36"
MAPLE
SET Shi
WIS

Fd Shi
NWIS

SR 109

E PAV'T 7

29.78'

36.05'

51.09'

70.39'

38.14'

113.73'
(Rec)

O.D.O.T. DISTRICT-2 SURVEY OFFICE

PERSONNEL

REFERENCE NO. 11

SHEET 13 OF 27

NOTES CORDES

H.C. HERMILLER

DATE 8-10-94

ROUTE 109

R.C. SLOVAK

WEATHER SUNNY

COUNTY FULTON

CANTERBURY

TEMP. +65° F

TOWNSHIP YORK

SECTION 25

T 7 N R 7 E


TYPE MONUMENT 1" IRON PIPE

ON SURFACE - BELOW 2 1/2"

~~LEFT~~ - ~~Q~~ PAV'T. - ~~RIGHT~~ YES


10.4 TO EAST EDGE PAVEMENT

S.L.M. 196+08

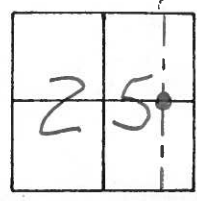

Fd 1" I. PIPE
ON E-W LINE SEC. 25
5-24-82
I. STONE

SET PK & WASHER
10-13-94. BVD

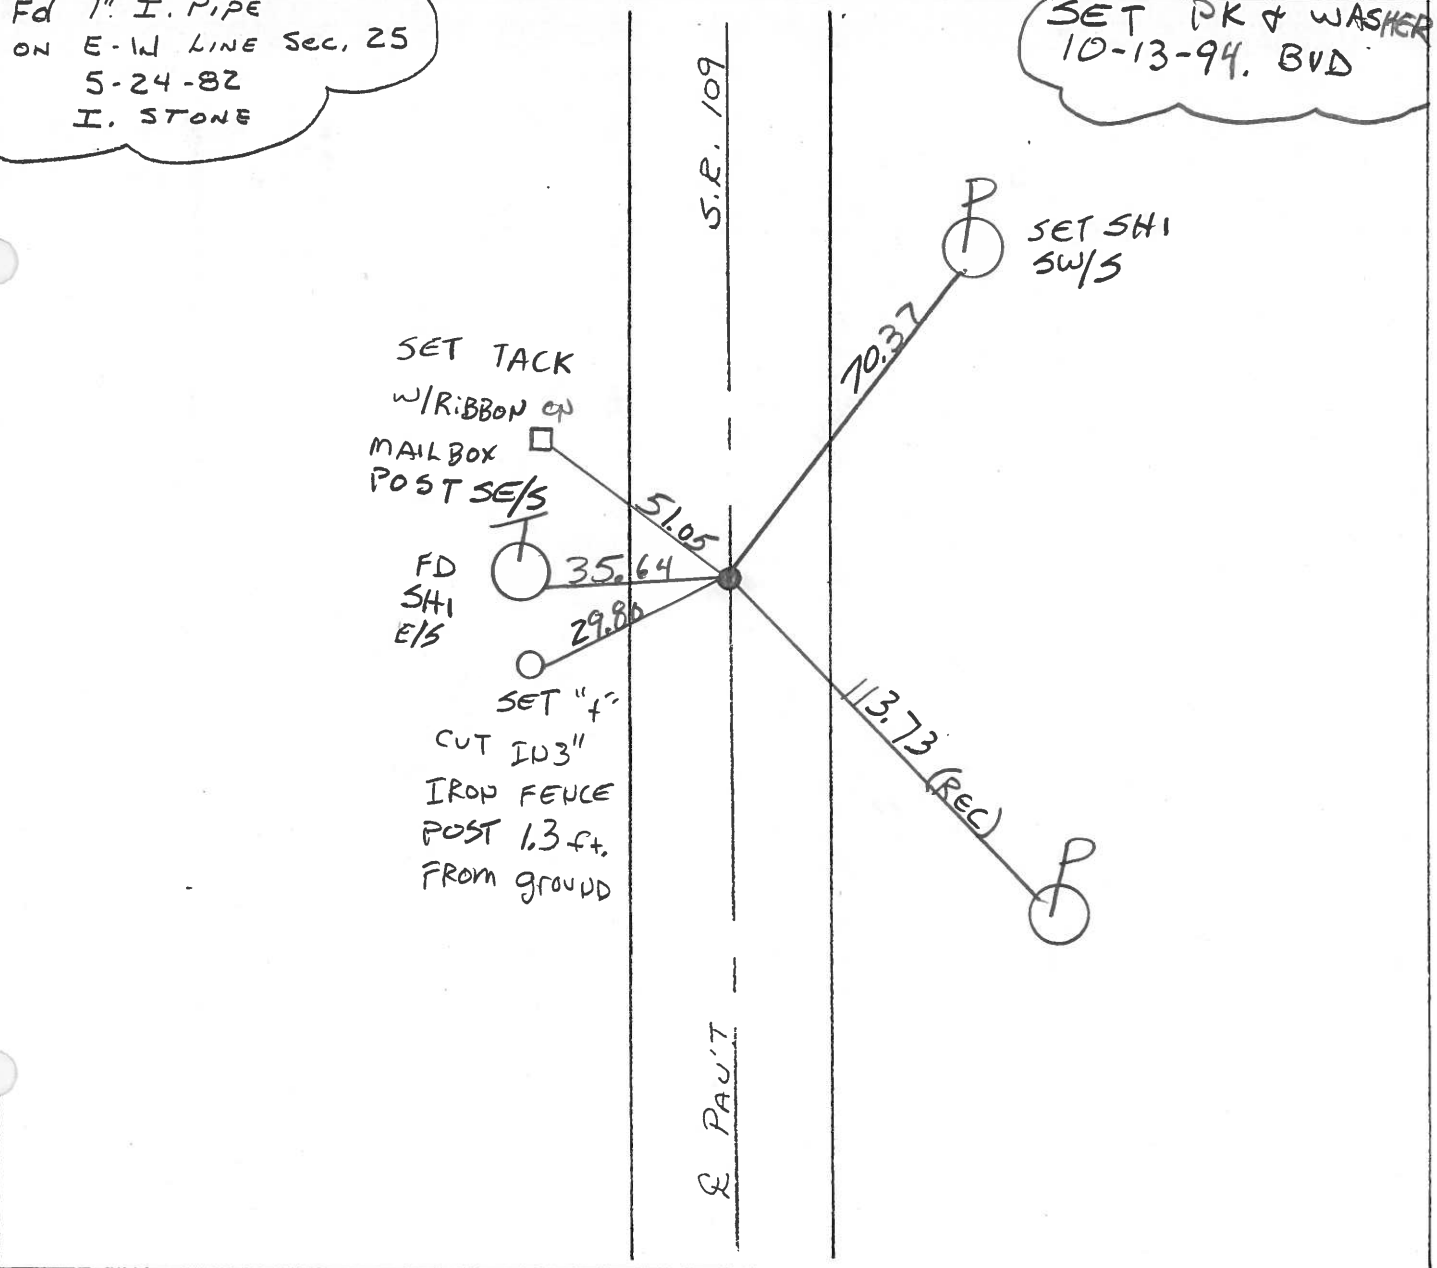

County Fulton S.R. 169

Date 24 May 82

Township Park


Weather Fair

Section 25

Temp. 70°

T N, R E


Personnel I. Stone

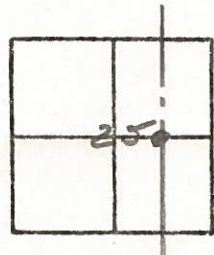

11

P. Neuse
R. Michelak
D. Curtis


REF. No. 11

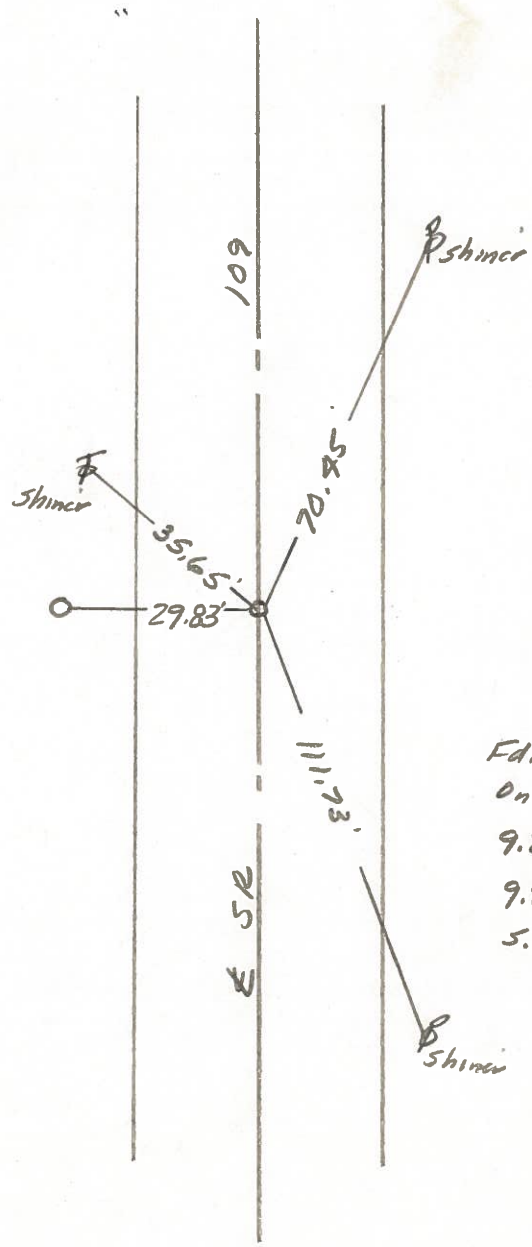

Fd. 1" I. Pipe To Surface
On E-W of Sec. 25
9.2' to W. edge put.
9.2' to E. edge put.
S.L.M. Sta. 196+12

PERSONNEL	TITLE	PERSONNEL	TITLE	COUNTY	DATE	WEATHER	TEMP.
Tansig				Fulton	July 13, 1972		
Coranata				S. R. 109			
Vanyo				SEC. YORK TWP			
Boyle							

DESCRIPTION _____ LEFT _____ CENTER LINE _____ RIGHT _____ JOB NO. _____




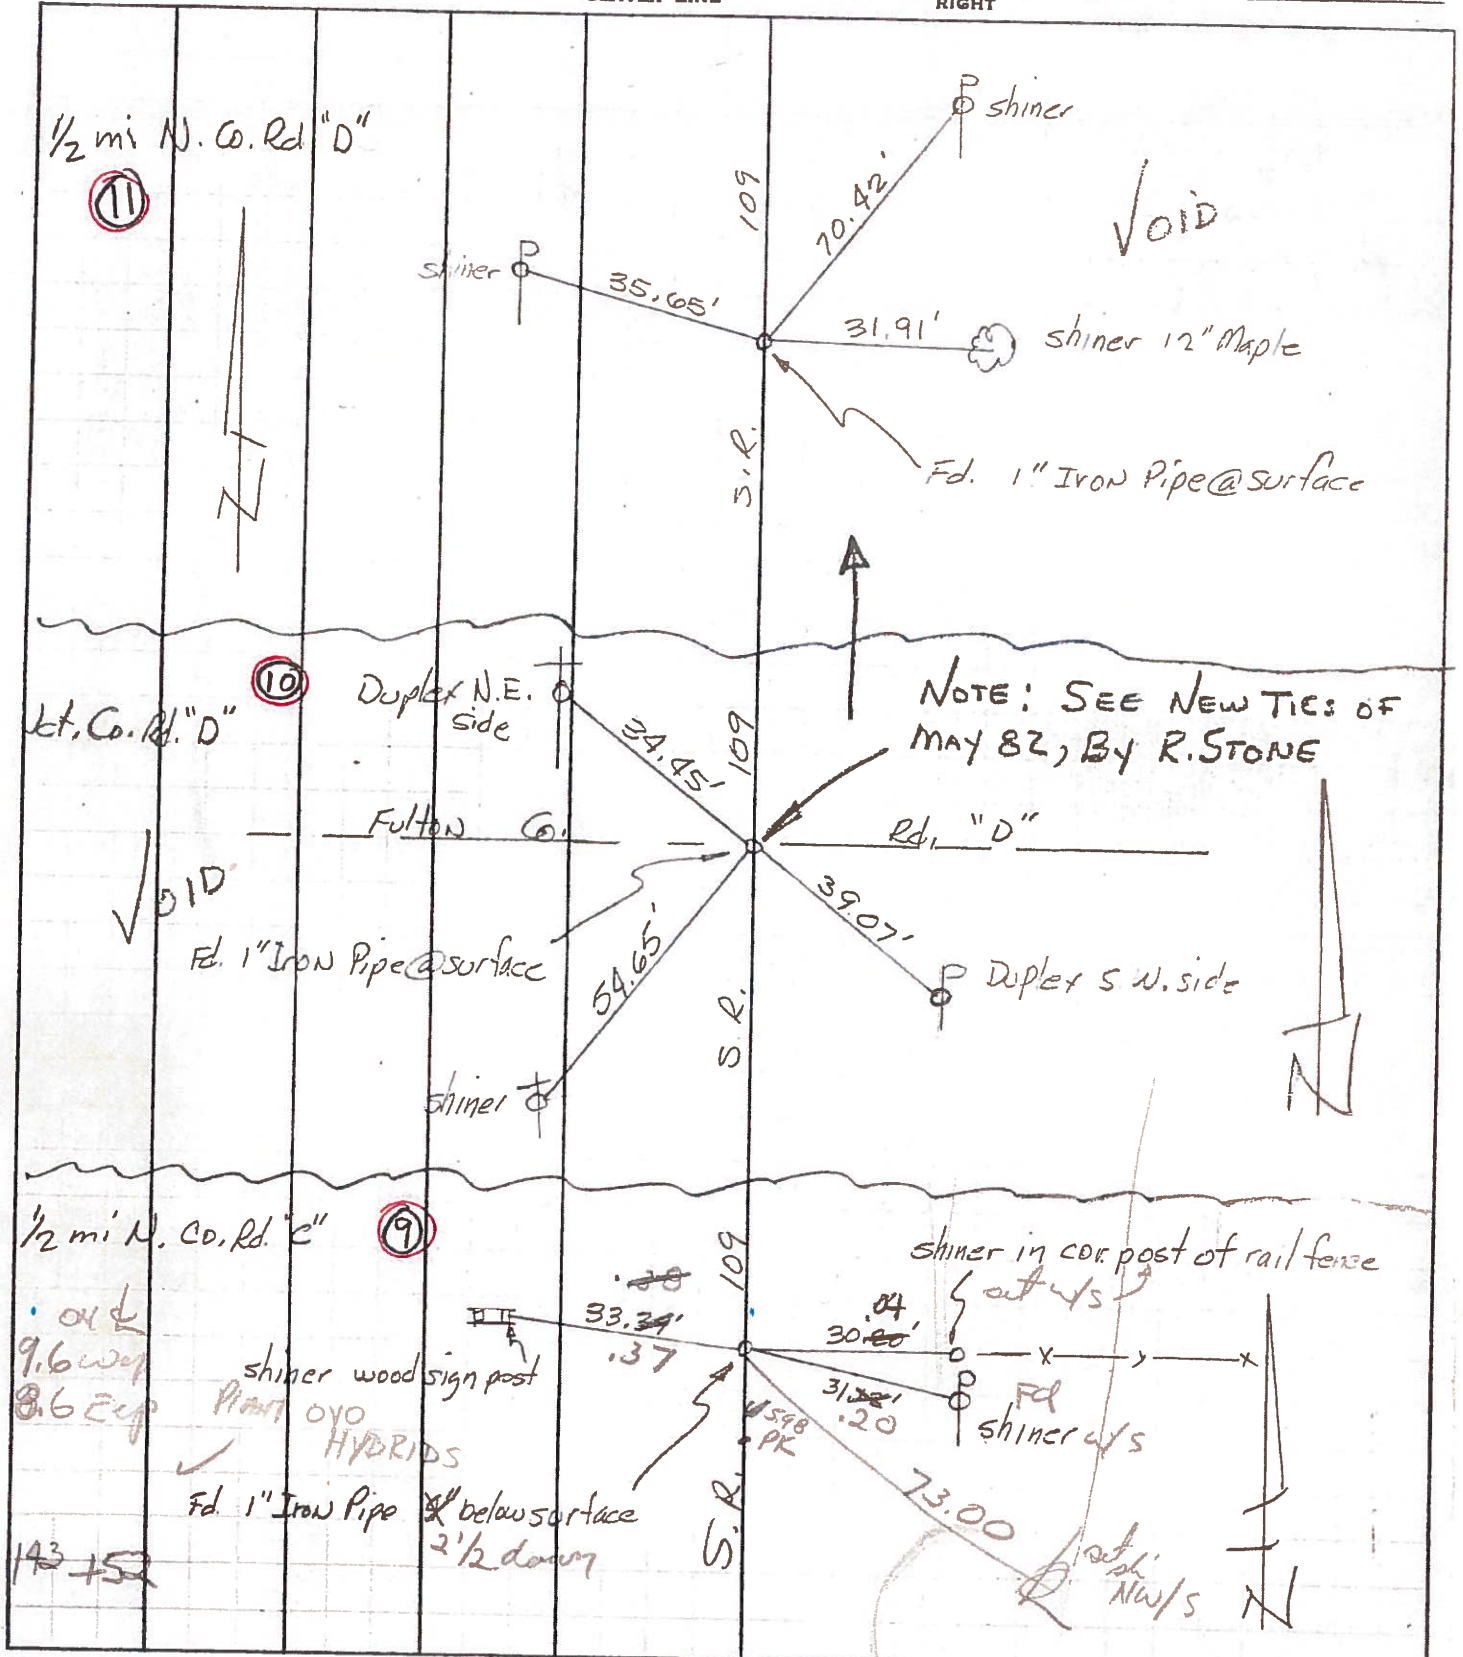


PERSONNEL TITLE PERSONNEL TITLE
 Red Beach _____
 Newcomb _____
 Knape _____
 Wise _____

COUNTY Fulton DATE Aug 1970
 S. R. 109 WEATHER _____
 SEC. York Twp TEMP. _____

DESCRIPTION CONTROL POINTS JOB NO. _____

LEFT CENTER LINE RIGHT

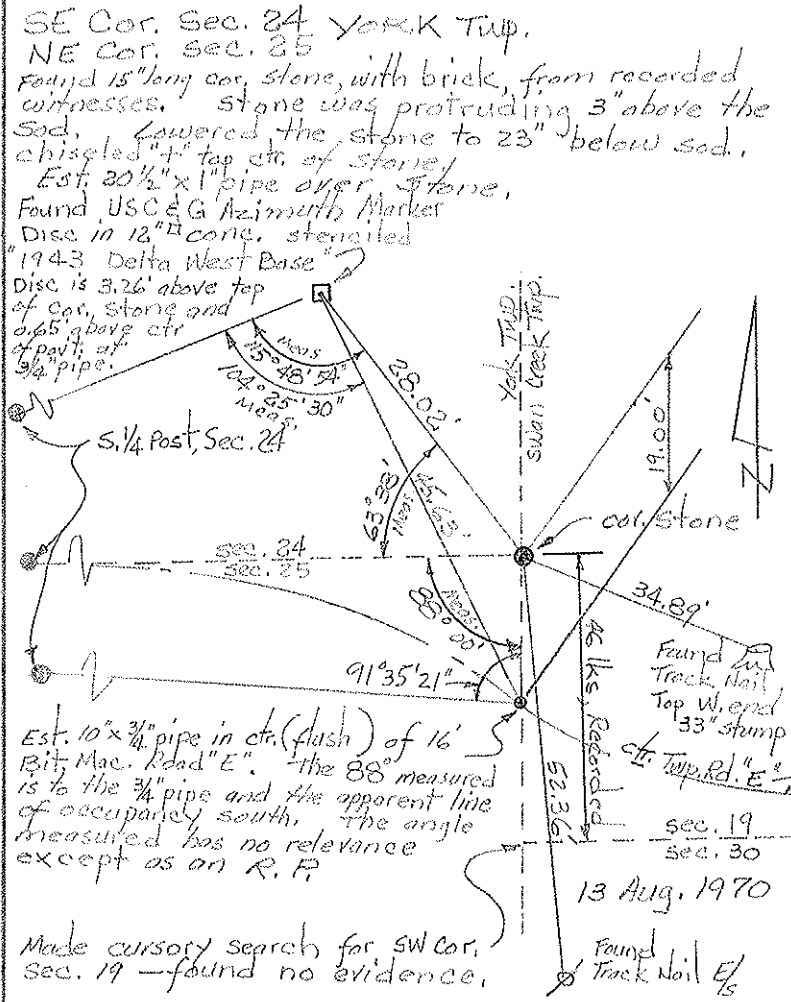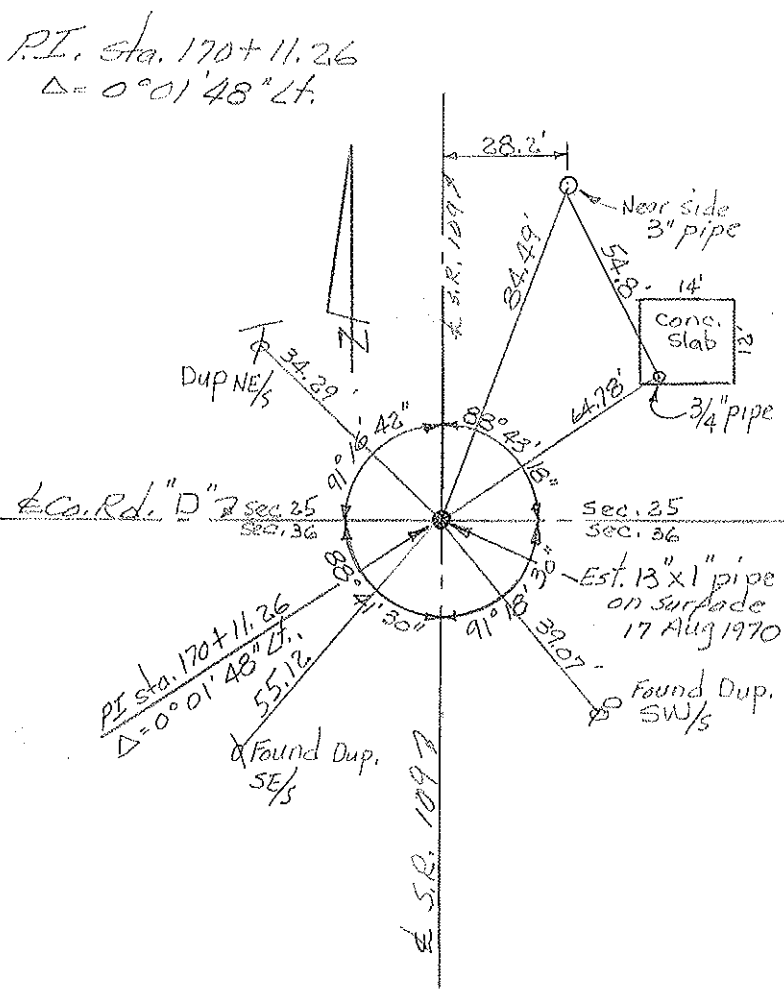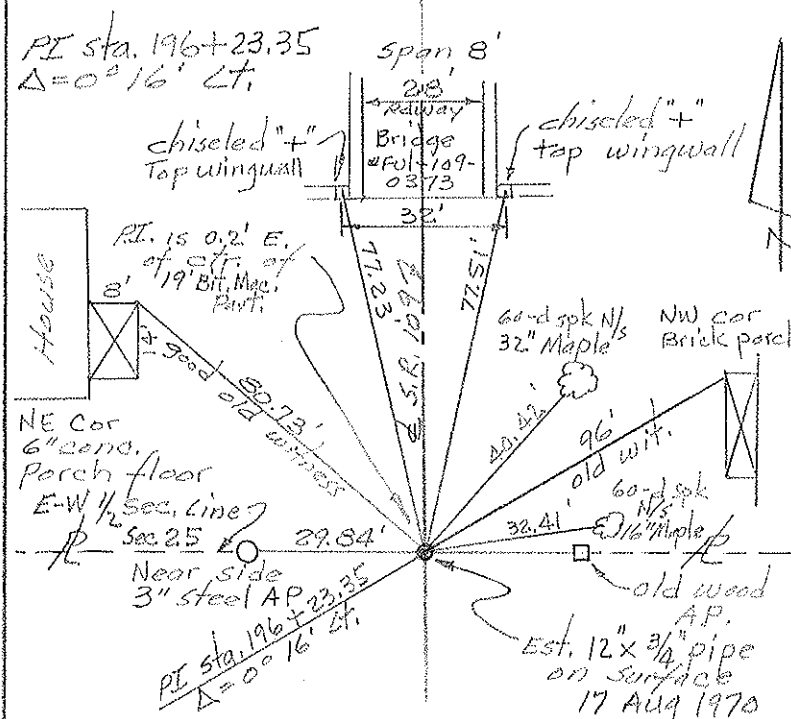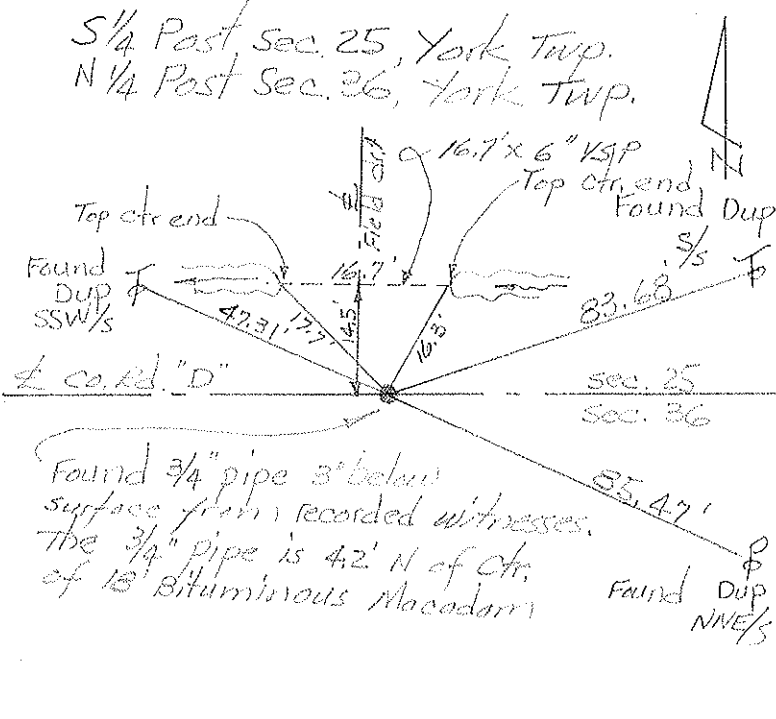

PERSONNEL TITLE PERSONNEL TITLE
 Red Beach
 Newcomb
 Knape
 Wise

COUNTY Fulton DATE Aug 1970
 S. R. 109 WEATHER
 SEC. 25 York Twp. TEMP.

DESCRIPTION ALIGNMENT & CONTROLS JOB NO.

