



O.D.O.T. DISTRICT 2 SURVEY OFFICE (USE ONLY)

PERSONNEL \_\_\_\_\_ REFERENCE NO. 12 SHEET 16 OF 31  
 NOTES RHOADES DATE 7-26-17 ROUTE SR 109  
 H.C. O'DONNELL WEATHER SUNNY COUNTY FULTON  
 R.C. CARSON TEMP. 67° TOWNSHIP YORK  
 \_\_\_\_\_ SECTION 25  
 \_\_\_\_\_ T 7 N R 7 E

TYPE MONUMENT SM.RR.SPIKE  
 ON SURFACE - ~~BELOW~~ \_\_\_\_\_ ON \_\_\_\_\_  
 LEFT - ☉ PAV'T - RIGHT \_\_\_\_\_  
9.8 TO N EDGE PAVEMENT  
 S.L.M. 222+85.59

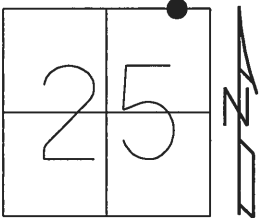

GRID: NORTHING: 687831.5939 EASTING: 1556887.3868

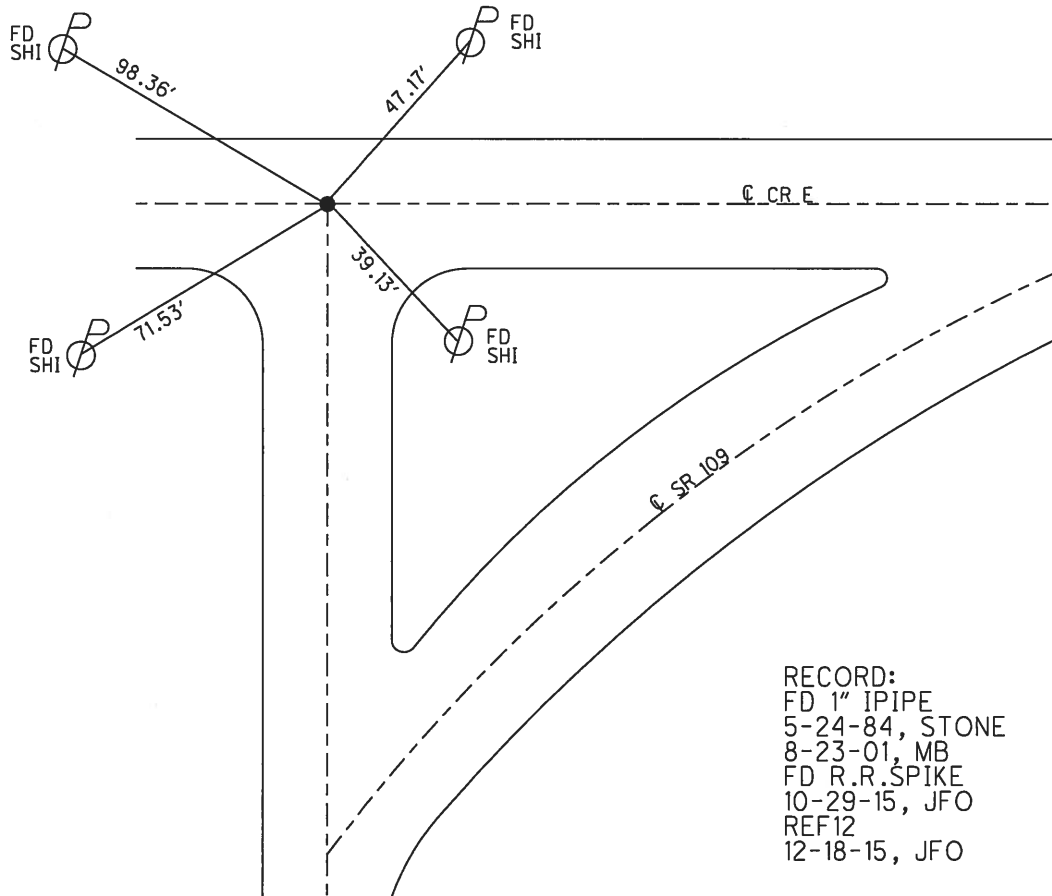

RECORD:  
 FD 1" IPIPE  
 5-24-84, STONE  
 8-23-01, MB  
 FD R.R.SPIKE  
 10-29-15, JFO  
 REF12  
 12-18-15, JFO

O.D.O.T. DISTRICT 2 SURVEY OFFICE

4 of 15

PERSONNEL

REFERENCE NO. 12

SHEET 14 OF 27

NOTES CORDES

H.C. CANTERBURY

DATE 8-10-94

ROUTE 109

R.C. HERMILLER

WEATHER CLOUDY

COUNTY Fulton

SIQUAK P

TEMP. +65°F

TOWNSHIP York

SECTION 25

T 7 N R 7 E



TYPE MONUMENT RR SPIKE (Lg)

ON SURFACE - ~~BELOW~~ YES

LEFT - ☉ PAV'T. - RIGHT —

28 TO ~~NORTH~~ EDGE PAVEMENT Co Rd "E"

S.L.M. —

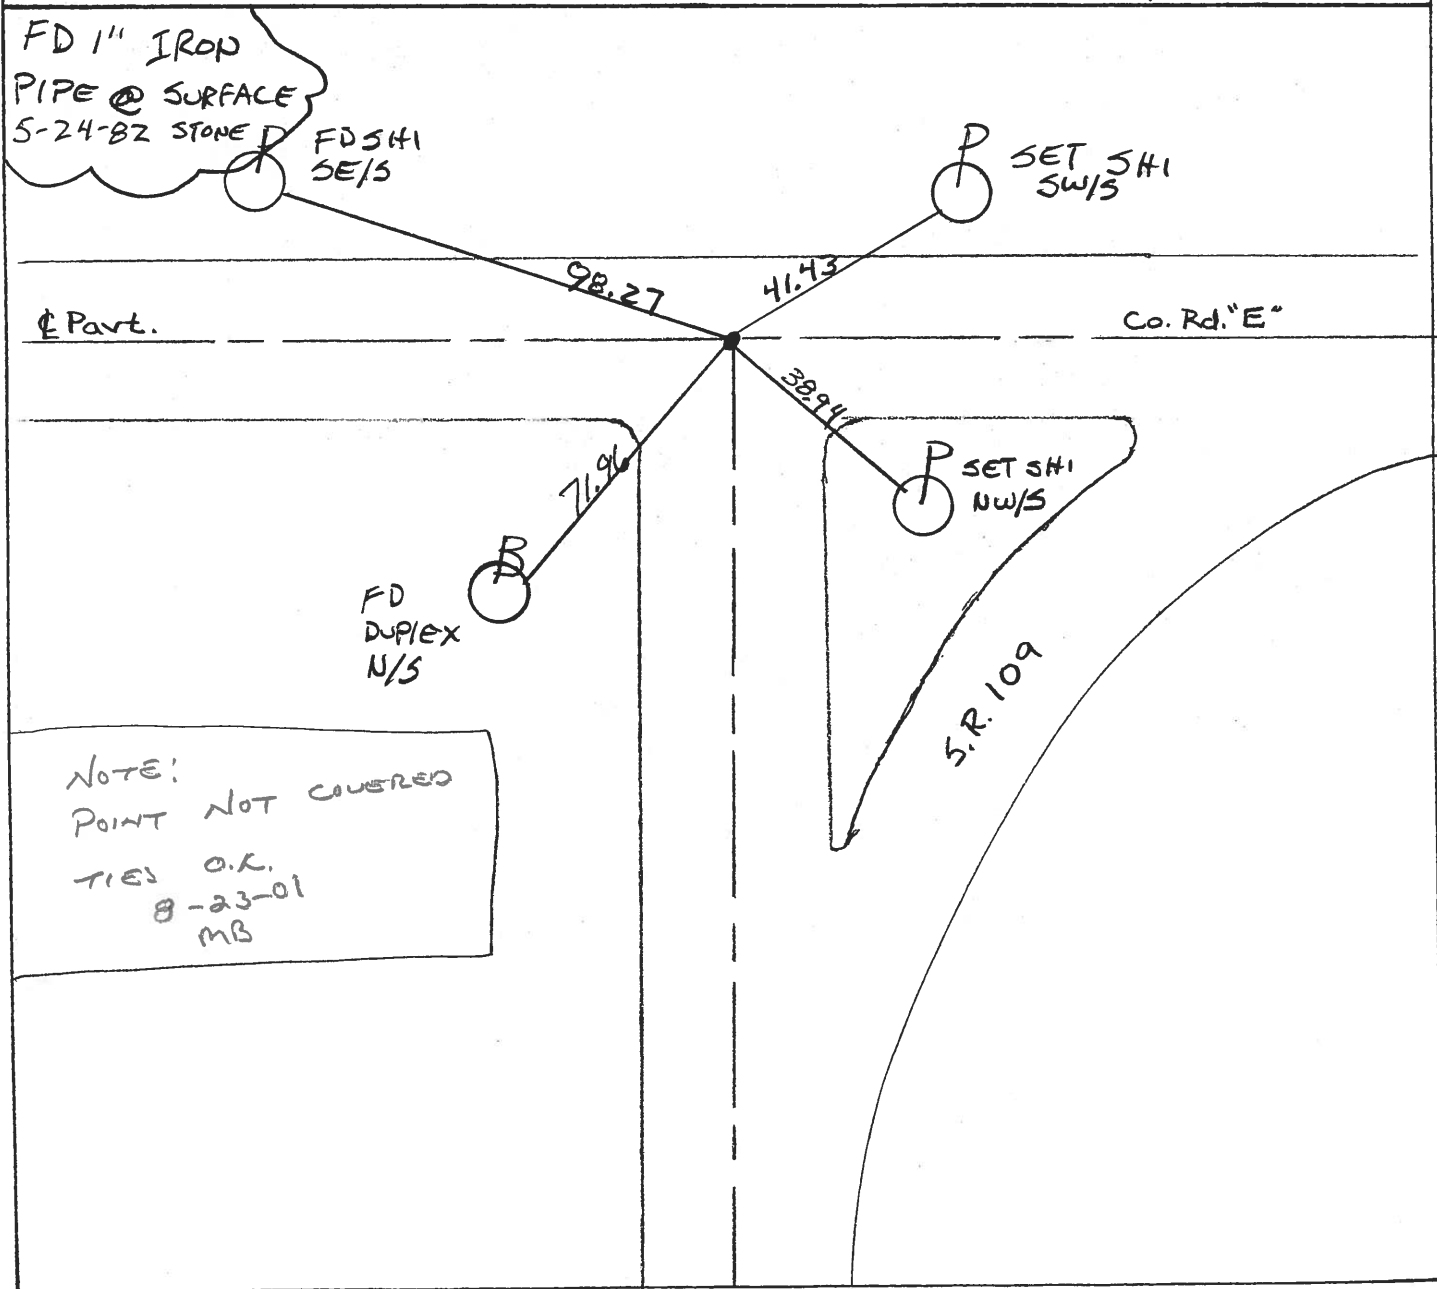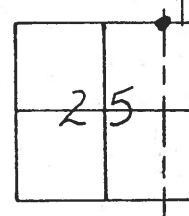

FD 1" IRON  
PIPE @ SURFACE  
5-24-82 STONE

FD SHI  
SE/S

P SET SHI  
SW/S

☉ Pavt.

Co. Rd. "E"

B

FD  
DUPLEX  
N/S

P

SET SHI  
NW/S

S.R. 109

NOTE:  
POINT NOT COVERED  
TIES O.K.  
8-23-01  
MB

# O.D.O.T. DISTRICT 2 SURVEY OFFICE

PERSONNEL

REFERENCE NO. 12

SHEET 14 OF 27

NOTES CORDES

H.C. CANTERBURY

DATE 8-10-94

ROUTE 109

R.C. HERMILLER

WEATHER CLOUDY

COUNTY Fulton

SIOUAK P

TEMP. + 65°F

TOWNSHIP York

SECTION 25

T 7 N R 7 E



TYPE MONUMENT RR SPIKE (Lg)

ON SURFACE - ~~BELOW~~ YES

LEFT - ☐ PAV'T. - RIGHT —

2.8 TO ~~NORTH~~ NORTH EDGE PAVEMENT CORNER

S.L.M. —

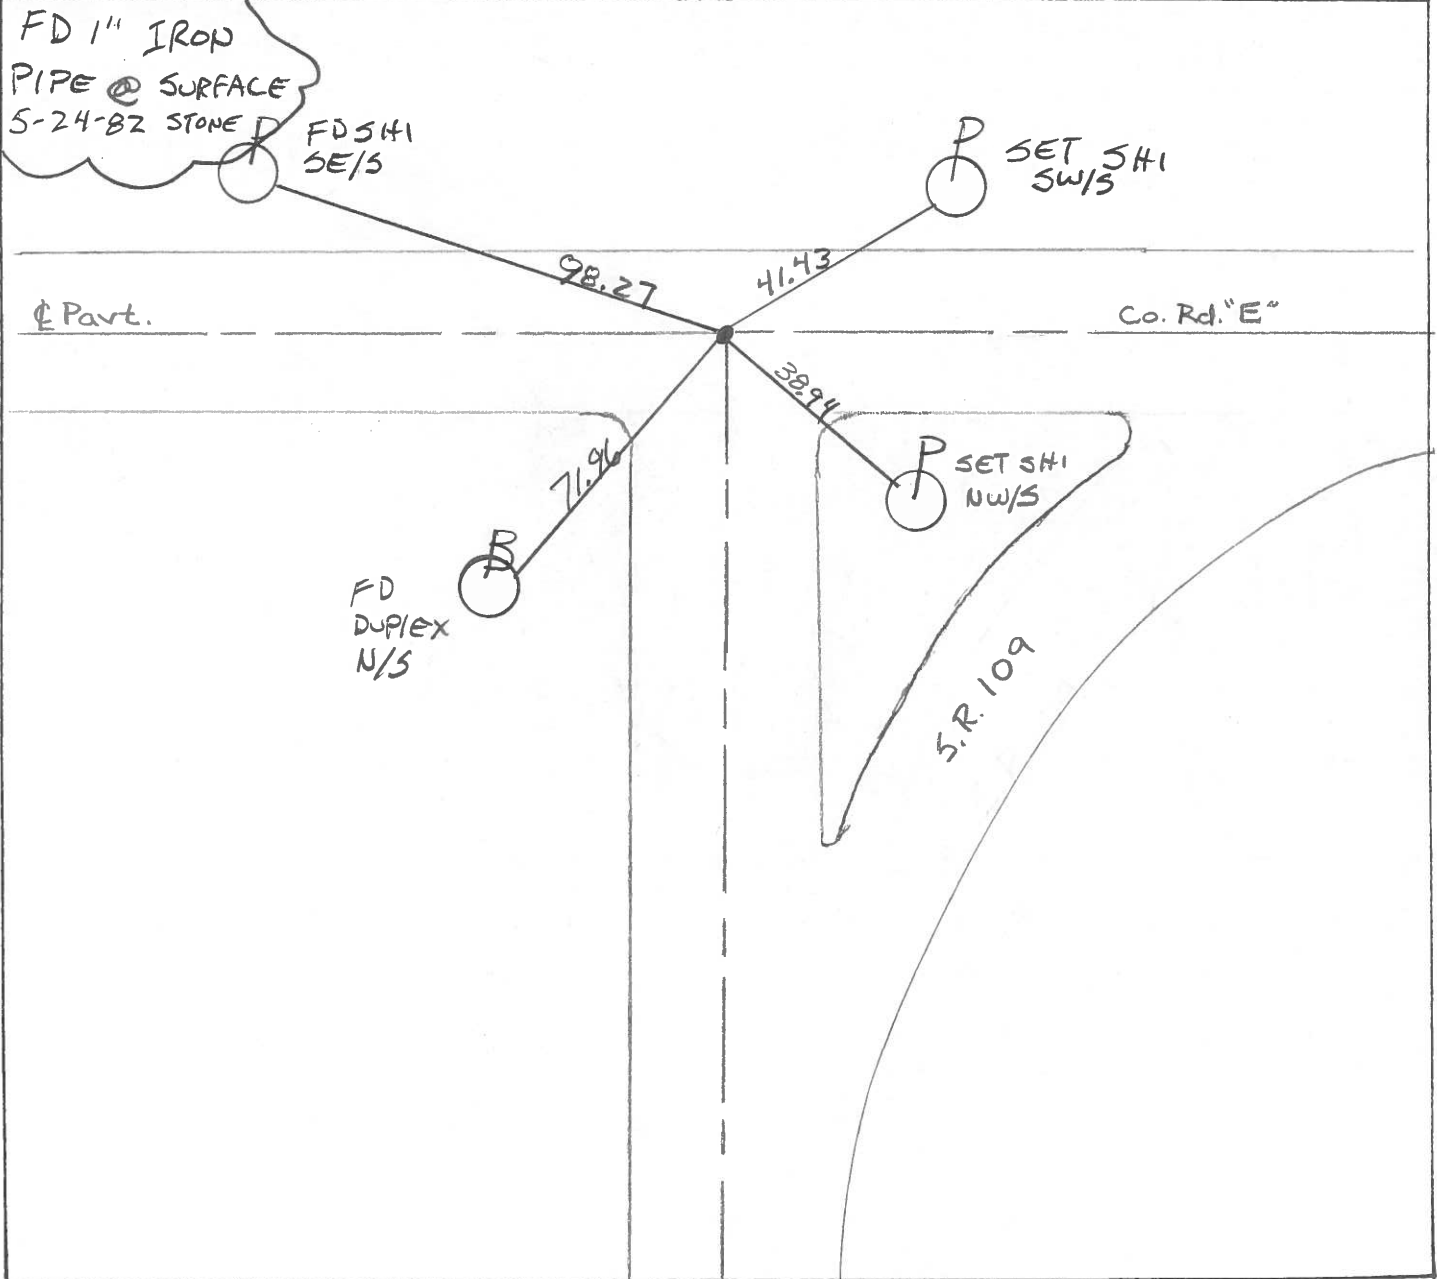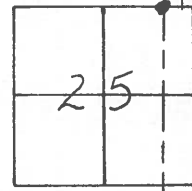

County Fulton S.R. 109

Date 24 May 82

Township Park

Weather Fair

Section 25

Temp. 70°

T. N, R. E


Personnel I. Stone

P. Newser


D. Curtis

R. Michalak

#12

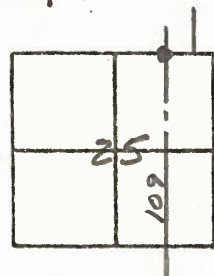

REF. NO. 12

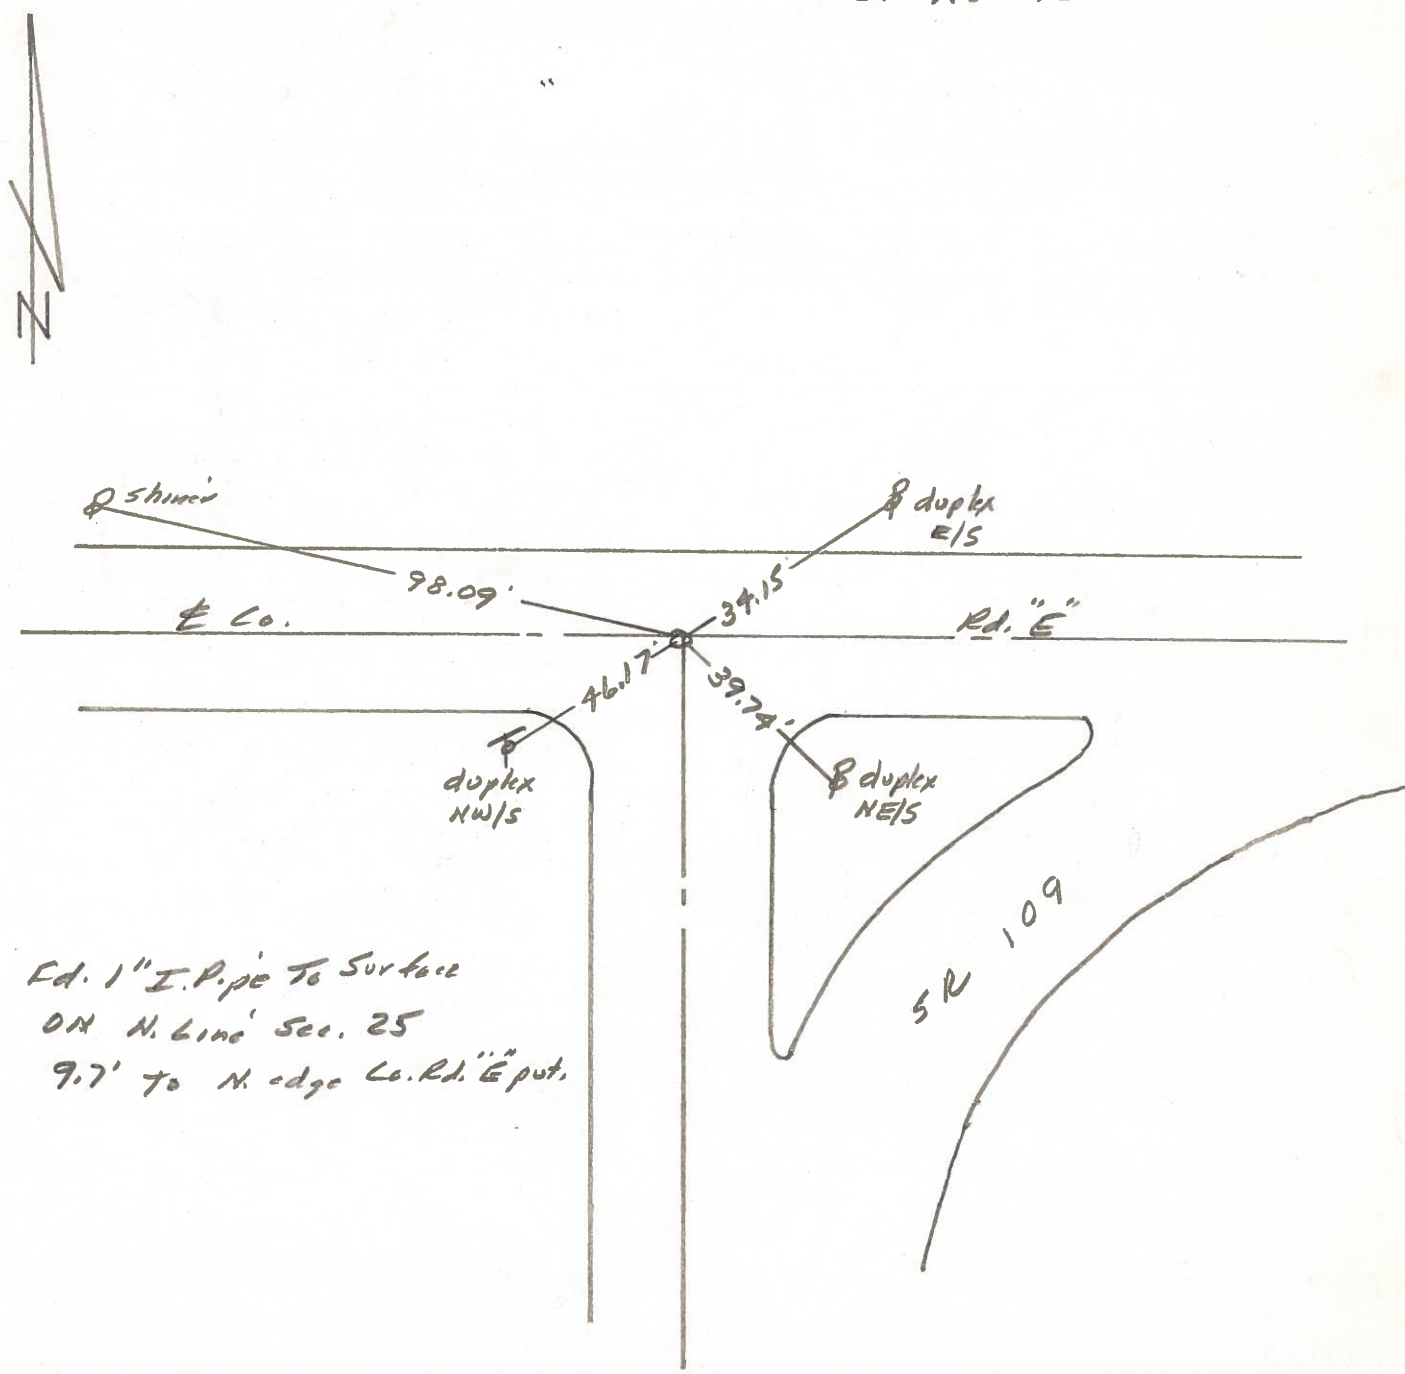


Ed. 1" I. Pipe To Surface  
 ON N. Line Sec. 25  
 9.7' To N. edge Co. Rd. E put.

PERSONNEL	TITLE	PERSONNEL	TITLE
Tomsic			
Nusser			
Gronata			
Vanyo			

COUNTY Fulton DATE July 16, 1973  
 S. R. 109 WEATHER \_\_\_\_\_  
 SEC. YORK TWP. TEMP. \_\_\_\_\_





DESCRIPTION \_\_\_\_\_ LEFT \_\_\_\_\_ CENTER LINE \_\_\_\_\_ RIGHT \_\_\_\_\_ JOB NO. \_\_\_\_\_

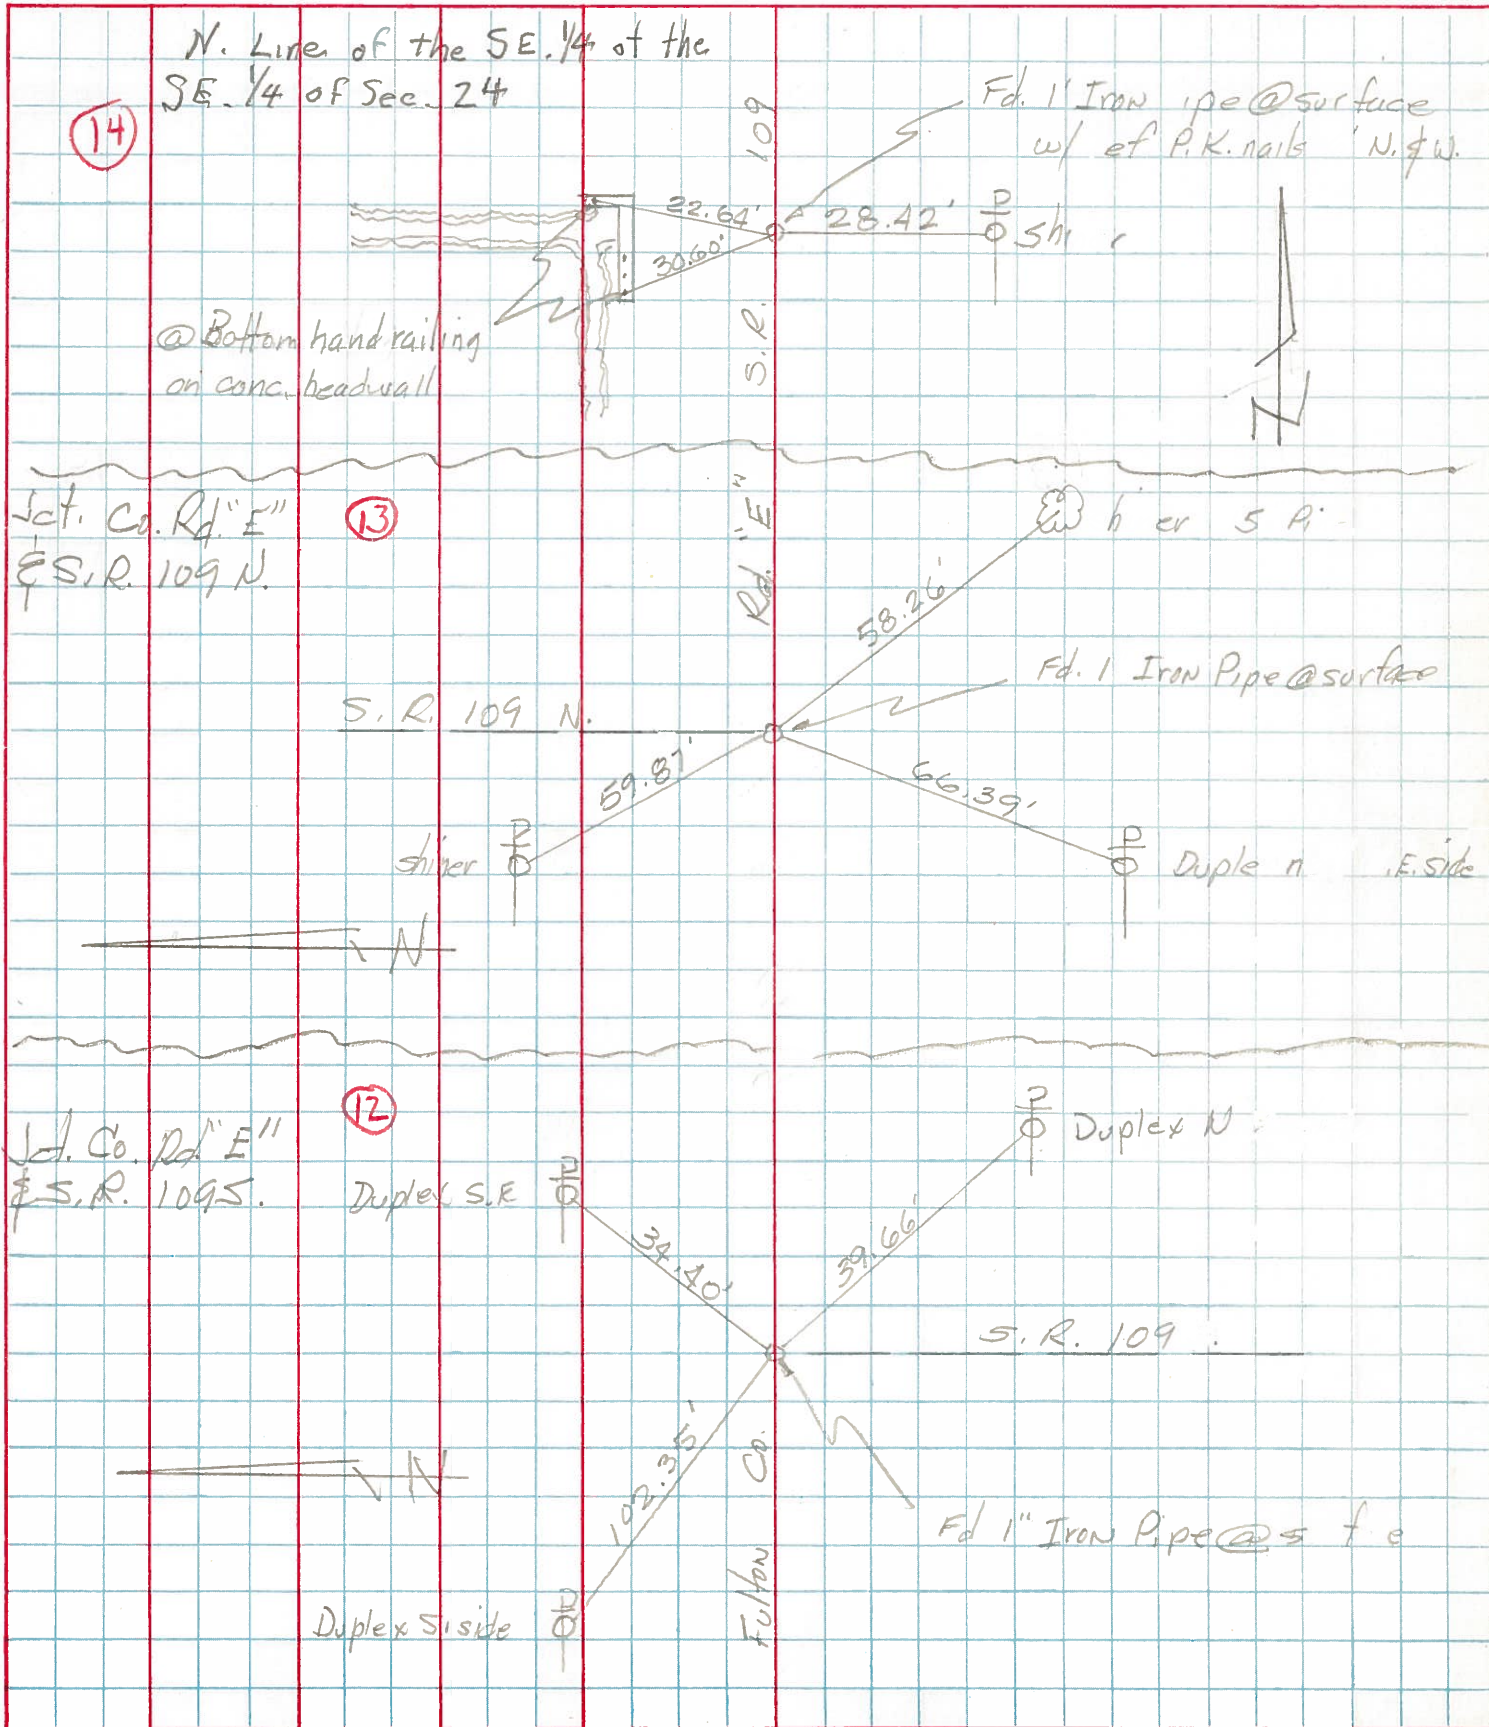

PERSONNEL TITLE PERSONNEL TITLE  
 Red Beach \_\_\_\_\_  
 Newcomb \_\_\_\_\_  
 Knape \_\_\_\_\_  
 Wise \_\_\_\_\_

COUNTY Fulton DATE Aug 1970  
 S. R. 109 WEATHER \_\_\_\_\_  
 SEC. York Twp TEMP. \_\_\_\_\_



DESCRIPTION CONTROL POINTS JOB NO. \_\_\_\_\_

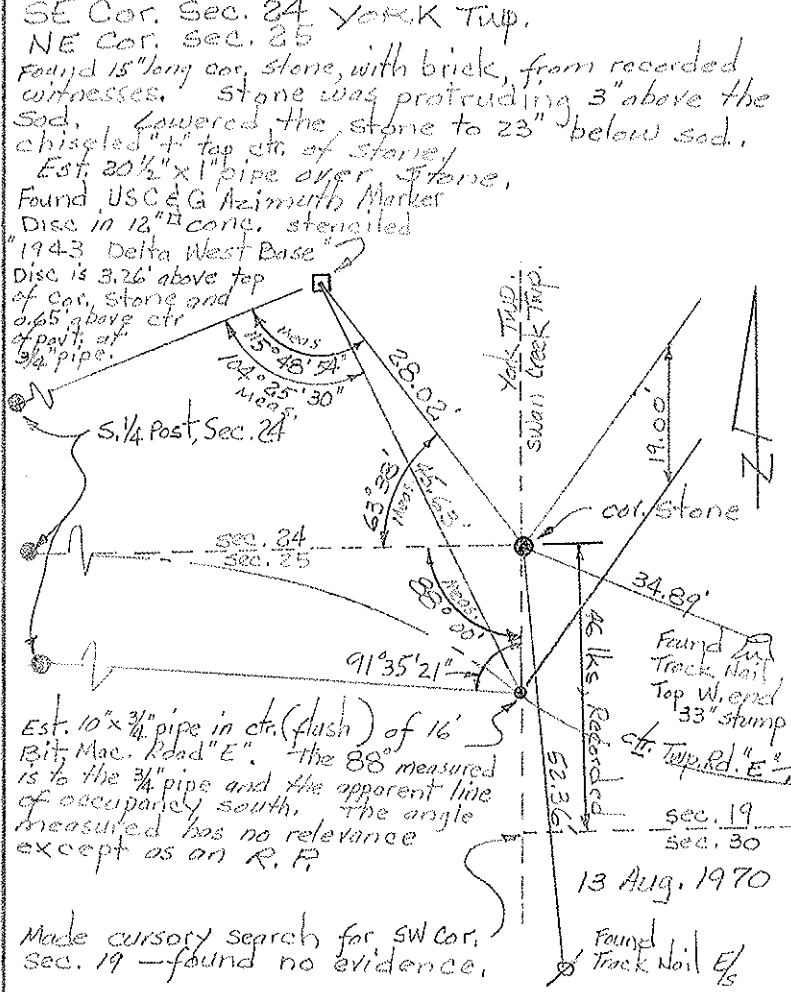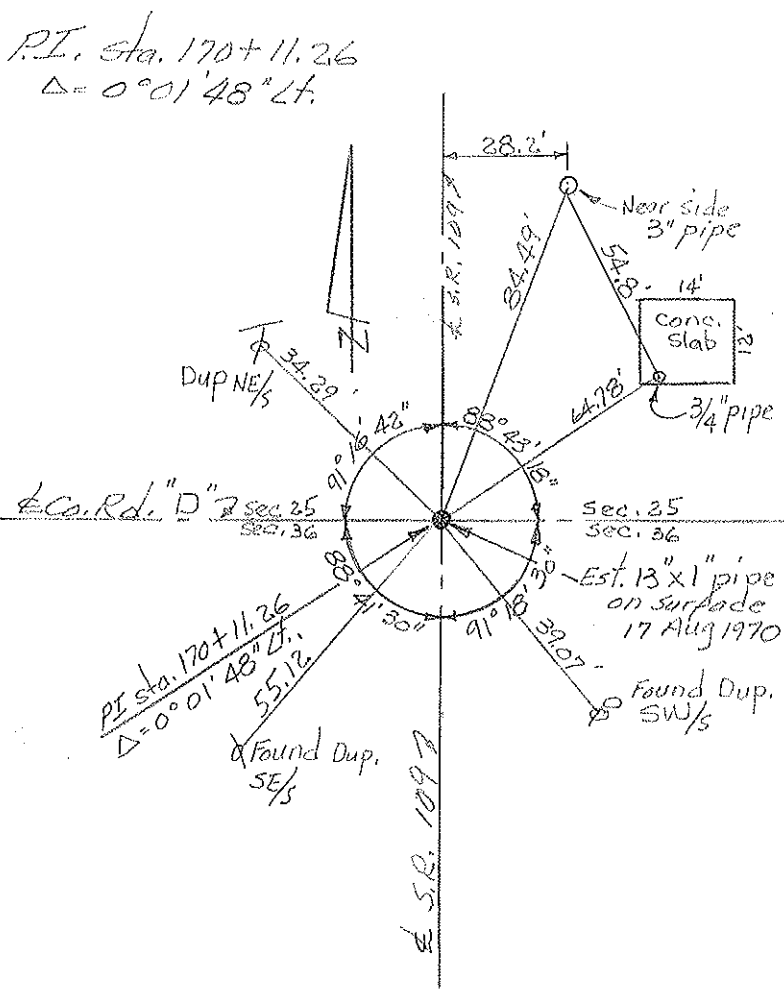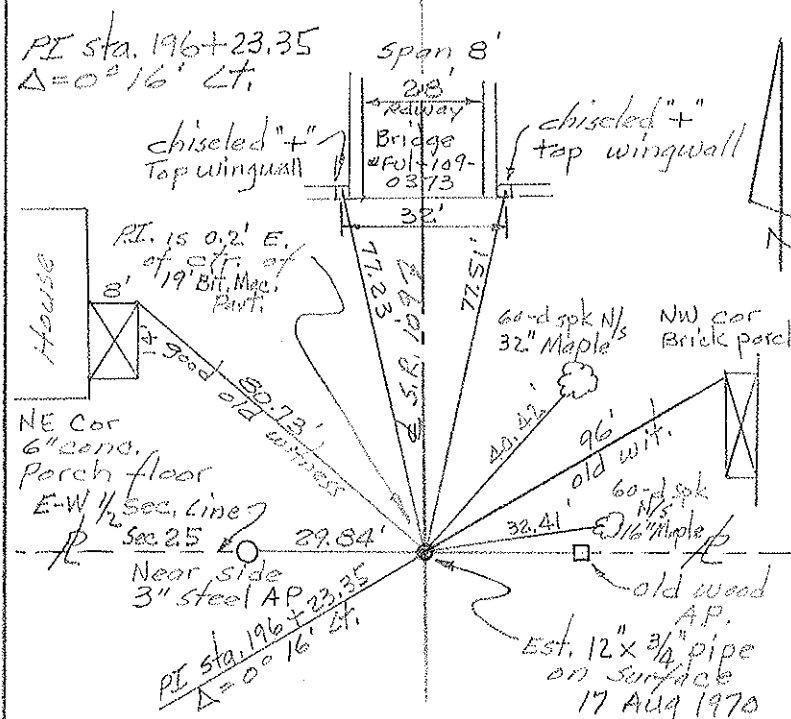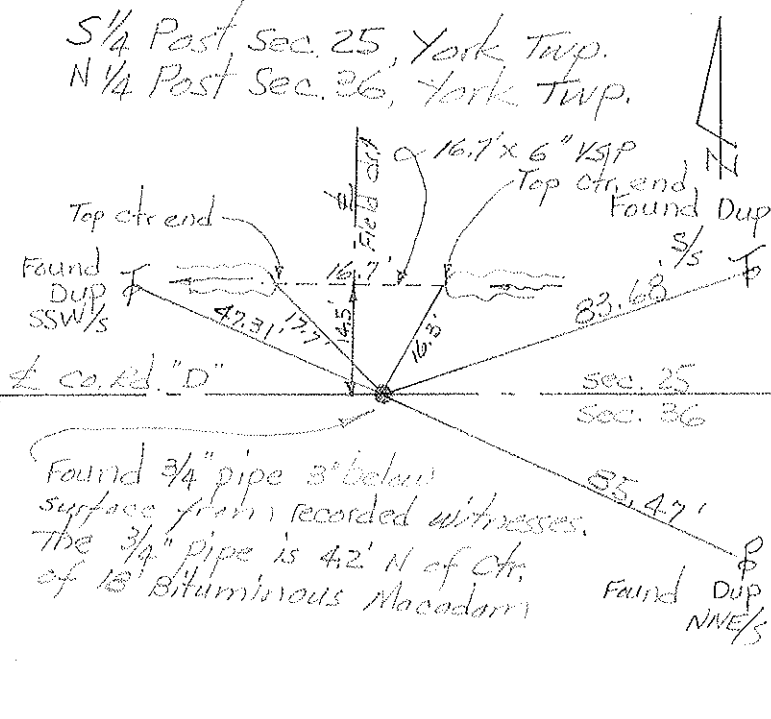



PERSONNEL	TITLE	PERSONNEL	TITLE
Red Beach			
Newcomb			
Knappe			
Wise			

COUNTY Fulton DATE Aug 1970  
 S. R. 109 WEATHER \_\_\_\_\_  
 SEC. YORK TWP. TEMP. \_\_\_\_\_

DESCRIPTION CONTROL POINTS JOB NO. \_\_\_\_\_

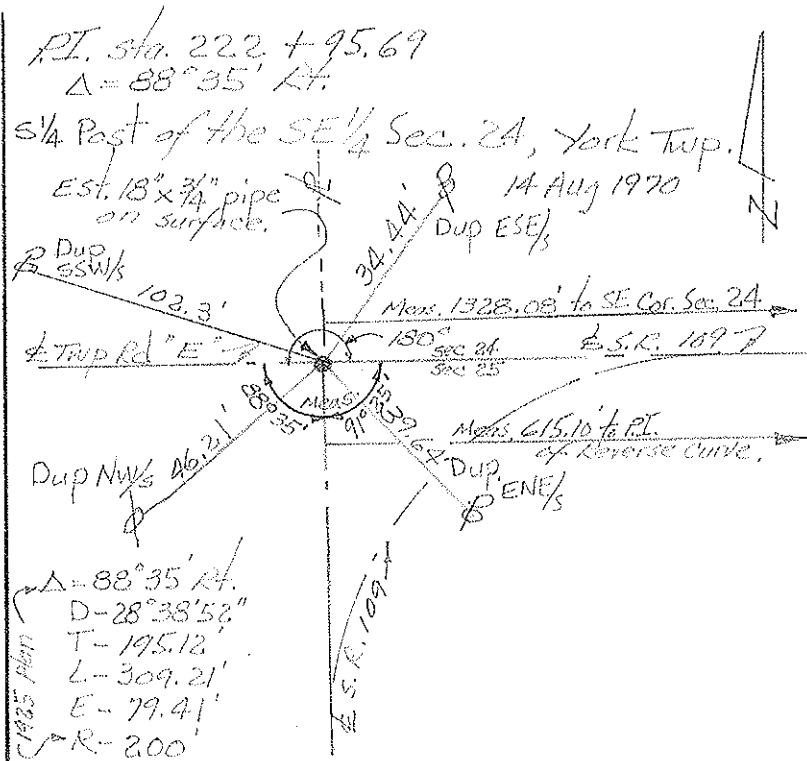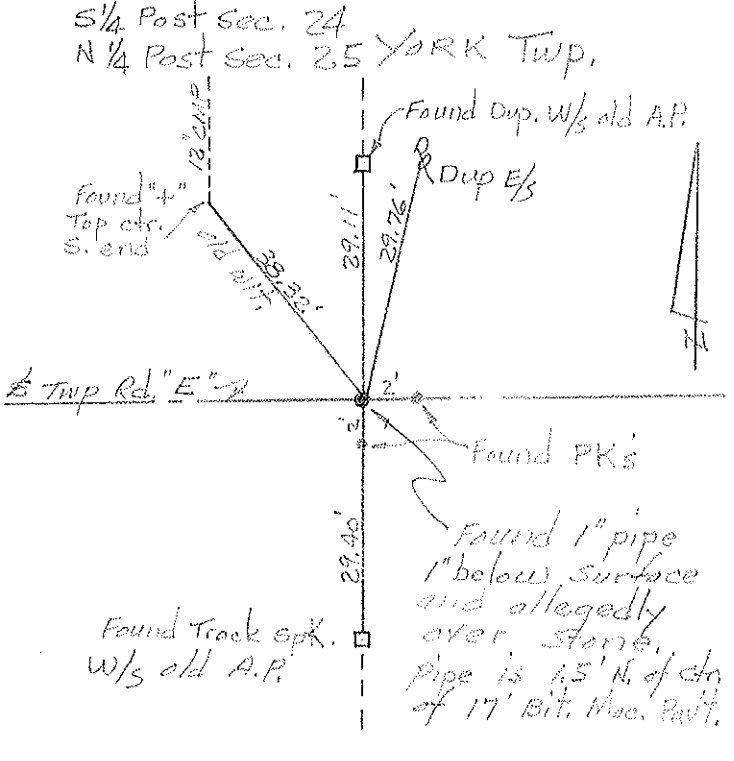





Cor. Stone, Sec. 23, 24, 25 & 26  
 YORK TWP.

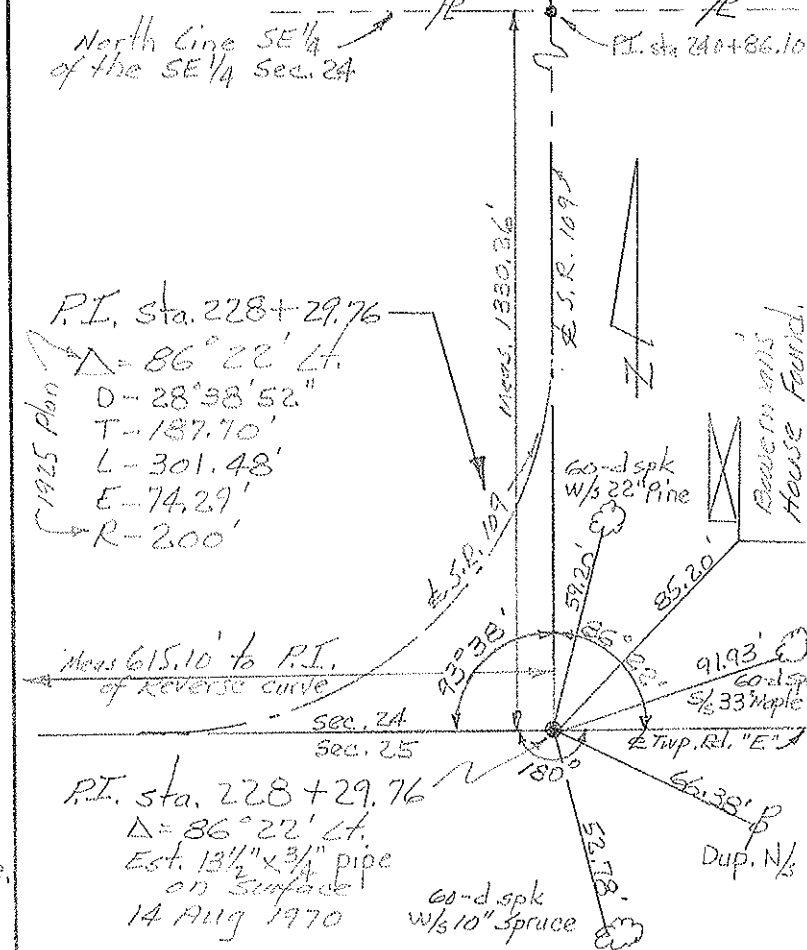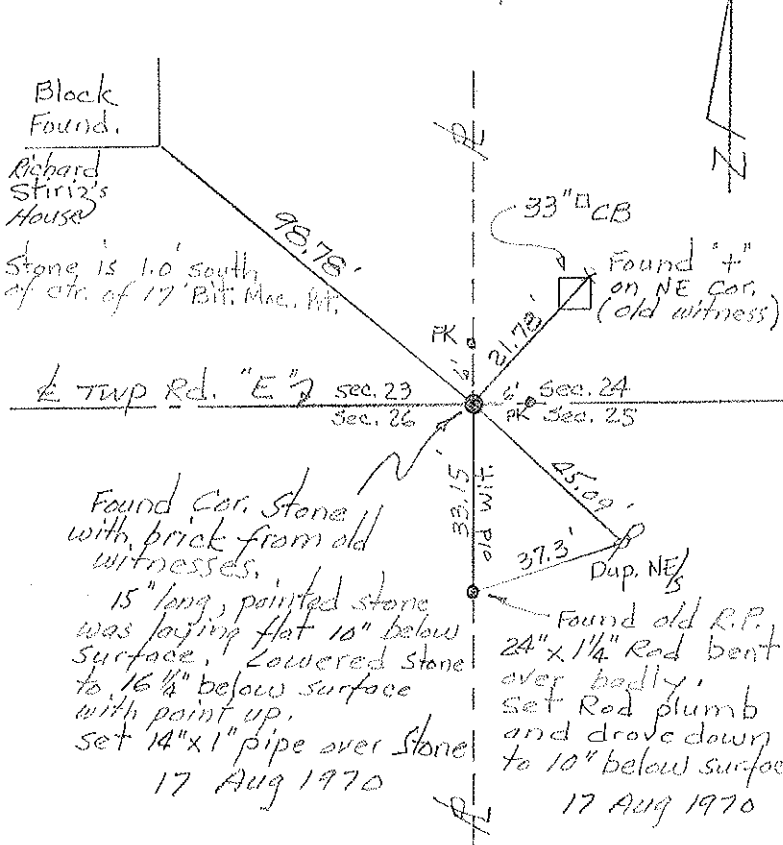

PERSONNEL TITLE PERSONNEL TITLE  
 Red Beach, \_\_\_\_\_  
 Newcomb \_\_\_\_\_  
 Knappe \_\_\_\_\_  
 Wise \_\_\_\_\_

COUNTY Fulton DATE Aug 1970  
 S. R. 109 WEATHER \_\_\_\_\_  
 SEC. YORK TWP. TEMP. \_\_\_\_\_

DESCRIPTION CONTROL POINTS JOB NO. \_\_\_\_\_

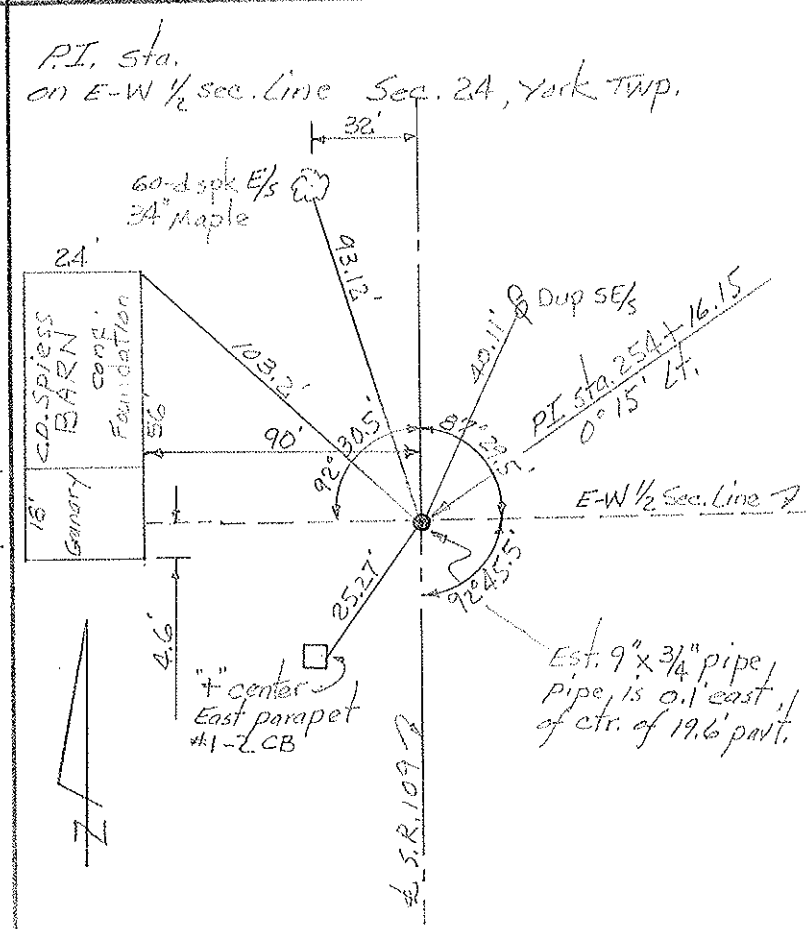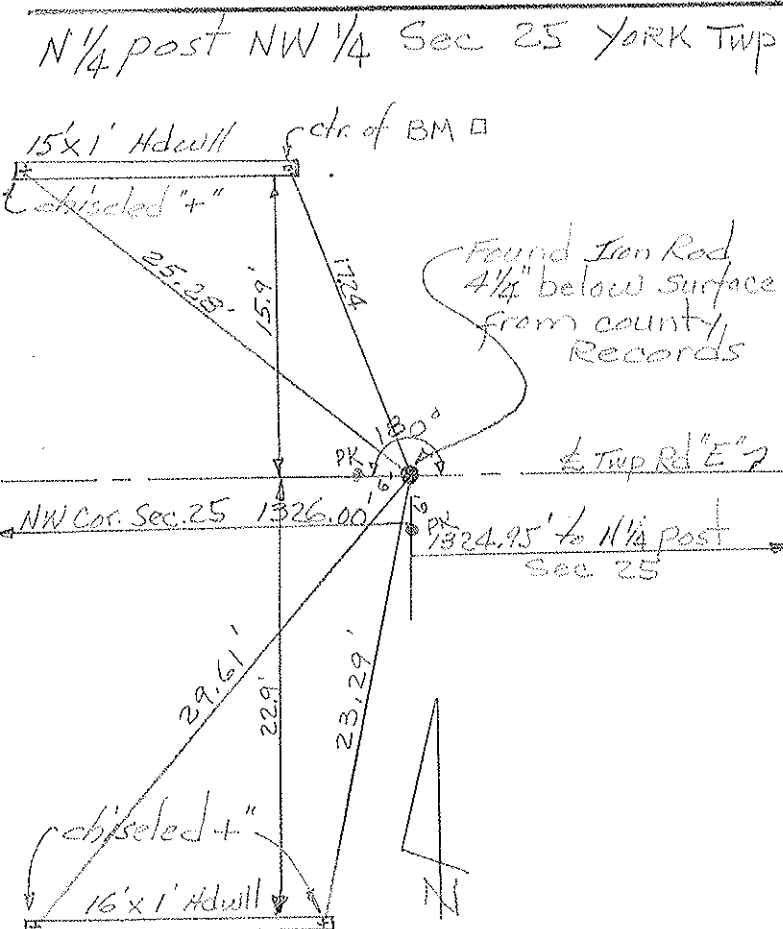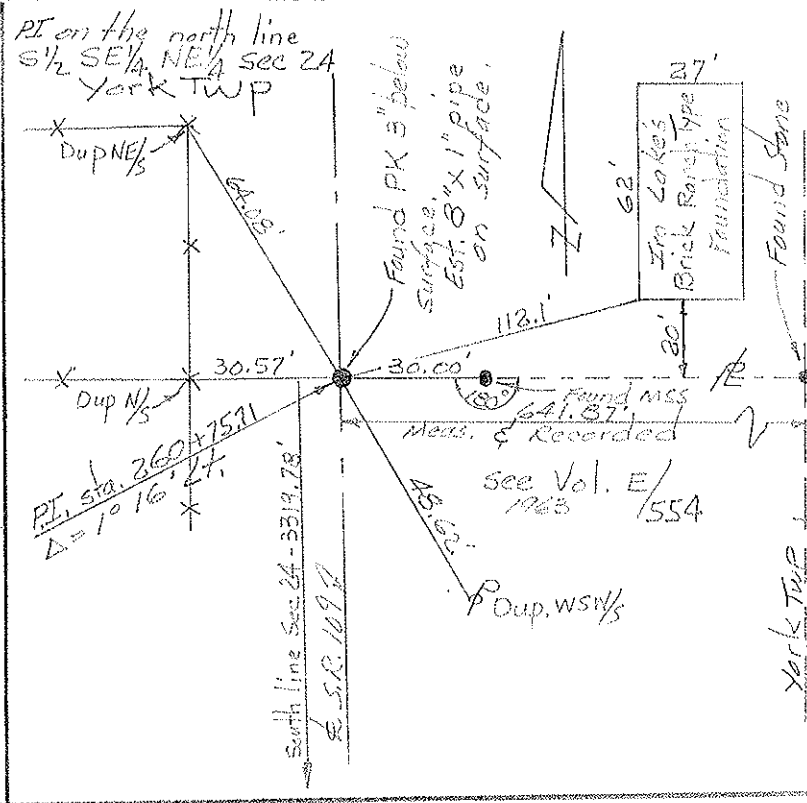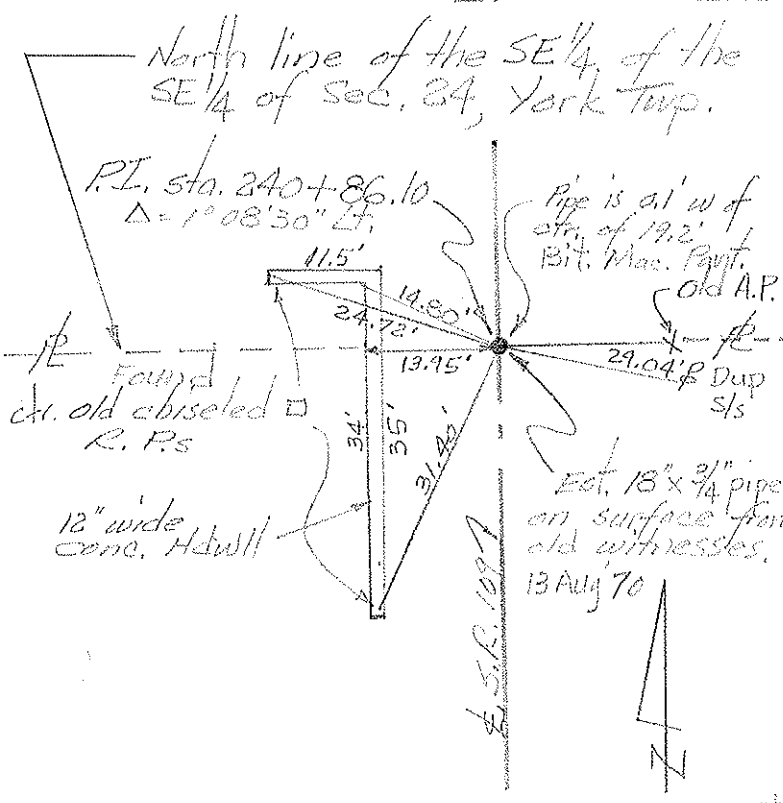



PERSONNEL	TITLE	PERSONNEL	TITLE
Red Beach			
Newcomb			
Knape			
Wise			

COUNTY Fulton DATE Aug 1970

S. R. 109 WEATHER \_\_\_\_\_

SEC. 25 York Twp. TEMP. \_\_\_\_\_

DESCRIPTION ALIGNMENT & CONTROLS JOB NO. \_\_\_\_\_

