

O.D.O.T. DISTRICT 2 SURVEY OFFICE (USE ONLY)

PERSONNEL _____ REFERENCE NO. 13 SHEET 17 OF 31

NOTES RHOADES DATE 7-26-17 ROUTE SR 109
 H.C. O'DONNELL WEATHER SUNNY COUNTY FULTON
 R.C. CARSON TEMP. 67° TOWNSHIP YORK
 _____ SECTION 25
 _____ T 7 N R 7 E

TYPE MONUMENT 1" SQ.BOLT


ON SURFACE - ~~BELOW~~ ON _____

LEFT - ☉ PAV'T - RIGHT _____


9.7 TO s EDGE PAVEMENT @ CR E

S.L.M. 228+19.57

GRID: NORTHING: 687837.4190 EASTING: 1557502.3892

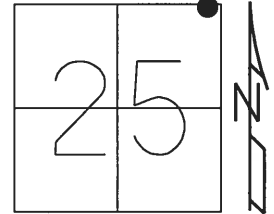

RECORD:
 FD 1" IPIPE
 5-24-82, STONE
 8-23-01, MB
 FD 1" S.Q.BOLT
 10-29-15, JFO
 REF13
 12-18-15, JFO

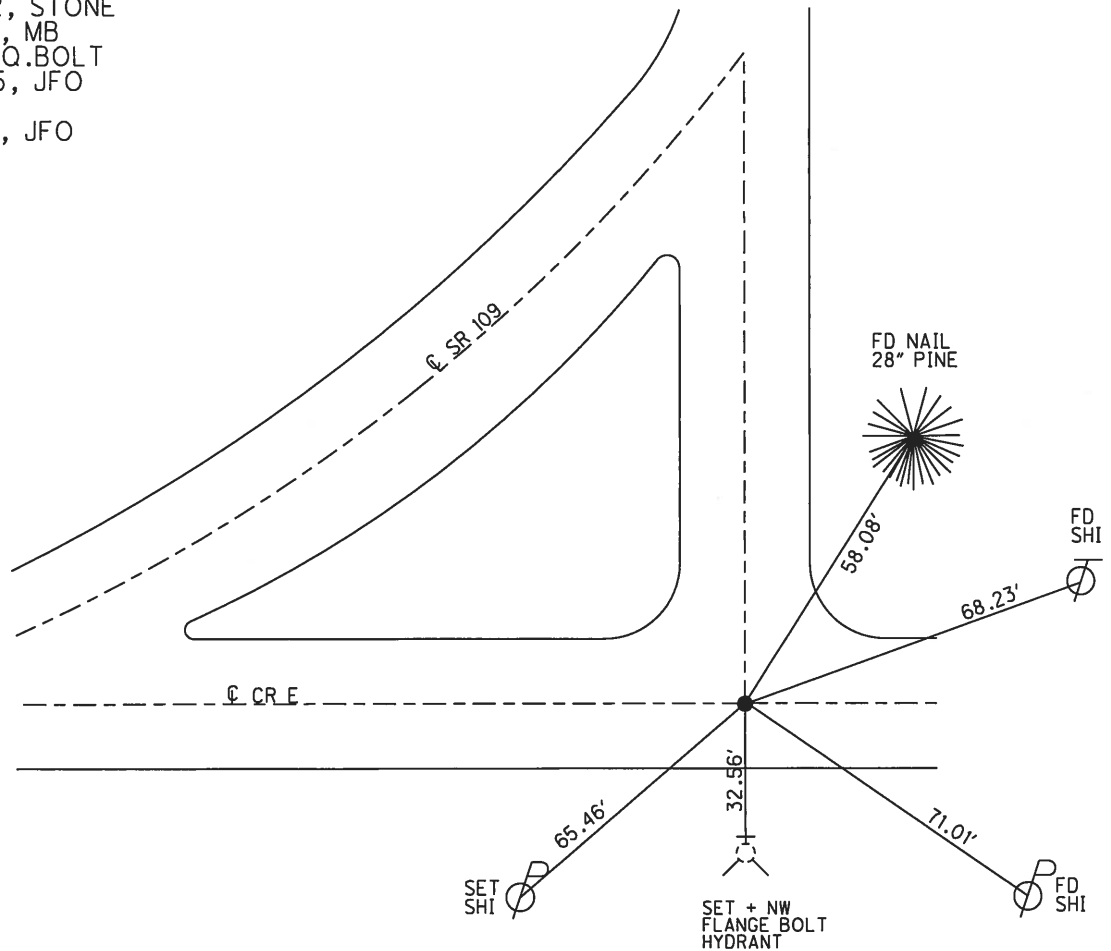

O.D.O.T. DISTRICT 2 SURVEY OFFICE 5 of 15

PERSONNEL

REFERENCE NO. 13

SHEET 15 OF 27

NOTES CORDES

H.C. CANTERBURY

DATE 8-10-94

ROUTE 109

R.C. SLOVAK

WEATHER cloudy

COUNTY Fulton

HERMILLER P

TEMP. +65° F

TOWNSHIP York

SECTION 25

T. 7 N R. 7 E


TYPE MONUMENT RR SPIKE (Lg)

ON SURFACE - ~~BELOW~~ YES

LEFT- & PAV'T. - RIGHT ---


9.7 TO SOUTH EDGE PAVEMENT CORDE

S.L.M. ---

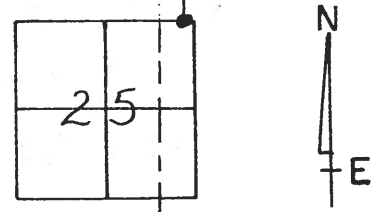

NOTE:
POINT NOT COVERED
TIES O.K.
8-23-01
MB

FDI" IRON PIPE @
SURFACE 5-24-82.
STONE

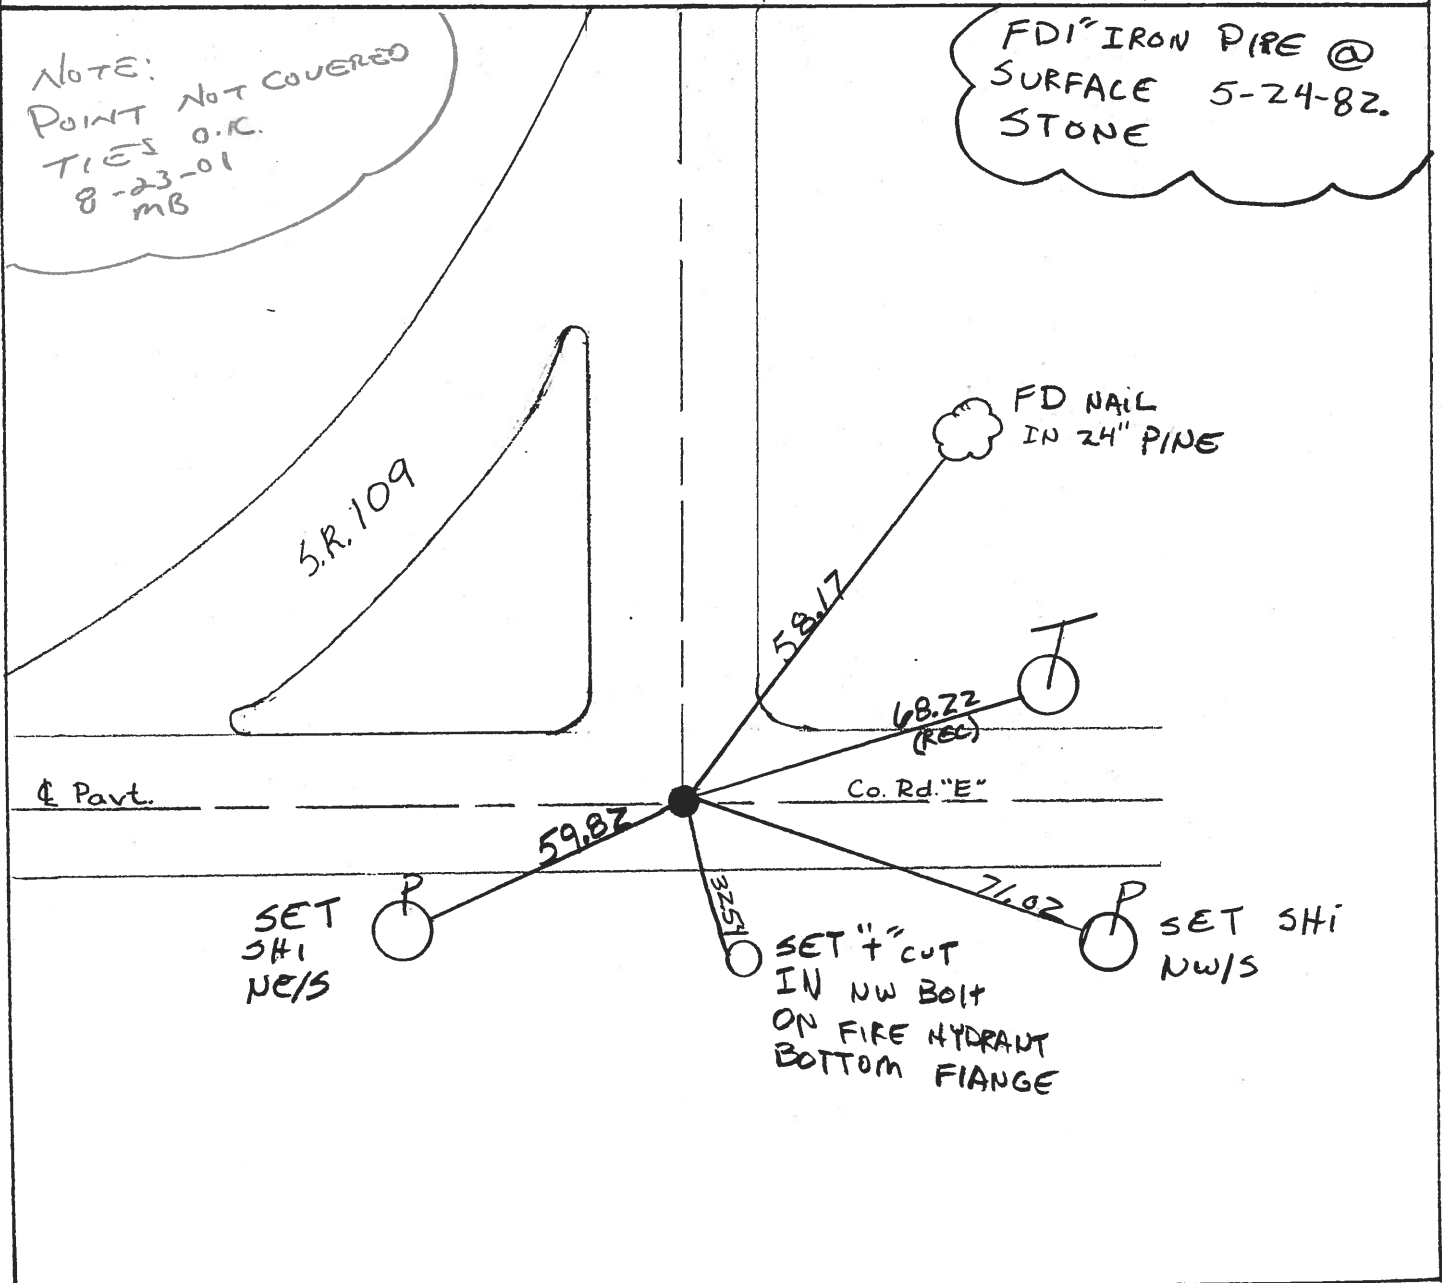

O.D.O.T. DISTRICT 2 SURVEY OFFICE

PERSONNEL

REFERENCE NO. 13

SHEET 15 OF 27

NOTES CORDES

H.C. CANTERBURY

DATE 8-10-94

ROUTE 109

R.C. SIOUAK

WEATHER CLOUDY

COUNTY Fulton

HERMILLER P

TEMP. +65° F

TOWNSHIP York

SECTION 25

T 7 N R 7 E


TYPE MONUMENT RR SPIKE (Lg)

ON SURFACE - ~~BELOW~~ YES


LEFT - Q PAV'T. - RIGHT

9.7 TO SOUTH EDGE PAVEMENT CORNER "E"

S.L.M.

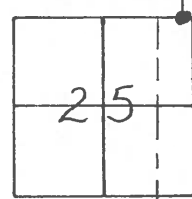

FD 1" IRON PIPE @
SURFACE 5-24-82.
STONE

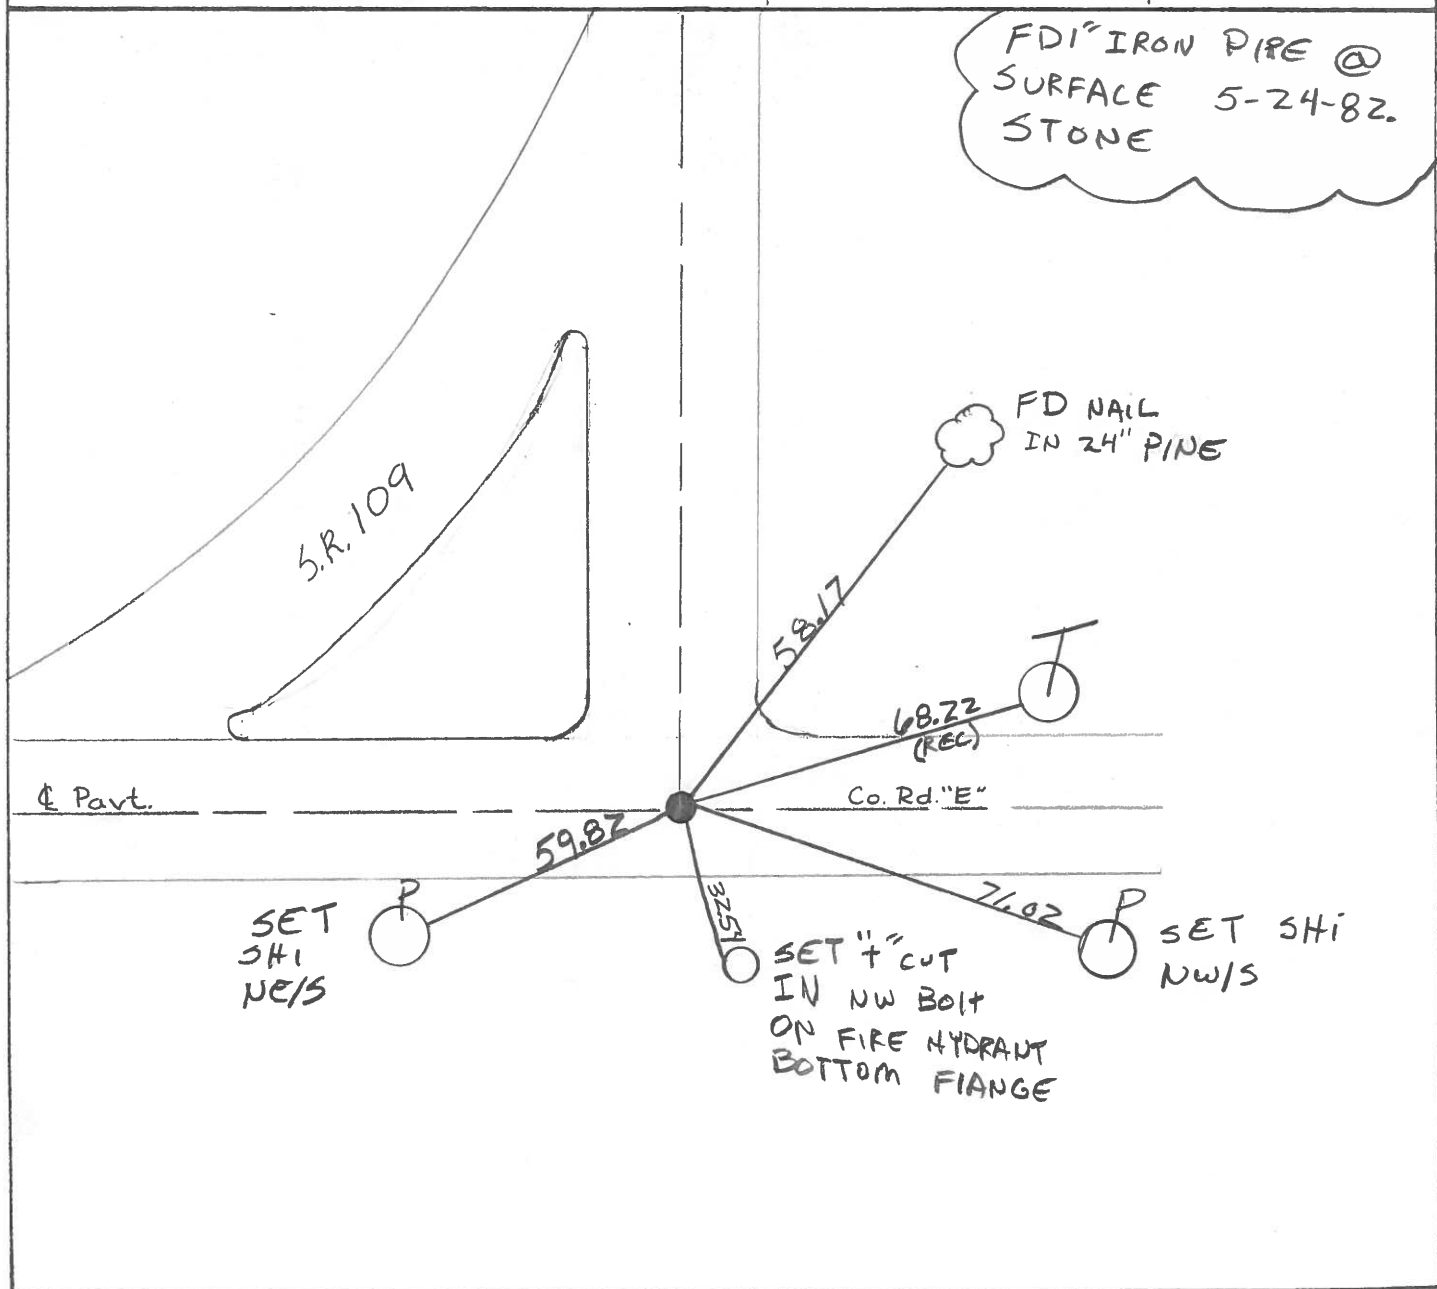

County Fulton S.R. 109

Date 24 May 82

Township York

Weather Fair


Section 25

Temp. 70°


T N, R E

Personnel J. Stone
P. Neuser
J. Curtis
R. Michalak

#13

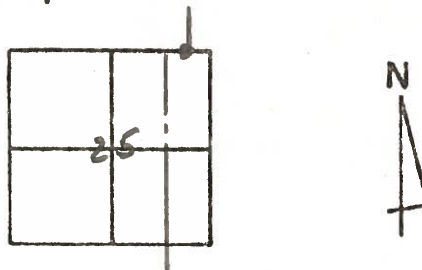


REF. NO. 13

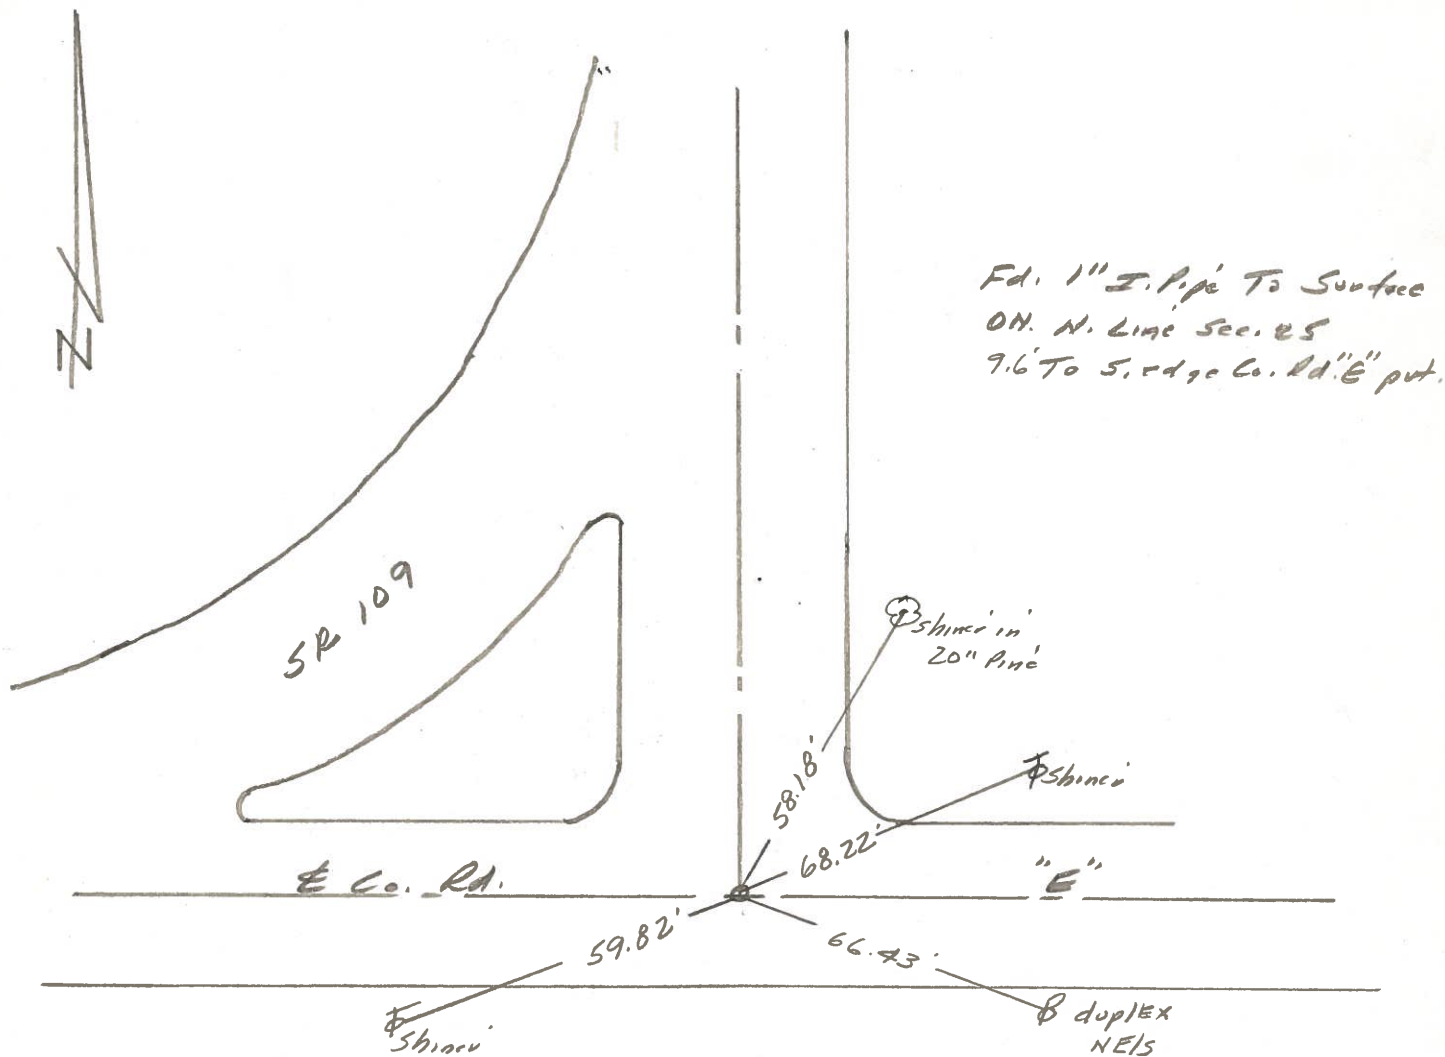

PERSONNEL	TITLE	PERSONNEL	TITLE
Tomsic			
Muser			
Granata			
Vanyo			

COUNTY Fulton DATE July 16, 1973
 S. R. 109 WEATHER _____
 SEC. YORK Twp. TEMP. _____



DESCRIPTION _____ LEFT _____ CENTER LINE _____ RIGHT _____ JOB NO. _____

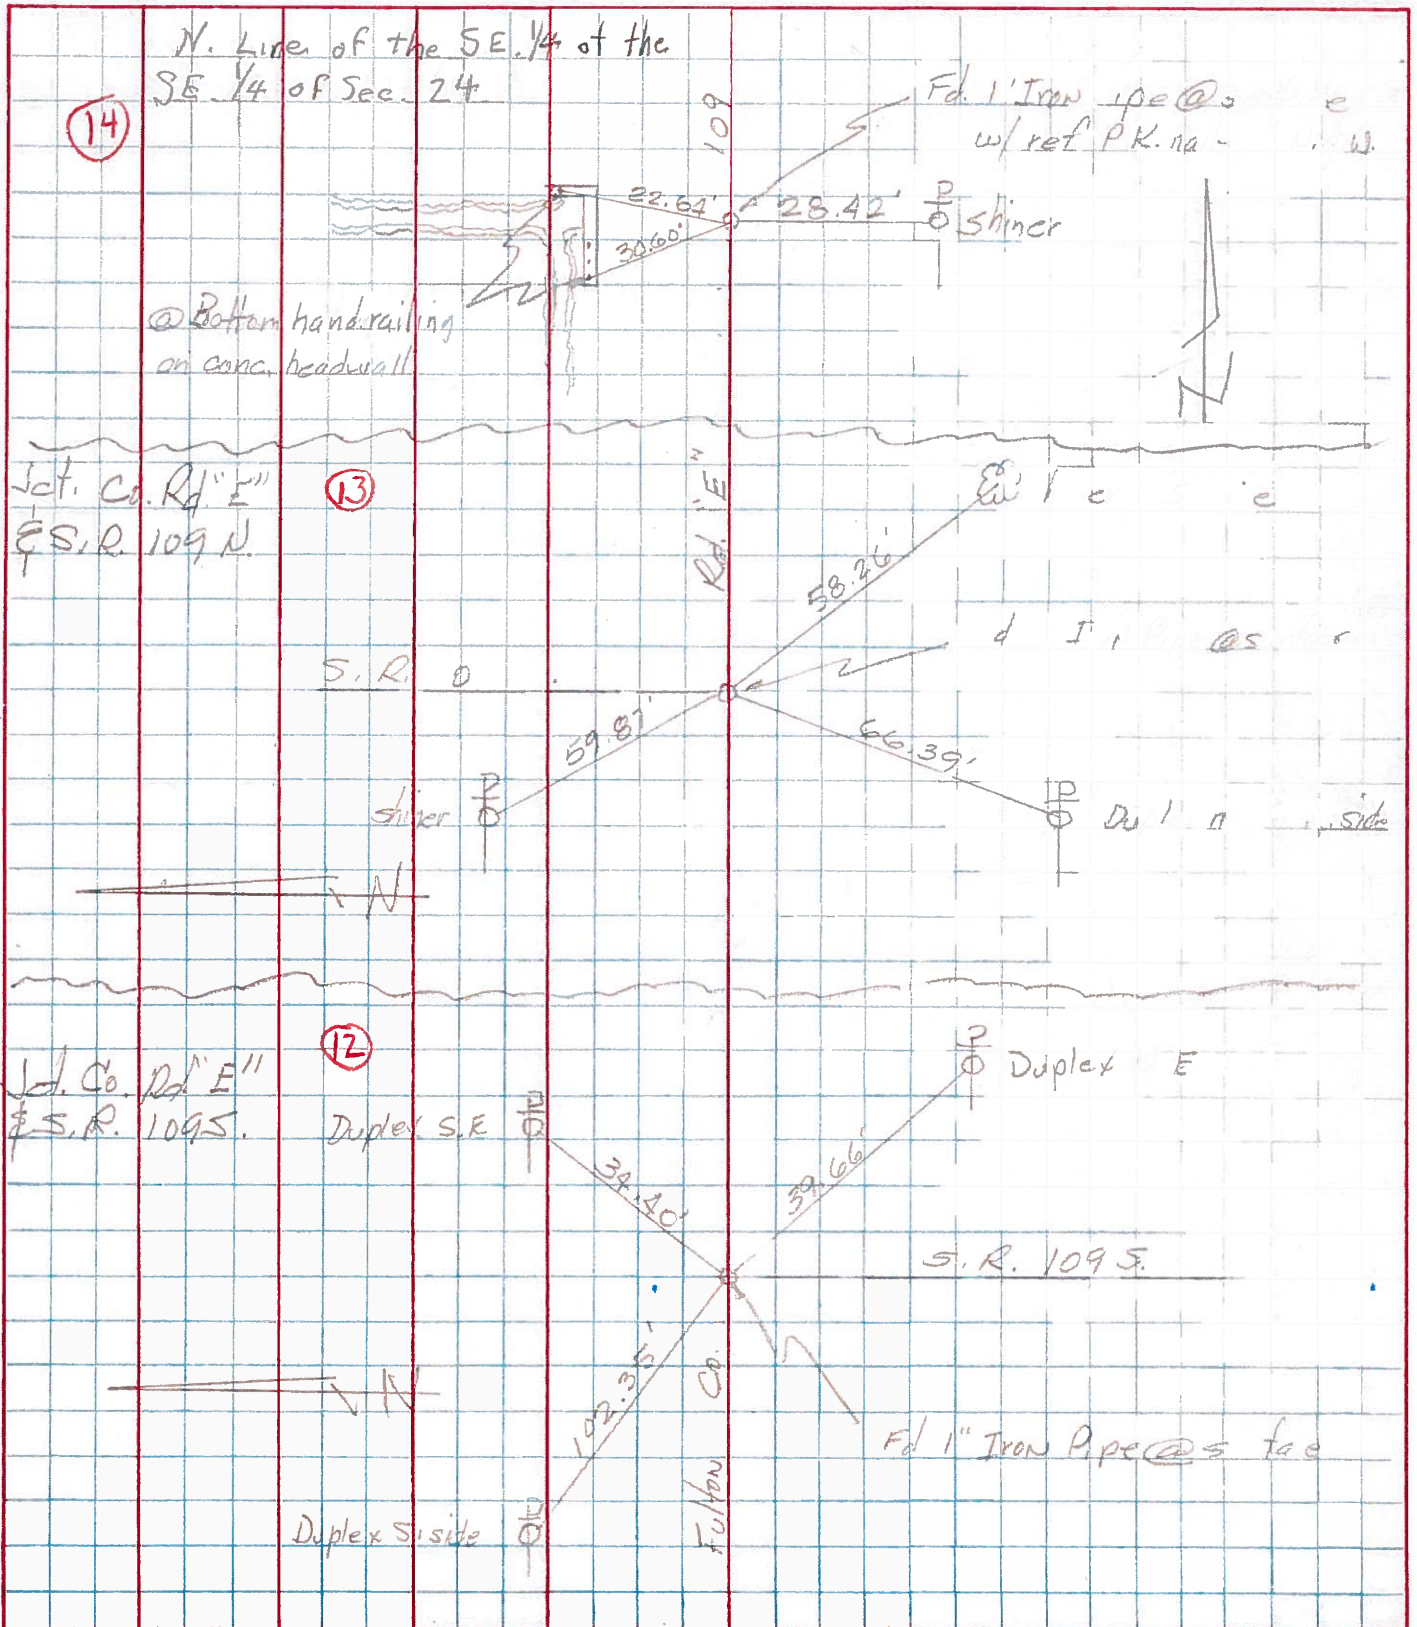



PERSONNEL	TITLE	PERSONNEL	TITLE
Red Beach			
Newcomb			
Knappe			
Wise			

COUNTY Fulton DATE Aug 1970
 S. R. 109 WEATHER _____
 SEC. YORK TWP. TEMP. _____

DESCRIPTION CONTROL POINTS JOB NO. _____

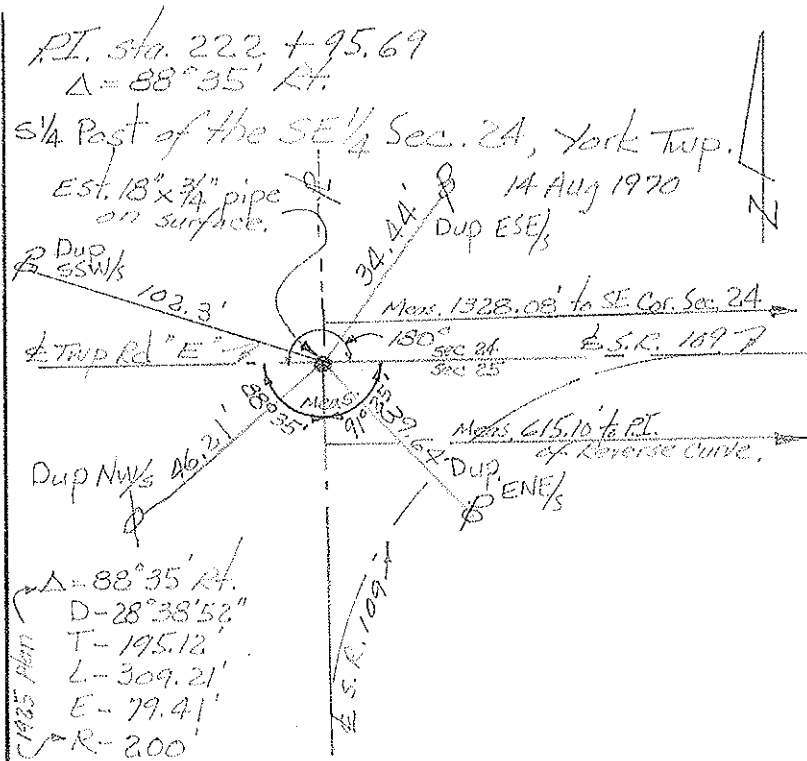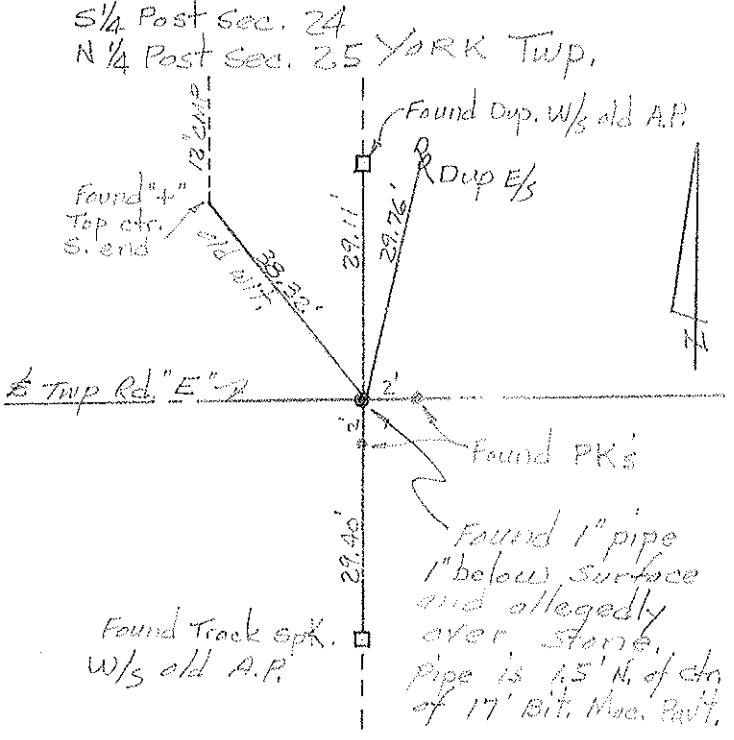





Cor. Stone, Sec. 23, 24, 25 & 26 YORK TWP.

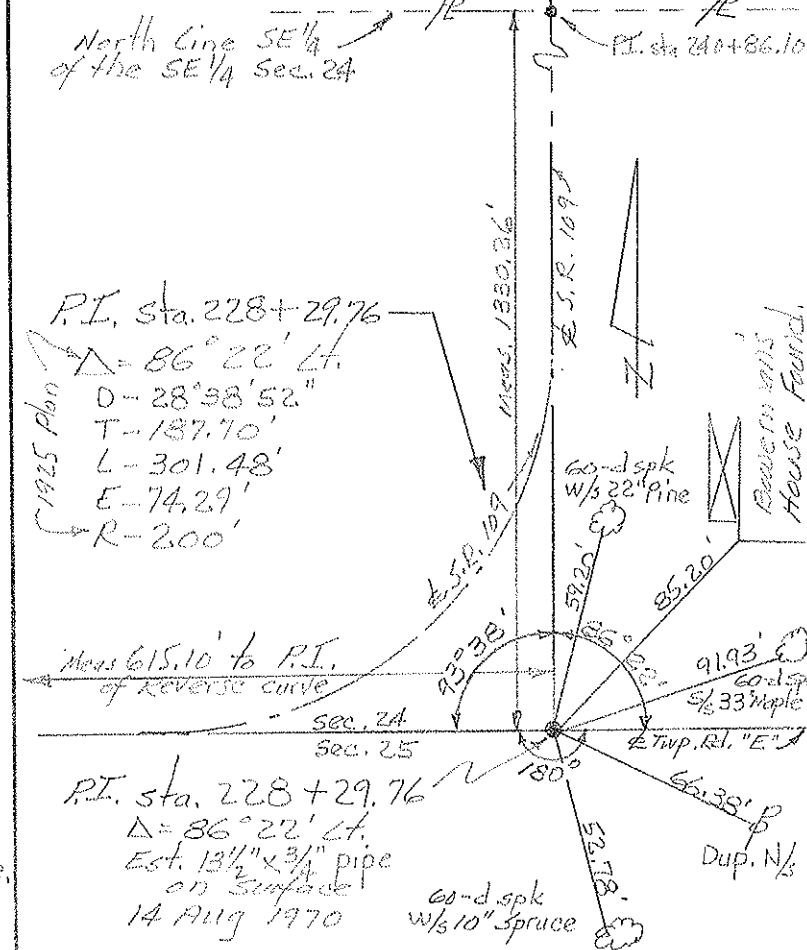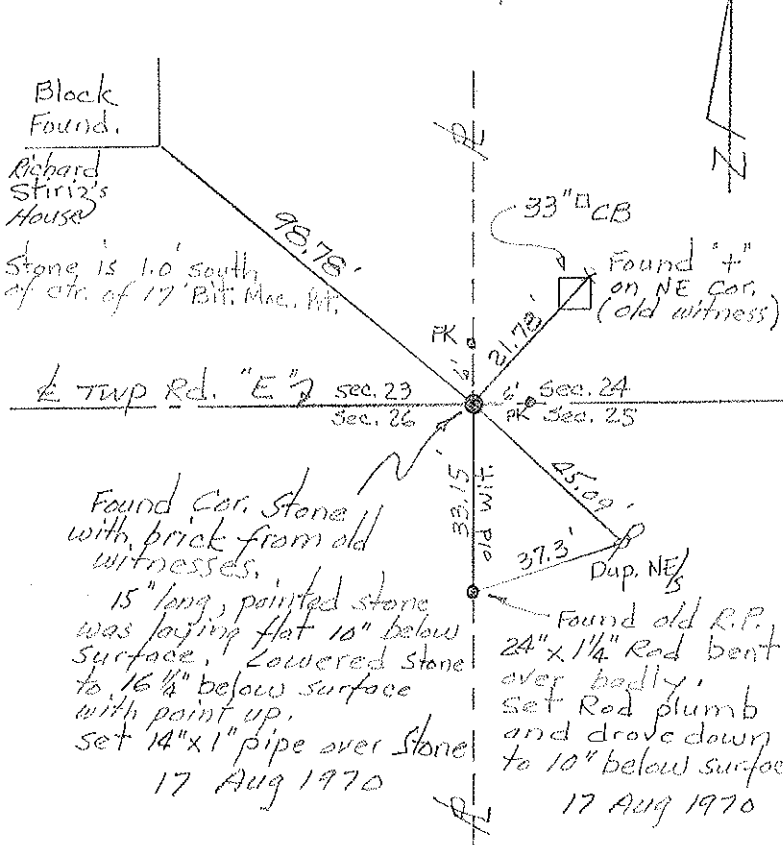

PERSONNEL TITLE PERSONNEL TITLE
 Red Beach
 Newcomb
 Knappe
 Wise

COUNTY Fulton DATE Aug 1970
 S. R. 109 WEATHER
 SEC. YORK TWP. TEMP.

DESCRIPTION CONTROL POINTS JOB NO.

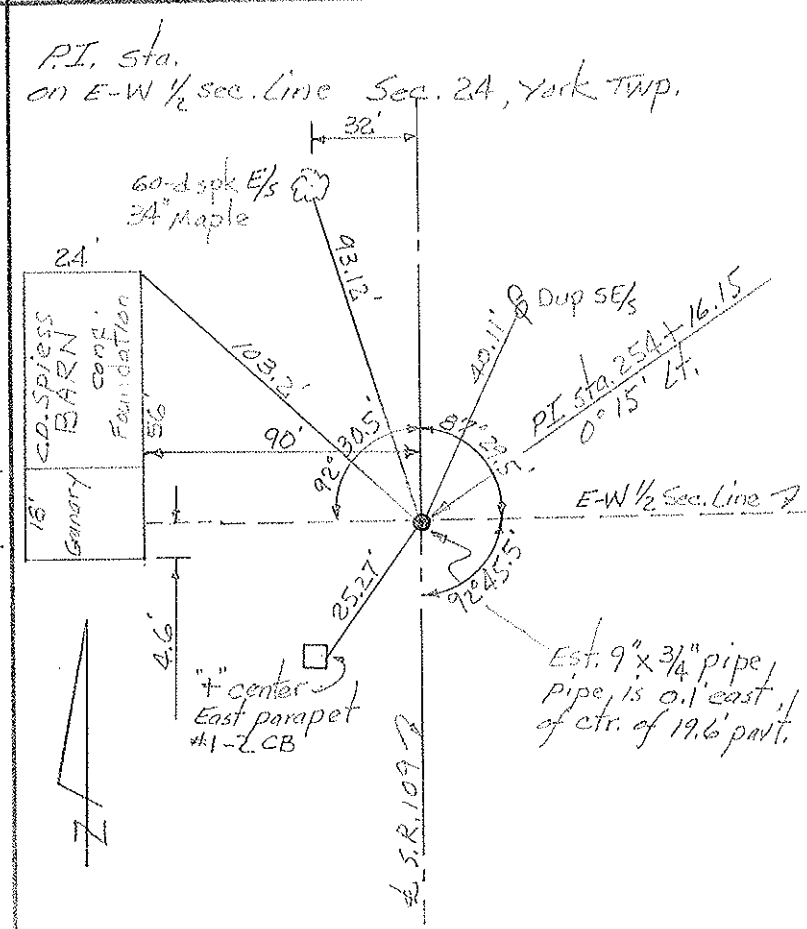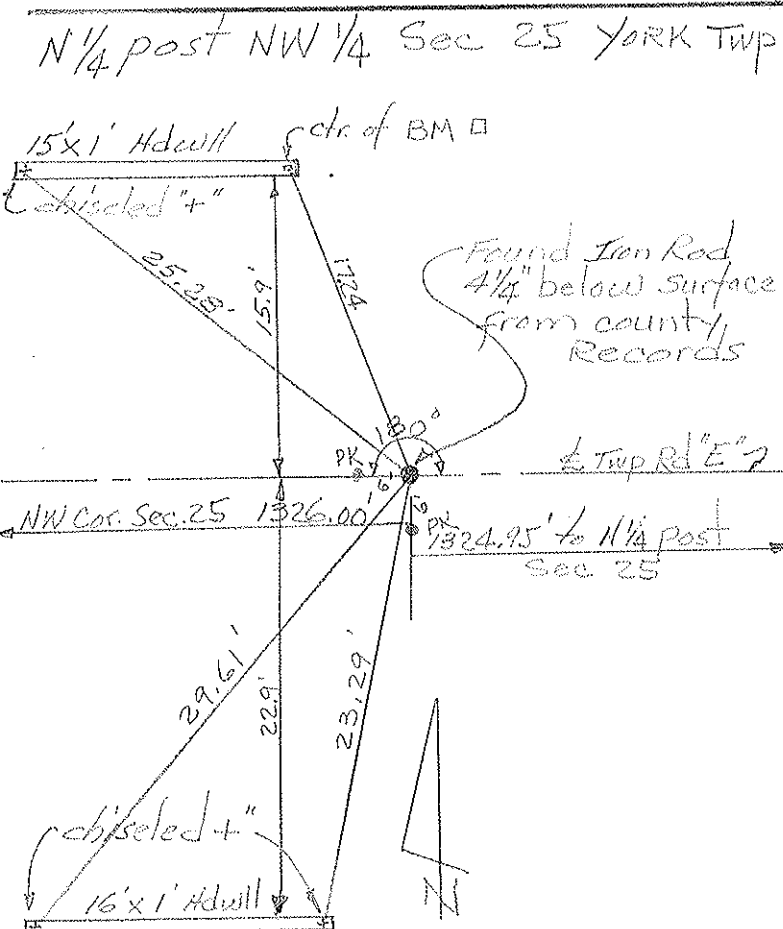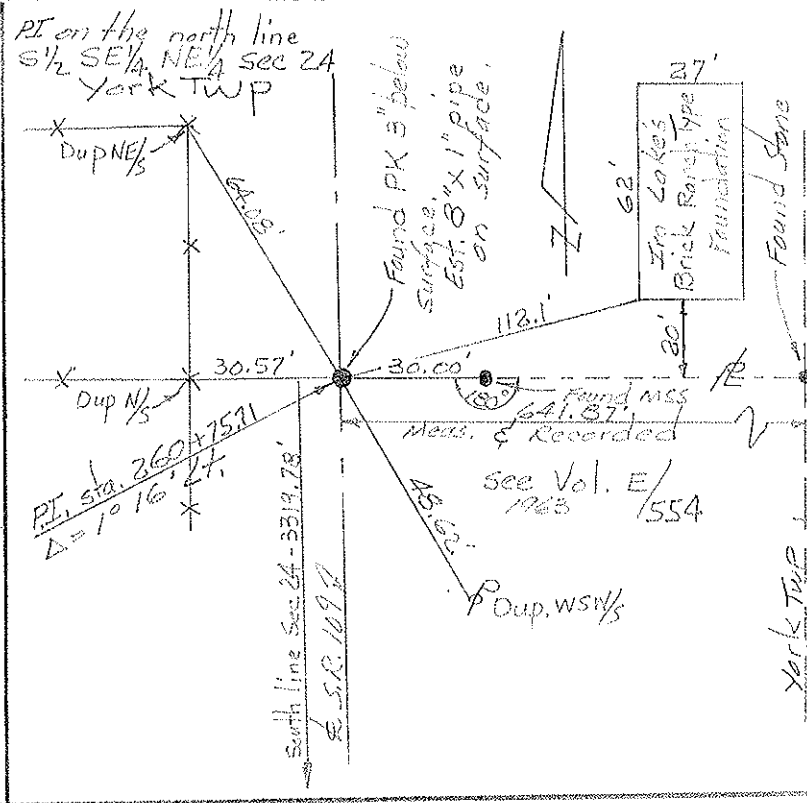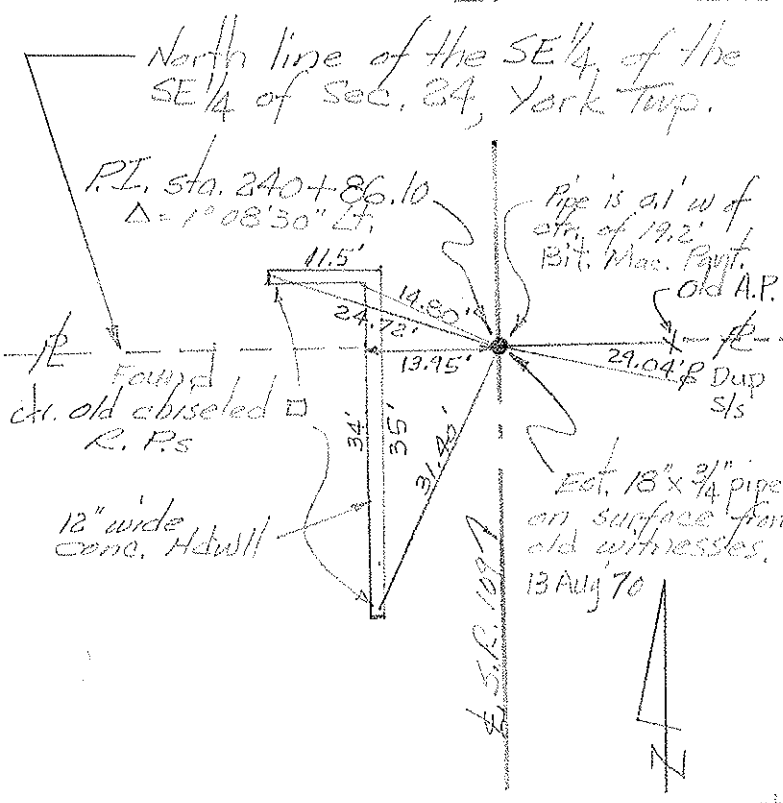

PERSONNEL TITLE PERSONNEL TITLE
 Red Beach
 Newcomb
 Knape
 Wise

COUNTY Fulton DATE Aug 1970
 S. R. 109 WEATHER
 SEC. 25 York Twp. TEMP.

DESCRIPTION ALIGNMENT & CONTROLS JOB NO.

