

O.D.O.T. DISTRICT 2 SURVEY OFFICE (USE ONLY)

PERSONNEL _____ REFERENCE NO. 14 SHEET 18 OF 31

NOTES RHOADES DATE 7-26-17 ROUTE SR 109
H.C. O'DONNELL WEATHER SUNNY COUNTY FULTON
R.C. CARSON TEMP. 67° TOWNSHIP YORK
SECTION 24
T 7 N R 7 E

TYPE MONUMENT SM.R.R.SPIKE


ON SURFACE - ~~BELOW~~ ON

LEFT - CL PAV'T - ~~RIGHT~~ 0.5'


10.0' TO LT EDGE PAVEMENT

S.L.M. 240+75.78

GRID: NORTHING: 689165.6598 EASTING: 1557573.8914

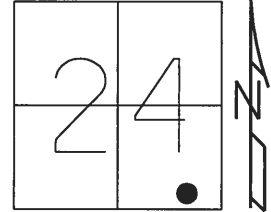

RECORD:
SET SM.R.R.SPIKE
8-23-01, MDB
FD SM.R.R.SPIKE
10-29-15
REF14
12-18-15, JFO
SET MAG/WASHER
12-1-17, JMR

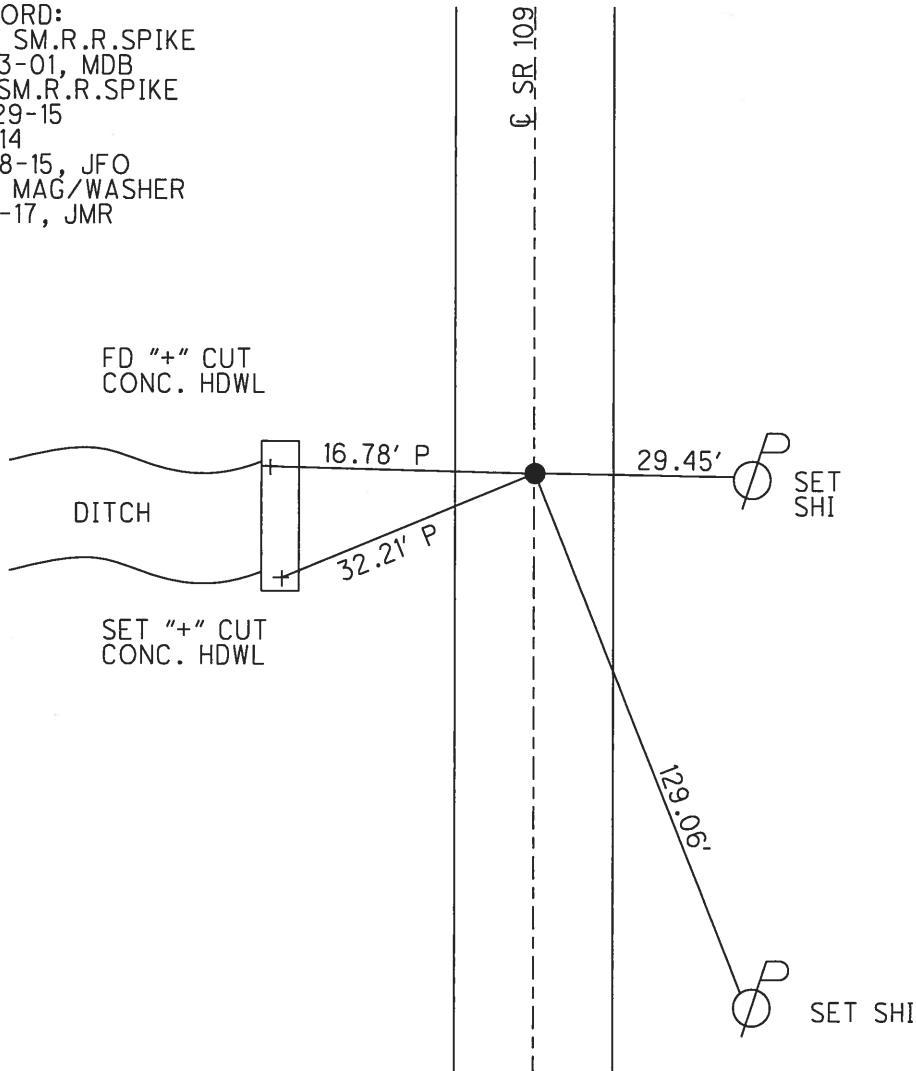

O.D.O.T. DISTRICT 2 SURVEY OFFICE

PERSONNEL _____

REFERENCE NO. 14

SHEET 6 OF 15

NOTES BARNHISEL RC

H.C. CORDES

DATE 7-6-01

ROUTE 109

R.C. _____

WEATHER SUNNY

COUNTY FULTON

TEMP. +75°

TOWNSHIP YORK

SECTION 24

T 7 N R 7 E


TYPE MONUMENT PK/WASHER

ON SURFACE - ~~BELOW~~ YES


LEFT - C PAV'T. - ~~RIGHT~~ 0.5'

10.0' TO LT EDGE PAVEMENT

S.L.M. 240+58

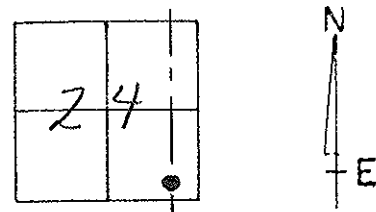

Reset Sm. RR. SPIRE
8-23-01
MDB

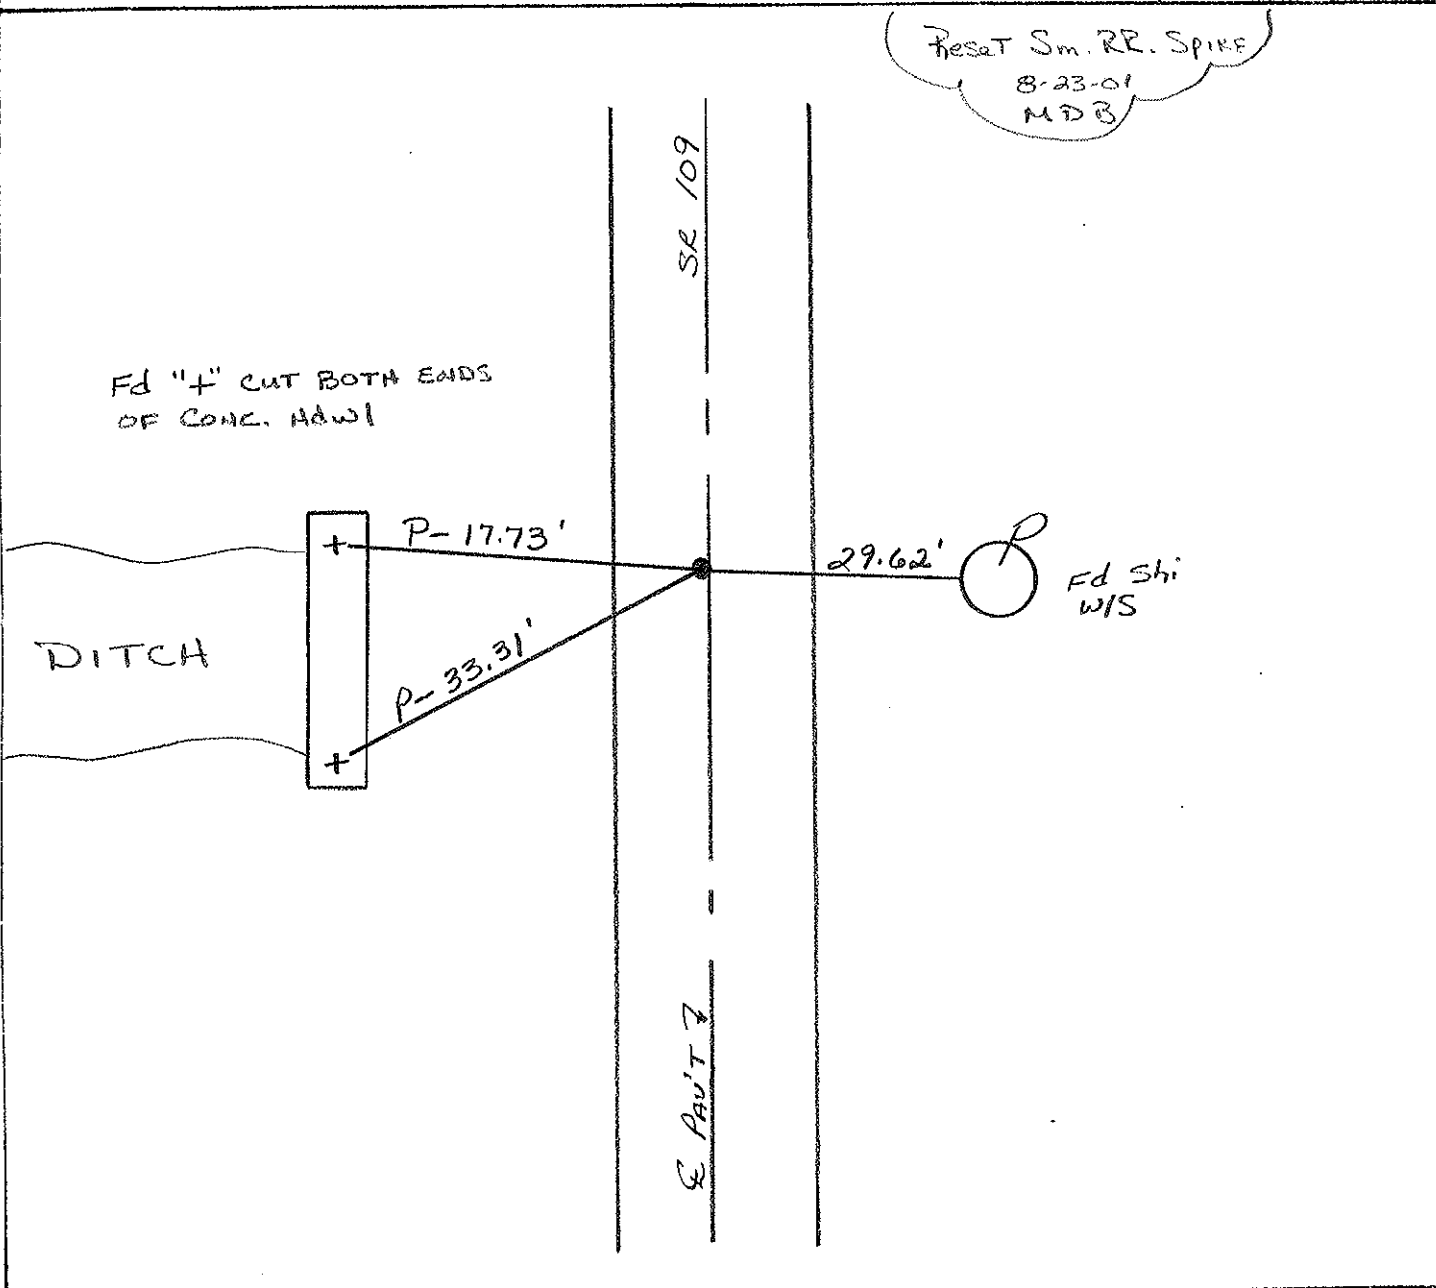

O.D.O.T. DISTRICT 2 SURVEY OFFICE

PERSONNEL

REFERENCE NO. 14

SHEET 16 OF 27

NOTES CORDS

H.C. CANTERBURY

DATE 8-10-94

ROUTE 109

R.C. SLOVAK

WEATHER SUNNY

COUNTY Fulton

HERMILLER F

TEMP. +65° F

TOWNSHIP York

SECTION 24

T 7 N R 7 E


TYPE MONUMENT 1" IRON PIPE (PIPE DAMAGED)

~~ON SURFACE~~ - BELOW 2 1/2"


~~LEFT - & PAV'T. - RIGHT~~ YES

10.2 TO LT EDGE PAVEMENT

S.L.M. 240+56

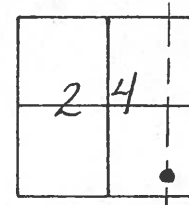

SET PK & WASHER
10-13-94
BUD

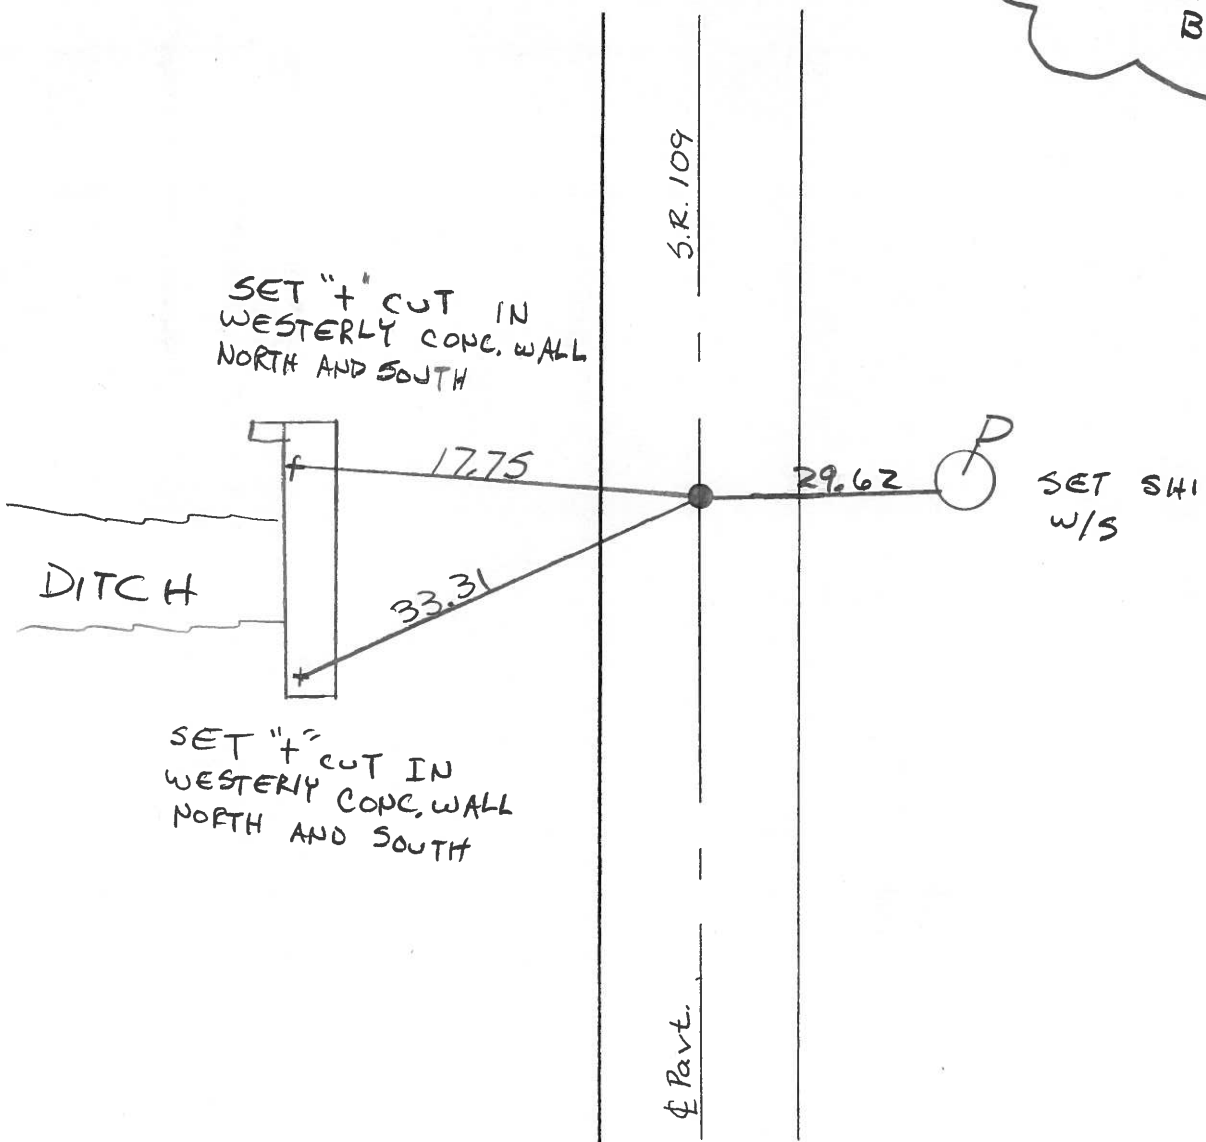

County Fulton S.R. 109

Date 24 May 82

Township York


Weather Fair

Section 24

Temp. 70°

T, N, R, E


Personnel I. Stone

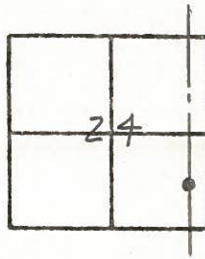

#14

P. Neuser
D. Curtis
R. Michalak


REF. NO. 14

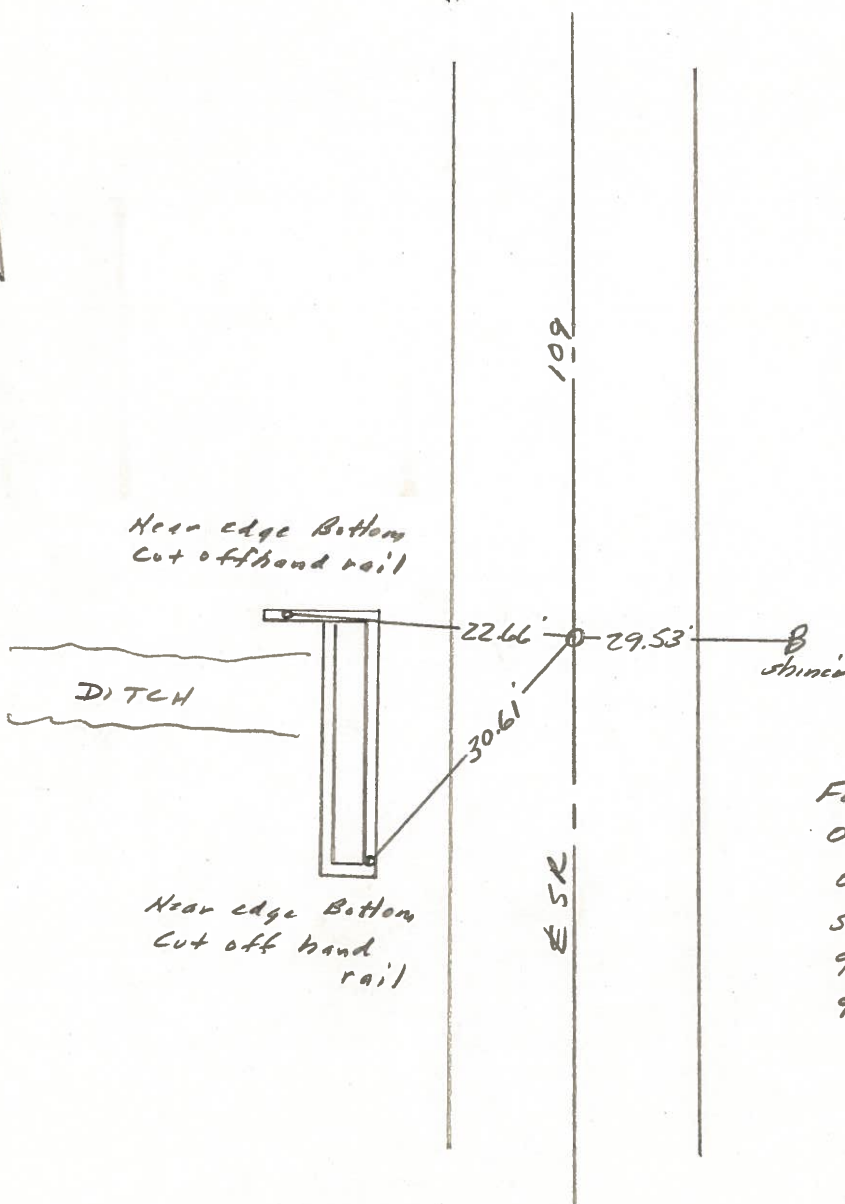

Fd. 1" I. Pipe To Surface
On N. Line SE 1/4 of SE 1/4
of Sec. 24
S.L.M. Sta. 2 + 55
9.6' To W. edge put,
9.5' To E. edge put.

PERSONNEL	TITLE	PERSONNEL	TITLE	COUNTY	DATE
Tomsic				Fulton	July 16, 1973
Nusser				S. R. 109	WEATHER
Granata				SEC. YORK Twp.	TEMP.
Vanyo					





DESCRIPTION	LEFT	CENTER LINE	RIGHT	JOB NO.
-------------	------	-------------	-------	---------

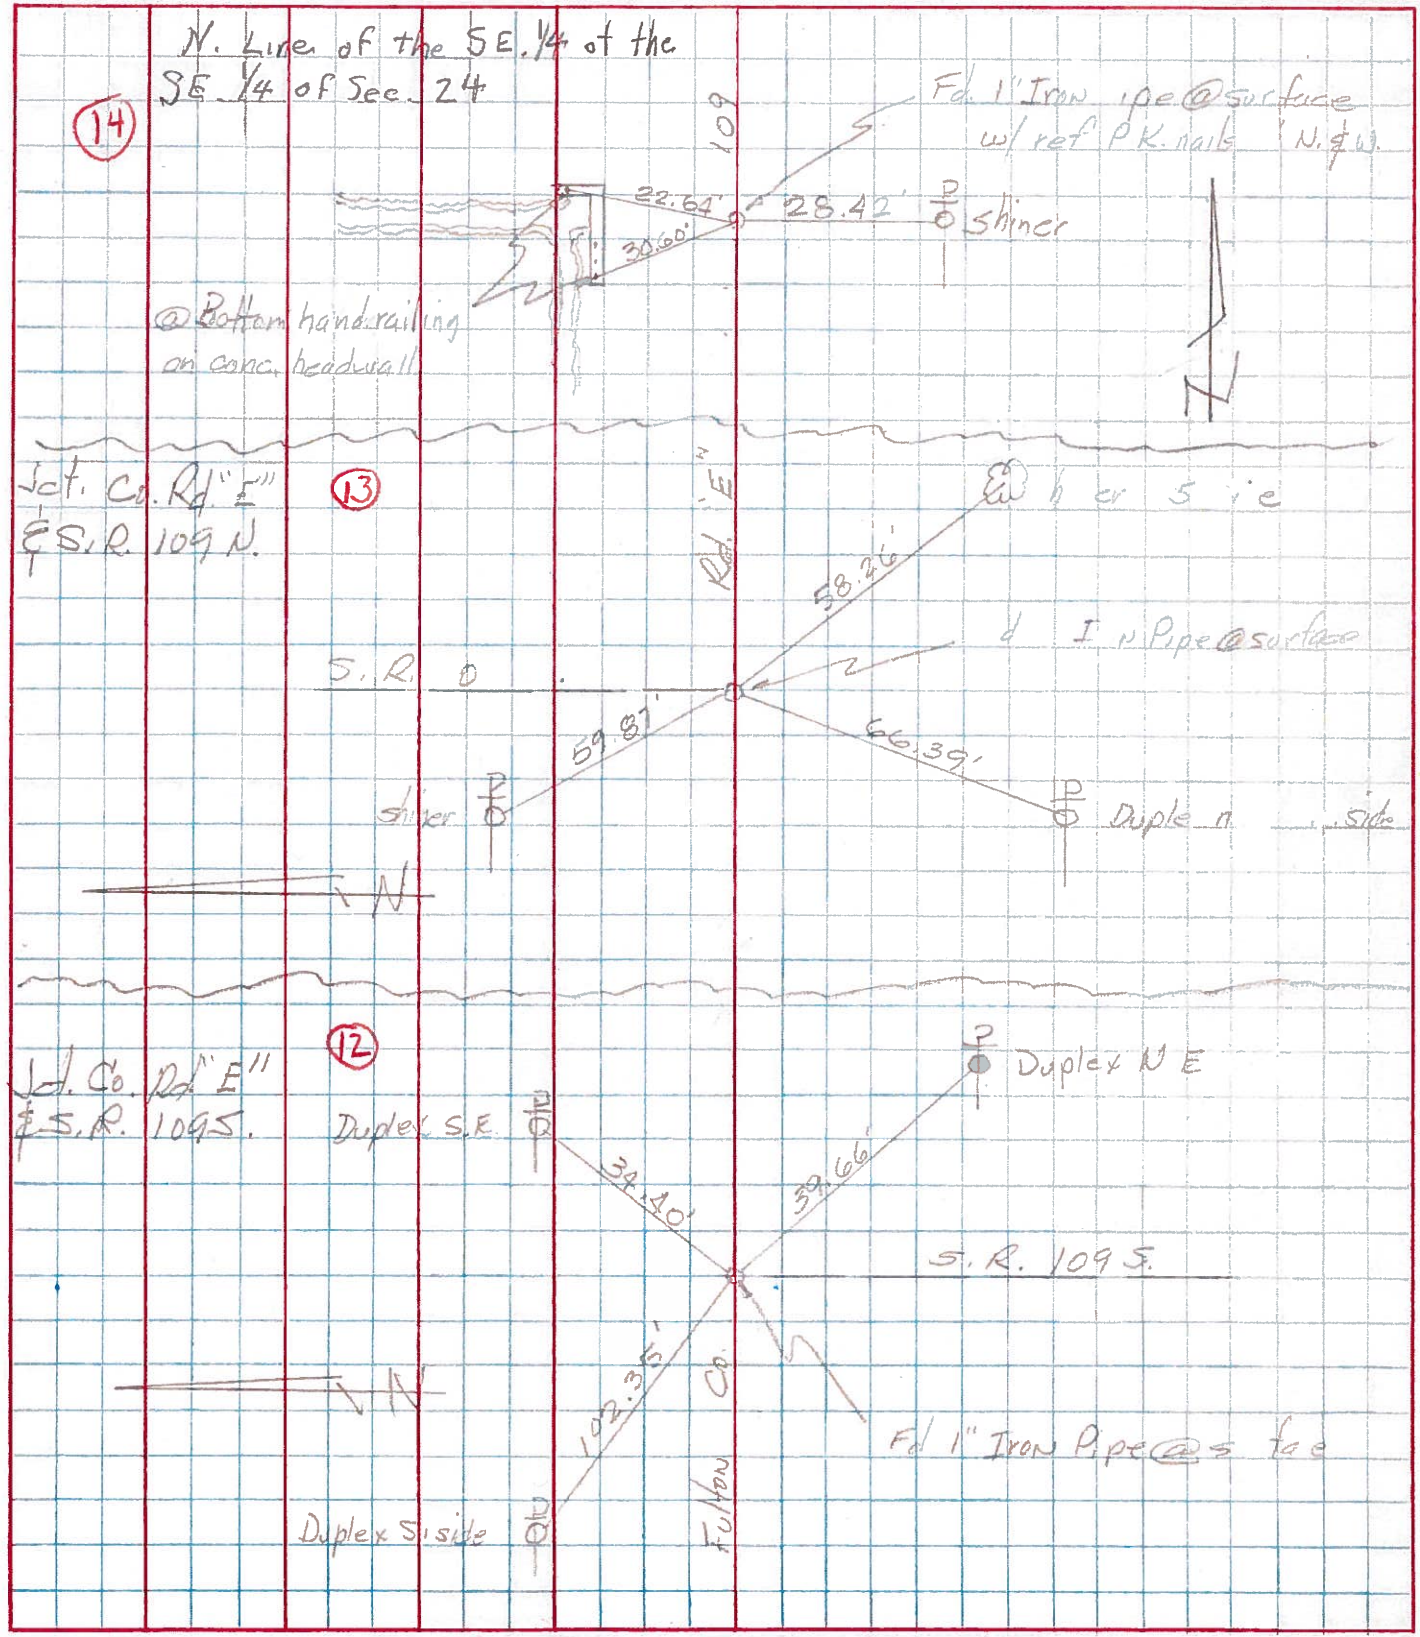


PERSONNEL TITLE PERSONNEL TITLE
 Red Beach, _____
 Newcomb _____
 Knappe _____
 Wise _____

COUNTY Fulton DATE Aug 1970
 S. R. 109 WEATHER _____
 SEC. YORK TWP. TEMP. _____

DESCRIPTION CONTROL POINTS JOB NO. _____

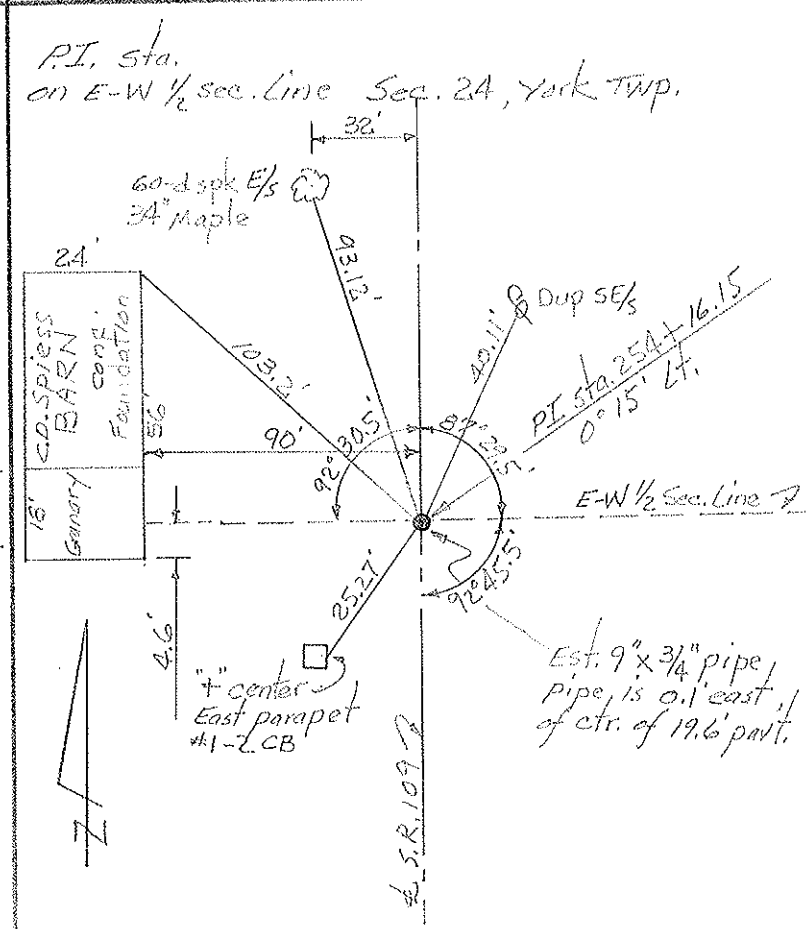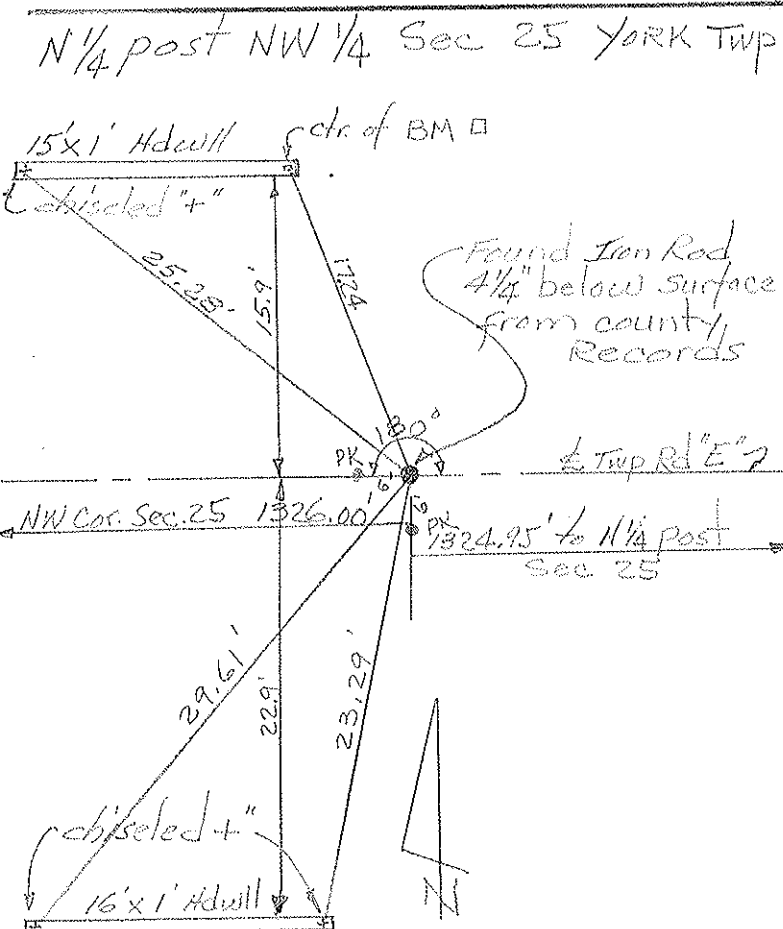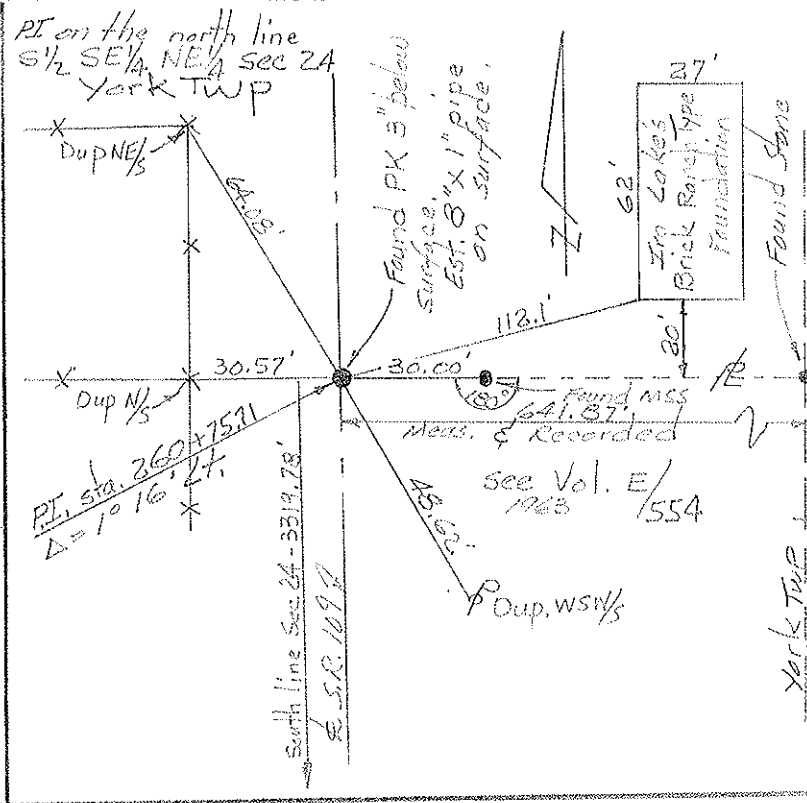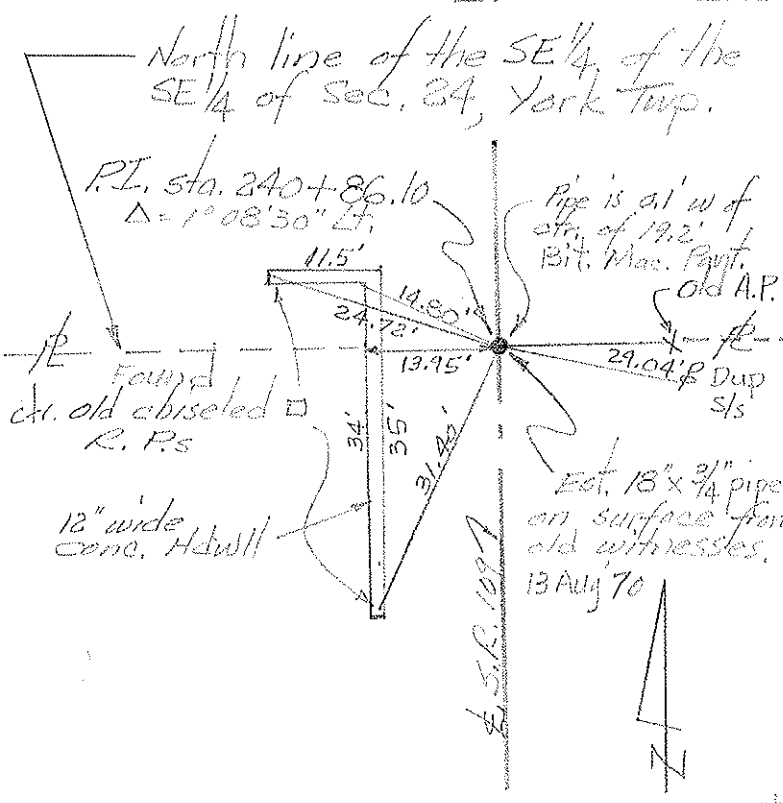

PERSONNEL	TITLE	PERSONNEL	TITLE	COUNTY	DATE
Red Beach				Fulton	Sept. 1970
Newcomb					
Krape				S. R. 109	WEATHER
Wise				SEC. SE 1/4, Sec. 24	TEMP.
DESCRIPTION	ALIGNMENT & CONTROLS			YORK TWP	JOB NO.
	LEFT	CENTER LINE	RIGHT		

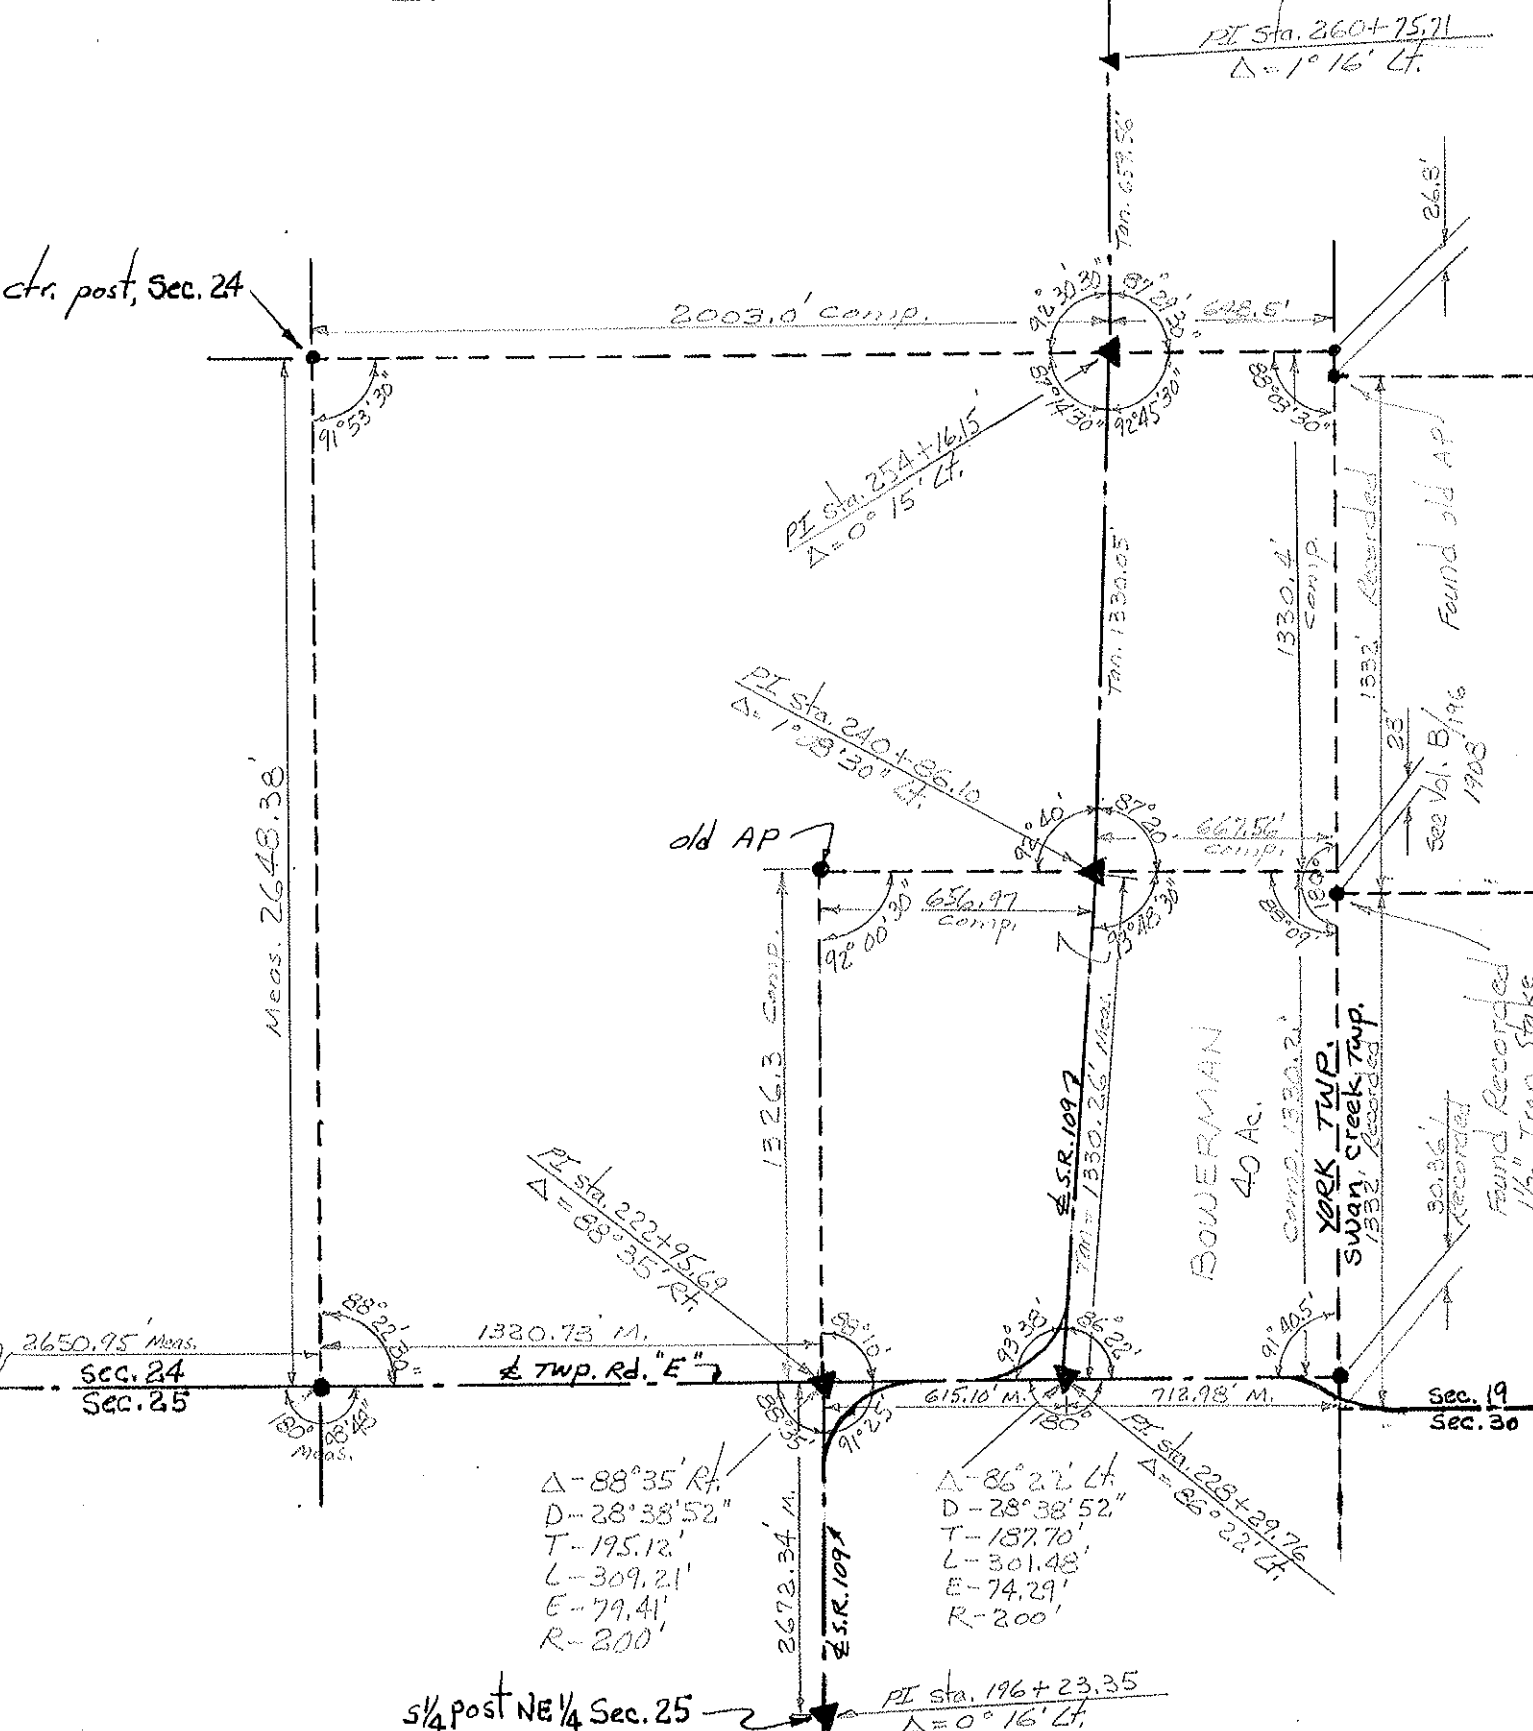

$\Delta = 88^\circ 35' \text{ Rt.}$
 $D = 28^\circ 33' 52''$
 $T = 195.12'$
 $L = 309.21'$
 $E = 79.41'$
 $R = 200'$

$\Delta = 86^\circ 22' \text{ Lt.}$
 $D = 28^\circ 38' 52''$
 $T = 187.70'$
 $L = 301.48'$
 $E = 74.29'$
 $R = 200'$

1/4 post NE 1/4 Sec. 25

PI sta. 196+23.35
Δ = 0° 16' Lt.