
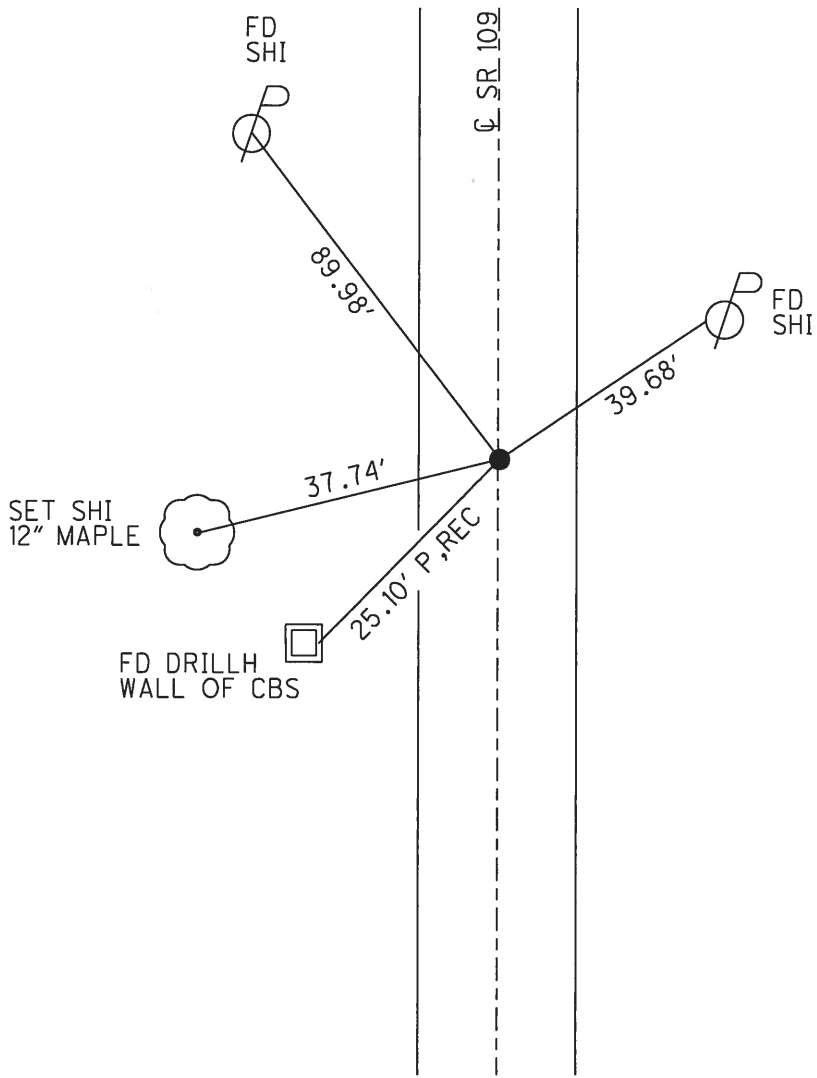


O.D.O.T. DISTRICT 2 SURVEY OFFICE (USE ONLY)

PERSONNEL _____ REFERENCE NO. 15 SHEET 19 OF 31
 NOTES RHOADES DATE 7-26-17 ROUTE SR 109
 H.C. O'DONNELL WEATHER SUNNY COUNTY FULTON
 R.C. CARSON TEMP. 67° TOWNSHIP YORK
 _____ SECTION 24
 _____ T 7 N R 7 E

TYPE MONUMENT SM.R.R.SPIKE
 ON SURFACE - ~~BELOW~~ ON _____
~~LEFT~~ - CL PAV'T - RIGHT 0.5'
9.5' TO RT EDGE PAVEMENT
 S.L.M. 254+05.64
 GRID: NORTHING: 690494.7482 EASTING: 1557619.1490

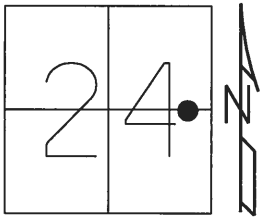

RECORD:
 SET SM..RR.SPIKE
 8-23-01, MDB
 FD SM.R.R.SPIKE
 10-29-15
 REF14
 12-18-15, JFO
 SET MAG/WASHER
 12-1-17, JMR

O.D.O.T. DISTRICT 2 SURVEY OFFICE

PERSONNEL _____

REFERENCE NO. 15

SHEET 7 OF 15

NOTES BARNHISEL RC

H.C. CORDES

R.C. _____

DATE 7-6-01

WEATHER SUNNY

TEMP. +75°

ROUTE 109

COUNTY FULTON

TOWNSHIP YORK

SECTION 24

T 7 N R 7 E


TYPE MONUMENT PK/WASHER

ON SURFACE - ~~BELOW~~ yes


~~LEFT~~ - 0 PAV'T. - RIGHT 0.5'

9.5' TO RT EDGE PAVEMENT

S.L.M. 253+88

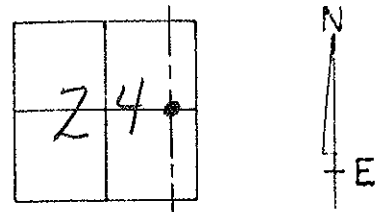

Reset Sm RR. SPIKE
8-23-01
MDB

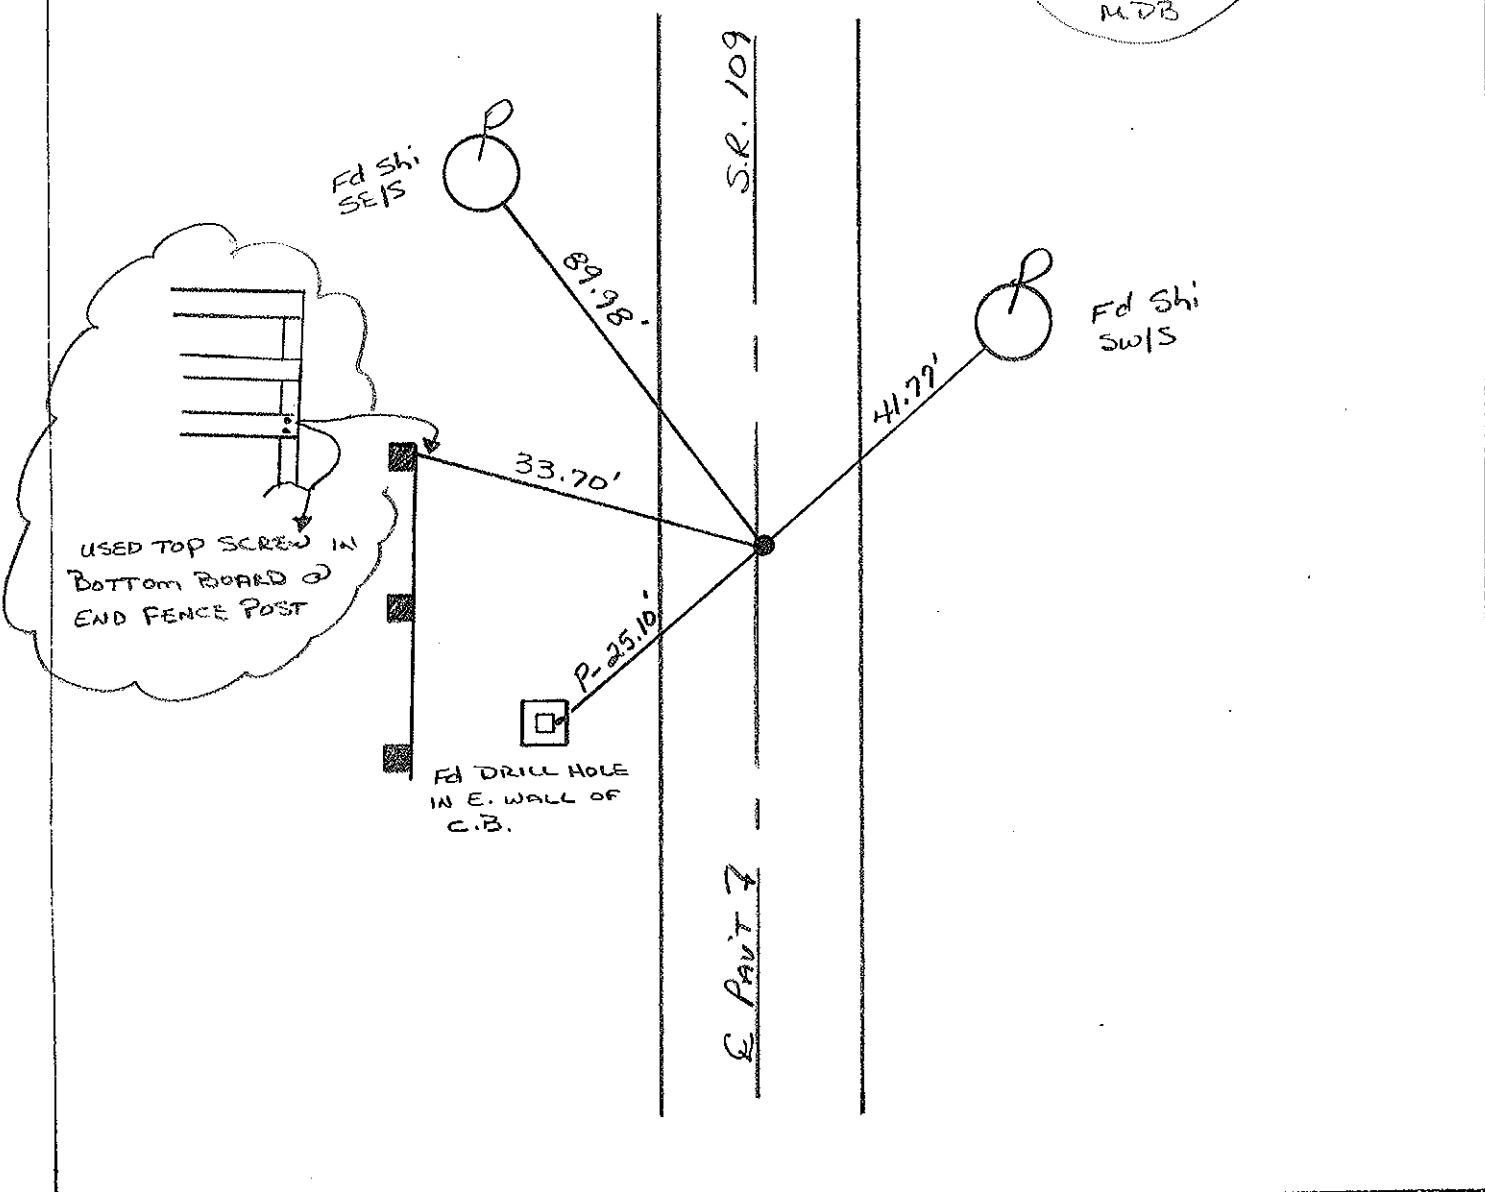

O.D.O.T. DISTRICT 2 SURVEY OFFICE

PERSONNEL

REFERENCE NO. 15

SHEET 17 OF 27

NOTES CORDES

H.C. CANTERBURY

DATE 8-10-94

ROUTE 109

R.G. HERMILLER

WEATHER SUNNY

COUNTY Fulton

SIOUAK P

TEMP. +75° F

TOWNSHIP York

SECTION 24

T 7 N R 7 E


TYPE MONUMENT 1" IRON PIPE

~~ON SURFACE~~ - BELOW 1 1/2


LEFT- & PAV'T. - RIGHT 0.6

9.8 TORT EDGE PAVEMENT

S.L.M. 253+88

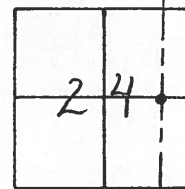

SET PK & WASHER
 10-13-94
 BVD

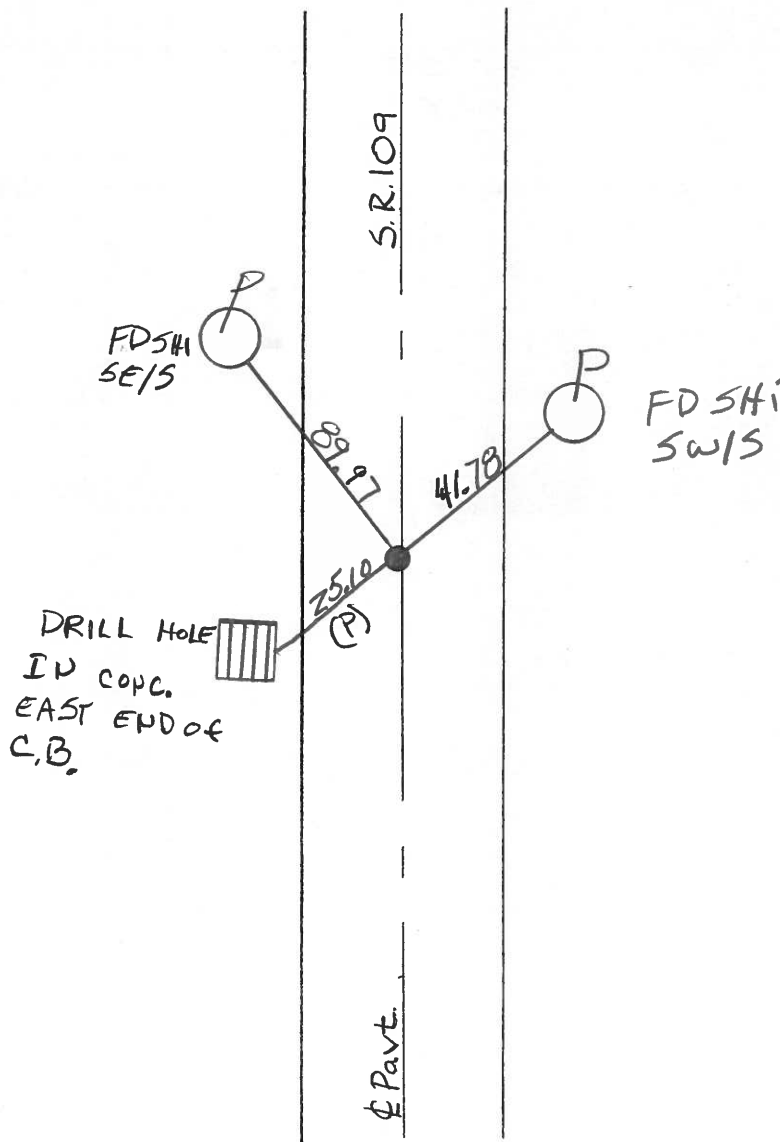

County Fulton S.R. 109

Date 24 May 82

Township York

Weather Fair

Section 24

Temp. 70°

T, N, R, E


Personnel I. Stone

#15


P. Newser

R. Michalak

D. Curtis

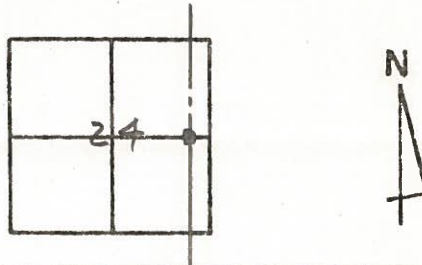

REF. NO. 15

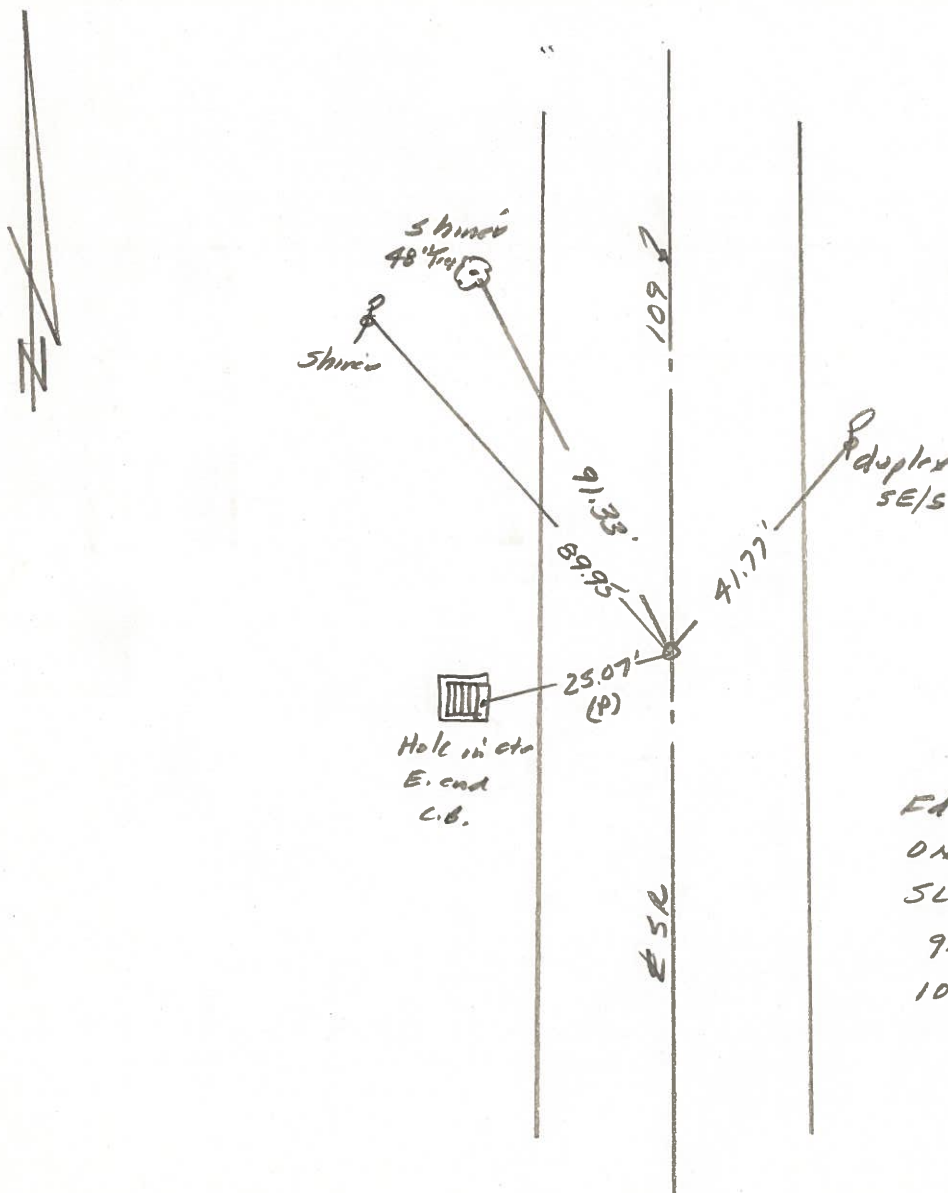


Ed. 1" I.P. pipe To Surface
 ON E-W & SEC. 24.
 SLM. STA. = 253+85
 9.3' To E. edge put.
 10.0' To W. edge put.

PERSONNEL	TITLE	PERSONNEL	TITLE
Tomsic		Boyle	
Neuser			
Granata			
Vanyo			

COUNTY Fulton DATE July 16, 1973
 S. R. 109 WEATHER _____
 SEC. _____ TEMP. _____





DESCRIPTION _____ LEFT _____ CENTER LINE _____ RIGHT _____ JOB NO. _____

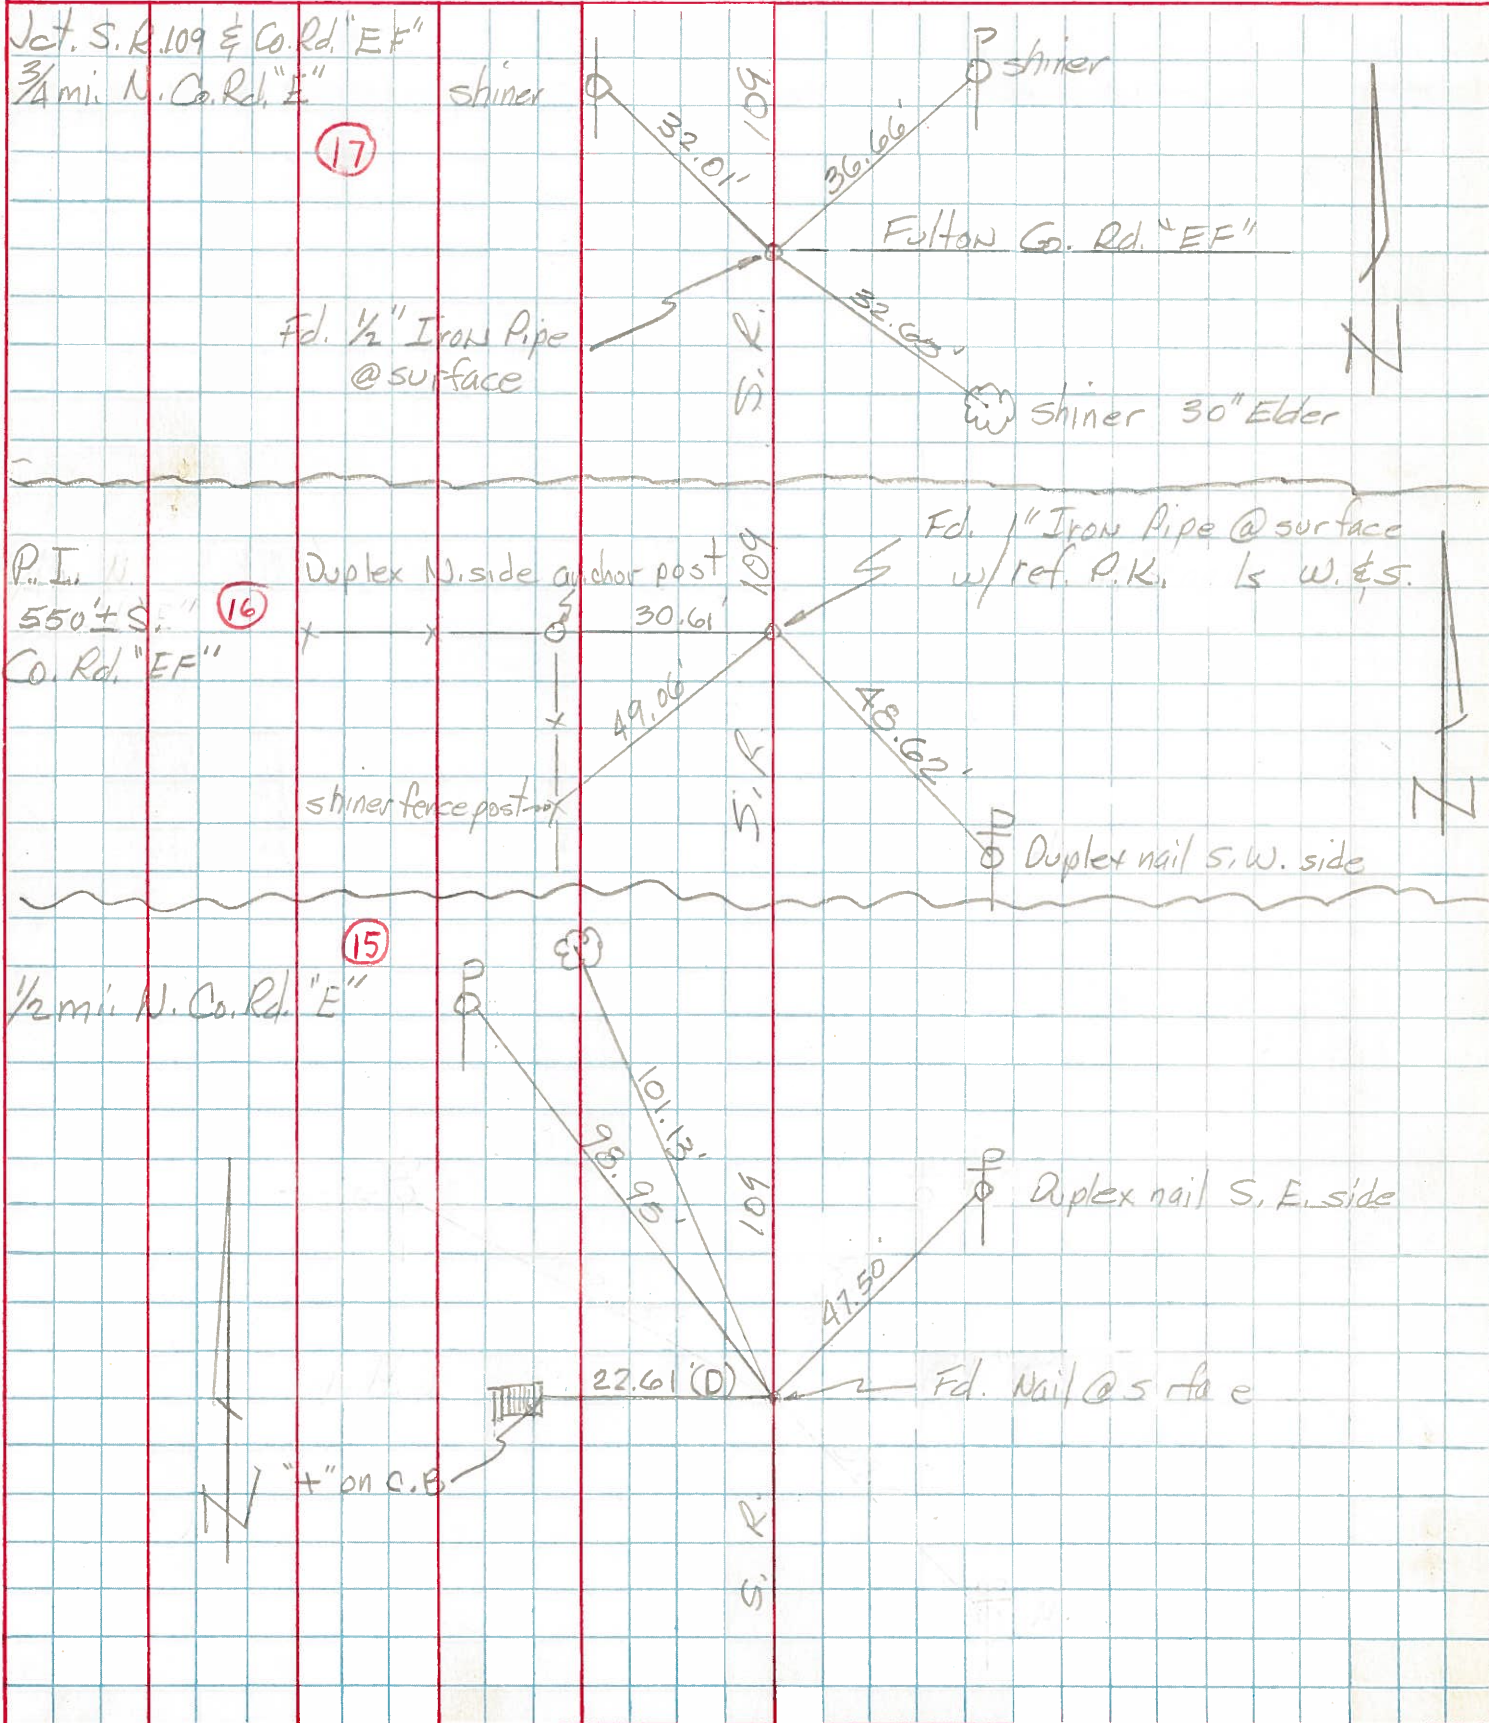


PERSONNEL TITLE PERSONNEL TITLE
 Red Beach
 Newcomb
 Knappe
 Wise

COUNTY Fulton DATE Aug 1970
 S. R. 109 WEATHER
 SEC. YORK TWP. TEMP.

DESCRIPTION CONTROL POINTS JOB NO.

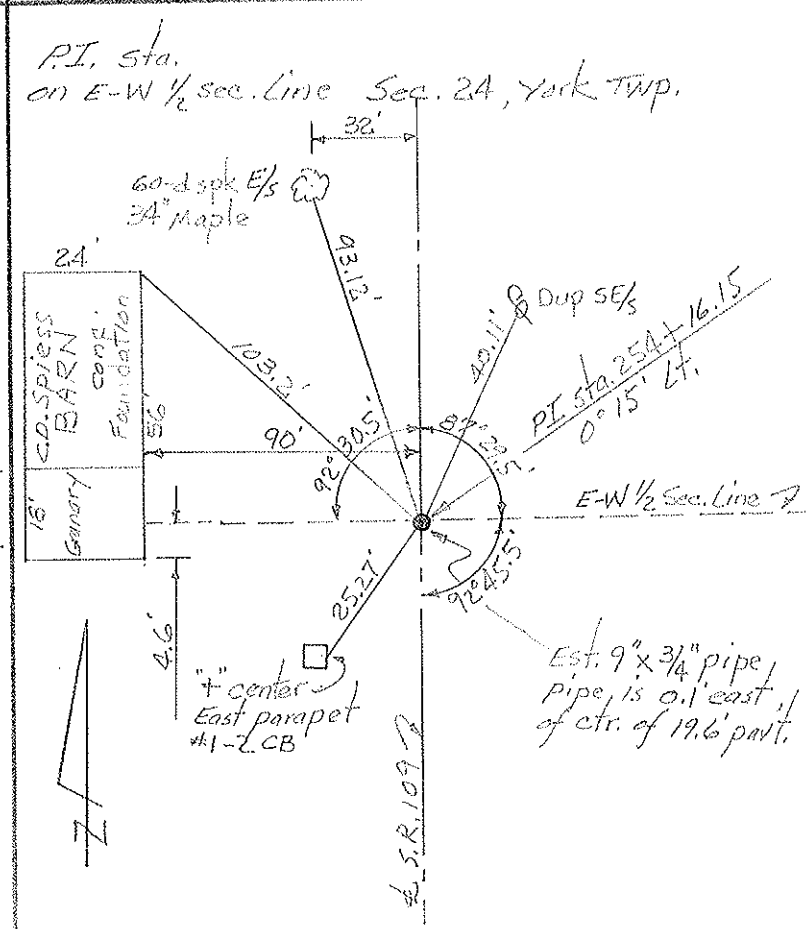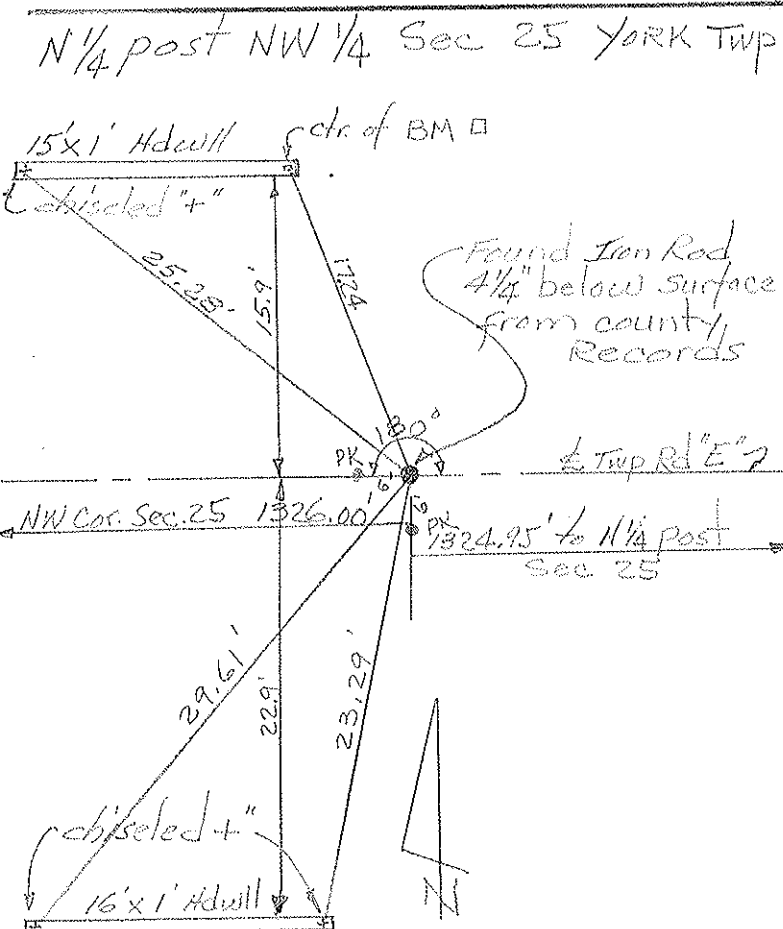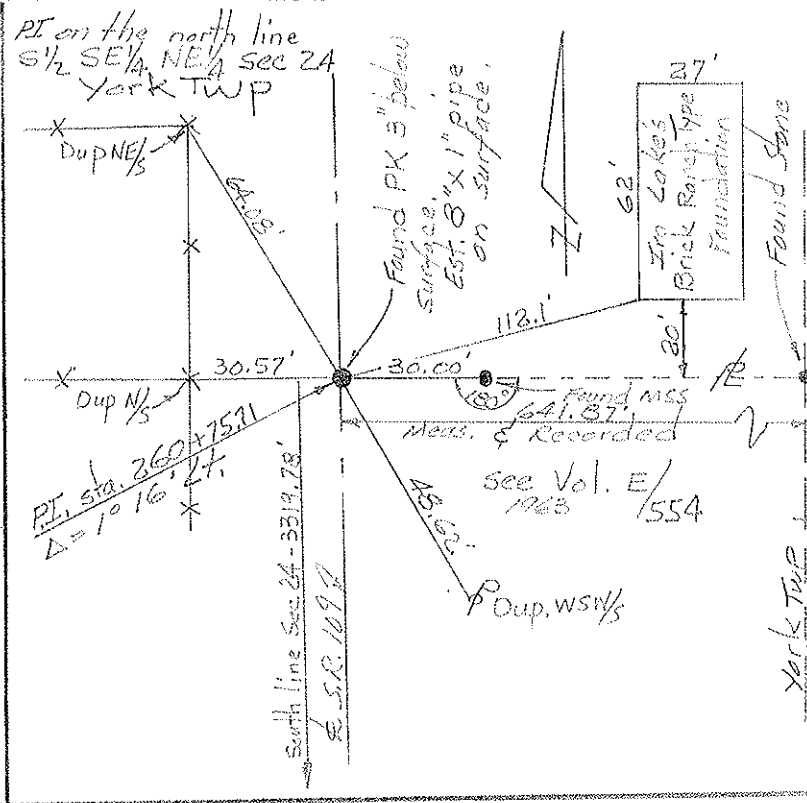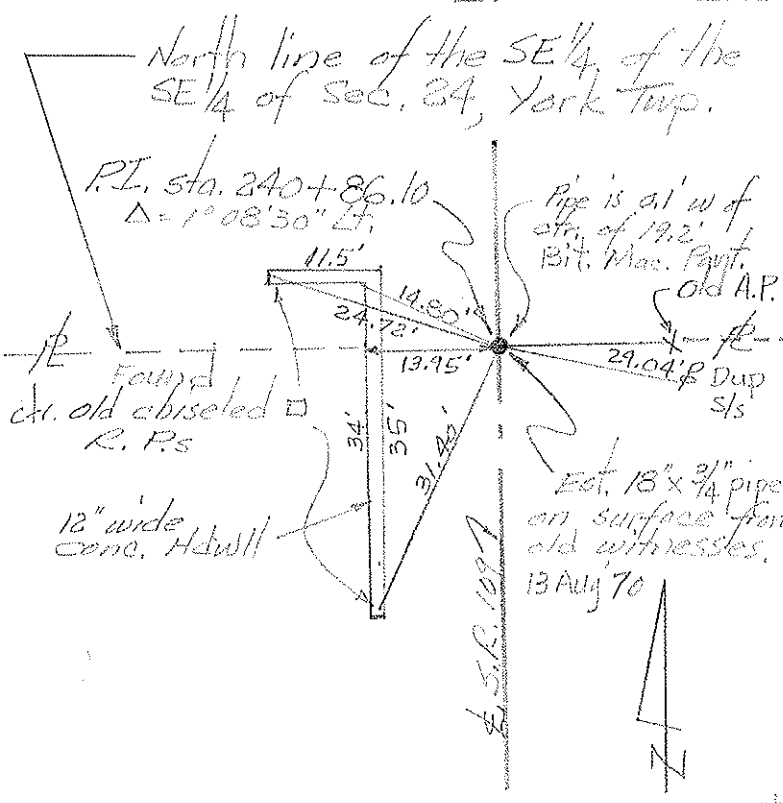

PERSONNEL	TITLE	PERSONNEL	TITLE	COUNTY	DATE
Red Beach				Fulton	Sept. 1970
Newcomb					
Krape				S. R. 109	WEATHER
Wise				SEC. SE 1/4, Sec. 24	TEMP.
DESCRIPTION	ALIGNMENT & CONTROLS			YORK TWP	JOB NO.
	LEFT	CENTER LINE	RIGHT		

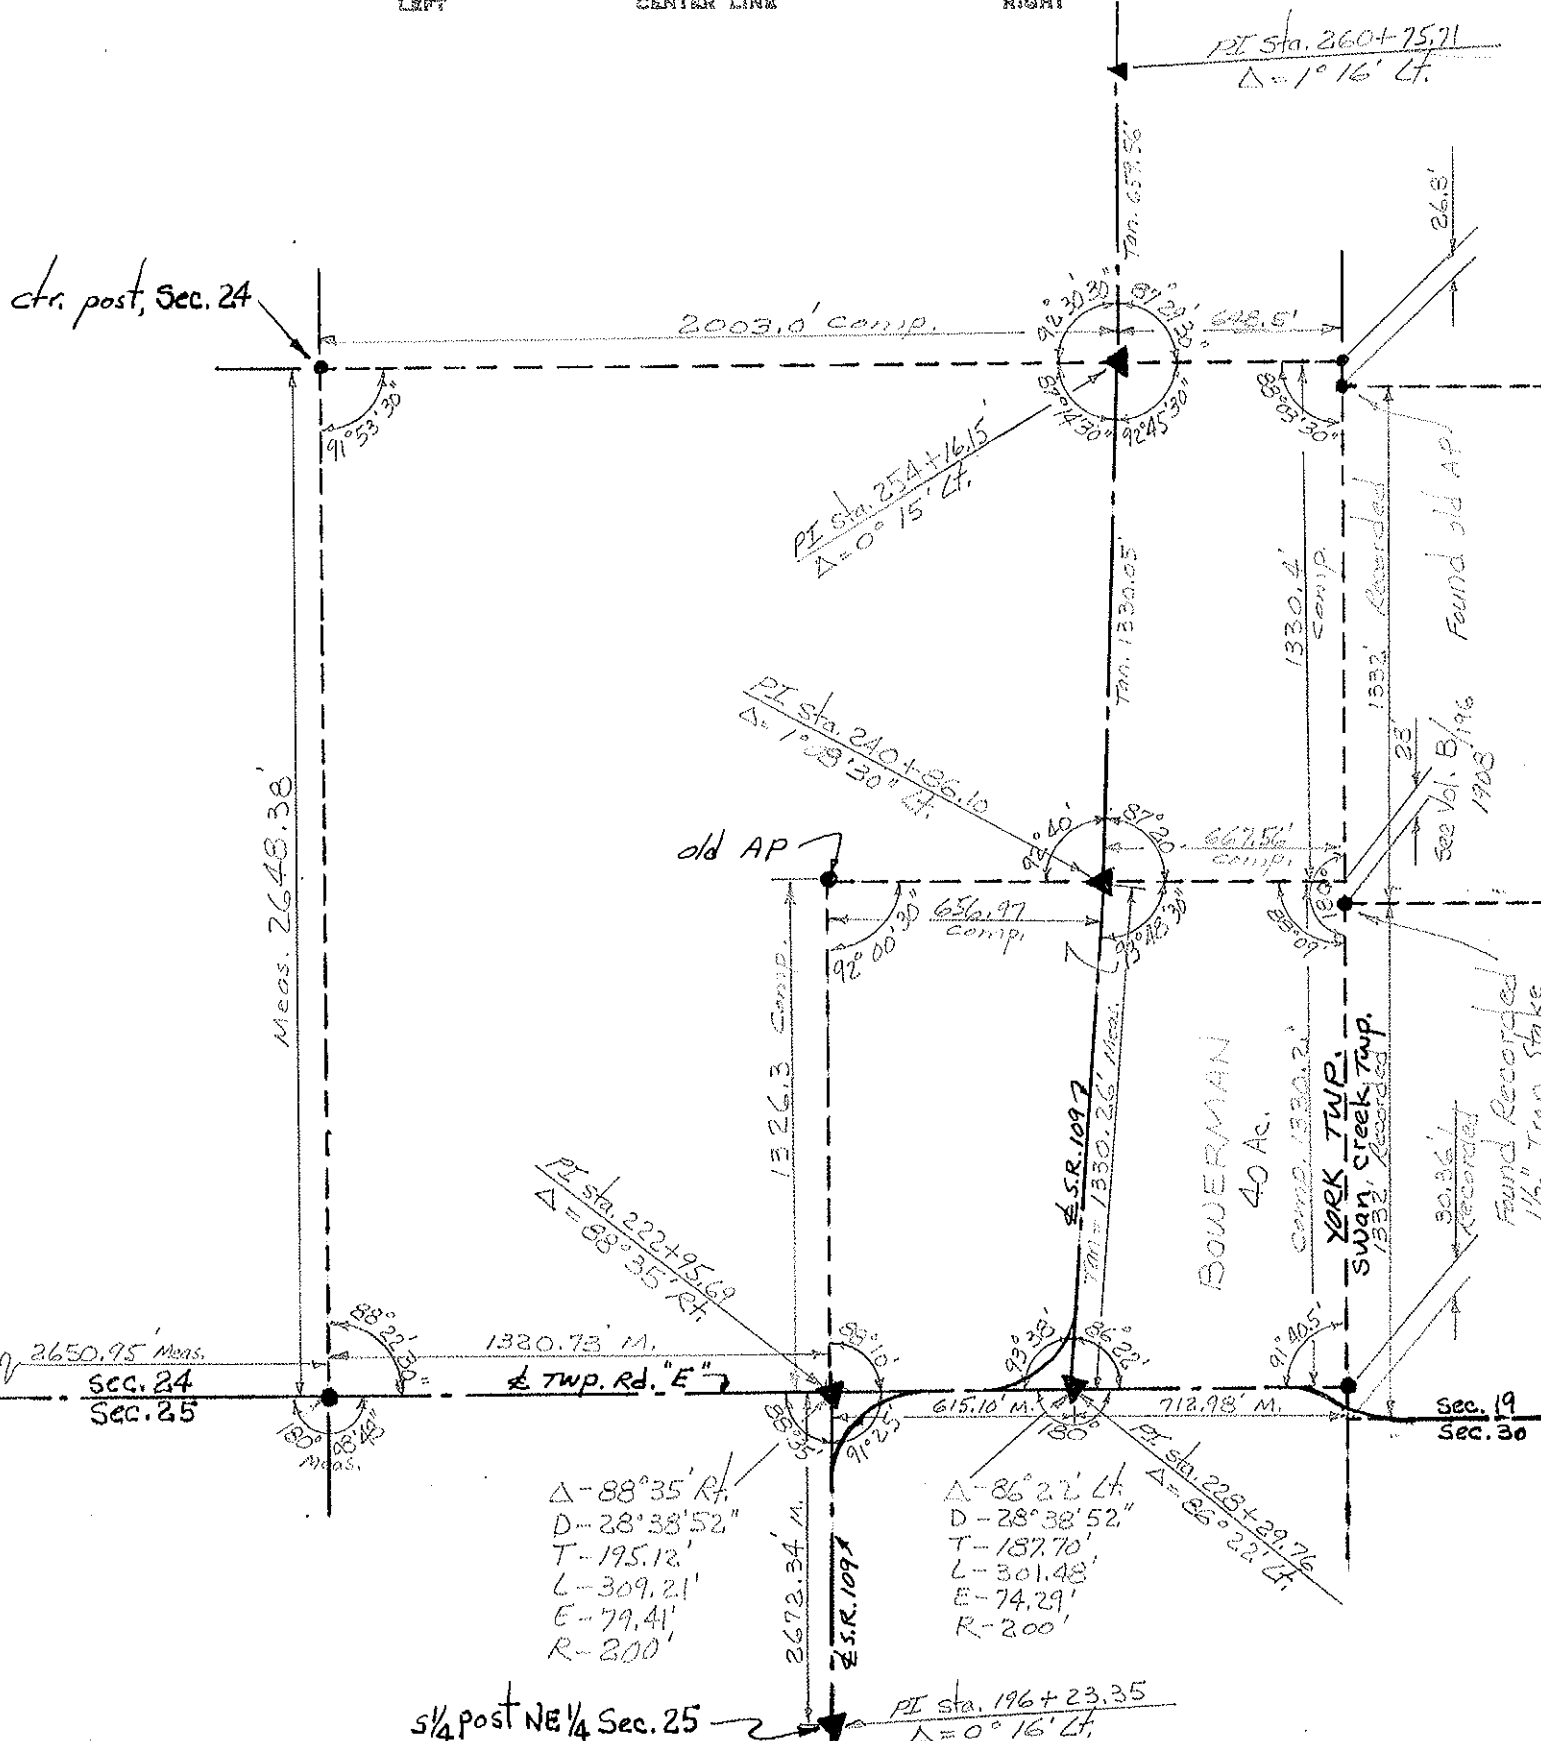

$\Delta - 88^{\circ} 35' \text{ Rt.}$
 $D - 28^{\circ} 38' 52''$
 $T - 195.12'$
 $L - 309.21'$
 $E - 79.41'$
 $R - 200'$

$\Delta - 86^{\circ} 22' \text{ Lt.}$
 $D - 28^{\circ} 38' 52''$
 $T - 187.70'$
 $L - 301.48'$
 $E - 74.29'$
 $R - 200'$

1/4 post NE 1/4 Sec. 25 \rightarrow PI Sta. 196+23.35
 $\Delta = 0^{\circ} 16' \text{ Lt.}$