
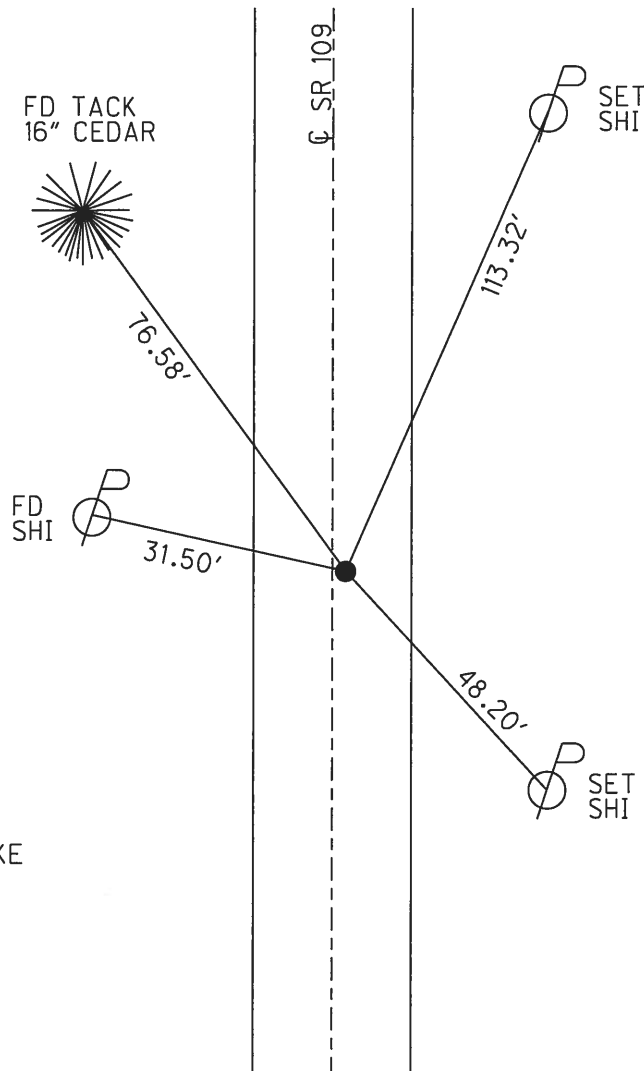


O.D.O.T. DISTRICT 2 SURVEY OFFICE (USE ONLY)

PERSONNEL	REFERENCE NO.	<u>16</u>	SHEET	<u>20</u>	OF	<u>31</u>
NOTES	<u>RHOADES</u>	DATE	<u>7-26-17</u>	ROUTE	<u>SR 109</u>	
H.C.	<u>O'DONNELL</u>	WEATHER	<u>SUNNY</u>	COUNTY	<u>FULTON</u>	
R.C.	<u>CARSON</u>	TEMP.	<u>67°</u>	TOWNSHIP	<u>YORK</u>	
				SECTION	<u>24</u>	
				T	<u>7</u>	R
				E	<u>7</u>	E

TYPE MONUMENT SM.R.R.SPIKE
 ON SURFACE - ~~BELOW~~ ON _____
~~LEFT~~ - CL PAV'T - RIGHT 1.5'
8.7' TO RT EDGE PAVEMENT
 S.L.M. 260+65.12

GRID: NORTHING: 691153.9397 EASTING: 1557638.6442

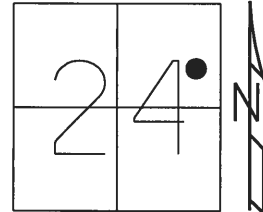

RECORD:
 FD 1" IPIPE
 FOUND P.I.
 5-24-82, STONE
 RESET SM.R.R.SPIKE
 8-23-01, MDB
 FD SM.R.R.SPIKE
 10-29-15, JFO
 REF16
 12-18-15, JFO
 SET MAG/WASHER
 12-1-17, JMR

O.D.O.T. DISTRICT 2 SURVEY OFFICE

PERSONNEL _____

REFERENCE NO. 16

SHEET 8 OF 15

NOTES BARNHISEL RC

H.C. CORDES

R.C. _____

DATE 7-6-01

WEATHER SUNNY

TEMP. +75°

ROUTE 109

COUNTY FULTON

TOWNSHIP YORK

SECTION 24

T 7 N 7 E


TYPE MONUMENT PK/WASHER

ON SURFACE - ~~BELOW~~ YES

~~LEFT~~ - C PAV'T. - RIGHT 1.5'


8.7' TO RT EDGE PAVEMENT

S.L.M. 260+49

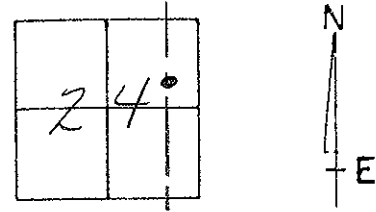

Record: I. Pipe
Found P.I.
5-24-82
STONE

Reset Sm RR. SPIKE
8-23-01
MDB

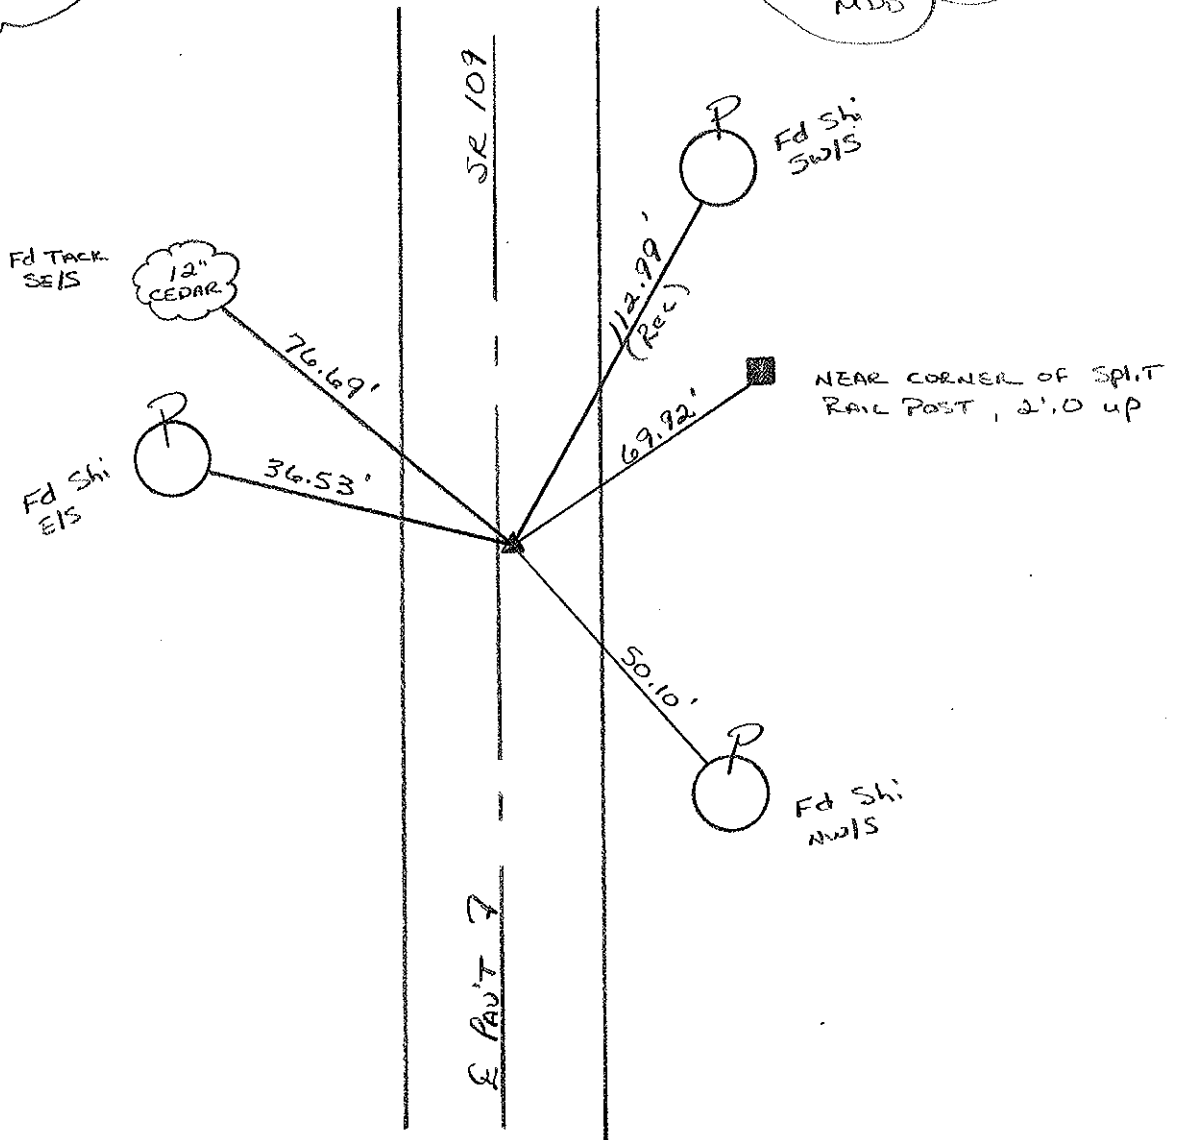

O.D.O.T. DISTRICT 2 SURVEY OFFICE

PERSONNEL

REFERENCE NO. 16

SHEET 18 OF 27

NOTES CORDES

H.C. CANTERBURY

DATE 8-10-94

ROUTE 109

R.C. HERMILLER

WEATHER SUNNY

COUNTY Fulton

SIOUAK P

TEMP. +75° F

TOWNSHIP York

SECTION 24

T 7 N R 7 E


TYPE MONUMENT 1" IRON PIPE

ON SURFACE - BELOW 2"

~~LEFT~~ - PAV'T. - RIGHT 1.1

9.6 TO RT EDGE PAVEMENT

S.L.M. 260+49

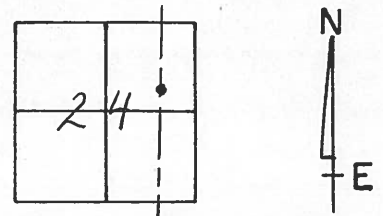

IRON PIPE IS
A P.I. RECORD
5-24-82 STONE

SET PK &
WASHER
10-13-94
BVD

SET TACK
IN WHITE
CEDAR



76.79

SET
SHI
W/S



36.54

S.R. 109

112.99
(REC)



SW CORNER POST
SPLIT RAIL FENCE
AT BASE

FD SHI
SW/S



50.13

¢ Pavt.

County Fulton S.R. 109

Township York

Section 24

T N, R E

Personnel I. Stone

P. Neuser

R. Micholde


J.

#16


Date 24 May 82

Weather Fair

Temp. 70°

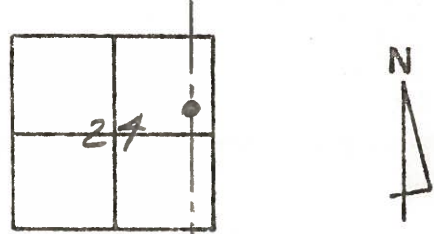

REF. NO. 16

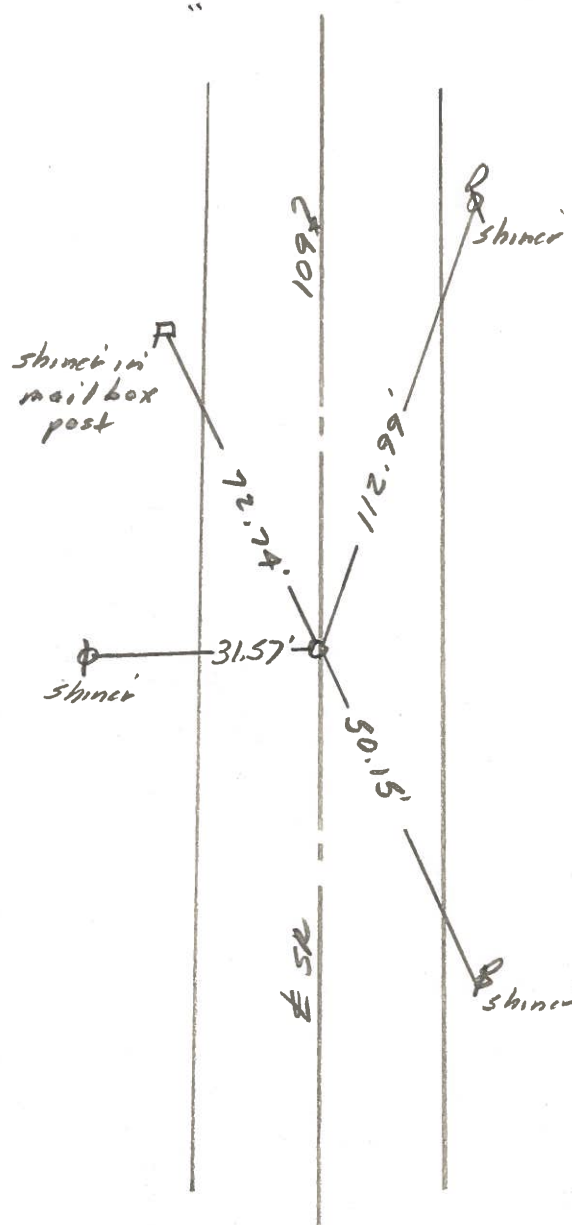


Fd. 1" 1. Pipe To Surface
 P.I. in put.
 8.6' To E. edge put.
 10.2' To W. edge put.
 SLM Sta. 260+44

PERSONNEL	TITLE	PERSONNEL	TITLE
Tomsic		Boyle	
Neuse, J.			
Granata			
Vanya			

COUNTY	Fulton	DATE	July 16, 1973
S. R.	109	WEATHER	
SEC.		TEMP.	

DESCRIPTION _____ LEFT _____ CENTER LINE _____ RIGHT _____ JOB NO. _____

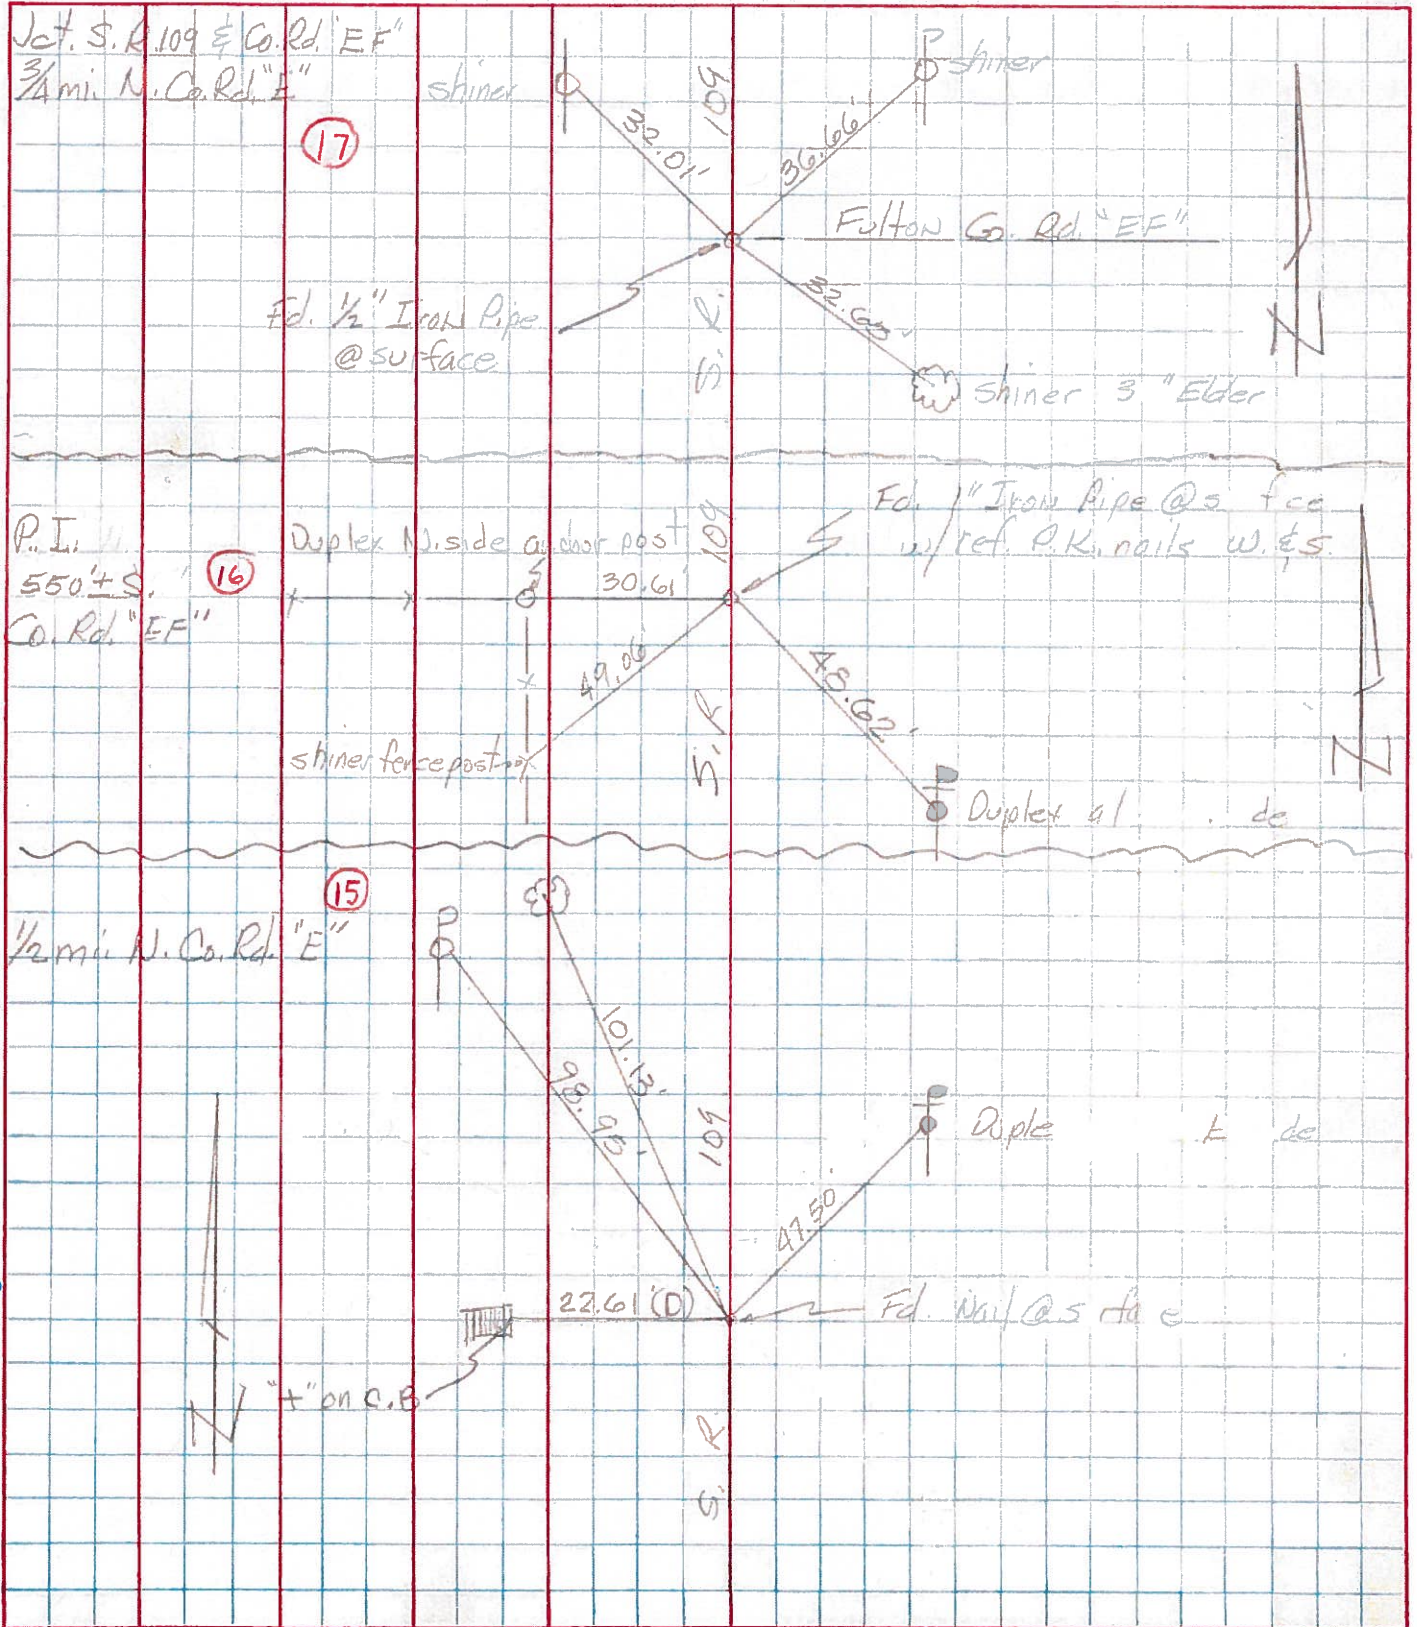

PERSONNEL TITLE PERSONNEL TITLE
 Red Beach
 Newcomb
 Knappe
 Wise

COUNTY Fulton DATE Aug 1970
 S. R. 109 WEATHER
 SEC. YORK TWP. TEMP.

DESCRIPTION CONTROL POINTS JOB NO.

