


O.D.O.T. DISTRICT 2 SURVEY OFFICE (USE ONLY)


PERSONNEL _____ REFERENCE NO. 17 SHEET 21 OF 31
 NOTES RHOADES DATE 4-20-18 ROUTE SR 109
 H.C. O'DONNELL WEATHER SUNNY COUNTY FULTON
 R.C. SEAMAN TEMP. 39° TOWNSHIP YORK
 _____ SECTION 24
 _____ T 7 N R 7 E

TYPE MONUMENT MONBOX W/1" I PIN
 ON SURFACE - ~~BELOW~~ ON
 LEFT - Q PAV'T - RIGHT ON
9.8' TO LT EDGE PAVEMENT
 S.L.M. 266+24.87

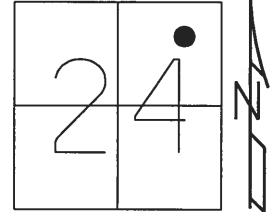

GRID: NORTHING: 691713.658 EASTING: 1557642.7357

RECORD:
 FD 1/2" IPIN
 8-10-94, BC
 SET P.K./WASHER
 10-13-94, BC
 SET SM.R.R.SPIKE
 8-23-01, MDB
 FD SM.R.R.SPIKE
 10-29-15, JFO
 FD MONBOX
 NEWREF17
 12-15-17, JFO
 ERROR OF SET IPIN
 TO SW OF STRATS
 12-19-17, JFO
 BUMPED PIN N.E.
 NEWREF17
 4-4-18, JFO

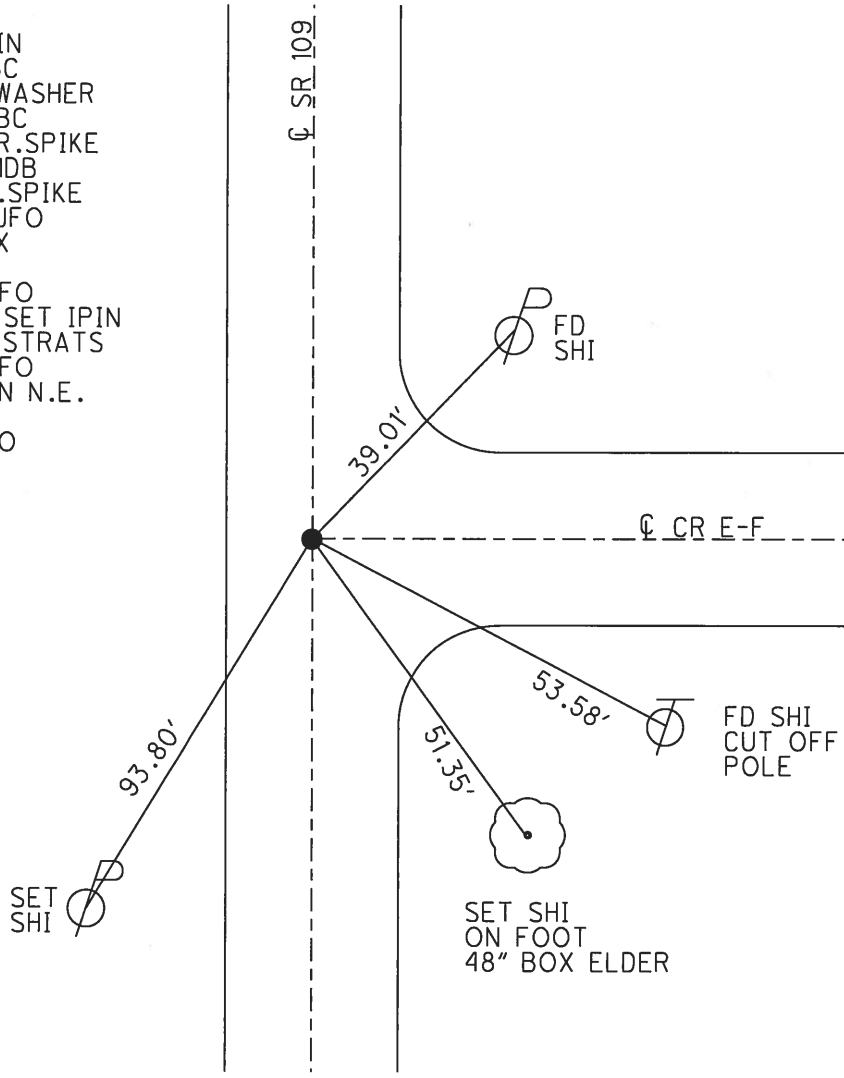

O.D.O.T. DISTRICT 2 SURVEY OFFICE

PERSONNEL _____

REFERENCE NO. 17

SHEET 9 OF 15

NOTES BARNHISEL RC

H.C. CORDES

DATE 7-6-01

ROUTE 109

R.C. _____

WEATHER SUNNY

COUNTY FULTON

TEMP. +75°

TOWNSHIP YORK

SECTION 24

T 7 N R 7 E


TYPE MONUMENT PK/WASHER

ON SURFACE - ~~BELOW~~ yes


~~LEFT - & PAV'T. - RIGHT~~ yes

9.8' TO LT EDGE PAVEMENT

S.L.M. 266+08 ON E PAV'T EAST

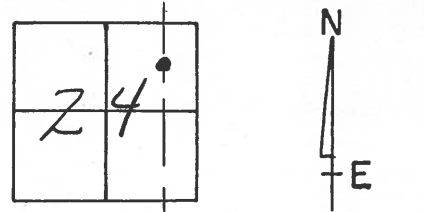

Reset Sm. RR. SPIKE
8-23-01
MDB

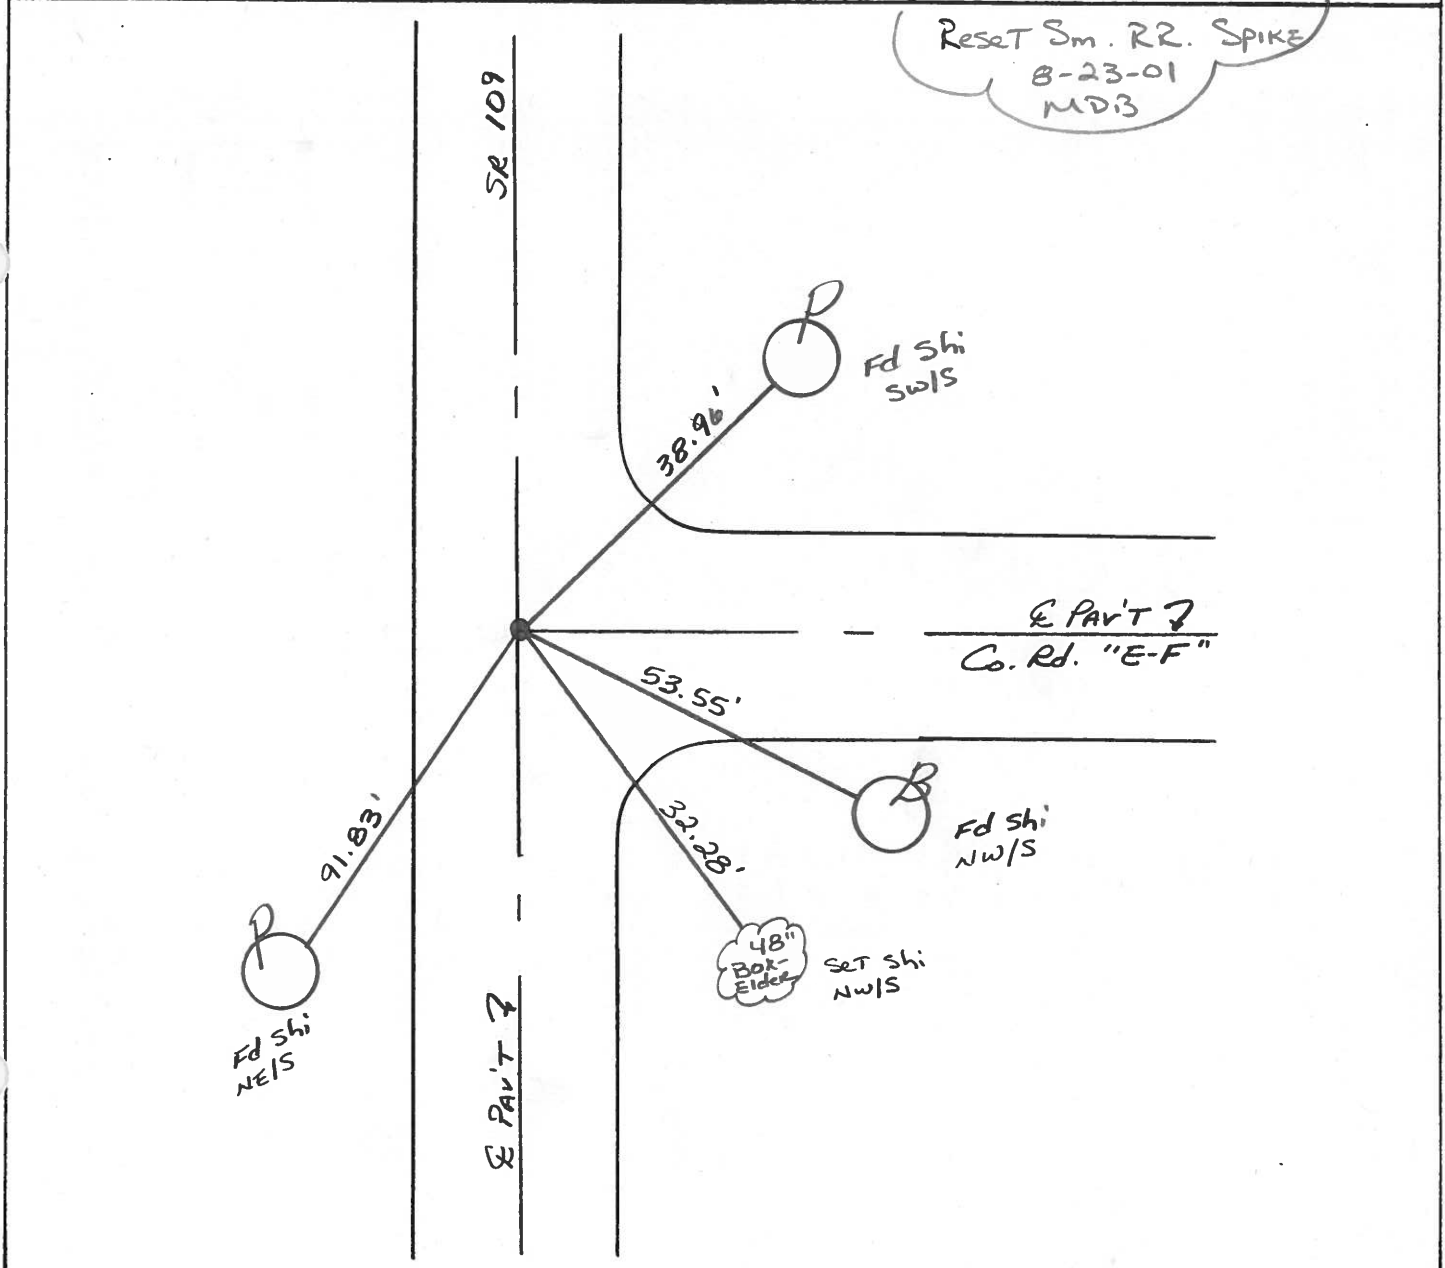

O.D.O.T. DISTRICT 2 SURVEY OFFICE

PERSONNEL

REFERENCE NO. 17

SHEET 19 OF 27

NOTES CORDES

H.C. CANTERBURY

R.C. HERMILLER

SLOVAK F

DATE 8-10-94

WEATHER SUNNY

TEMP. +75°F

ROUTE 109

COUNTY Fulton

TOWNSHIP York

SECTION 24

T 7 N R 7 E


TYPE MONUMENT 1/2 FROM PIPE

~~ON SURFACE~~ - BELOW 1 1/2' BELOW


LEFT - 0.3 PAV'T. - RIGHT 0.3

9.6 TO LT EDGE PAVEMENT

S.L.M. 266 to 8

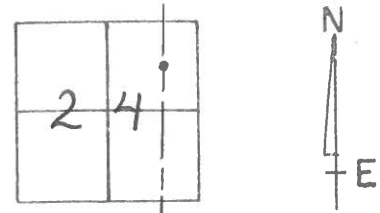

SET PK + WASHER
10-13-94
BUD

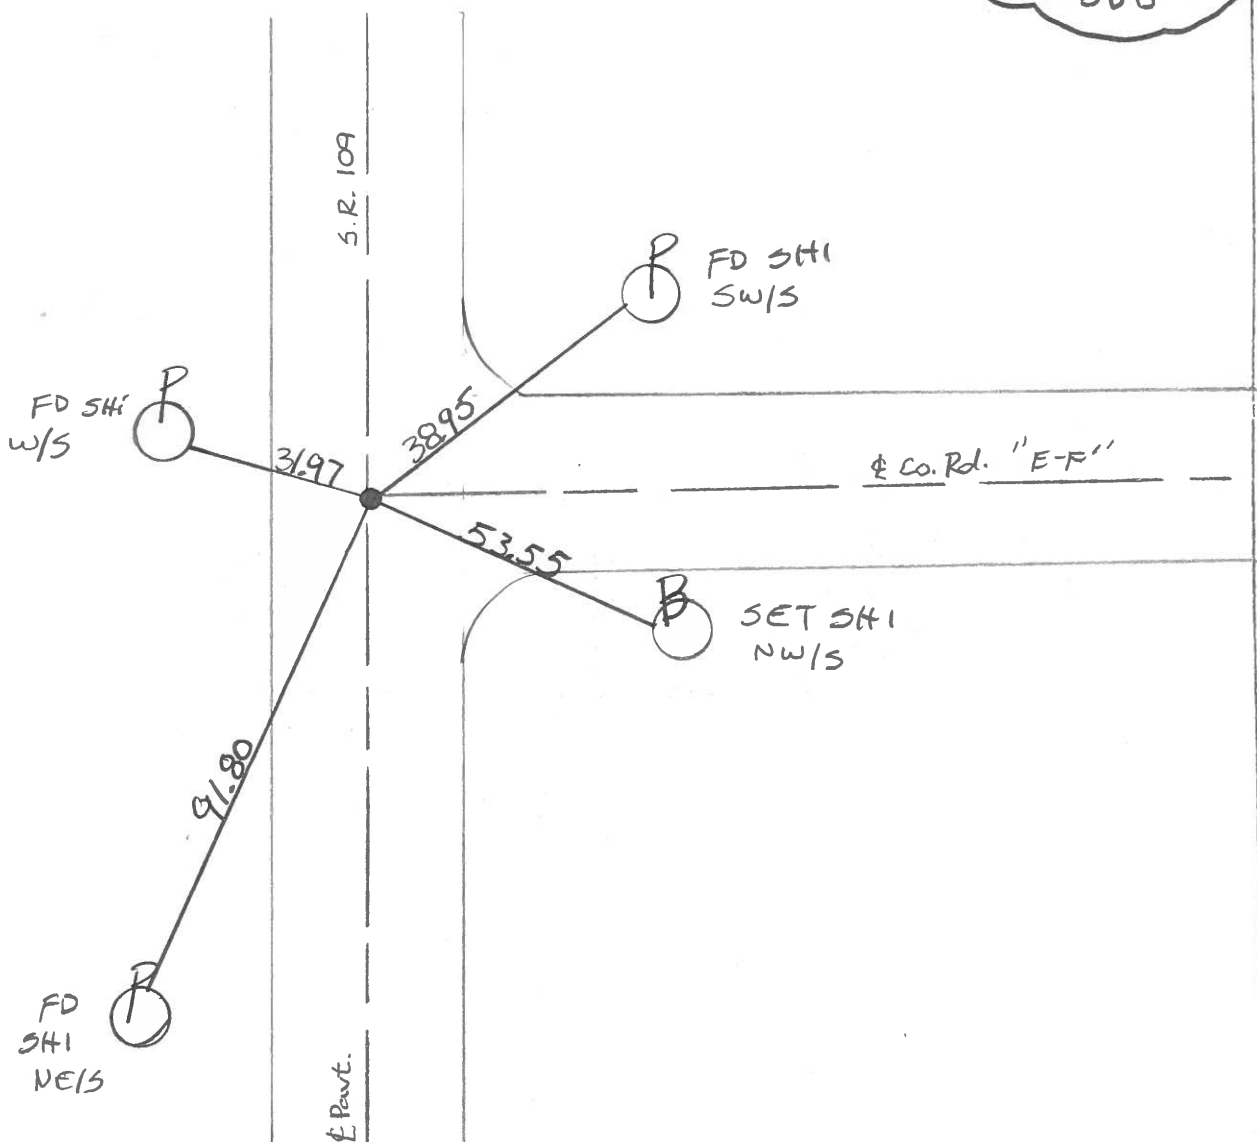

County Fulton S.R. 109

Township York

Section 24

T N, R E

Personnel J. Stone

P. Neuse

R. Michalak


D. Curtis

#17


Date 25 May 82

Weather Cloudy

Temp. 60°

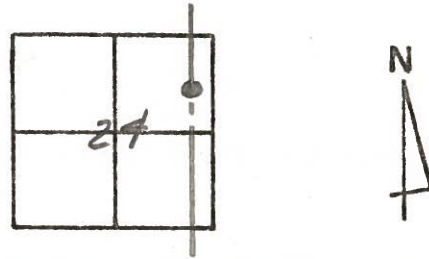


REF. NO. 17

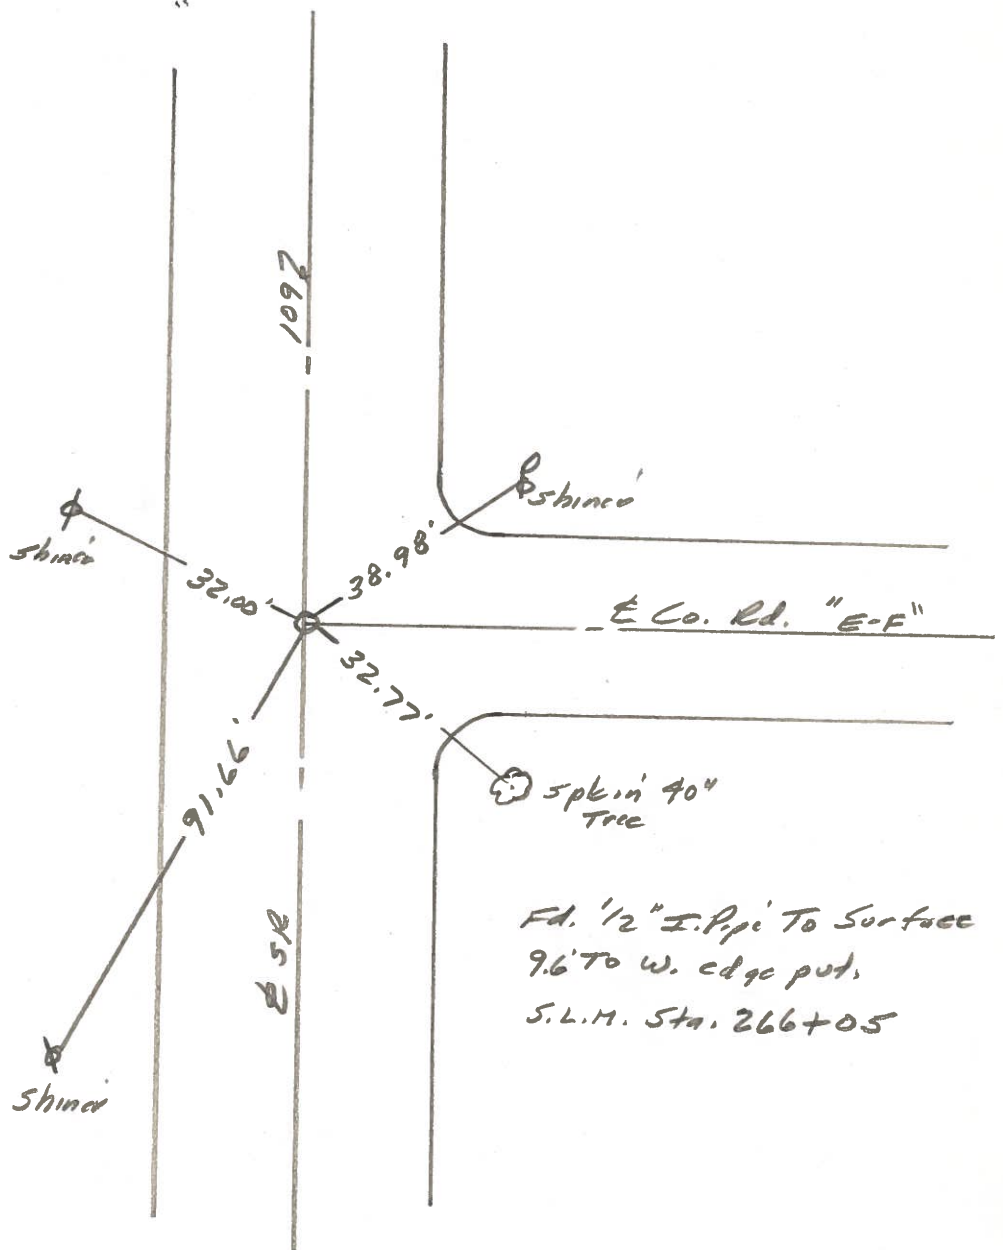

Fd. '1/2" I. Pipi To Surface
 9.6' To W. edge put.
 S.L.M. Sta. 266+05

PERSONNEL	TITLE	PERSONNEL	TITLE	COUNTY	DATE	WEATHER	TEMP.
Tomsic		Boyle		Fulton	July 16, 1973		
Nease				S. R. 109			
Granata				SEC.			
Vanya							

DESCRIPTION LEFT CENTER LINE RIGHT JOB NO.

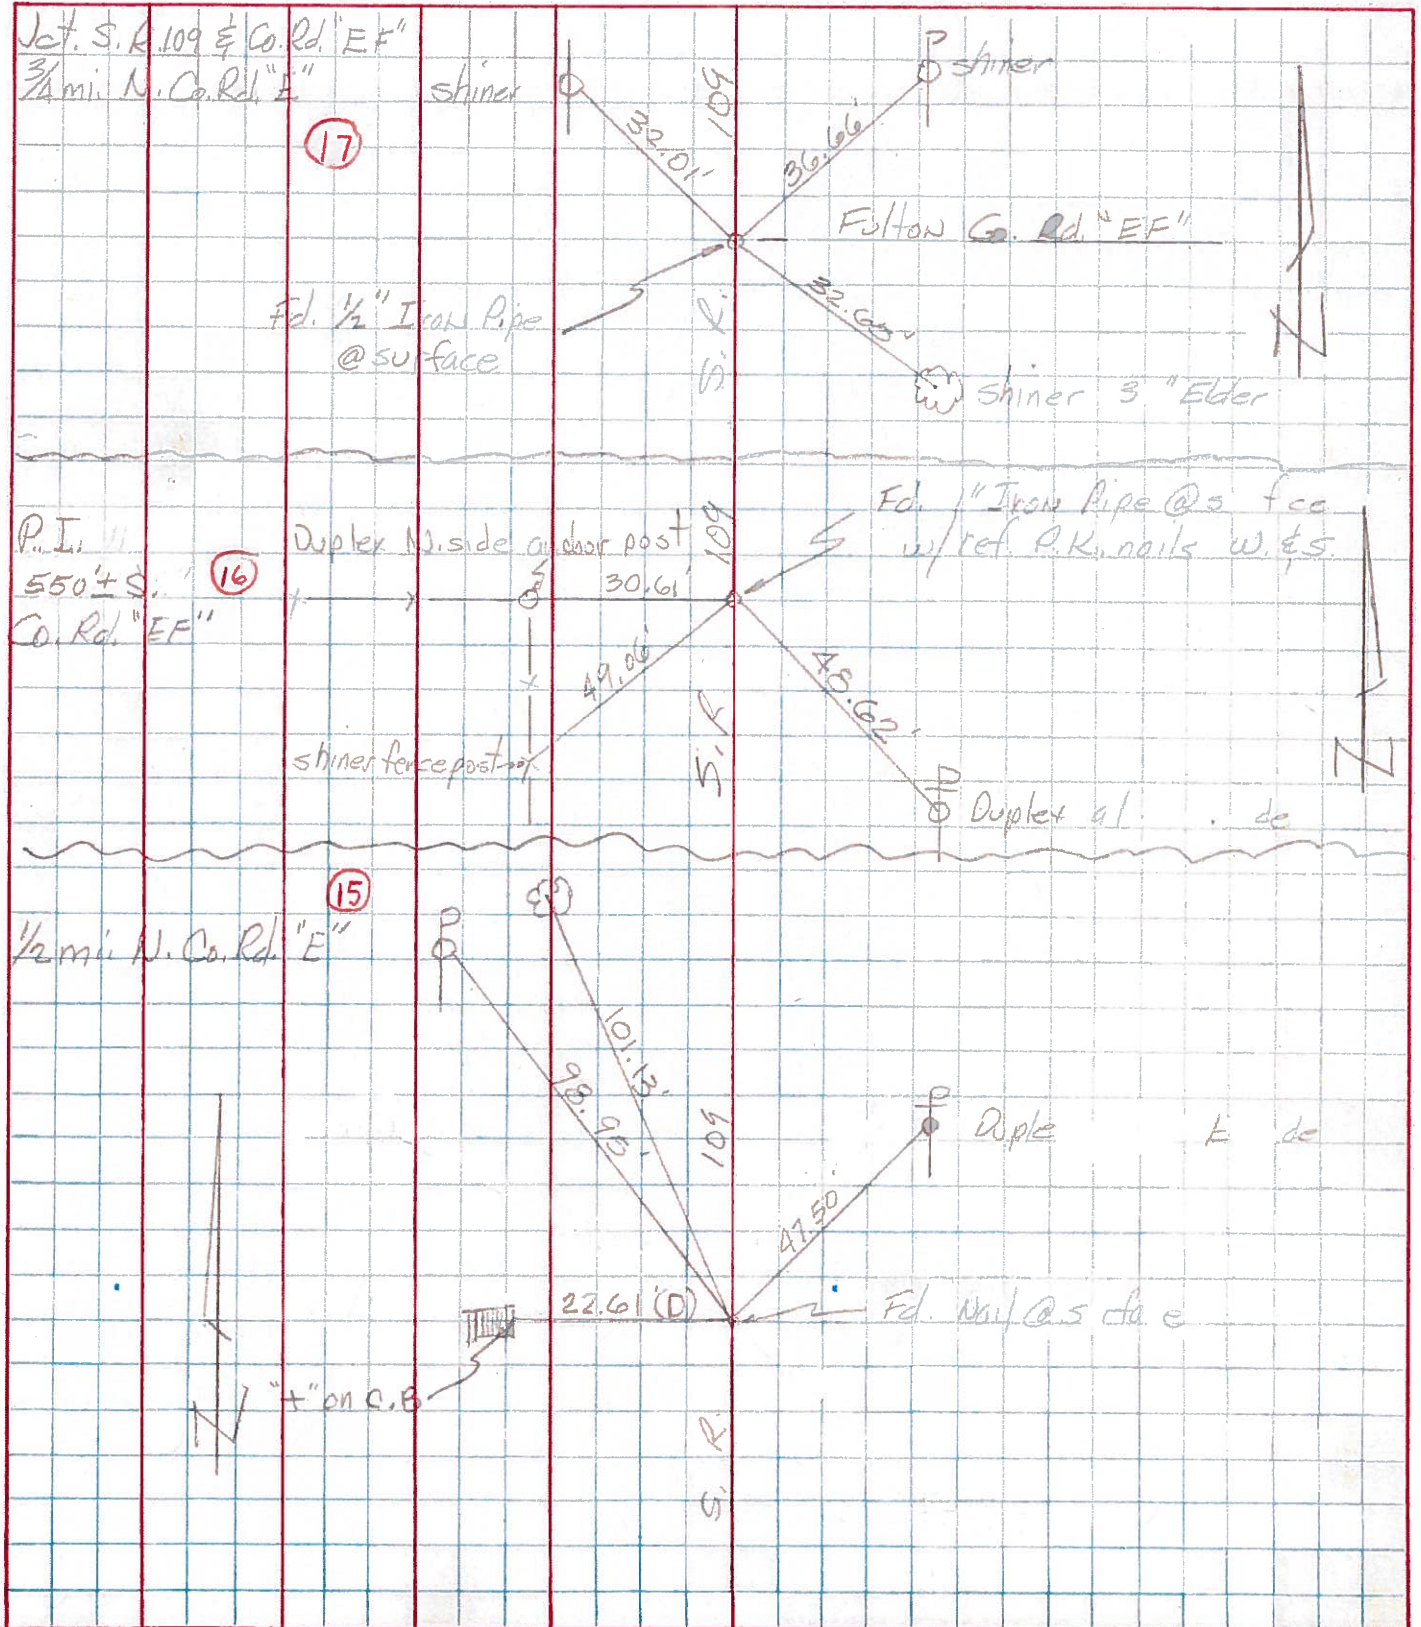

PERSONNEL <u>Red Beach</u>	TITLE	PERSONNEL	TITLE	COUNTY	<u>FULTON</u>	DATE	<u>Sept. 1970</u>
<u>Newcomb</u>				S. R.	<u>109</u>	WEATHER	
<u>Knape</u>				SEC	<u>NE 1/4 Sec. 24, YORK TWP</u>	TEMP.	
<u>Wise</u>							

DESCRIPTION ALIGNMENT & CONTROLS JOB NO.

