



O.D.O.T. DISTRICT 2 SURVEY OFFICE (USE ONLY)

PERSONNEL	REFERENCE NO.	17 A	SHEET	22	OF	31
NOTES	RHOADES	DATE	4-20-18	ROUTE	SR 109	
H.C.	O'DONNELL	WEATHER	SUNNY	COUNTY	FULTON	
R.C.	SEAMAN	TEMP.	39°	TOWNSHIP	YORK	
				SECTION	24	
				T	7	N
				R	7	E

TYPE MONUMENT MONBOX W/ 1" I PIN
 ON SURFACE - ~~BELOW~~ ON _____
~~LEFT~~ - ℄ PAV'T - RIGHT 1.5'
8.5 TO RT EDGE PAVEMENT
 S.L.M. 278+70.75
 GRID: NORTHING: 692971.747 EASTING: 1557652.0522

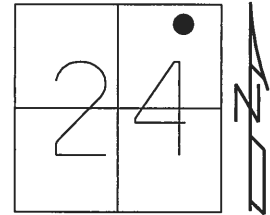

RECORD: P.C.
 9-24-82, STONE
 SET P.K./WASHER
 10-13-94, BUD
 SET SM.R.R. SPIKE
 8-23-01, MDB
 FD SM.R.R. SPIKE
 10-29-15, JFO
 REFA17
 11-16-15, JFO
 FD MONBOX
 W/1" IPIN
 ± 5" OFF
 NEWREFA17
 12-15-17
 12-19-17, JFO
 BUMPED PIN S.W.
 NEWREFA17
 4-4-18, JFO

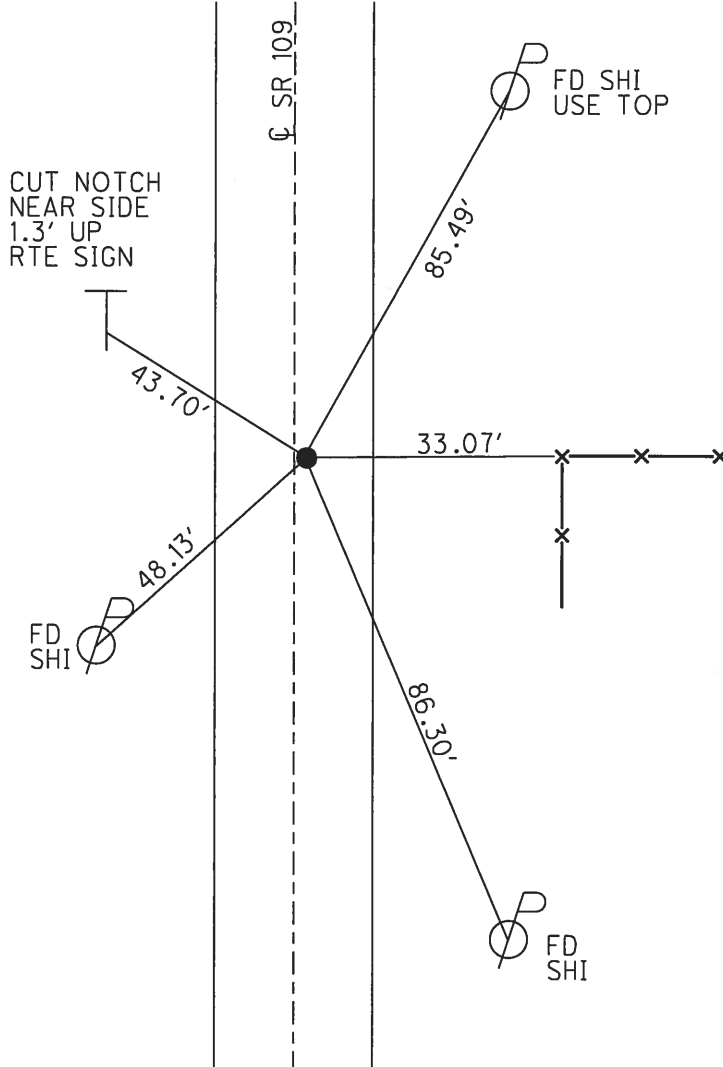

O.D.O.T. DISTRICT 2 SURVEY OFFICE

PERSONNEL _____

REFERENCE NO. 17-A

SHEET 10 OF 15

NOTES BARNHSEL RC

H.C. CORDES

R.C. _____

DATE 7-6-01

WEATHER SUNNY

TEMP. +75°

ROUTE 109

COUNTY FULTON

TOWNSHIP YORK

SECTION 24

T 7 N R 7 E


TYPE MONUMENT PK/WASHER

ON SURFACE - ~~BELOW~~ YES

LEFT - ~~C~~ PAV'T. - RIGHT 0.7'

8.5' TO RT EDGE PAVEMENT


S.L.M. 278+54

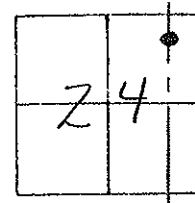

Records P.C.
5-24-82
STONE

Reset Sm. RR. SPIKE
8-23-01
MDS

CUT NOTCH
NEAR SIDE
1.3' up
"ST. RT. 109"
SIGN

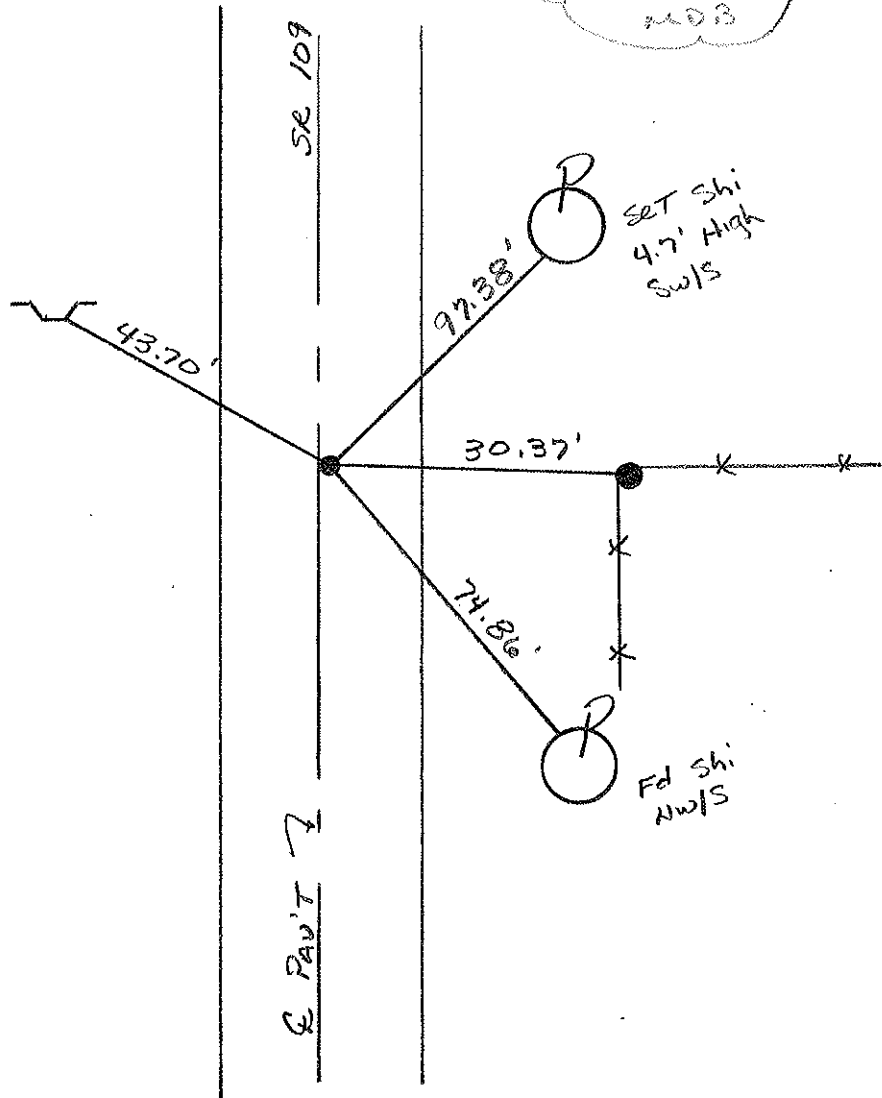

O.D.O.T. DISTRICT 2 SURVEY OFFICE

PERSONNEL

REFERENCE NO. 17-A

SHEET 20 OF 27

NOTES CORDES

H.C. VAN DUSEN

DATE 8-10-94

ROUTE 109

R.C. SIOUAK

WEATHER SUNNY

COUNTY Fulton

BARNISEL

TEMP. +75°F

TOWNSHIP York

SECTION 24

T 2 N R 7 E


TYPE MONUMENT PK NAIL

ON SURFACE BELOW YES

LEFT-Q PAV'T. - RIGHT 1.8


9.7 TO RT. EDGE PAVEMENT

S.L.M. 278+54

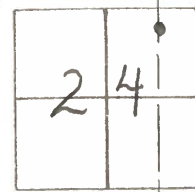

RECORD: P.C. CURVE
5-24-82 STONE

SET P.K. + WASHER
10-13-94
BUD

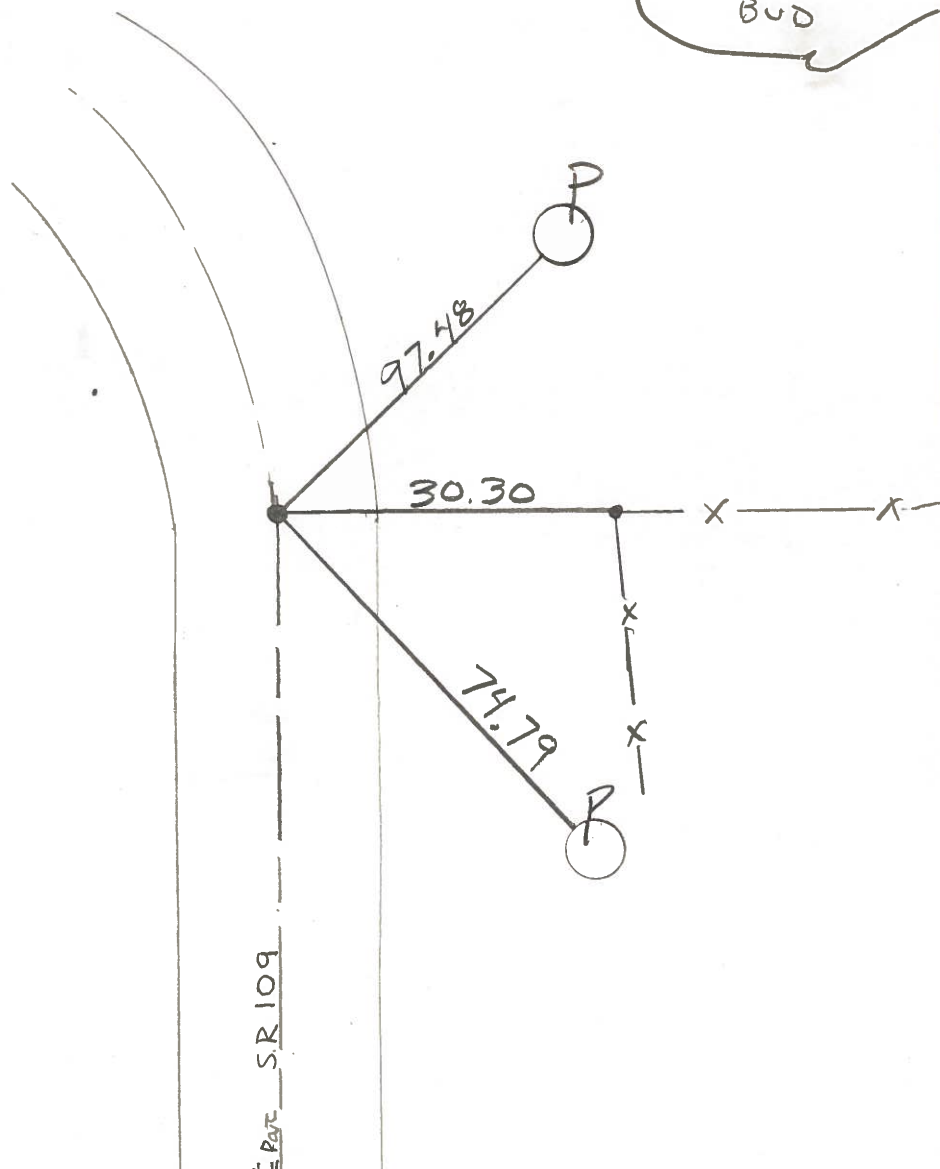

SR 109

County Fulton S.R. 109

Date 25 May 82

Township York


Weather cloudy

Section 24

Temp. 60°

T N, R E

Personnel I. Stone

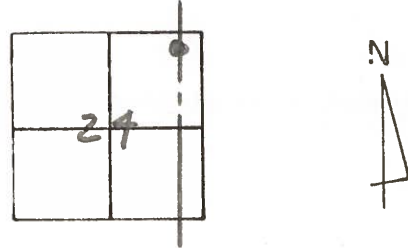


#17-A

P. Newser
R. Michalok
D. Curtis

REF. No. 17A

Fd. PK Nail To Surface
P.C. Curve
9.3' To E. edge put.
11.6' To W. edge put.
SLM STA. 278+50

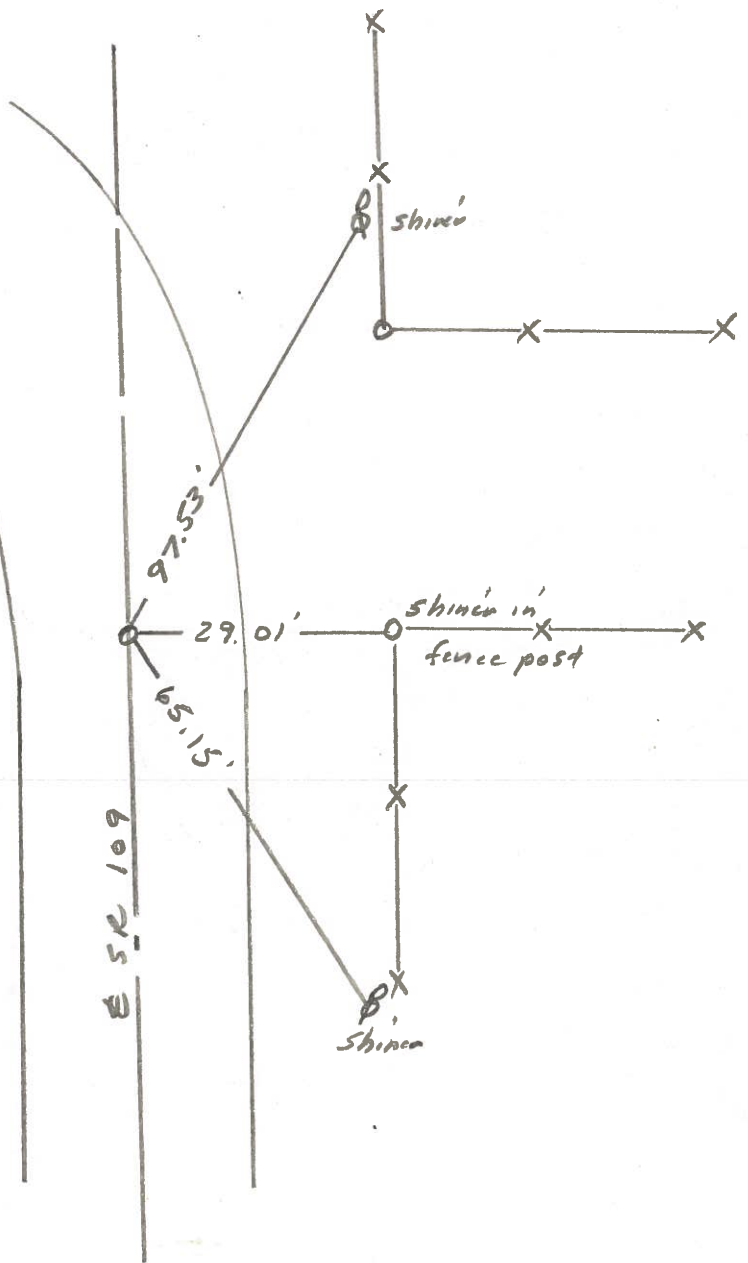

PERSONNEL	TITLE	PERSONNEL	TITLE
Tomsic		Boyle	
Neuer			
Granata			
Vanyo			

COUNTY	Fulton	DATE	July 16, 1973
S. R.	109	WEATHER	
SEC.		TEMP.	

DESCRIPTION LEFT CENTER LINE RIGHT JOB NO.

