


O.D.O.T. DISTRICT 2 SURVEY OFFICE (USE ONLY)


PERSONNEL _____ REFERENCE NO. 18 D SHEET 26 OF 31
 NOTES RHOADES DATE 7-26-17 ROUTE SR 109
 H.C. O'DONNELL WEATHER SUNNY COUNTY FULTON
 R.C. CARSON TEMP. 67° TOWNSHIP YORK
 _____ SECTION 24
 _____ T 7 N R 7 E

TYPE MONUMENT 3/4" IRON PIPE
~~ON SURFACE~~ - BELOW 4"
~~LEFT~~ - ℄ PAV'T - RIGHT 11.9'
0.7' RT OF EDGE PAVEMENT
 S.L.M. 281+54.3

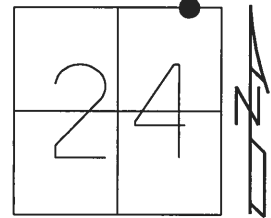

GRID: NORTHING: 693219.1369 EASTING: 1557585.1295

RECORD:
 FD P.K./NAIL 1/2"
 8-10-94, BC
 SET P.K./WASHER
 10-14-94, SCH
 SET SM.R.R.SPIKE
 8-23-01, MDB
 FD SM.R.R.SPIKE
 REFD18
 11-16-15, JFO
 FD MON BOX
 NEWREFD18
 12-15-17, JFO

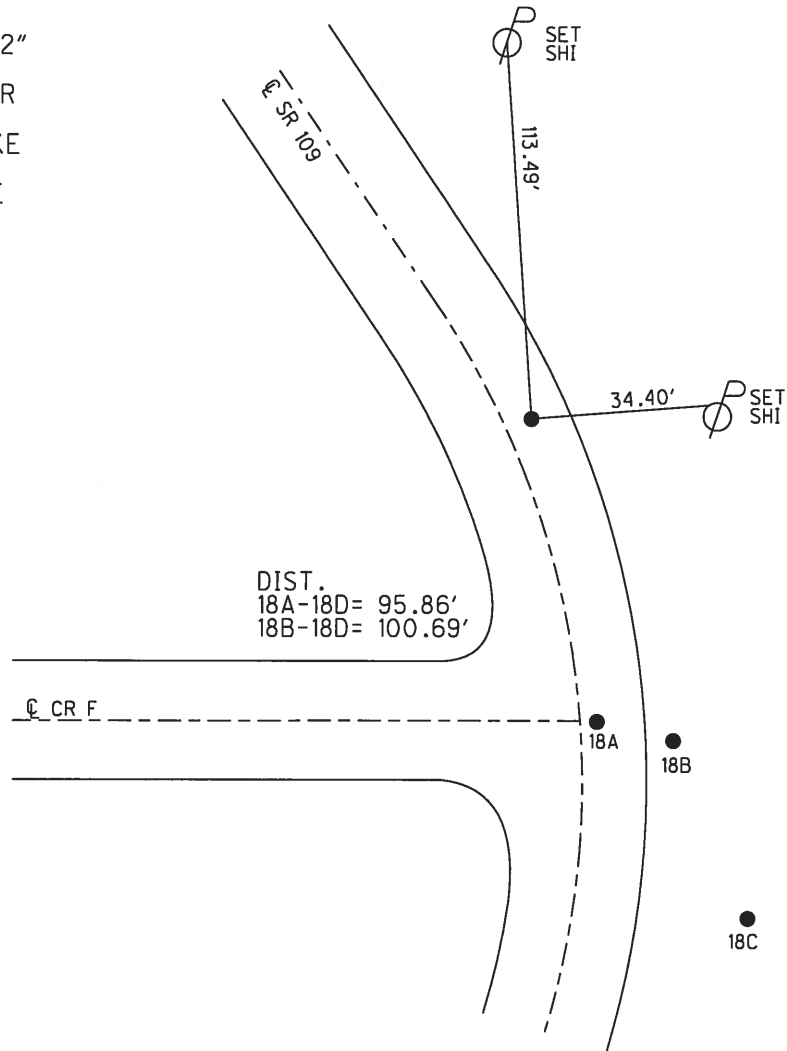

O.D.O.T. DISTRICT 2 SURVEY OFFICE

PERSONNEL

NOTES BARNHISEL RC

H.C. CORDES

R.C. _____

REFERENCE NO. 18-B, 18-C, 18, 18-A SHEET 11 OF 15
C, B, A, D

DATE 7-6-01

WEATHER Sunny

TEMP. +75°

ROUTE 109

COUNTY FULTON

TOWNSHIP YORK

SECTION 24

T 7 N R 7 E


TYPE MONUMENT See Below

ON SURFACE - BELOW See Below


LEFT - & PAV'T. - RIGHT See Below

— TO — EDGE PAVEMENT

S.L.M. See Below

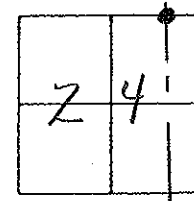

PT "A" & "D"
 RESET SM. RR. SPKES
 8-23-01
 MDB

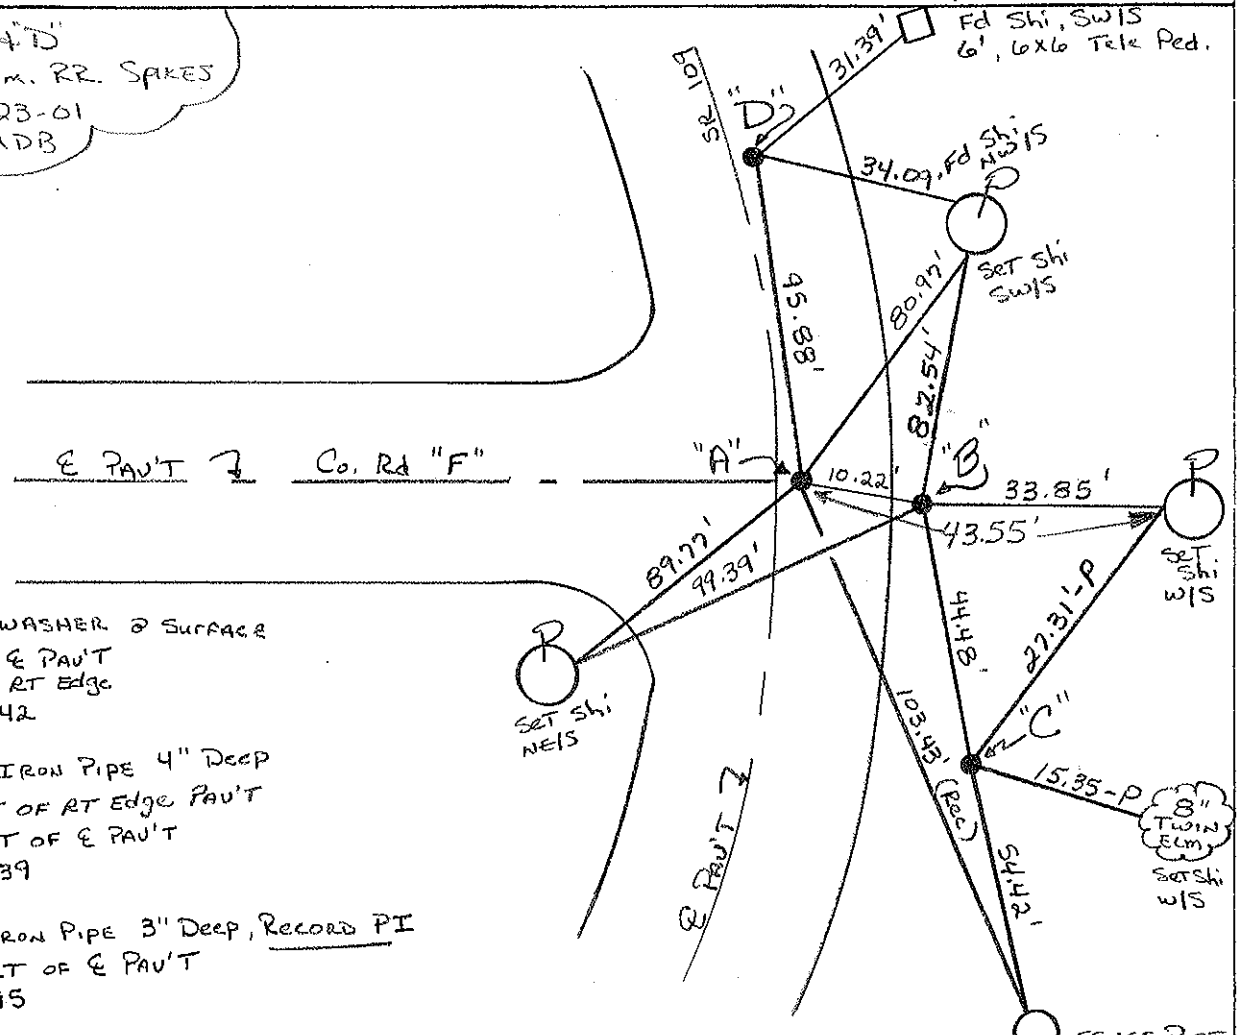

- "A" = Fd PKWASHER @ SURFACE
 2.3' RT of PAV'T
 9.0' TO RT EDGE
 280+42
- "B" = Fd 3/4" IRON PIPE 4" DEEP
 0.7' RT OF RT EDGE PAV'T
 11.9' RT OF E PAV'T
 280+39
- "C" = Fd 1/2" IRON PIPE 3" DEEP, RECORD PI
 20.8' RT OF E PAV'T
 279+95
- "D" = Fd PKWASHER @ SURFACE, RECORD PT
 1.9' RT OF E PAV'T
 8.6' TO RT EDGE PAV'T
 281+36

O.D.O.T. DISTRICT 2 SURVEY OFFICE

PERSONNEL

REFERENCE NO. 17-B/18/19 SHEET 21 OF 27

NOTES CORDES

H.C. CANTERBURY

R.C. HERMILLER

SIQUAK P

DATE 8-10-94

WEATHER SUNNY

TEMP. 75° F

ROUTE 109

COUNTY Fulton

TOWNSHIP Troy

SECTION 24

T 7 N R 7 E


TYPE MONUMENT SEE BELOW

ON SURFACE - BELOW SEE BELOW


LEFT- & PAV'T. - RIGHT SEE BELOW

TO EDGE PAVEMENT

S.L.M. SEE BELOW

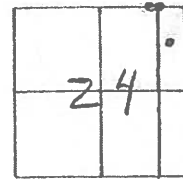

SET PK & WASHER
AT ALL POINTS
10-14-94
SCH

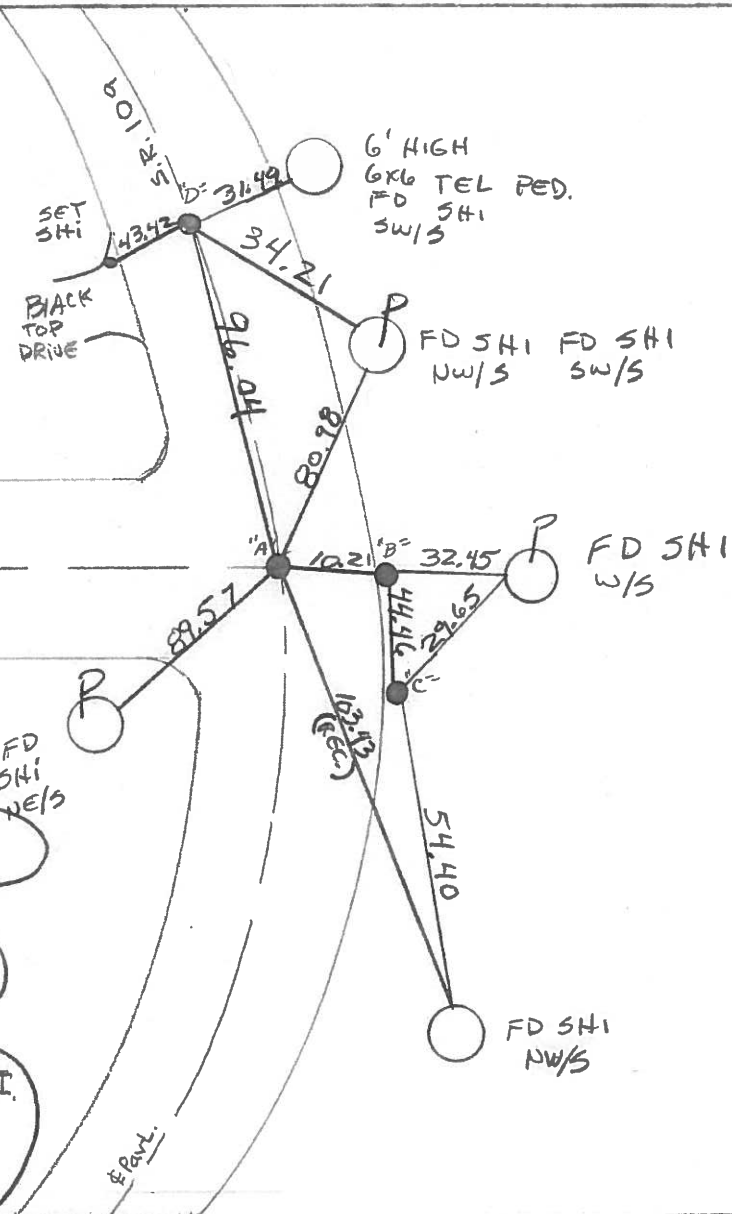

- "A" = FD RR SPKIKE 1 1/2" DEEP DAMAGED
1.2 RT &
10.3 RT. EDGE
280+42
- "B" = FD 3/4" IRON PIPE 2" DEEP
0.8 TO RT. EDGE
10.9 RT of E
280+39
- "C" = FD. 1 1/2" IRON PIPE 2" DEEP RECORD P.I.
20.8 RT &
279+95
- "D" = FD PK NAIL 1 1/2" DEEP RECORD P.T.
1.7 RTE, 9.7 RT EDGE
281+36

O.D.O.T. DISTRICT 2 SURVEY OFFICE

SHEET 11 OF

County Fulton S.R. 109

Date 25 May 82

Township Troy

Weather Cool

Section 24

Temp. 60°

T N, R E


Personnel I. Stone

P. Houser


R. Michalale

J. Curtis

#17-A, 18
#19

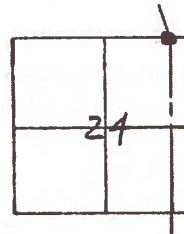

REF. No. 17-A, 18, 19


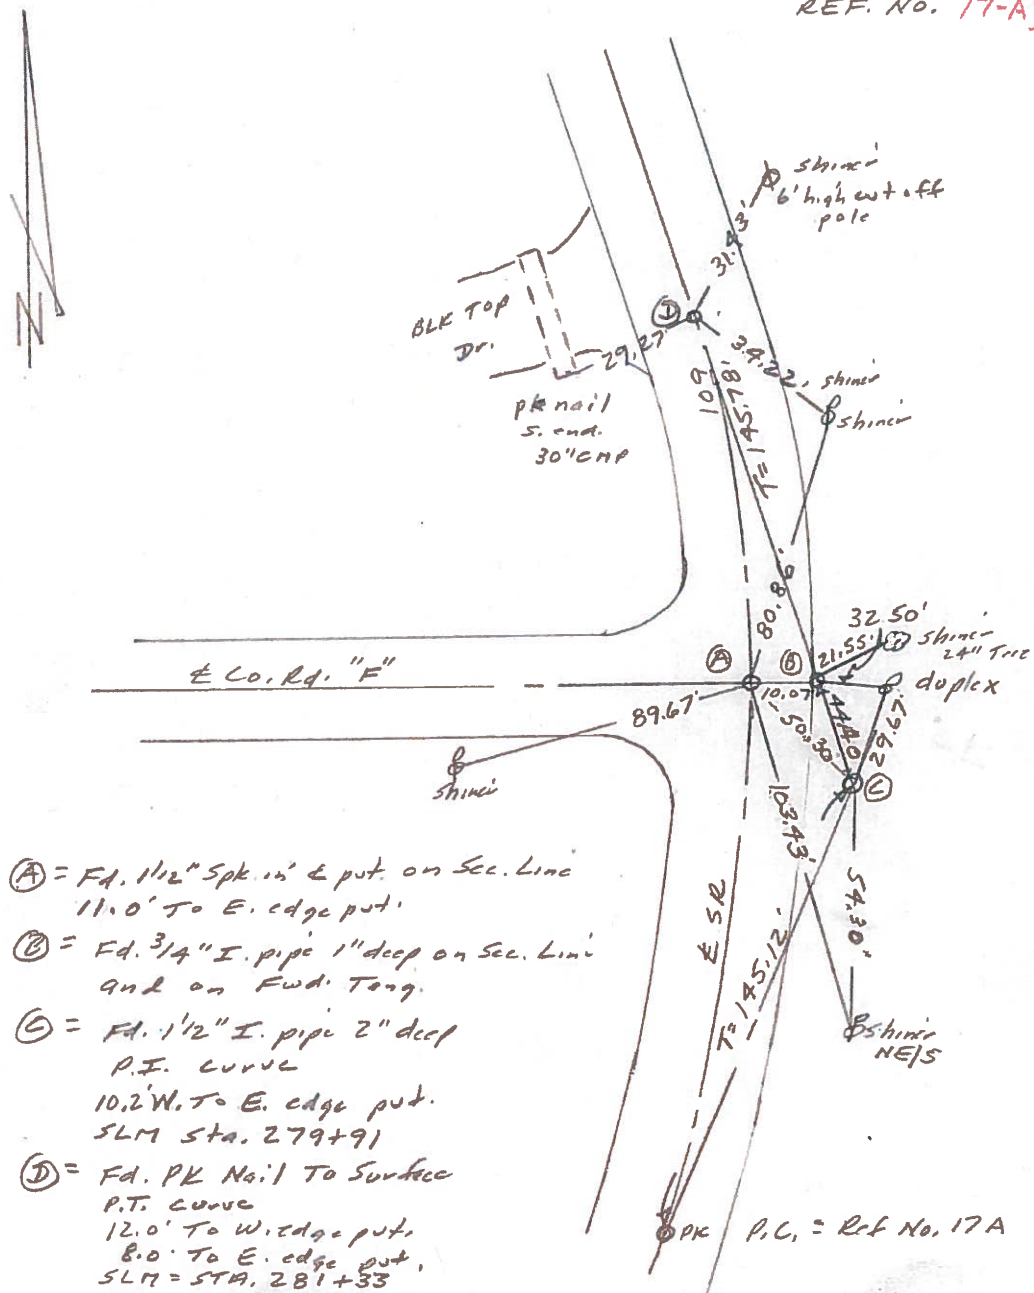


- Ⓐ = Fd. 1 1/2" Spk. in' & put. on Sec. Line 11.0' To E. edge put.
- Ⓑ = Fd. 3/4" I. pipe 1" deep on Sec. Line and on Fwd. Tang.
- Ⓒ = Fd. 1/2" I. pipe 2" deep P.F. curve 10.2' W. To E. edge put. SLM Sta. 279+91
- Ⓓ = Fd. PK Nail To Surface P.T. curve 12.0' To W. edge put, 8.0' To E. edge put, SLM = STA. 281+33


PK P.C. = Ref No. 17A

PERSONNEL	TITLE	PERSONNEL	TITLE	COUNTY	DATE
Red Beach				Fulton	Aug 1970
Newcomb					
Knape				S. R. 109	WEATHER
Wise				SEC. YORK TWP	TEMP.

DESCRIPTION CONTROL POINTS JOB NO.

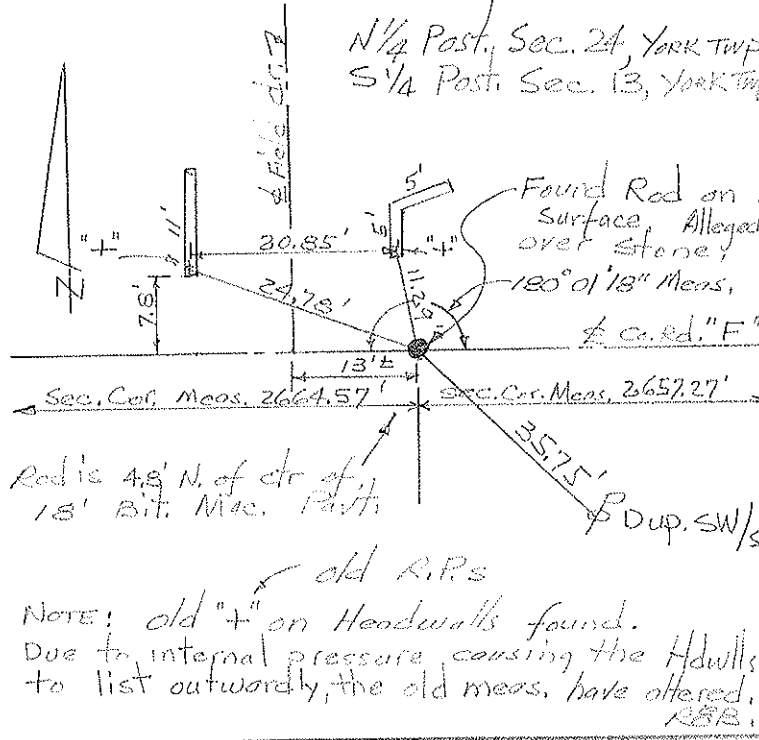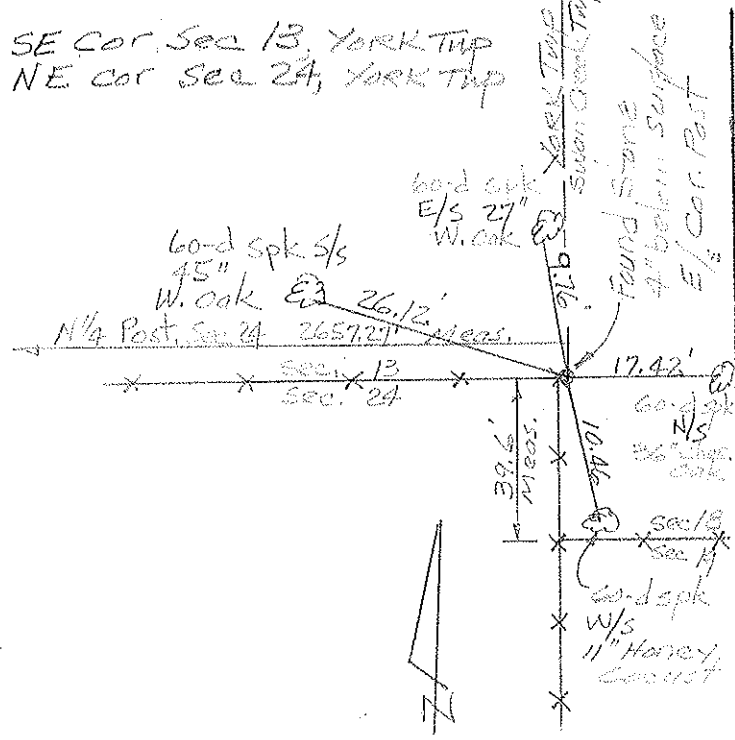

P.I. Sta. 280+26.65 $\Delta = 31^\circ 08' Lt.$

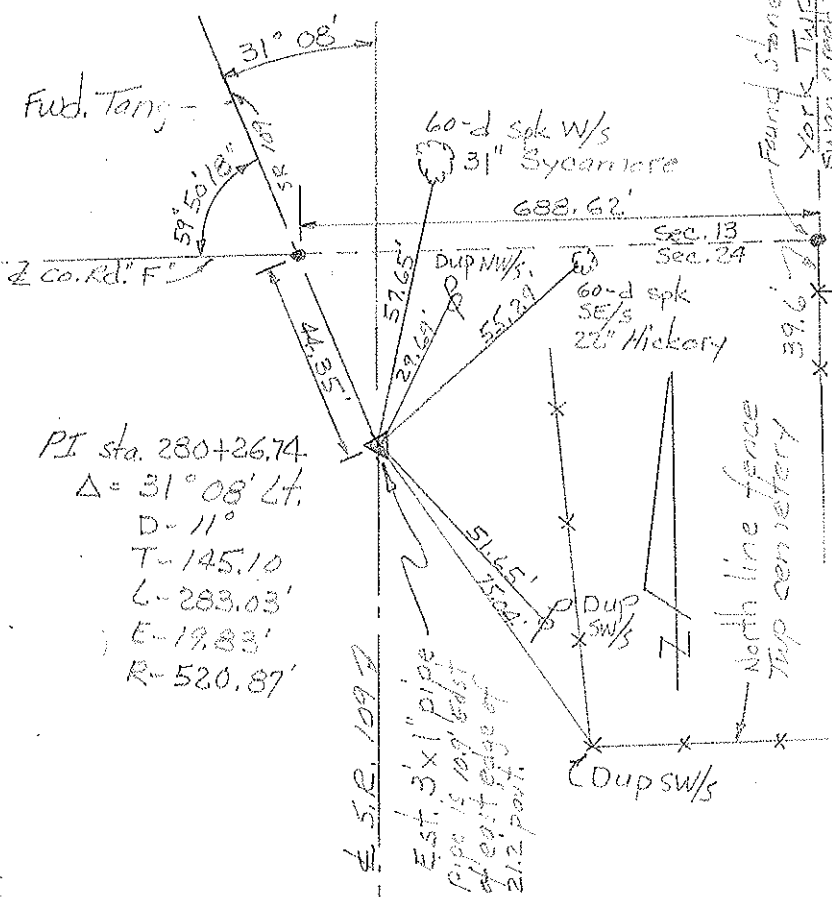

P.I. Sta. 280+26.74
 $\Delta = 31^\circ 08' Lt.$
 D = 11'
 T = 145.10
 L = 283.03'
 E = 19.83'
 R = 520.87'

Sec. Cor., Sec. 13, 14, 23 & 24 York Twp.

