



O.D.O.T. DISTRICT 2 SURVEY OFFICE (USE ONLY)

PERSONNEL _____ REFERENCE NO. 19 A SHEET 28 OF 31
 NOTES RHOADES DATE 12-15-17 ROUTE SR 109
 H.C. O'DONNELL WEATHER CLOUDY COUNTY FULTON
 R.C. FARKAS TEMP. 24° TOWNSHIP YORK
 _____ SECTION 13
 _____ T 7 N R 7 E

TYPE MONUMENT CMON
 ON SURFACE - ~~BELOW~~ ON _____
 LEFT - ☉ PAV'T - RIGHT ON
10.6' TO LT EDGE PAVEMENT
 S.L.M. 292+22.21
 GRID: NORTHING: 694147.5663 EASTING: 1557033.8199

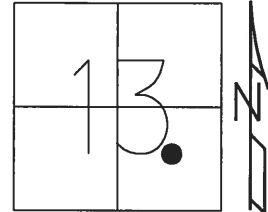

RECORD: ☉ CONST T.S.
 STA. 292+32.45
 SEE PLAN
 FUL-109-5.40 (1978)
 SHOT CTR OF BOX
 REFA19
 NEED TO RAISE
 BOX 4"± DOWN
 12-23-15, JFO
 DNF MONBOX
 12-1-17, JFO
 SET MAG/WASHER
 NEWREFA19
 12-15-17, JFO

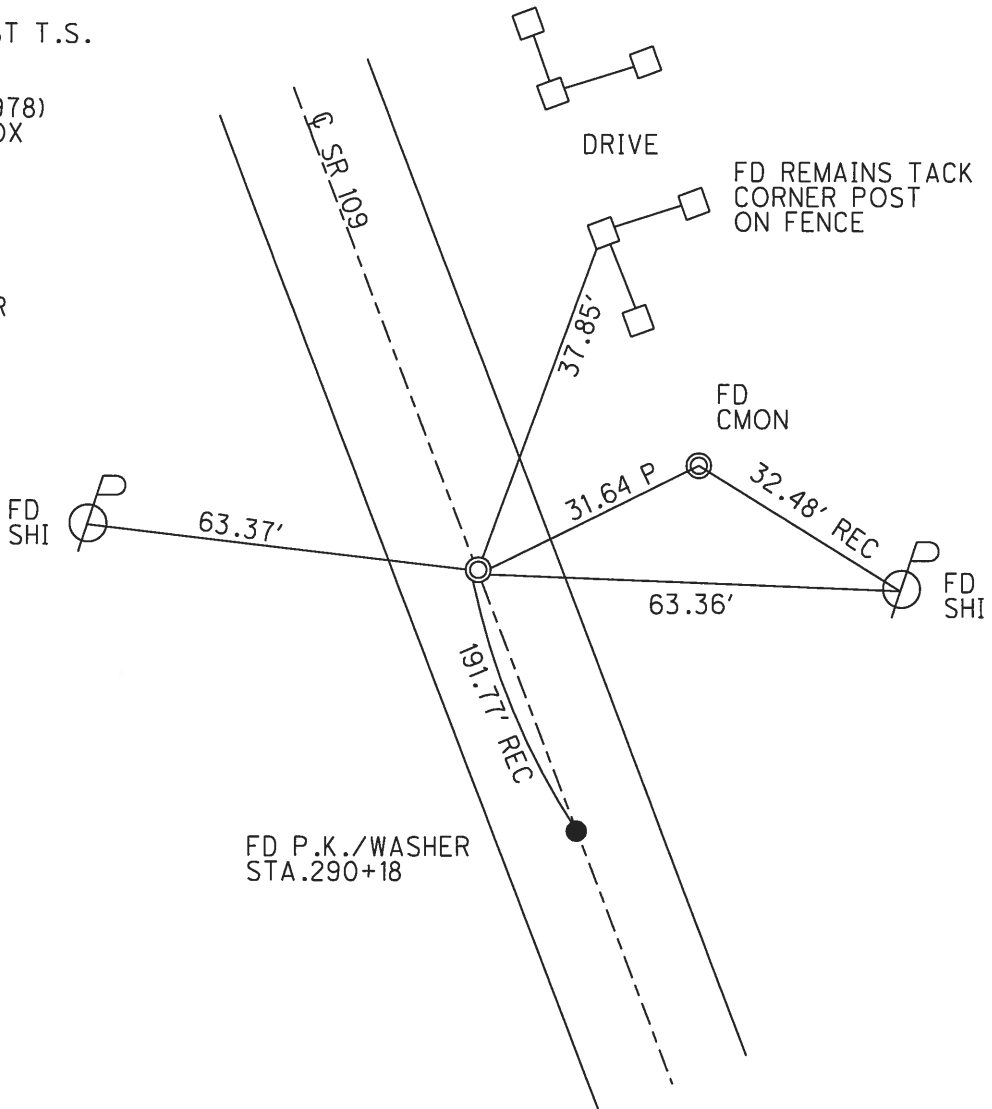

O.D.O.T. DISTRICT 2 SURVEY OFFICE

PERSONNEL _____

REFERENCE NO. 19-A
ALTER 1978

SHEET 13 OF 15

NOTES BARNHISE 1

H.C. Moser

DATE 7-9-01

ROUTE 109

R.C. CANTERBURY

WEATHER SUNNY

COUNTY FULTON

TEMP. +85°

TOWNSHIP YORK

SECTION 13

T 7 N R 7 E


TYPE MONUMENT I-Rod in Conc. Mon.

ON SURFACE - BELOW yes


~~LEFT~~ - RIGHT yes

10.6' TO LT EDGE PAVEMENT

S.L.M. 292+06

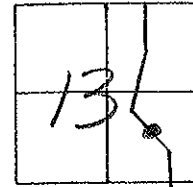

Records:
to const.
T.S. 292+32.45
See Plan;
FUL-109-S.40 (1978)

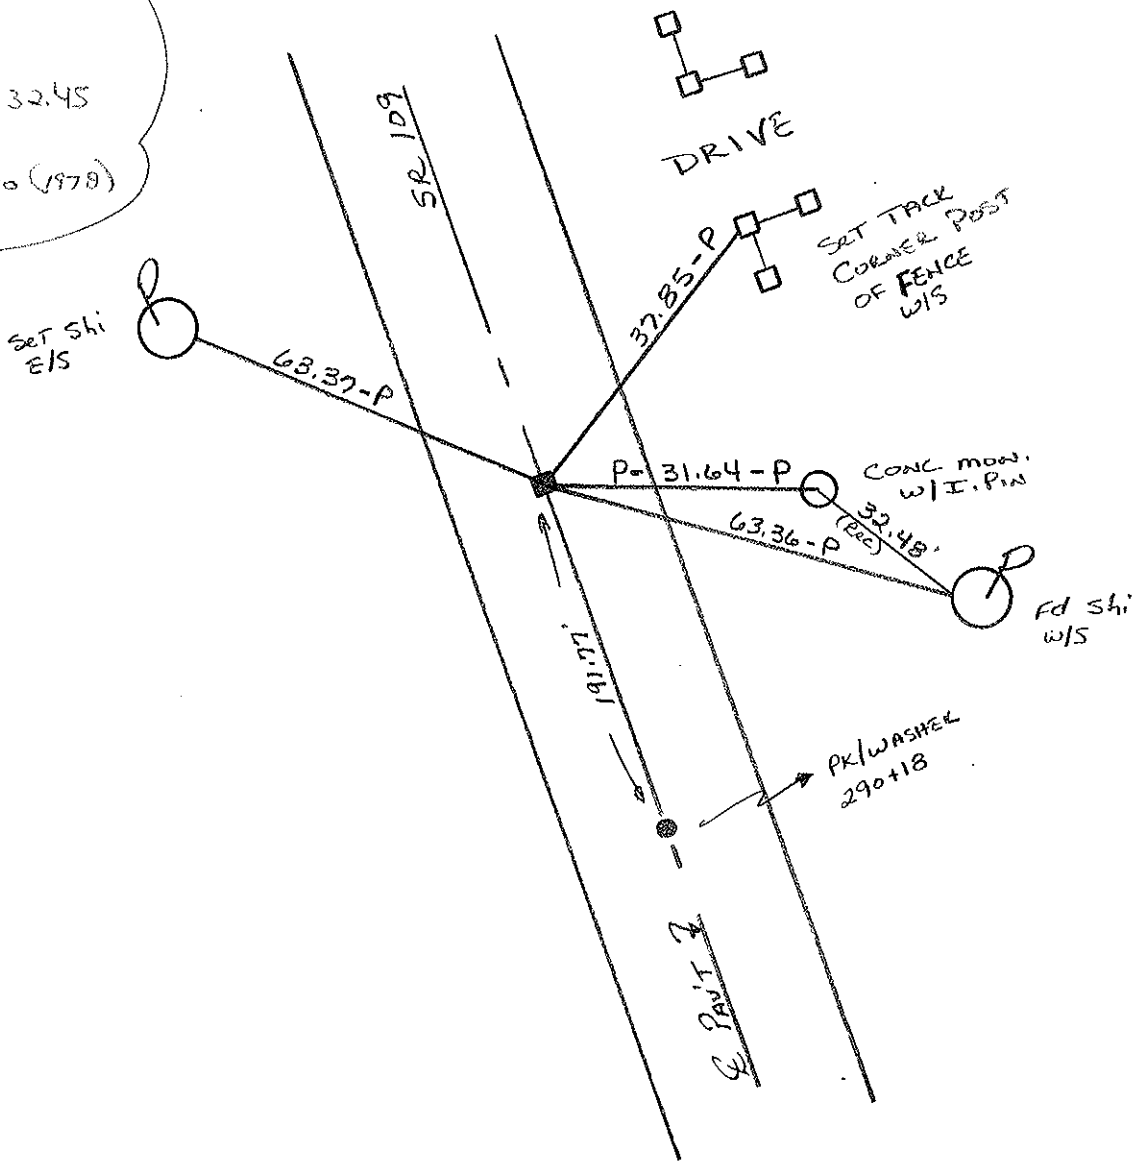

O.D.O.T. DISTRICT 2 SURVEY OFFICE

PERSONNEL

REFERENCE NO. 19-A

SHEET 24 OF 27

NOTES CORDES

H.C. VAN DUSEN

DATE 8-15-94

ROUTE 109

R.C. BARNHISEL

WEATHER SUNNY

COUNTY FULTON

SLOVAK P

TEMP. +65° F

TOWNSHIP YORK

SECTION 13

T 7 N R 7 E



TYPE MONUMENT MON. BOX

ON SURFACE - ~~BELOW~~ YES

~~LEFT- & PAV'T. - RIGHT~~ YES

10.9 TO RT. EDGE PAVEMENT

S.L.M. 292 + 05

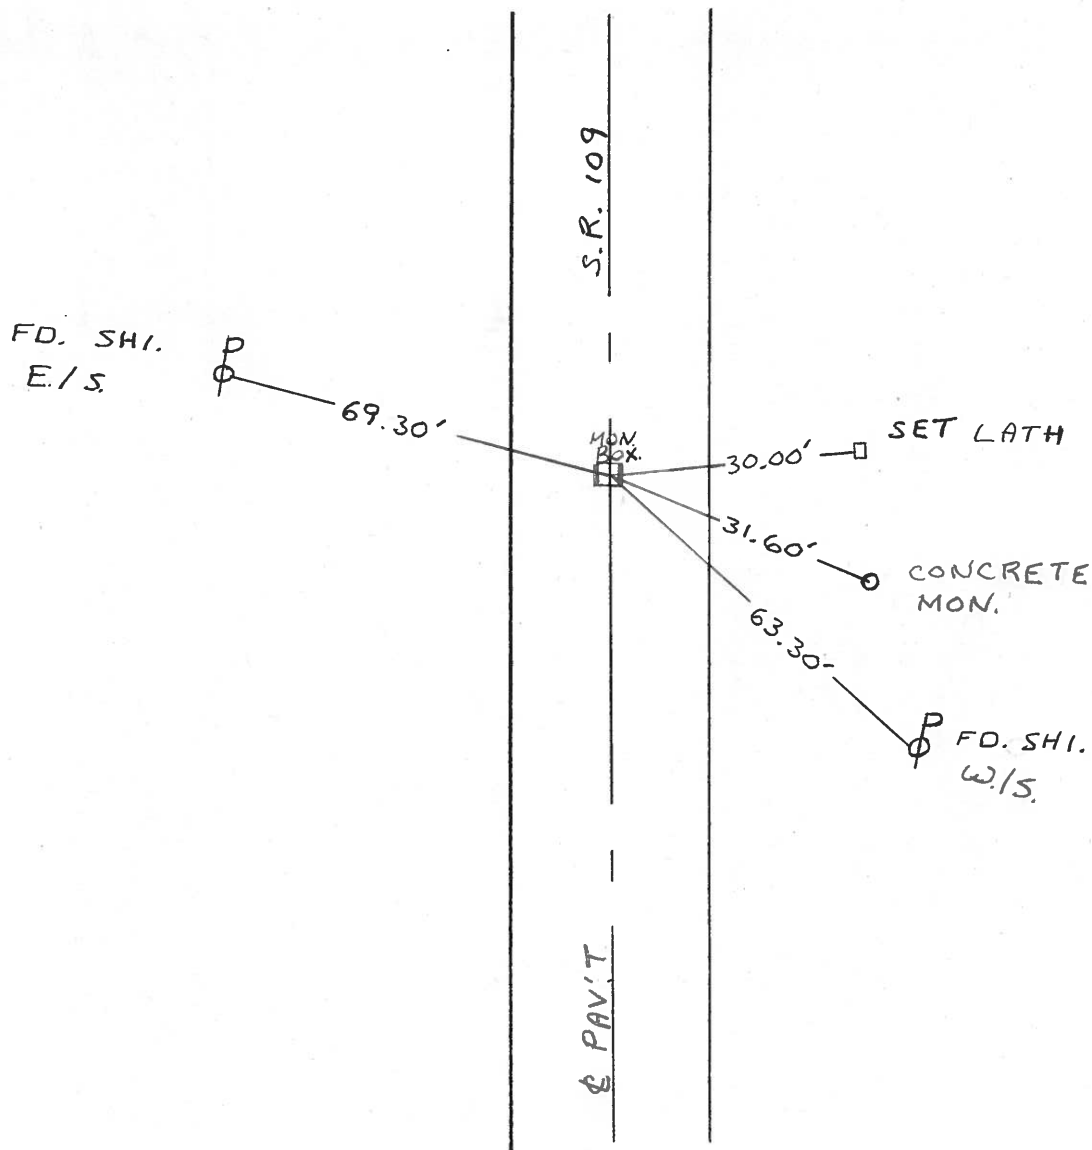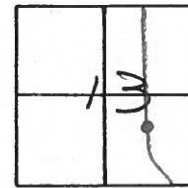

O.D.O.T. DISTRICT 2 SURVEY OFFICE

PERSONNEL _____

REFERENCE NO. _____

SHEET 23 OF 27

NOTES CORDES

H.C. VAN DUSEN

DATE 8-15-94

ROUTE 109

R.C. BARPHISEL

WEATHER SUNNY

COUNTY FULTON

SLOVAK P

TEMP. +65° F

TOWNSHIP YORK

SECTION 13

T 7 N R 7 E


TYPE MONUMENT CONC. MON

ON SURFACE - BELOW YES


~~LEFT~~ - CL PAV'T. - RIGHT 31.3

TO - EDGE PAVEMENT

S.L.M. 292+00

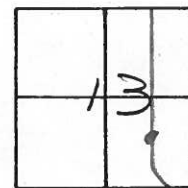


SET
SHI
E/S

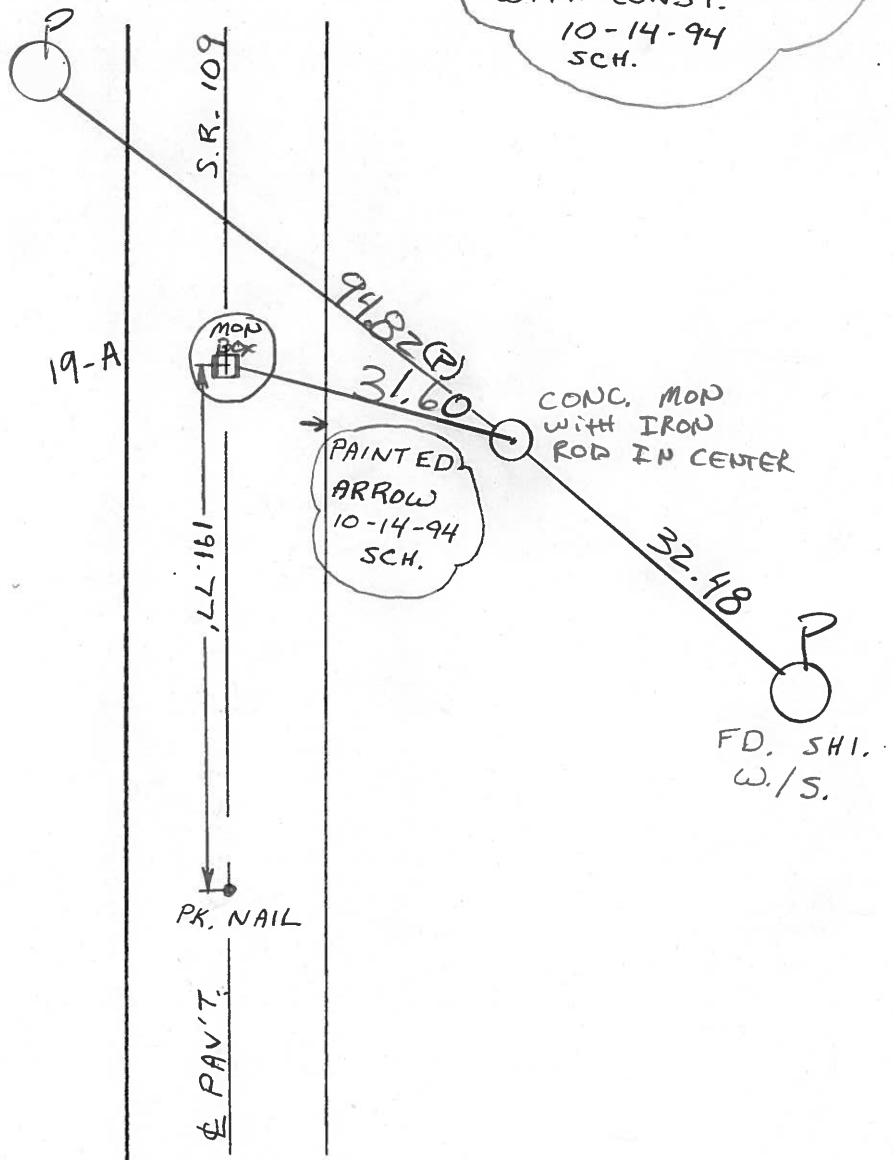

PERSONNEL	TITLE	PERSONNEL	TITLE	COUNTY	DATE	WEATHER
Tomasic		Boyle		Fulton	July 16, 1973	
Naucer				S. R. 109		
Granata				SEC.		
Vanyo						TEMP.

DESCRIPTION	LEFT	CENTER LINE	RIGHT	JOB NO.
-------------	------	-------------	-------	---------

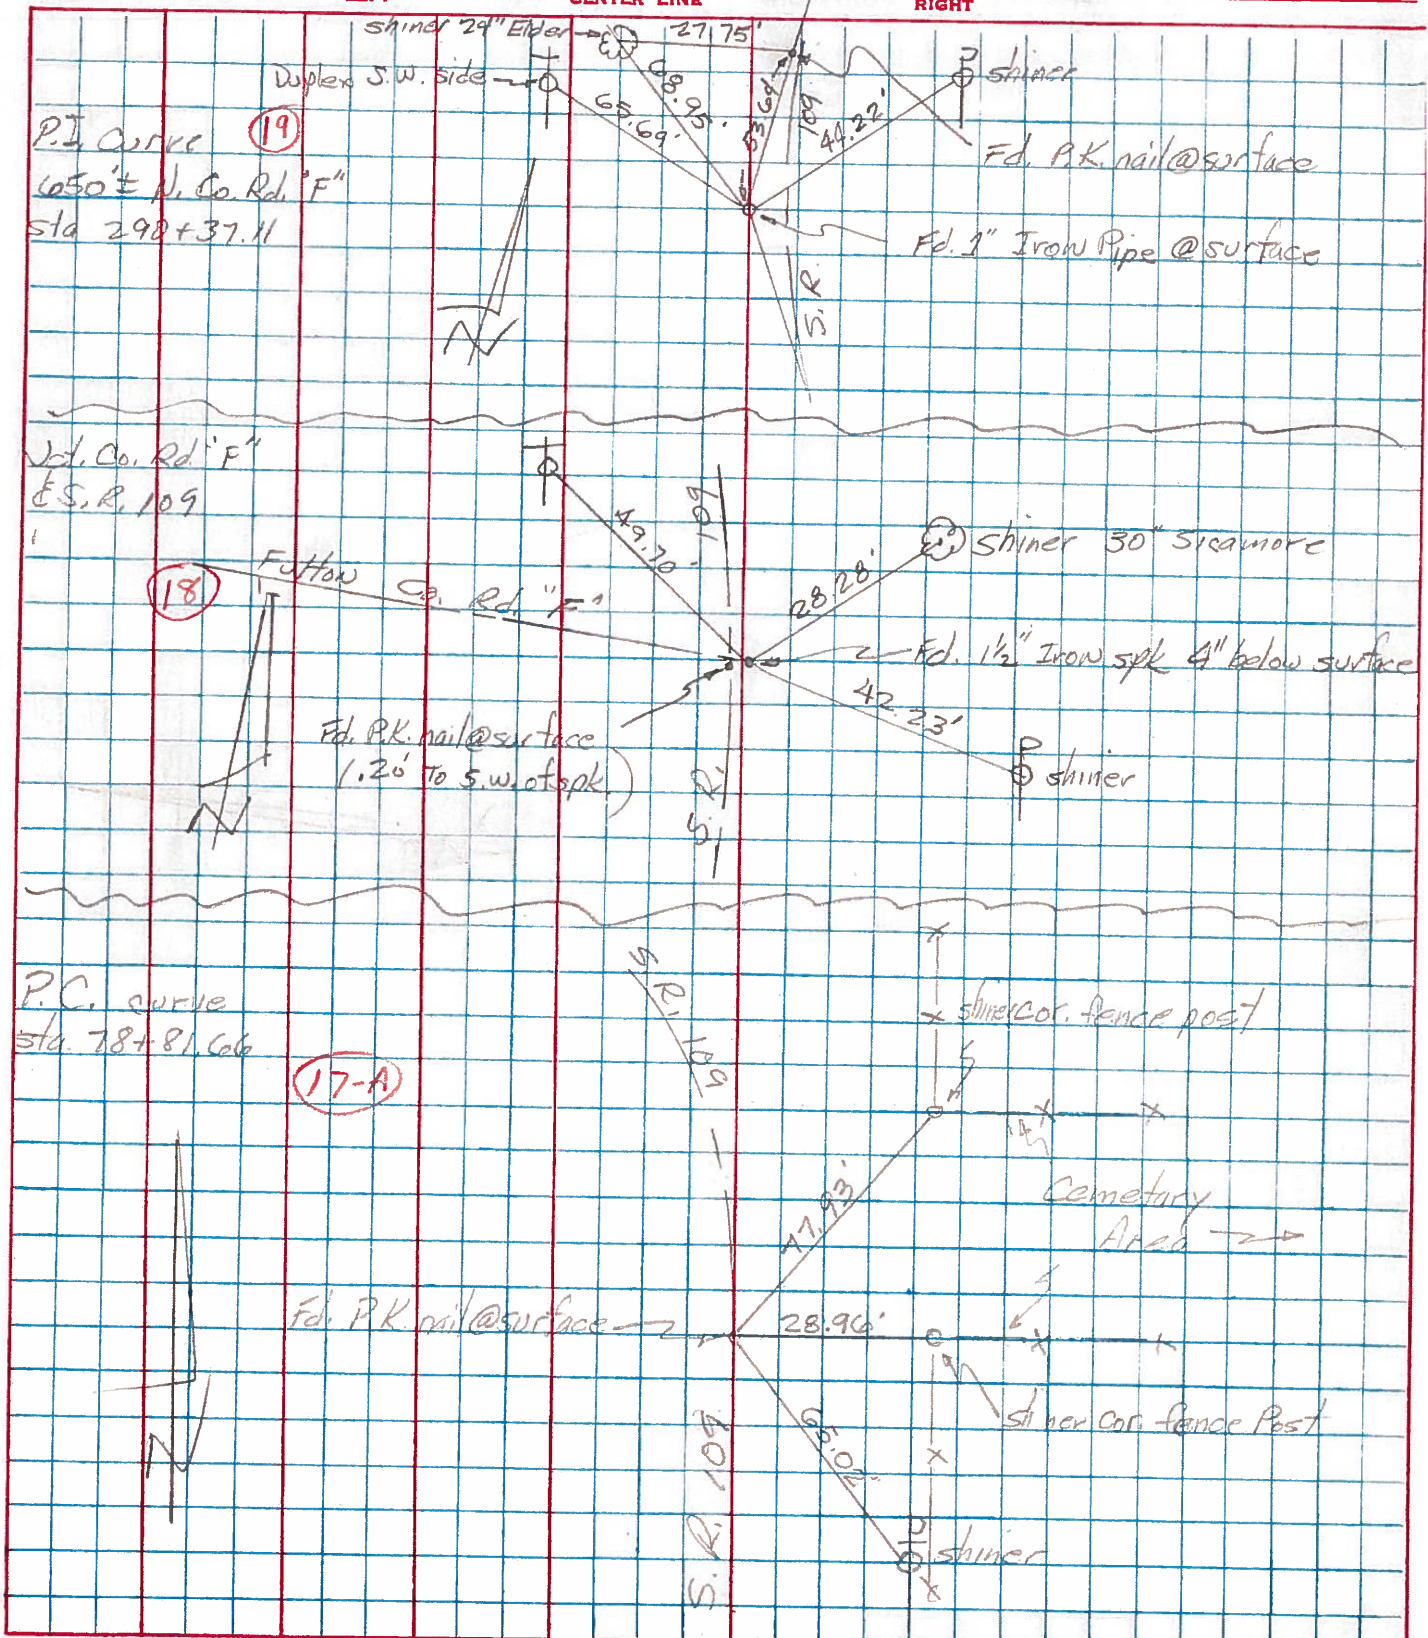

PERSONNEL	TITLE	PERSONNEL	TITLE	COUNTY	DATE
Red Beach				FULTON	Sept 1970
Newcomb				S. R. 109	WEATHER
Knape				SEC. 13 York Twp Delta	TEMP.
Wise					

DESCRIPTION **CONTROL POINTS** JOB NO.

