



O.D.O.T. DISTRICT 2 SURVEY OFFICE (USE ONLY)

PERSONNEL	REFERENCE NO.	19 B	SHEET	29	OF	31
NOTES	RHOADES	DATE	12-15-17	ROUTE	SR 109	
H.C.	O'DONNELL	WEATHER	CLOUDY	COUNTY	FULTON	
R.C.	FARKAS	TEMP.	24°	TOWNSHIP	YORK	
				SECTION	13	
				T	7	N
				R	7	E

TYPE MONUMENT MAG/WASHER
 ON SURFACE - ~~BELOW~~ ON
~~LEFT~~ - Q PAV'T - ~~RIGHT~~ YES
10.4' TO RT EDGE PAVEMENT
 S.L.M. 303.76.97
 GRID: NORTHING: 695250.4199 EASTING: 1556853.2287

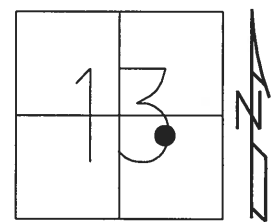

RECORD: Q CONST T.S.
 STA. 292+32.45
 SEE PLAN
 FUL-109-5.40 (1978)
 SHOT CENTER OF BOX
 REFB19 NEED TO RAISE
 BOX 4"± DOWN
 12-23-15, JFO
 DNF MONBOX
 12-1-17, JMR
 SET MAG/WASHER
 NEWREFB19
 12-15-17, JFO

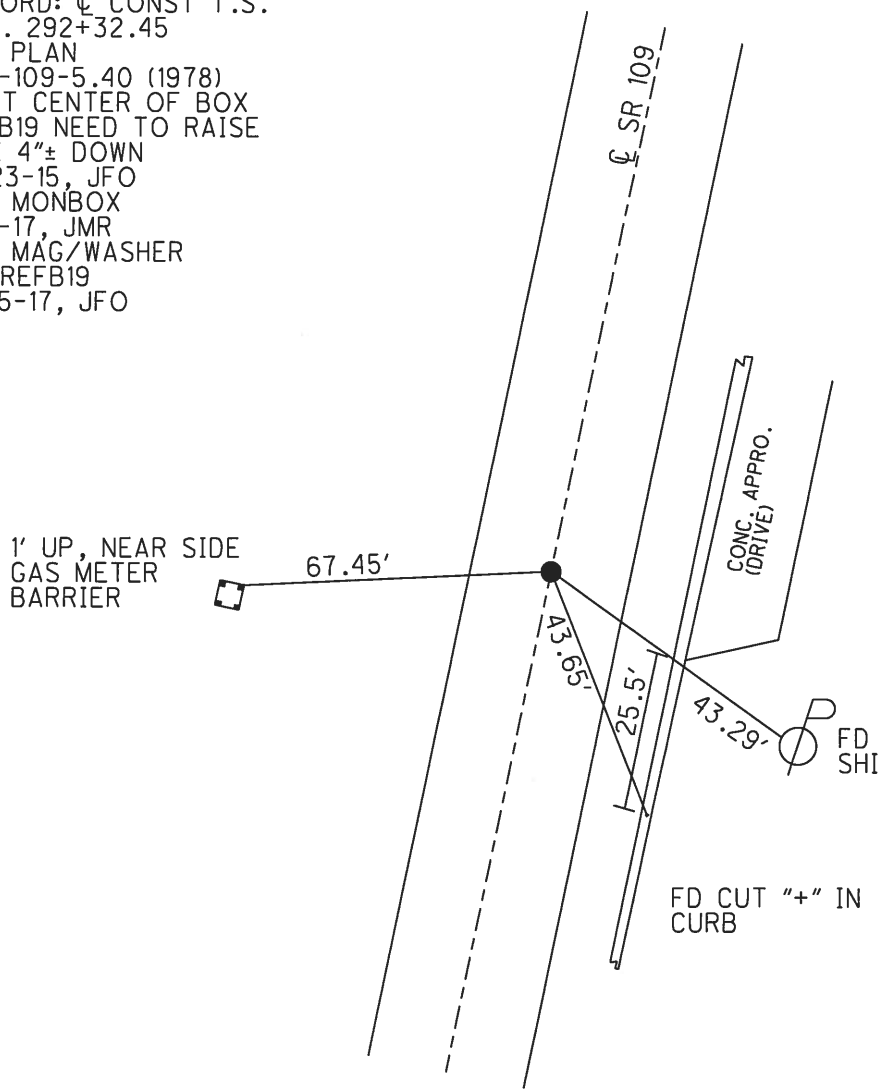

O.D.O.T. DISTRICT 2 SURVEY OFFICE

PERSONNEL _____

REFERENCE NO. 19-B
after 1978

SHEET 14 OF 15

NOTES BARNHISEL

H.C. MOSEY

R.C. CANTERBURY

DATE 7-9-01

WEATHER SUNNY

TEMP. +85°

ROUTE 109

COUNTY FULTON

TOWNSHIP YORK

SECTION 13

T 7 N R 7 E


TYPE MONUMENT I. Rod in CONC. Mon.

ON SURFACE - ~~BELOW~~ yes


~~LEFT - C~~ PAV'T. - ~~RIGHT~~ yes

10.4' TO RT EDGE PAVEMENT

S.L.M. 303+60

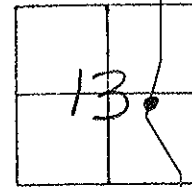

Records:
& const.
S.T. 303+88.45
See PLAN!
FD-109-540 (1978)

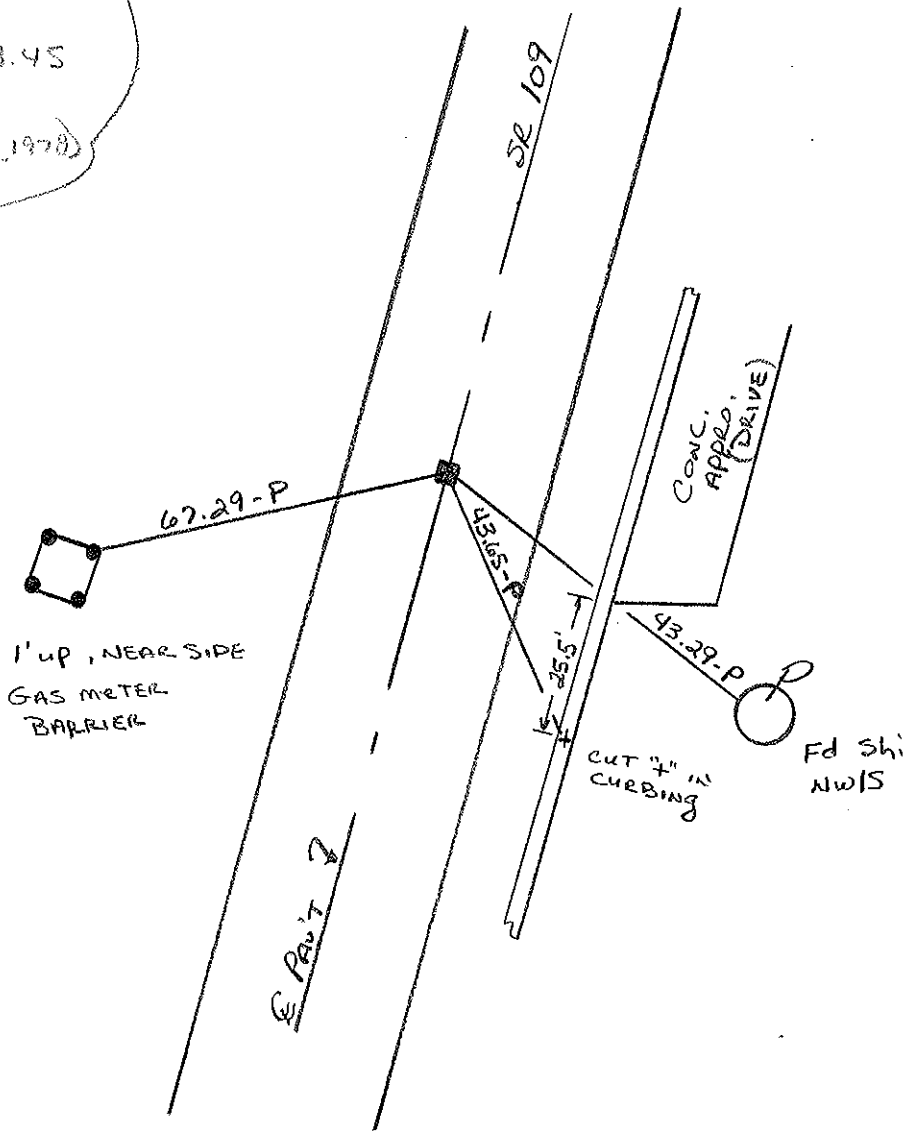

O.D.O.T. DISTRICT 2 SURVEY OFFICE

PERSONNEL

REFERENCE NO. 19-B

SHEET 25 OF 27

NOTES CORDES

H.C. VAN DUSEN

DATE 8-15-94

ROUTE 109

R.C. BARNHISEL

WEATHER SUNNY

COUNTY FULTON

SLOVAK P

TEMP. +65° F

TOWNSHIP YORK

SECTION 13

T 7 N R 7 E


TYPE MONUMENT MON. BOX

ON SURFACE - ~~BELOW~~ YES


~~LEFT -~~ PAV'T. - RIGHT YES

11.9' TO LT EDGE PAVEMENT

S.L.M. 303 + 60

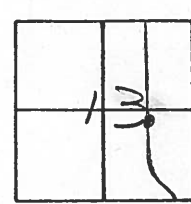

MON. BOX RAISED WITH
CONSTRUCTION
10-14-94
SCH

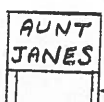

SET SHI.
E./S.

62.20'

SET
LATH

21.00'



S.R. 109

☐ PAV'T







43.40'



FD. SHI.
NW./S.

PERSONNEL	TITLE	PERSONNEL	TITLE	COUNTY	DATE
Red Beach				FULTON	Sept 1970
Newcomb				S. R. 109	WEATHER
Knape				SEC. 13 York Twp Delta	TEMP.
Wise					

DESCRIPTION **CONTROL POINTS** JOB NO.

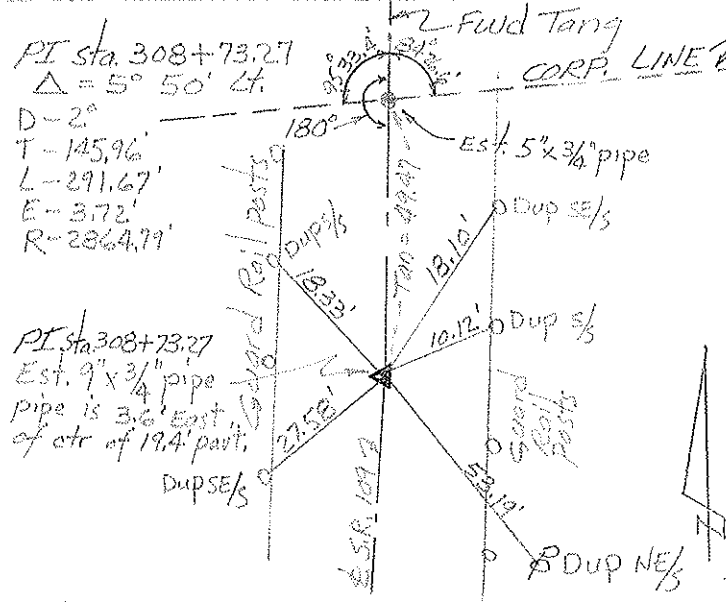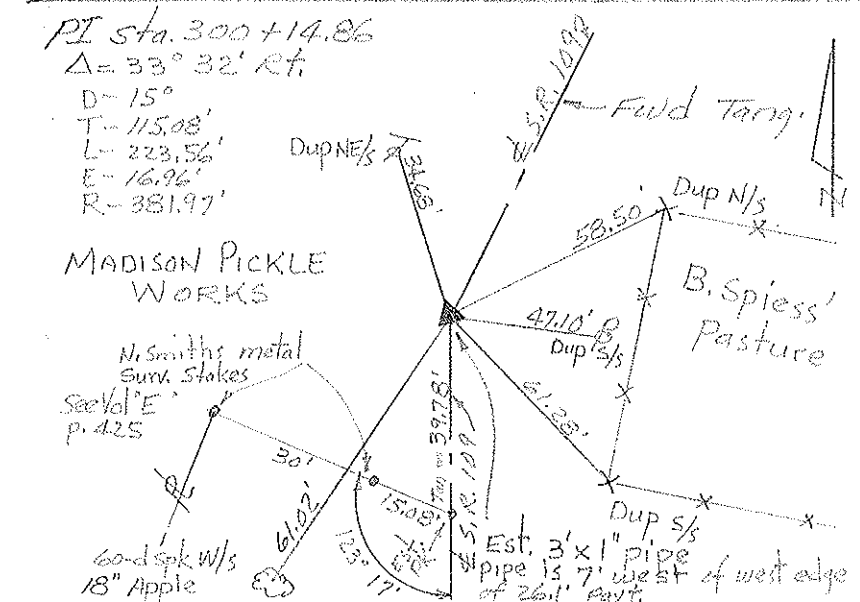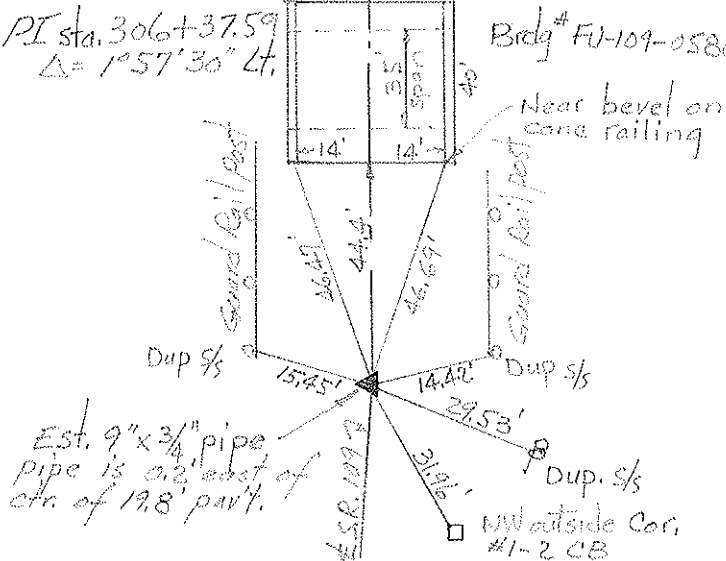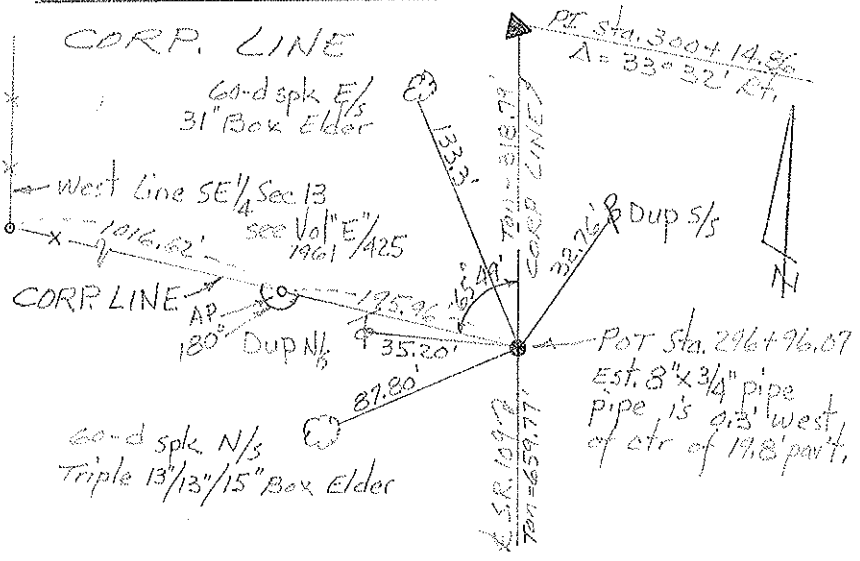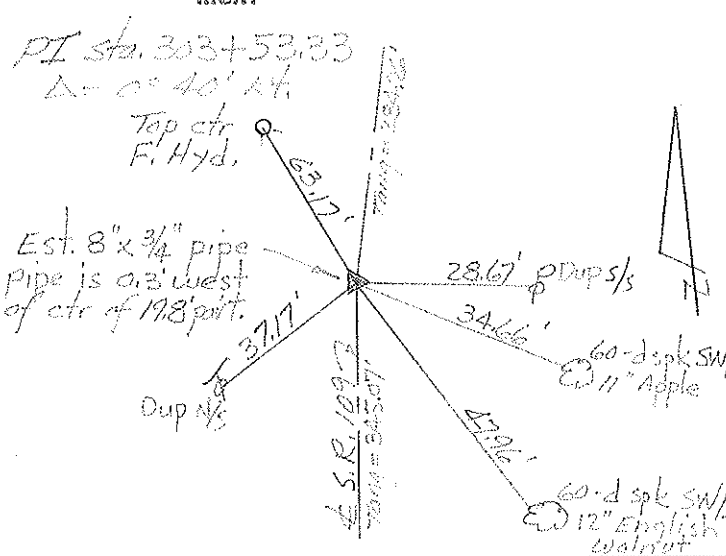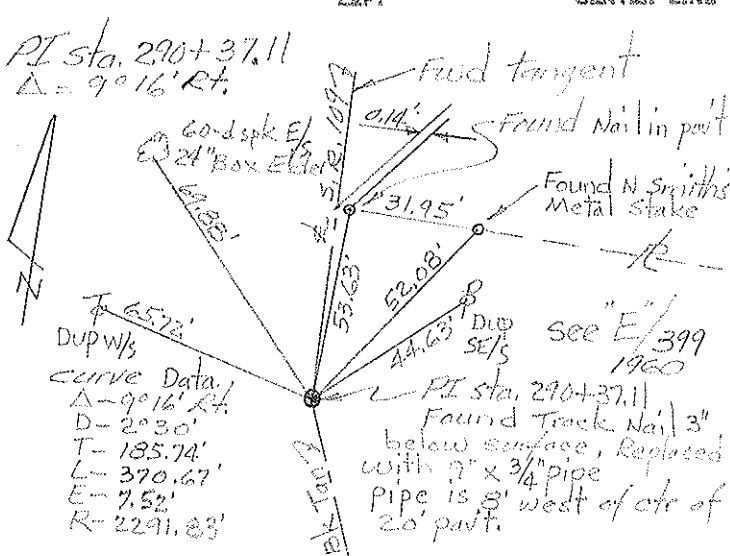

PERSONNEL TITLE PERSONNEL TITLE COUNTY FULTON DATE Sept. 1970
Red Beach _____
Newcomb _____
Knapa _____
Wise _____
 S. R. 109 WEATHER _____
 SEC. SE 1/4 Sec. 13, YORK TWP TEMP _____

DESCRIPTION ALIGNMENT & CONTROLS JOB NO. _____

