

O.D.O.T. DISTRICT 2 SURVEY OFFICE (USE ONLY)

PERSONNEL _____

REFERENCE NO. 20 A

SHEET 31 OF 35

NOTES NIESE

DATE 4-23-21

ROUTE SR 109

H.C. AUBLE

WEATHER CLOUDY

COUNTY FULTON

R.C. NIESE

TEMP. 41°

TOWNSHIP YORK

DWG BY AUBLE PID 101295

SECTION 13

T 7 N R 7 E

TYPE MONUMENT MAG/WASHER

ON SURFACE - ~~BELOW~~ ON

OFFSET CL PAVEMENT 7.2' ~~±~~ : RT

3.8' TO RT EDGE PAVEMENT


STATION: 308+74.45

HORZ.DATUM: NAD83(2011)


GEOID: 12A

GRID: NORTHING: 695736.367

EASTING: 1556955.292

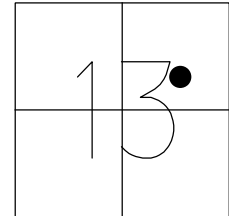

RECORD: REC.P.I.
FD MAG/WASHER
REFA20
1-9-20, JLL
SET MAG/WASHER
10-7-21, DSA

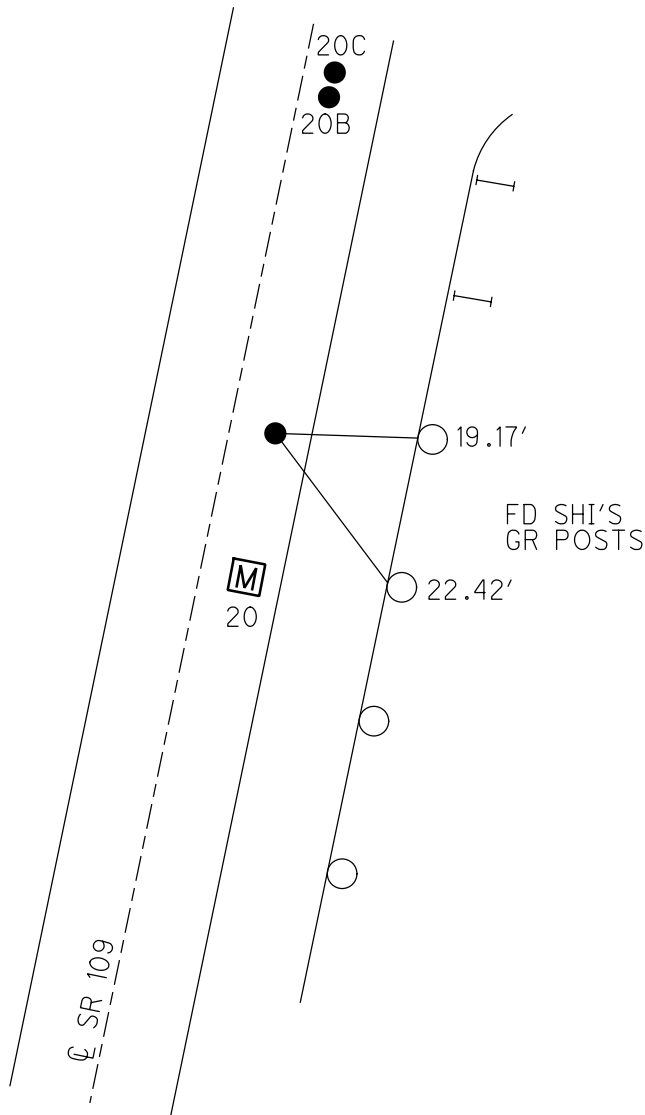

DIST:
20-20A= 16.17'
20-20B= 65.22'
20-20C= 65.62'