

O.D.O.T. DISTRICT 2 SURVEY OFFICE (USE ONLY)

PERSONNEL

REFERENCE NO. 20 B

SHEET 32 OF 35

NOTES NIESE

DATE 4-23-21

ROUTE SR 109

H.C. AUBLE

WEATHER CLOUDY

COUNTY FULTON

R.C. NIESE

TEMP. 41°

TOWNSHIP YORK

SECTION 13

DWG BY AUBLE

PID 101295

T 7 N R 7 E

TYPE MONUMENT MAG NAIL

ON SURFACE - ~~BELOW~~ ON

OFFSET CL PAVEMENT 4.6' ~~LT~~ : RT

6.4' TO RT EDGE PAVEMENT


STATION: 309+23.5

HORZ. DATUM: NAD83(2011)


GEOID: 12A

GRID: NORTHING: 695785.266

EASTING: 1556959.499

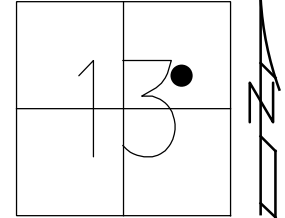

RECORD:
ORIGIN UNKNOWN
FD MAG NAIL
REFB20
1-9-20, JLL
SET MAG NAIL
10-7-21, DSA

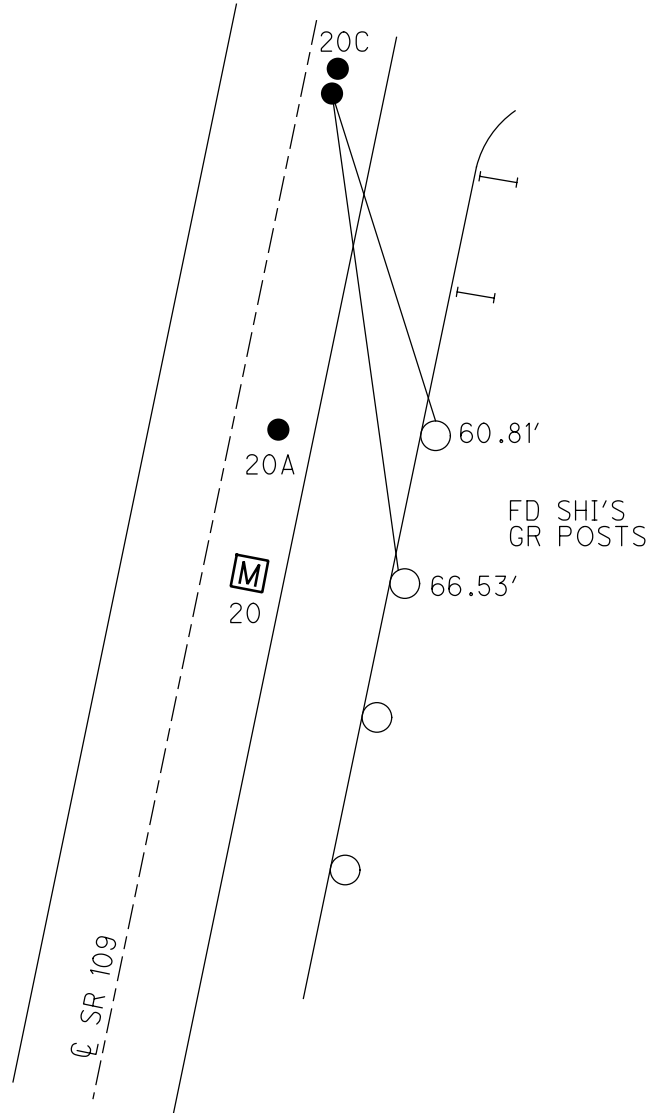

DIST:
20-20A= 16.17'
20-20B= 65.22'
20-20C= 65.62'