


O.D.O.T. DISTRICT 2 SURVEY OFFICE (USE ONLY)


PERSONNEL _____ REFERENCE NO. 20 C SHEET 33 OF 35
 NOTES NIESE DATE 4-23-21 ROUTE SR 109
 H.C. AUBLE WEATHER CLOUDY COUNTY FULTON
 R.C. NIESE TEMP. 41° TOWNSHIP YORK
 DWG BY AUBLE PID 101295 SECTION 13
 T 7 N R 7 E

TYPE MONUMENT MAG/WASHER
 ON SURFACE - ~~BELOW~~ ON _____
 OFFSET CL PAVEMENT 4.6' ~~±~~ : RT
6.4' TO RT EDGE PAVEMENT
 STATION: 309+23.9

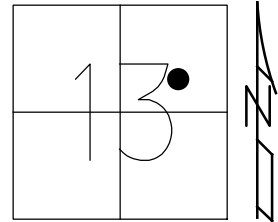

HORZ. DATUM: NAD83(2011) GEOID: 12A
 GRID: NORTHING: 695785.651 EASTING: 1556959.526

RECORD:
 DELTA CORPLINE
 STA. 309+07.26
 FD MAG/WASHER
 REFC20
 1-9-20, JLL
 SET MAG/WASHER
 10-7-21, DSA

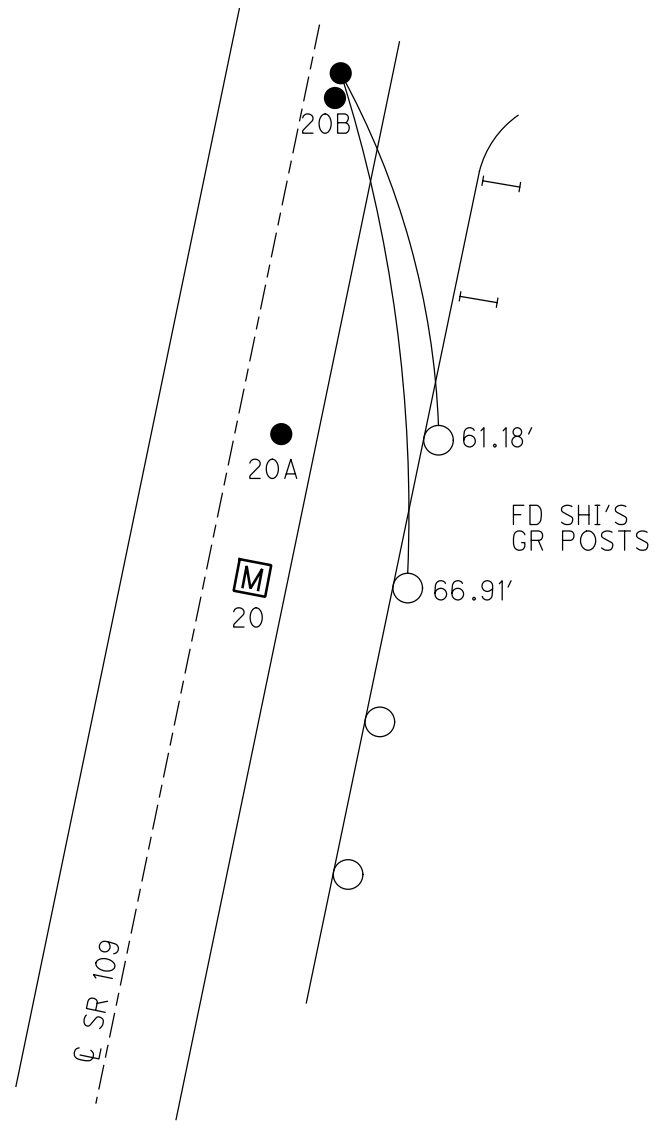

DIST:
 20-20A = 16.17'
 20-20B = 65.22'
 20-20C = 65.62'