


PERSONNEL	TITLE	PERSONNEL	TITLE	COUNTY	DATE	WEATHER	TEMP
Tomsic		Boyle		Fulton	July 16, 1973		
Neuser				S. R. 109			
Granata							
Lawyo							

DESCRIPTION _____ LEFT _____ CENTER LINE _____ RIGHT _____ JOB NO. _____

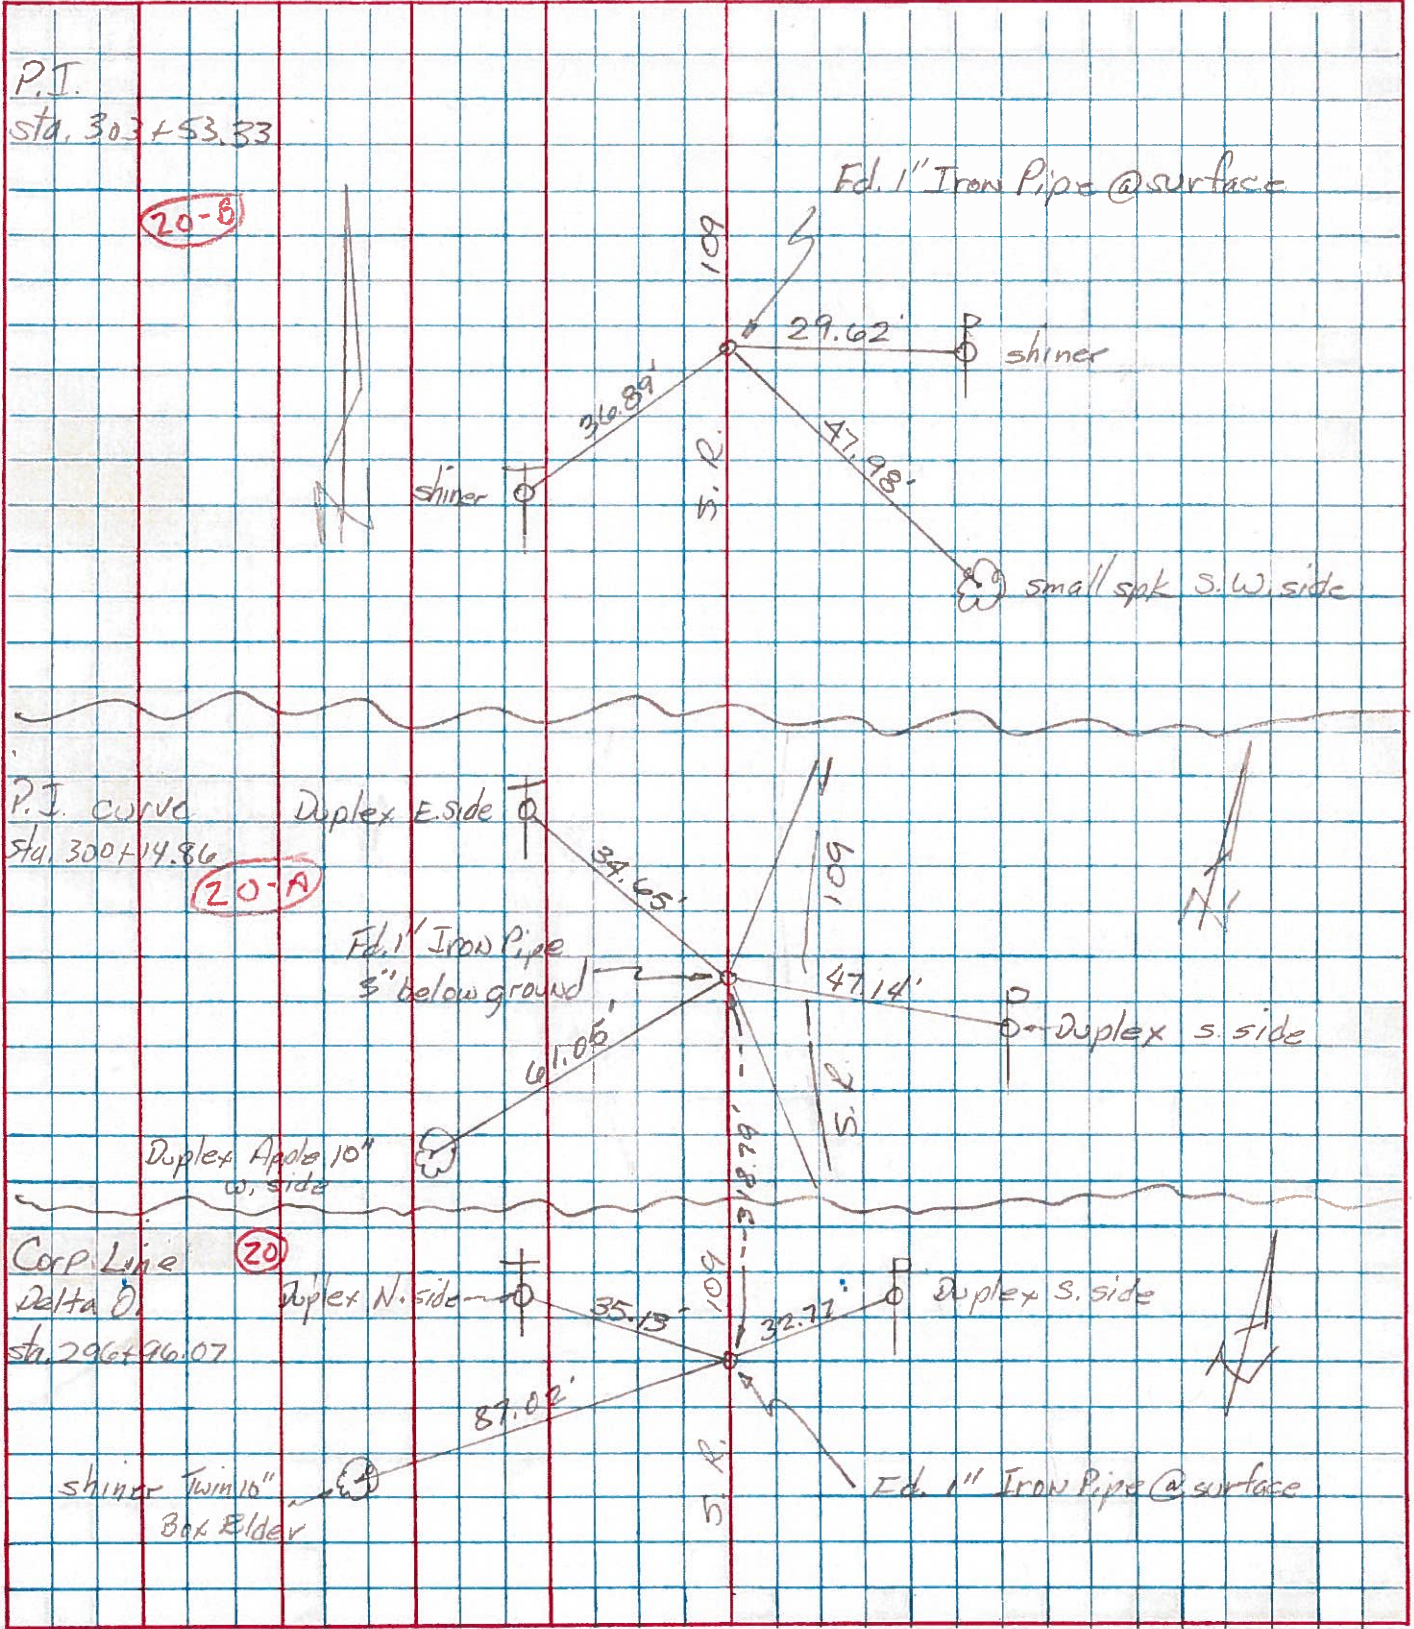

PERSONNEL TITLE PERSONNEL TITLE COUNTY Fulton DATE Sept. 1970
Red Beach
Newcomb S. R. 109 WEATHER _____
Knape
Wise SEC. NE 1/4 Sec. 13 DELTA TWP. _____

DESCRIPTION ALIGNMENT & CONTROLS YORK TWP. JOB NO. _____

