

O.D.O.T. DISTRICT 2 SURVEY OFFICE (USE ONLY)

PERSONNEL _____ REFERENCE NO. 21 SHEET 34 OF 35
 NOTES NIESE DATE 4-23-21 ROUTE SR 109
 H.C. AUBLE WEATHER CLOUDY COUNTY FULTON
 R.C. NIESE TEMP. 41° TOWNSHIP YORK
 DWG BY AUBLE PID 101295 SECTION 13
 T 7 N R 7 E

TYPE MONUMENT MAG/WASHER


ON SURFACE - ~~BELOW~~ ON

OFFSET Q PAVEMENT 2.4' ~~LT~~ : RT
12.9' TO RT EDGE PAVEMENT


STATION: 321+48

HORZ. DATUM: NAD83(2011) GEOID: 12A

GRID: NORTHING: 697019.909 EASTING: 1557066.589

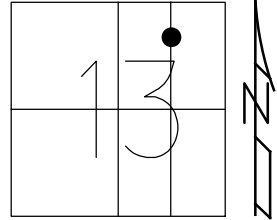

RECORD: P.I.
 FD 1/2" PIPE
 5-25-82, IRS
 8-18-94, MB
 SET P.K./WASHER
 10-14-94, SH
 SET MAG/WASHER
 8-24-09, DH
 FD MAG/WASHER
 REF21
 12-18-15, JFO
 FD MAG/WASHER
 REF21
 1-9-20, JLL
 4-23-21, DSA
 SET MAG/WASHER
 10-7-21, DSA

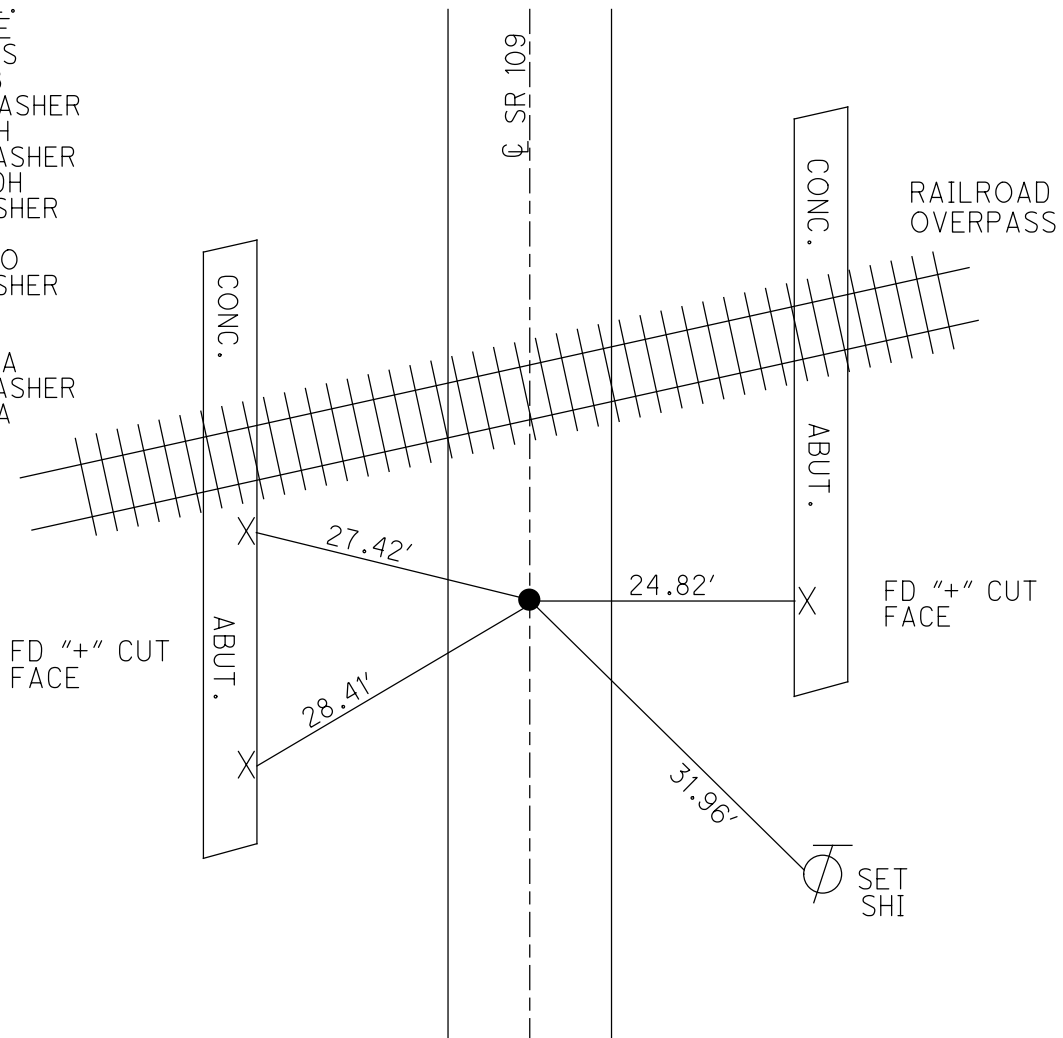


O.D.O.T. DISTRICT 2 SURVEY OFFICE (USE ONLY)

PERSONNEL _____ REFERENCE NO. 21 SHEET 31 OF 31


NOTES HOMAN _____ DATE 8/24/09 ROUTE SR 109
 H.C. HOMAN _____ WEATHER SUNNY COUNTY FULTON
 R.C. ROUSOS _____ TEMP. 75° TOWNSHIP YORK
 _____ SECTION 13
 _____ T 7 N R 7 E

TYPE MONUMENT _____ P.K./WASHER _____
 ON SURFACE - ~~BELOW~~ _____ ON _____
~~LEFT~~ - ☉ PAV'T - RIGHT 2.4'
12.9' TO RT EDGE CURB
 S.L.M. 321+48

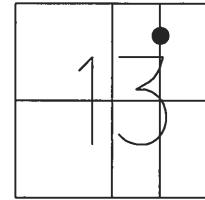

GRID: NORTHING: 697019.909 EASTING: 1557066.489


RECORD: P.I.
 FD. 1/2" PIPE
 05-25-82, IS
 FD. 1/2" PIPE
 08-18-94, MB
 SET P.K./WASHER
 10-14-94, SH
 SET MAG/WASHER
 08-24-09, DH
 FD MAG/WASHER
 10-29-15, JFO
 REF21
 12-18-15, JFO

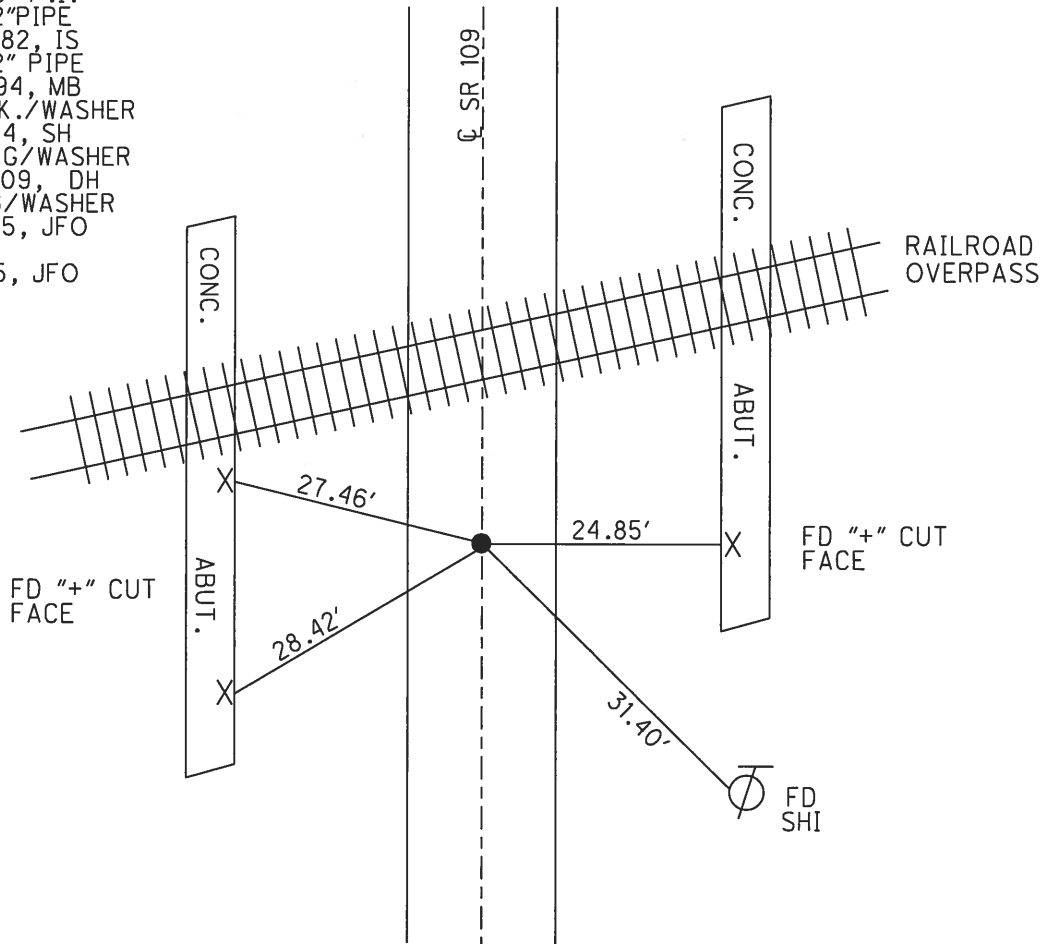

O.D.O.T. DISTRICT 2 SURVEY OFFICE (USE ONLY)


PERSONNEL _____ REFERENCE NO. 21 SHEET 1 OF 1
 NOTES HOMAN DATE 8-24-09 ROUTE SR 109
 H.C. HOMAN WEATHER SUNNY COUNTY FULTON
 R.C. ROUSOS TEMP. +75° TOWNSHIP YORK
 _____ SECTION 13
 _____ T 7 N R 7 E

TYPE MONUMENT _____ FD. PK/WASHER
 ON SURFACE - ~~BELOW~~ ON SURFACE
~~LEFT - C PAV'T~~ - RIGHT 2.4' RT.
12.9 TO RT EDGE CURB
 S.L.M. _____ PI 321+48

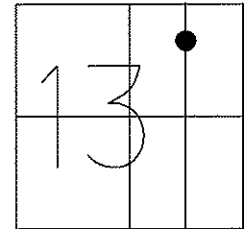

Grid: Northing: 697019.909 Easting: 1557066.489

- FD. 1/2" PIPE
- 05-25-82 IS
- FD. 1/2" PIPE
- 08-18-94 MB
- SET PK/WASHER
- 10-14-94 SH
- SET MAG/WASHER
- 08-24-09 DH

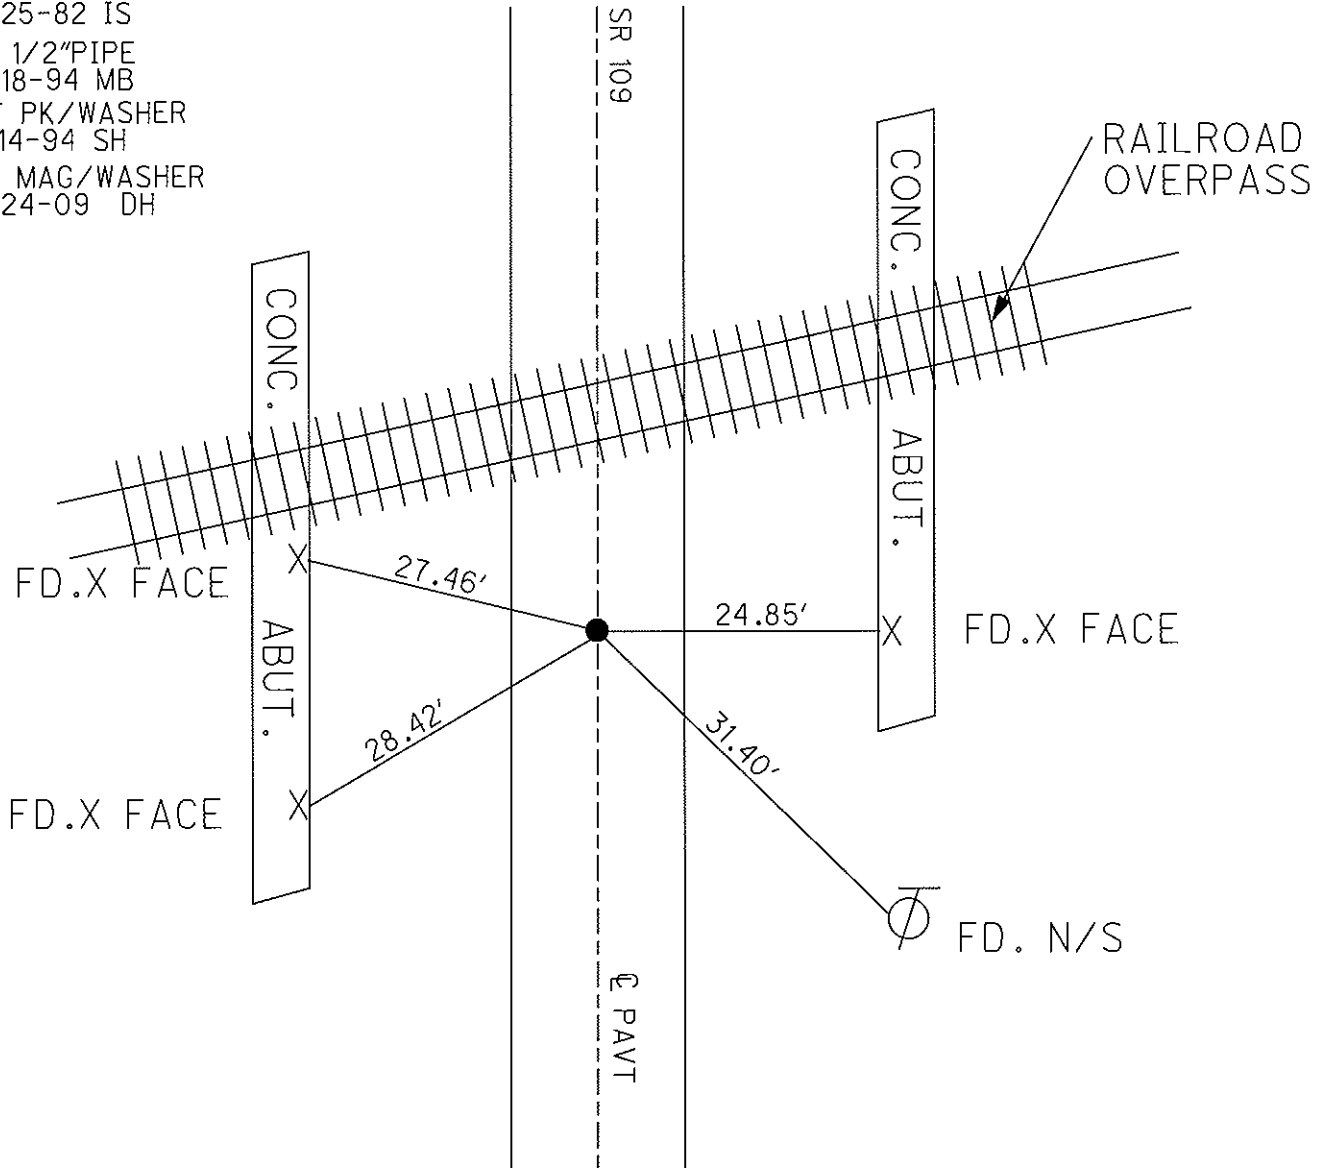

O.D.O.T. DISTRICT 2 SURVEY OFFICE

PERSONNEL

REFERENCE NO. 21

SHEET 27 OF 27

NOTES CORDES

H.C. VAN DUSEN

DATE 8-15-94

ROUTE 109

R.C. SLOVAK

WEATHER SUNNY

COUNTY Fulton

BARNHISEL P


TEMP. +65° F

TOWNSHIP Troy York

SECTION 13

T 7 N R 7 E

TYPE MONUMENT 1/2" IRON PIPE
ON SURFACE - BELOW 1" BELOW
LEFT - & PAV'T. - RIGHT 2.4'
12.2 TO RT. EDGE PAVEMENT (CURB)
S.L.M. 321+48

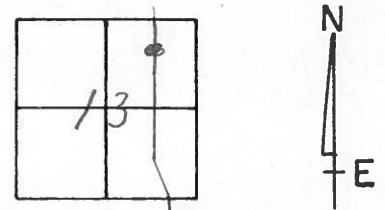


SET PK/WASHER
 10-14-94
 SCH

CONRAIL OVERPASS

SET 1/2" CUT IN
 FACE OF ABUTMENT

SET 1/2" CUT IN
 FACE OF ABUTMENT

SET 1/2" CUT IN
 FACE OF ABUTMENT

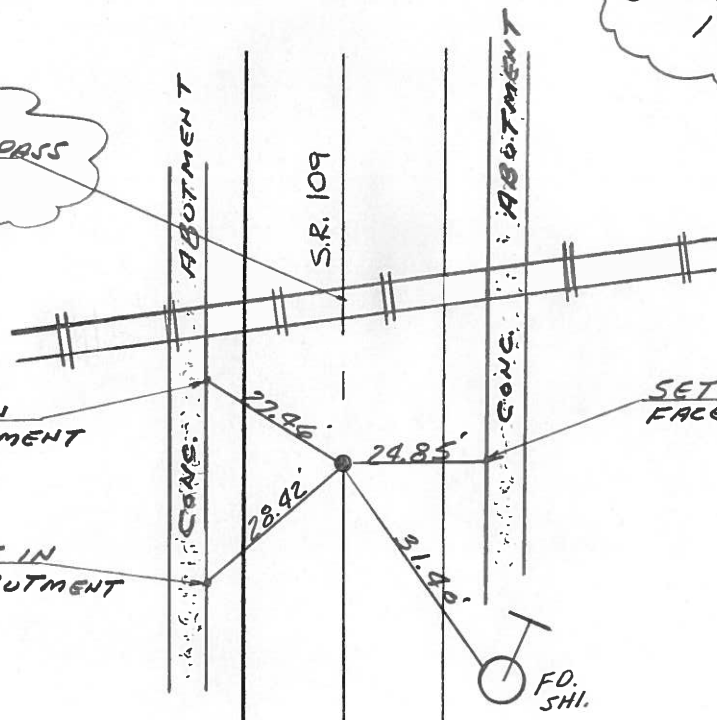

FD. 1/2" IRON PIPE
 @ SURFACE
 RI. SLM 320+91
 5-25-82
 I. STONE

ODOT. DISTRICT 2 SURVEY OFFICE

SHEET 12 OF

County Fulton S.R. 109

Date 25 May 82

Township Troy


Weather Cool

Section 13

Temp. 600

T N, R E

Personnel I. Stone

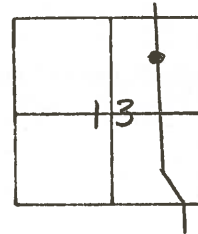


#21

P. Neuser

R. Michalak

D. Curtis

REF. NO. 21

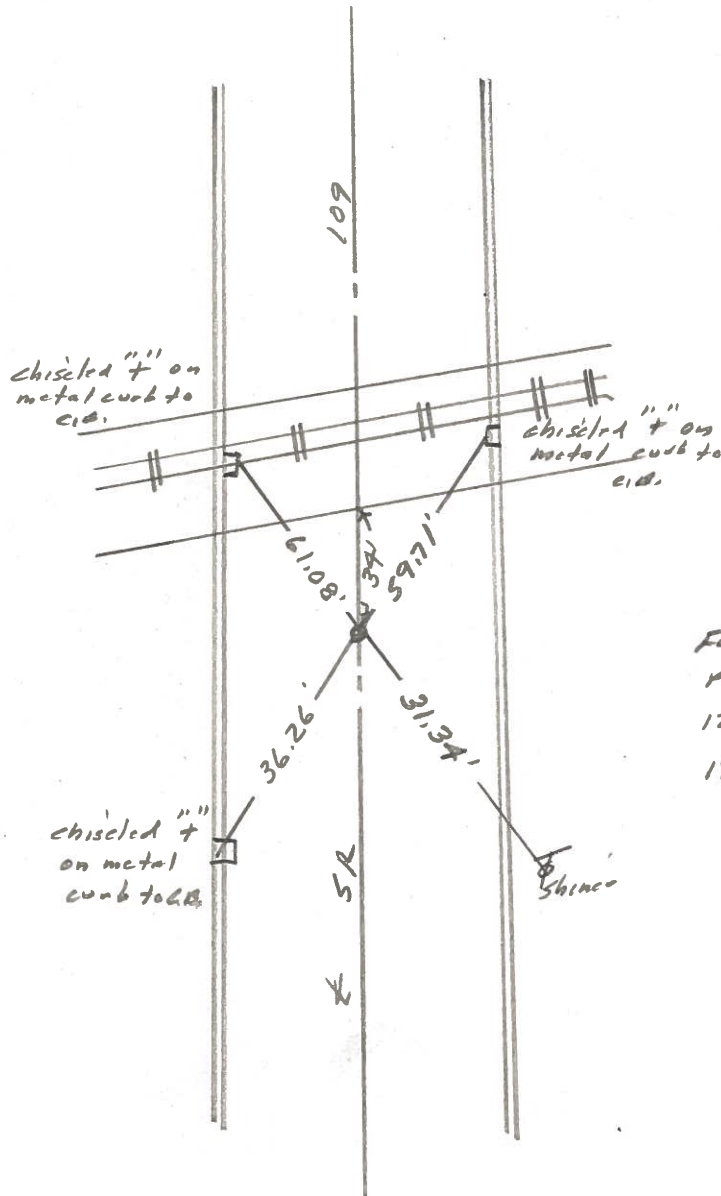

Ed. 1/2" I. Pipe To Surface
P.I. SLT Sta. 320+91
12.9' to E. edge put.
17.4' to W. edge put.


PERSONNEL	TITLE	PERSONNEL	TITLE
Tomsic			
Neuser			
Vango			
Boyle			

COUNTY FULTON DATE July-18-77

S. R. 109 WEATHER clear

SEC. DELTA TEMP. 75°

DESCRIPTION Mon. JOB NO. 024610

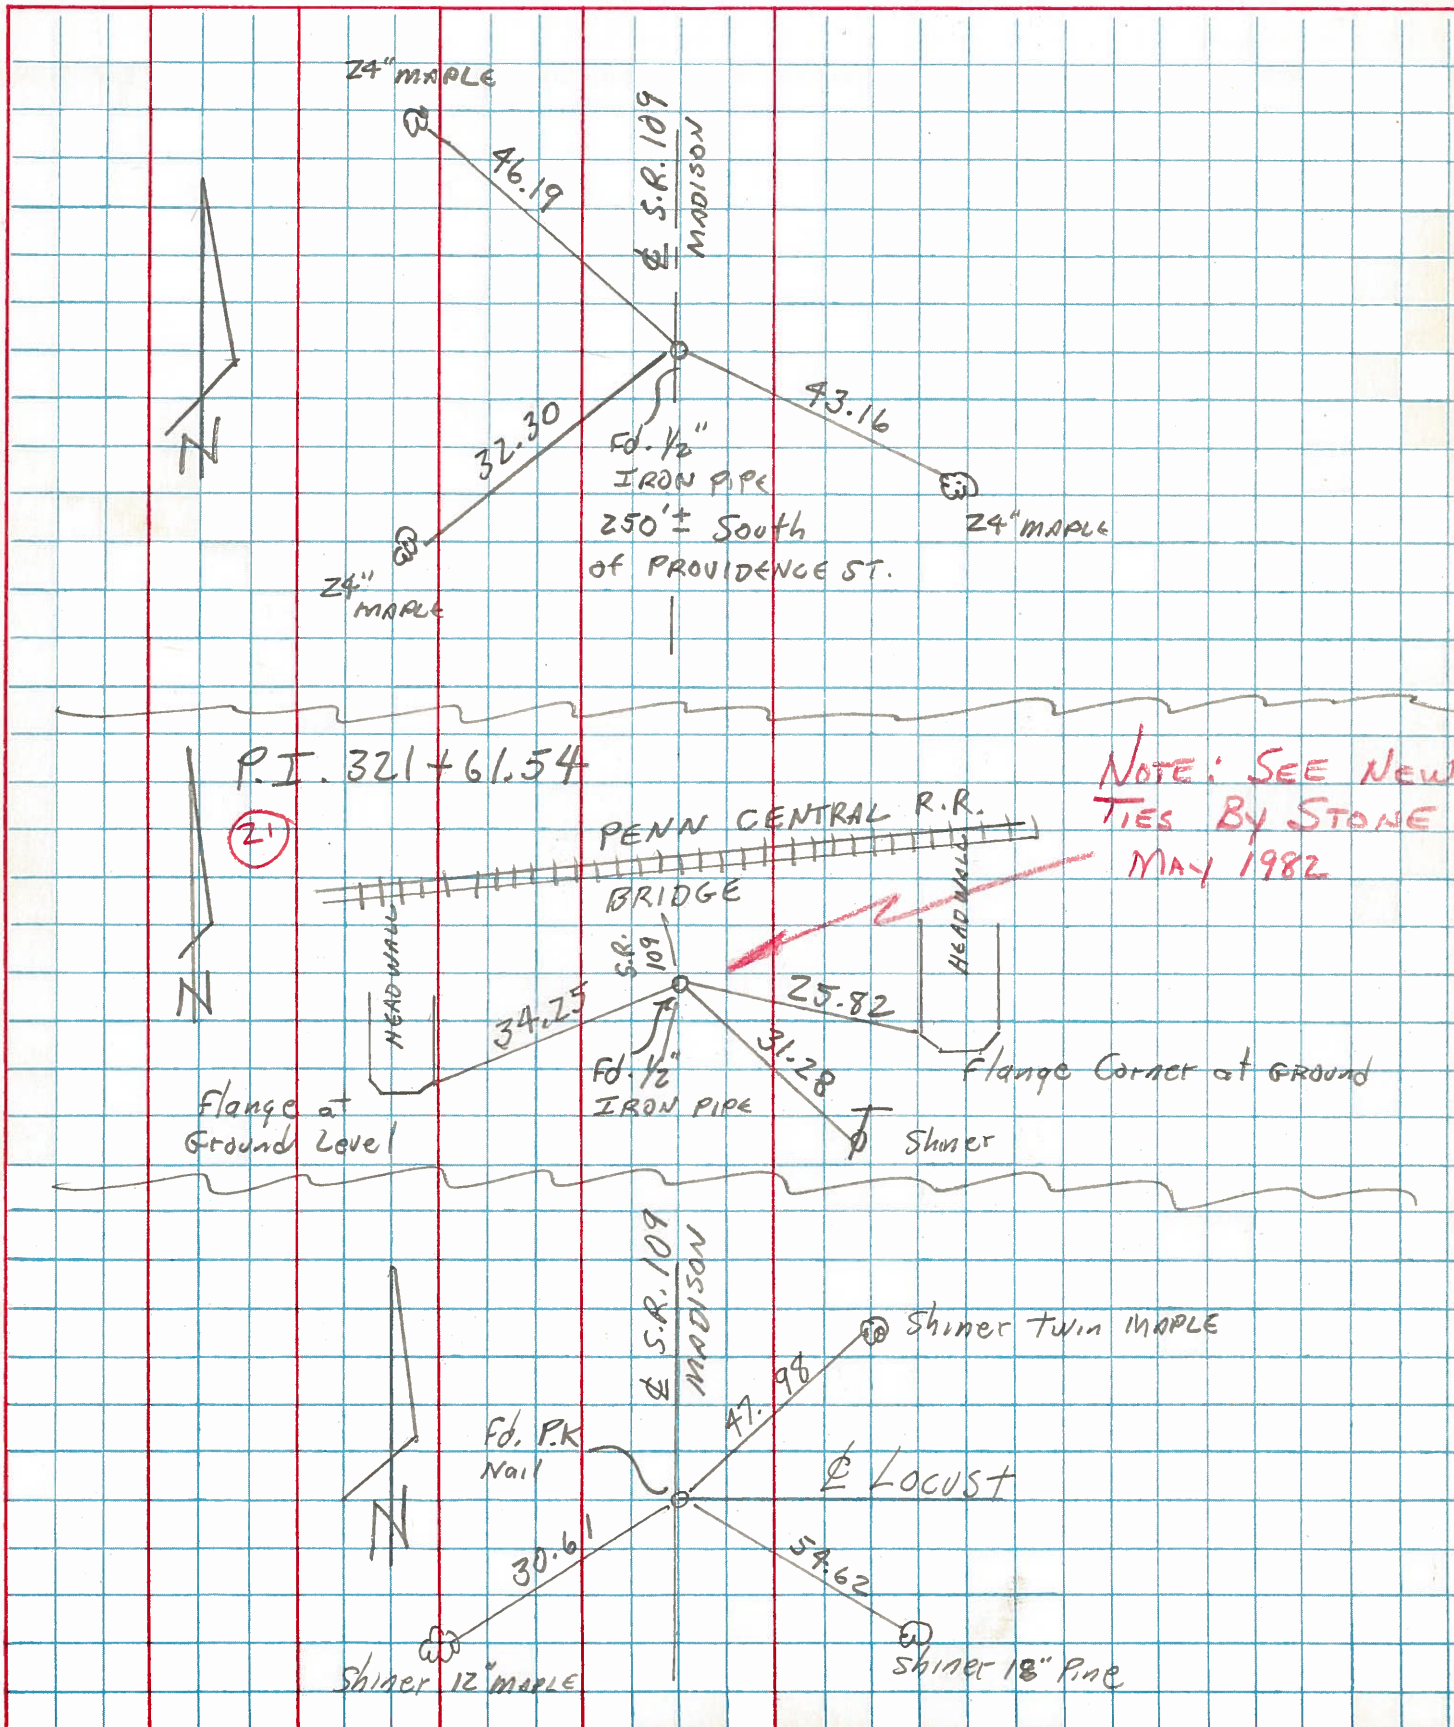





PERSONNEL	TITLE	PERSONNEL	TITLE
Red Beach			
Newcomb			
Knape			
Wise			

COUNTY Fulton DATE Sept 1970

S. R. 109 WEATHER _____


SEC. 13, Delta TEMP. _____

DESCRIPTION CONTROL POINTS JOB NO. _____

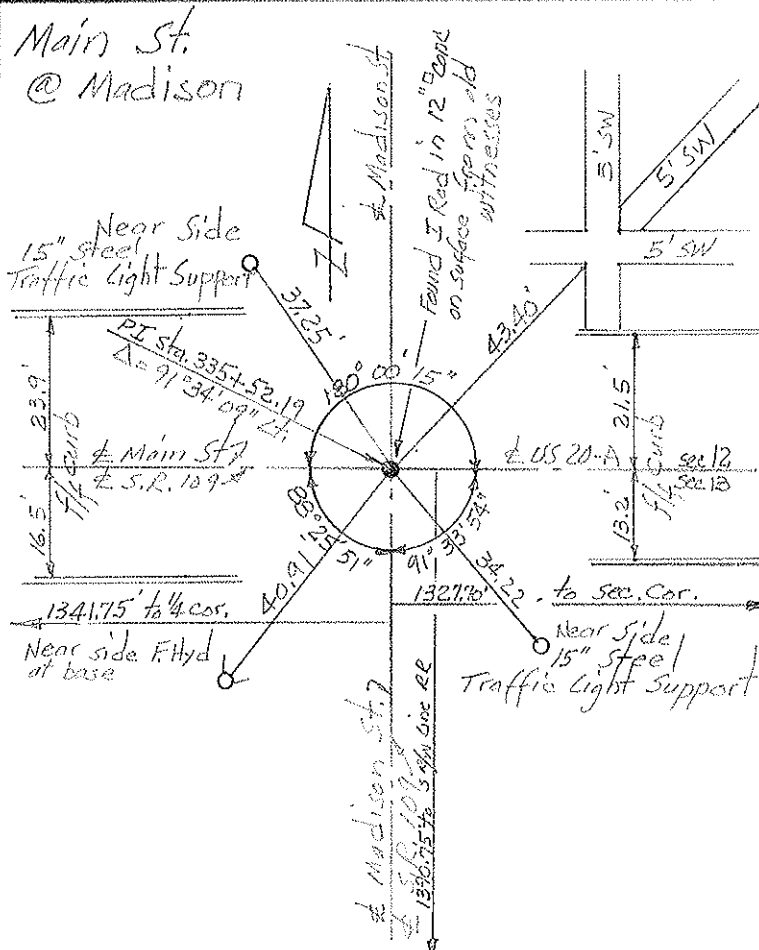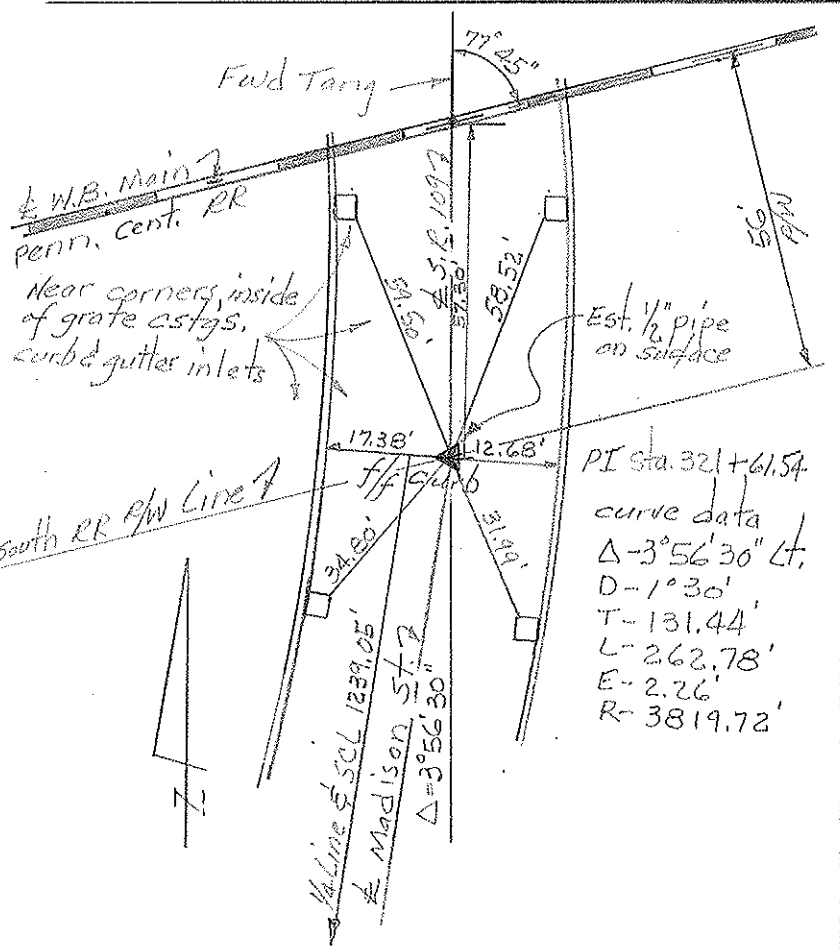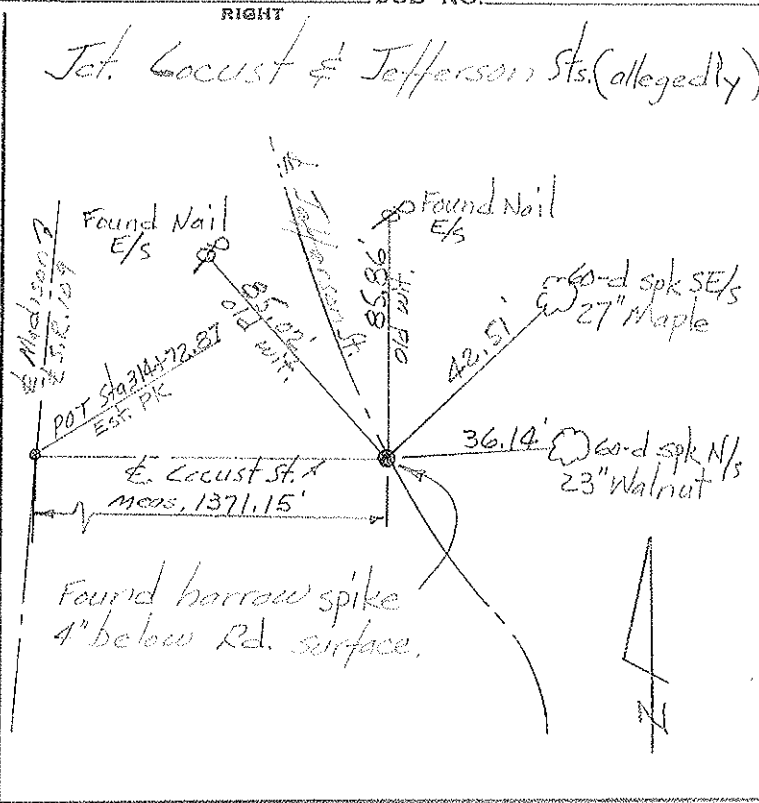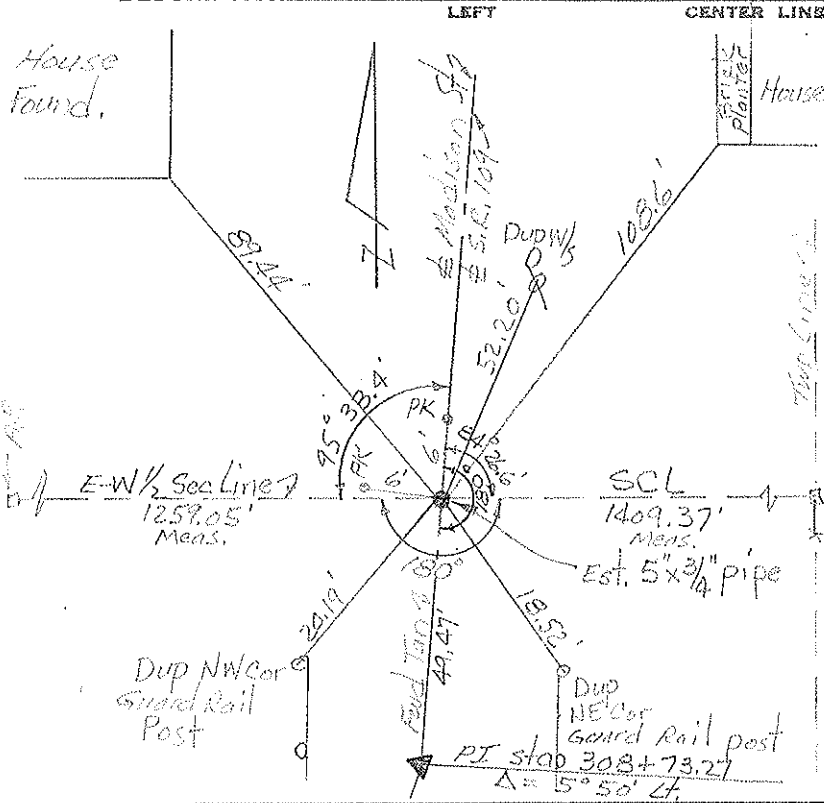

PERSONNEL TITLE PERSONNEL TITLE COUNTY Fulton DATE Sept. 1970
Red Beach _____
Newcomb _____
Knape _____
Wise _____
 S. R. 109 WEATHER _____
 SEC. NE 1/4 Sec. 13 DELTA TWP. _____
YORK TWP.

DESCRIPTION ALIGNMENT & CONTROLS JOB NO. _____

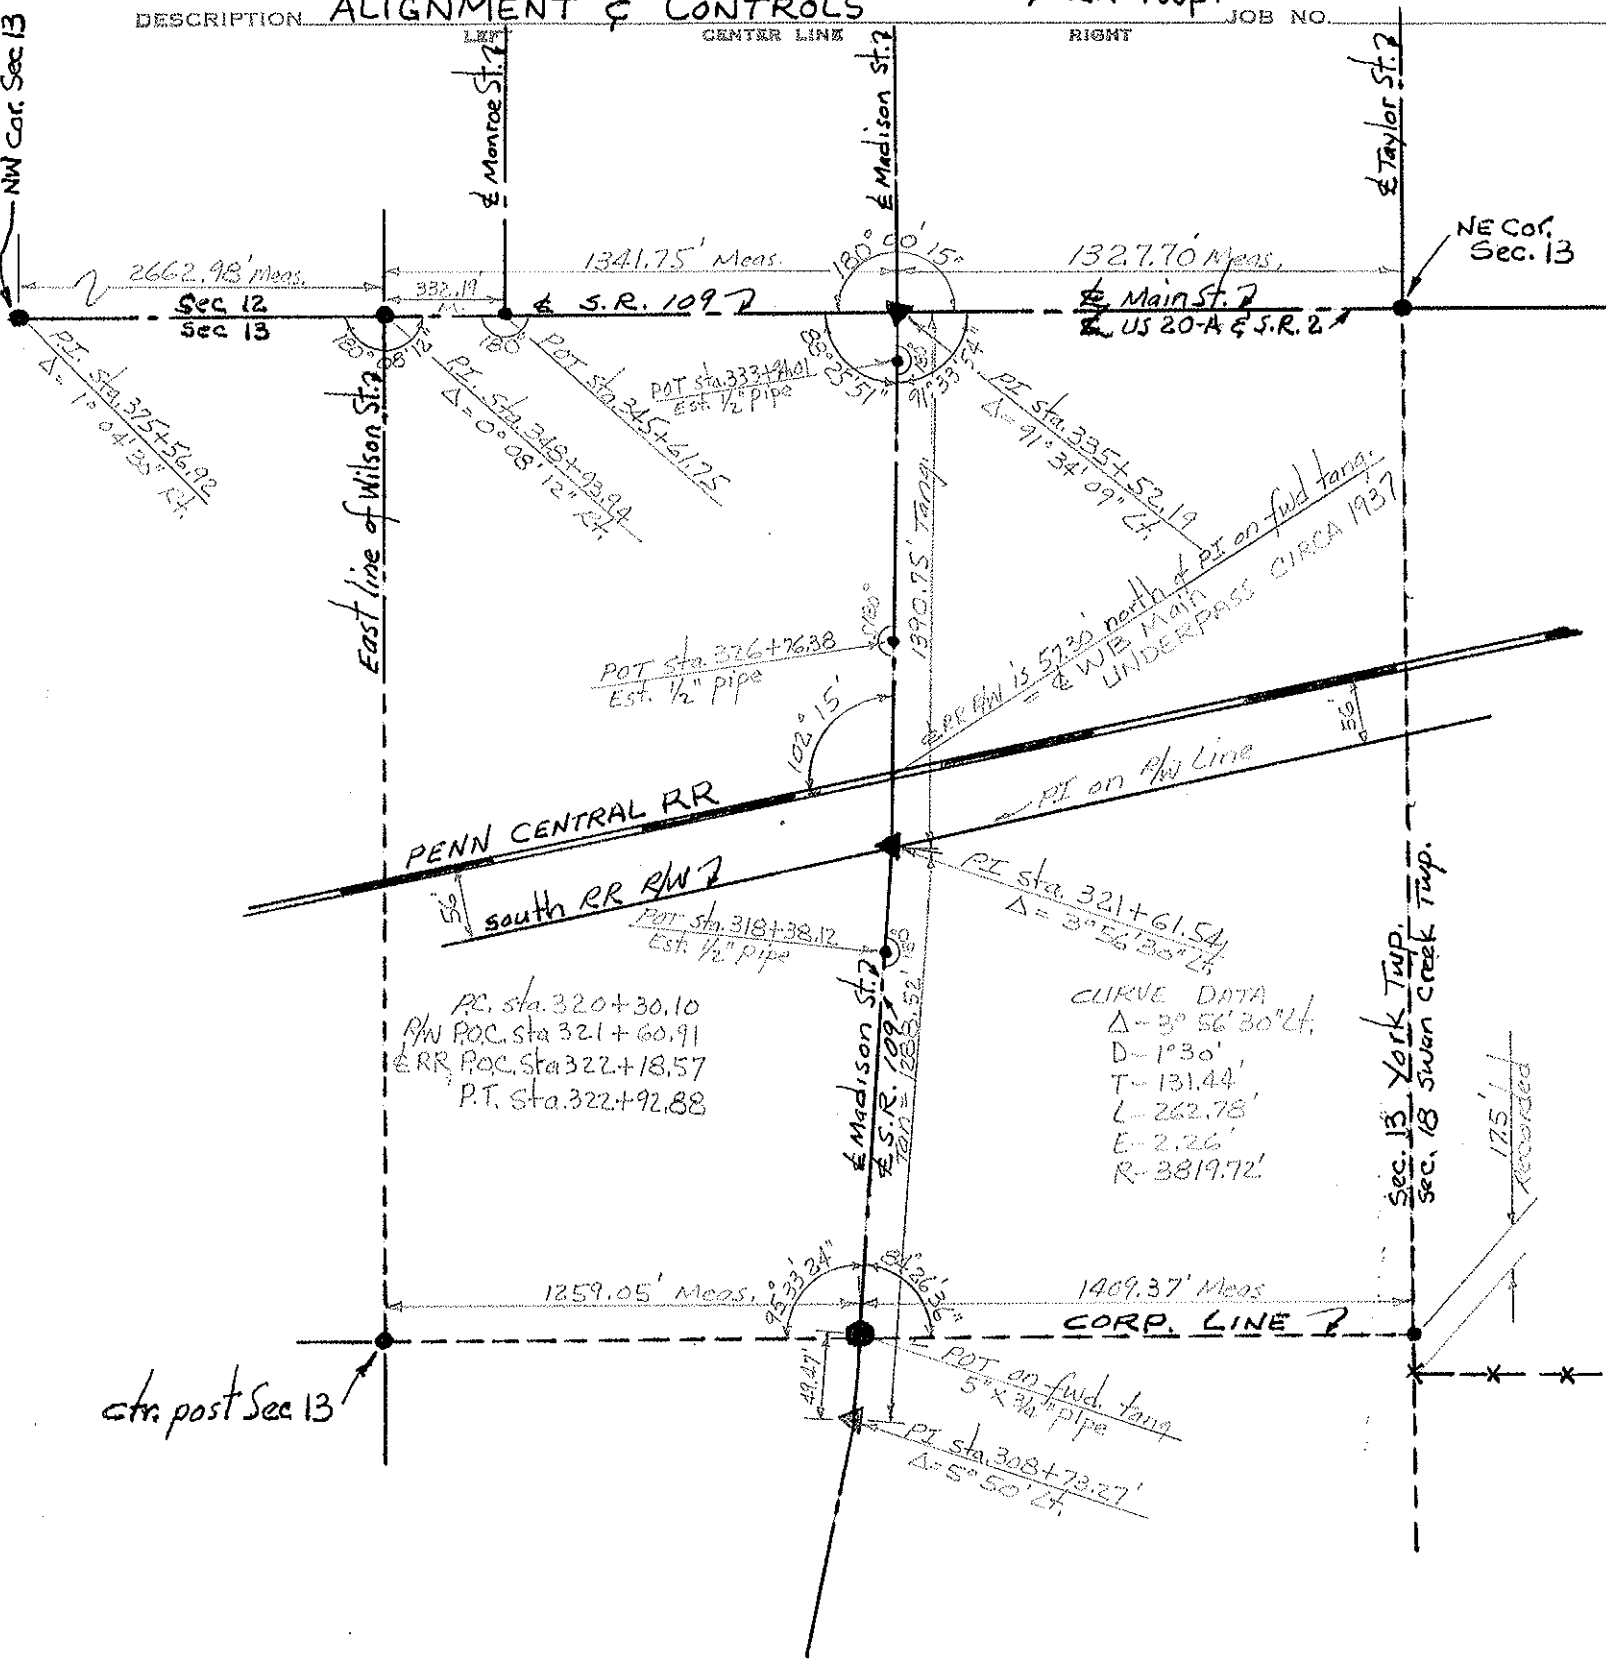

RC. sta. 320+30.10
 R/W POC. sta 321+60.91
 RR POC. sta 322+18.57
 P.T. sta. 322+92.88

CURVE DATA
 Δ=3°56'30" Lt.
 D=1°30'
 T=131.44'
 L=262.78'
 E=2.26'
 R=3819.72'

Sec. 13 York Twp.
 Sec. 18 Swan Creek Twp.

175'
 recorded