


PERSONNEL	TITLE	PERSONNEL	TITLE	COUNTY	DATE	WEATHER	TEMP.
Tomsic				FULTON	July 18-73	clear	78°
Nouser				S. R. 109			
Granata				SEC. DELTA			
Yanyo		Boyle					
DESCRIPTION: MAN					JOB NO. 024610		

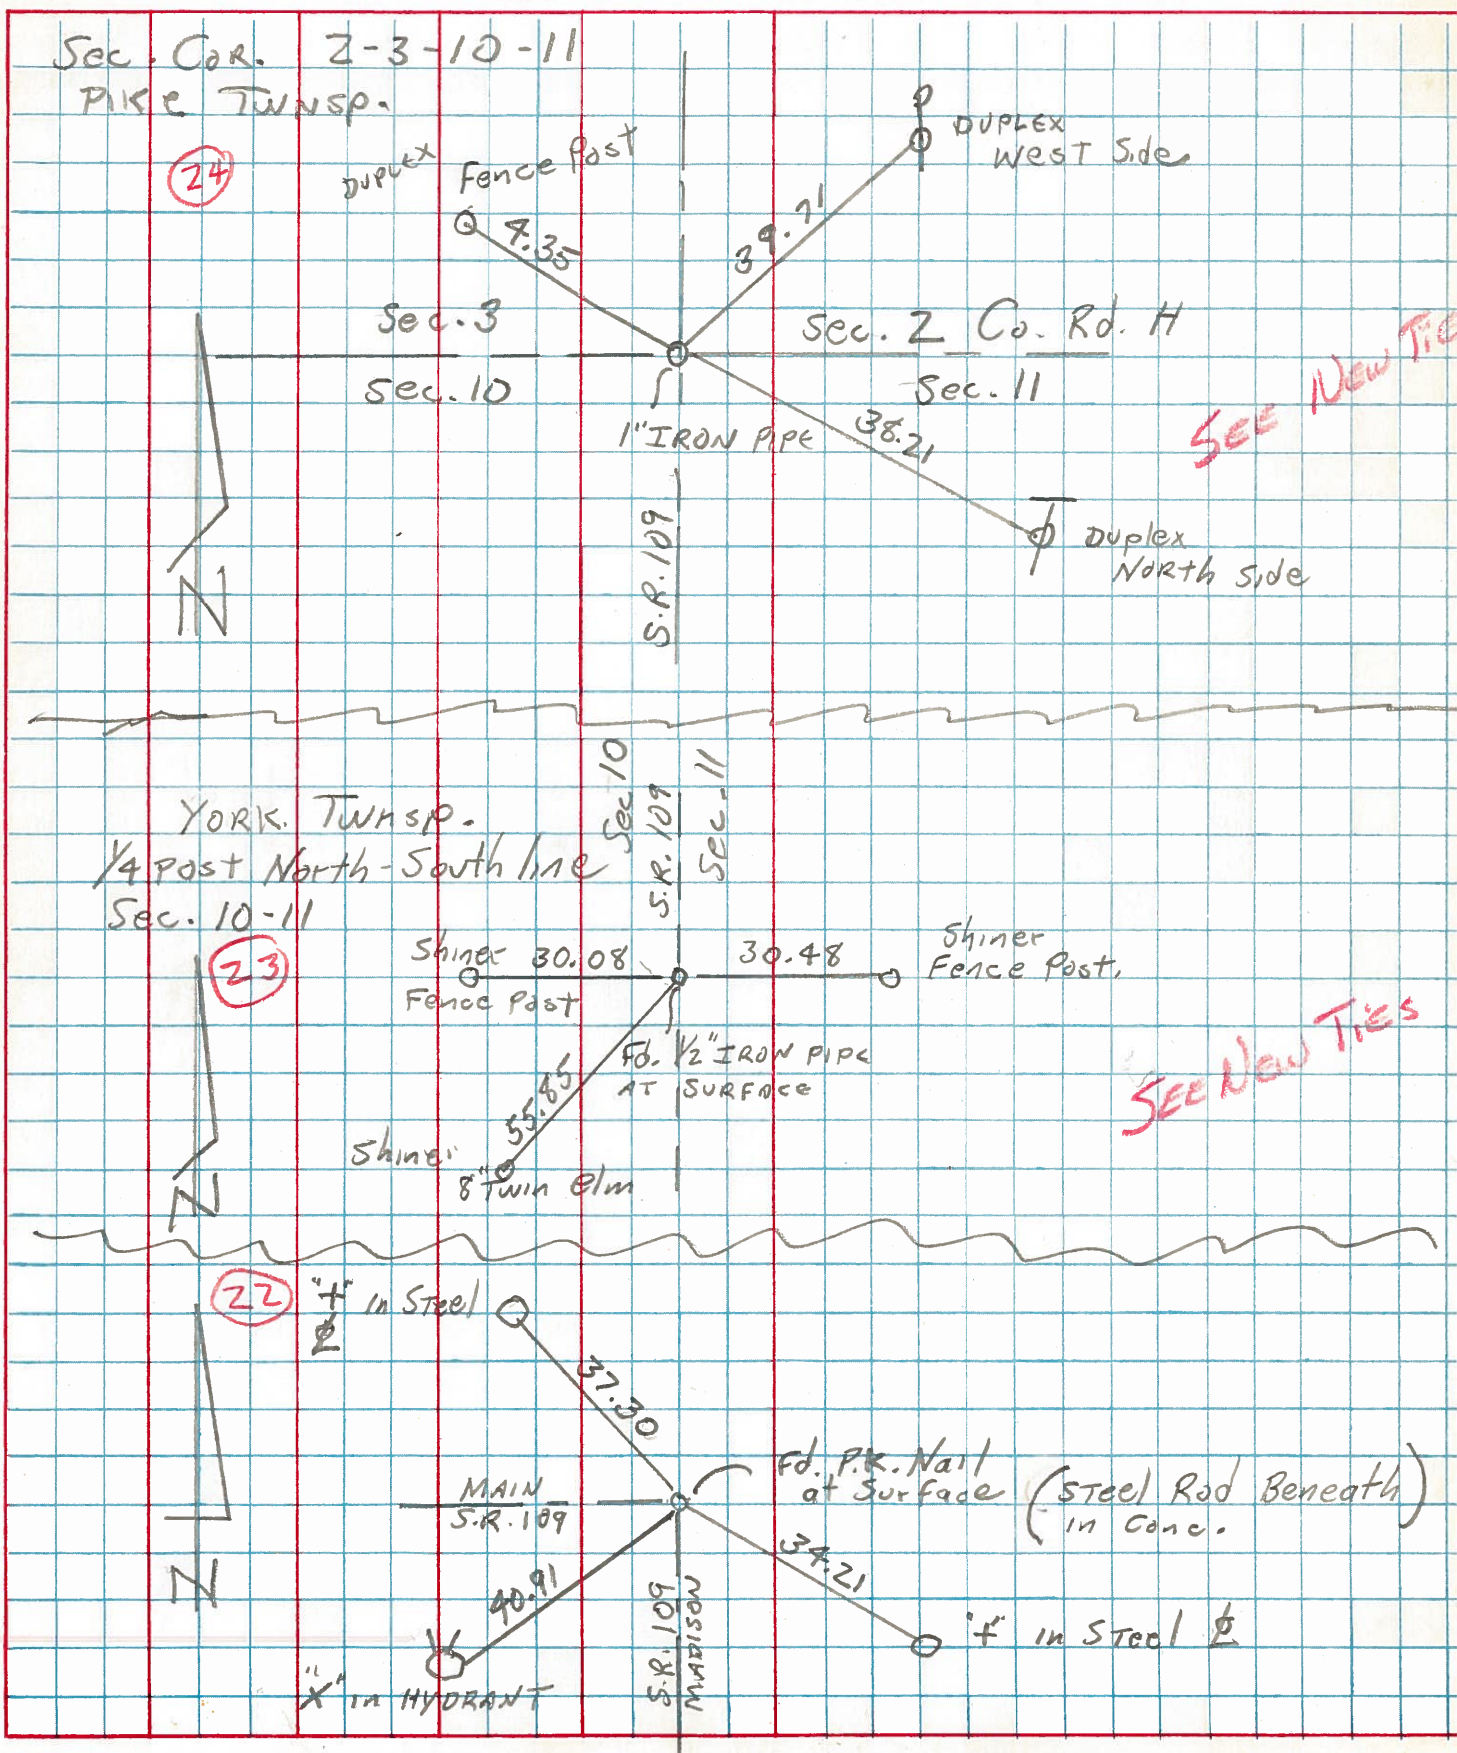

PERSONNEL TITLE PERSONNEL TITLE
 Red Beach _____
 Newcomb _____
 Knappe _____
 Wise _____

COUNTY Fulton DATE Sept. 1970
 S. R. 109 WEATHER _____
 SEC. Delta TEMP. _____

DESCRIPTION CONTROL POINTS JOB NO. _____

