

O.D.O.T. DISTRICT 2 SURVEY OFFICE (USE ONLY)

PERSONNEL

REFERENCE NO. 22

SHEET 35 OF 35

NOTES RHOADES
 H.C. LEU
 R.C. O'DONNELL
BALBAUGH

DATE 1-27-20
 WEATHER CLOUDY
 TEMP. 34°

ROUTE SR 109
 COUNTY FULTON
 TOWNSHIP YORK
 SECTION 13

DWG BY AUBLE PID 101295

T 7 N R 7 E


TYPE MONUMENT 1" IPIN, BENT EASTERLY

~~ON SURFACE~~ - BELOW 4" DOWN

OFFSET Q PAVEMENT 5.0' ~~LT~~ : RT

- TO - EDGE PAVEMENT

STATION: 335+28

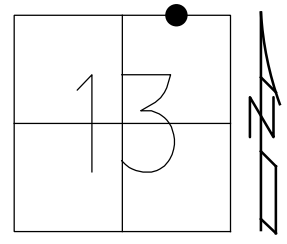

HORZ. DATUM: NAD83(2011)


GEOID: 12A

GRID: NORTHING: 698410.405

EASTING: 1557091.581

RECORD:
 SET SM.R.R.SPIKE
 5/13/88
 SET MAG/WASHER
 1/12/04, RGN
 FD 1" IPIN
 4" DOWN
 REFF39
 1-27-20, JLL
 SET MAG/WASHER
 10-7-21, DSA

NOTE: REFF39 US 20A

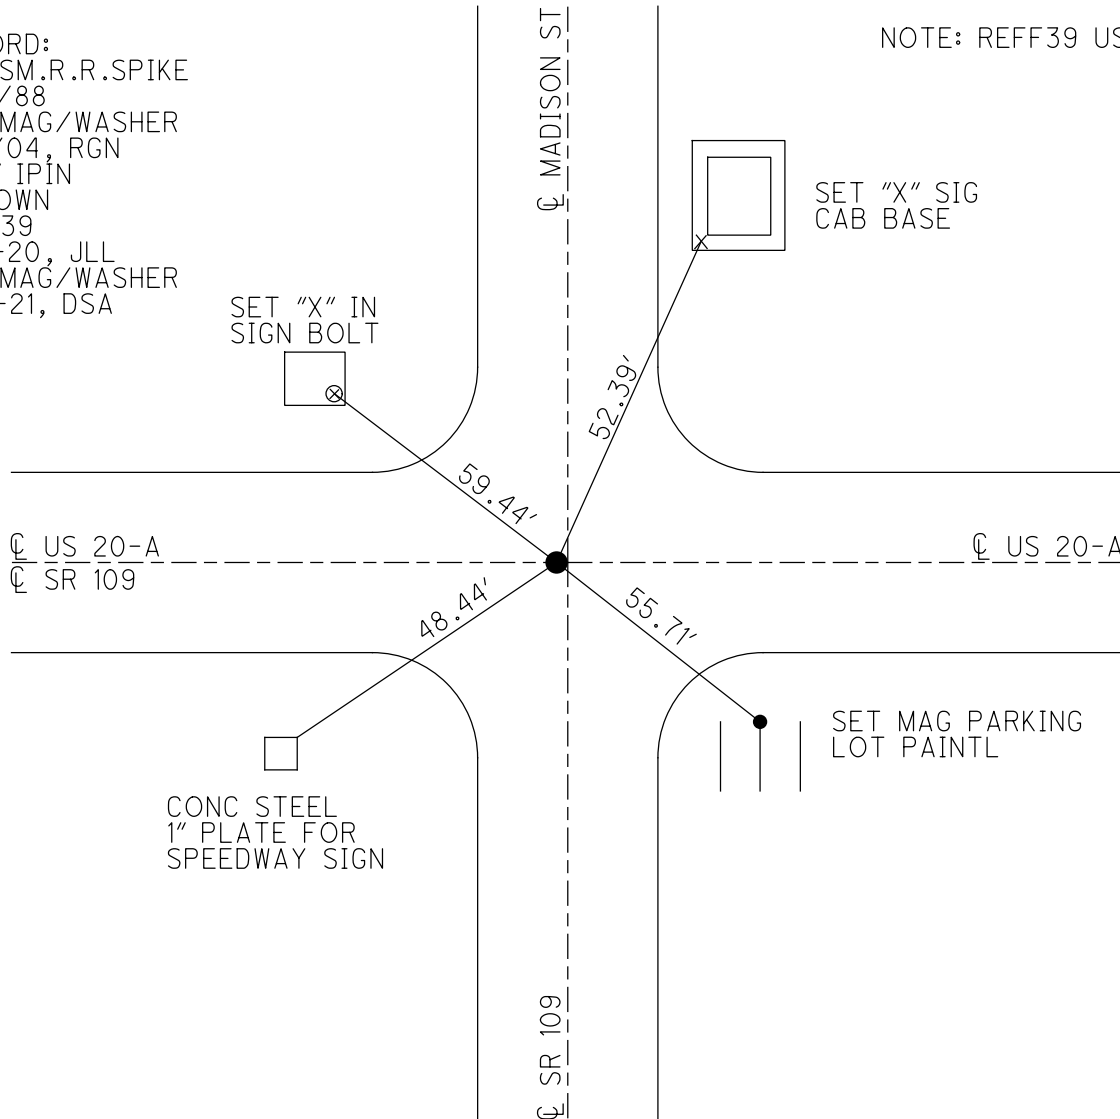

O.D.O.T. DISTRICT 2 SURVEY OFFICE (USE ONLY)

PERSONNEL _____

REFERENCE NO. 22

SHEET 32 OF 32

NOTES STONE

DATE 9/23/86

ROUTE SR 109

H.C. CURTIS

WEATHER CLOUDY

COUNTY FULTON

R.C. HOUSEHOLDER

TEMP. 65°

TOWNSHIP YORK

SECTION 13

DWG BY NIESE PID _____

T 7 N R 7 E

TYPE MONUMENT 1" IPIN IN CONC

~~ON SURFACE~~ - BELOW 2"

OFFSET \odot PAVEMENT ON LT : RT

- TO - EDGE PAVEMENT


STATION: 339+28

HORIZ. DATUM: _____


GEOID: _____

GRID: NORTHING: _____


EASTING: _____

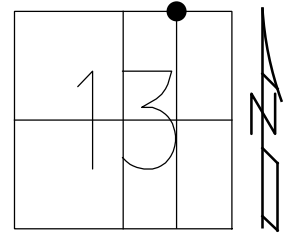

RECORD:
FD 1" IPIN
IN CONC
9/23/86, IRS
SET SM.R.R.SPIKE
5/13/88

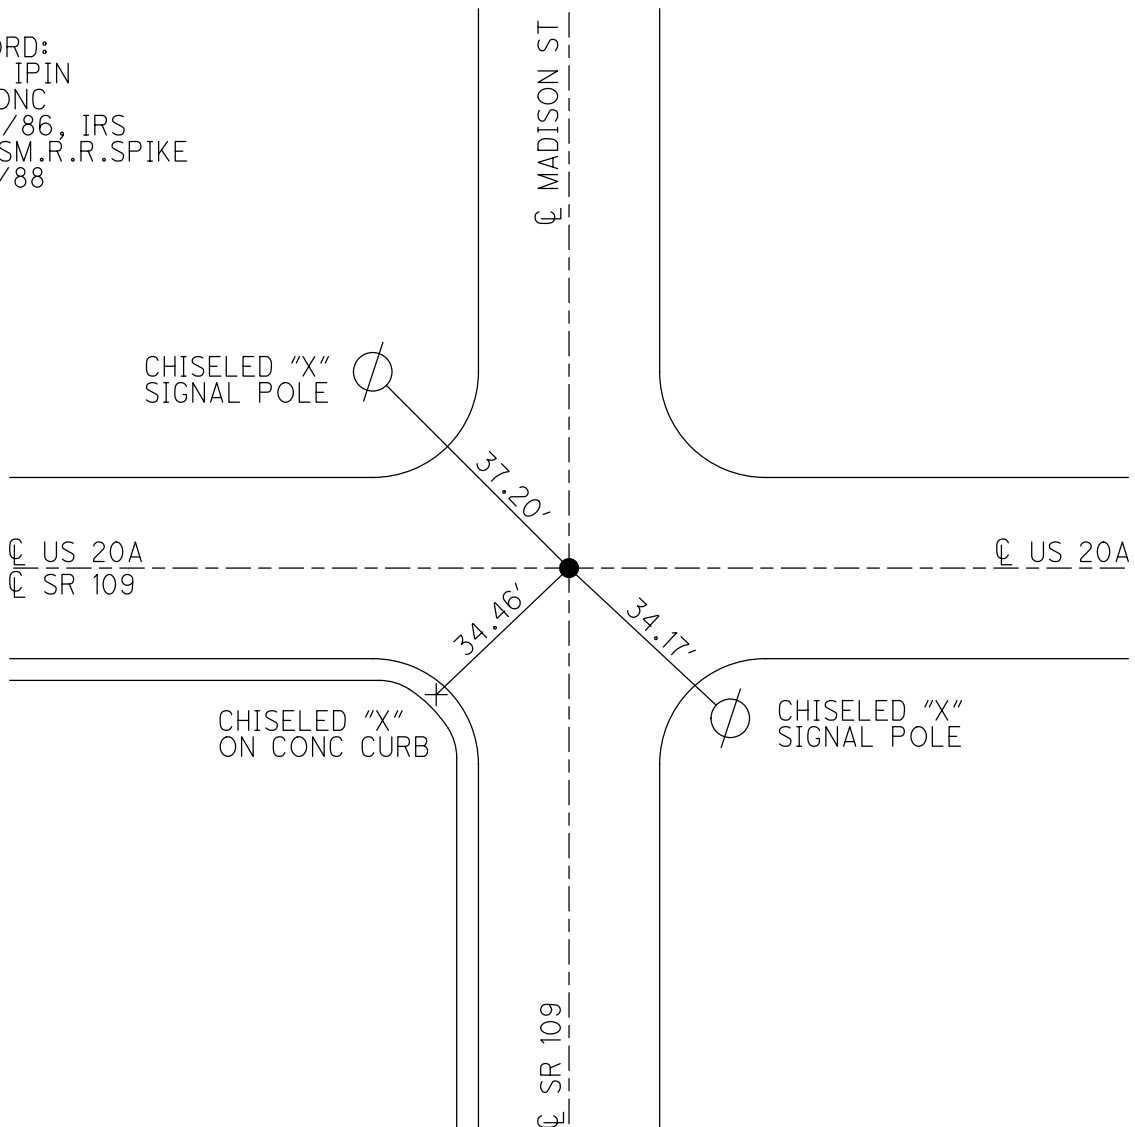

PERSONNEL	TITLE	PERSONNEL	TITLE	COUNTY	DATE	WEATHER	TEMP.
Tomsic				FULTON	July 18-73	clear	78°
Nouser				S. R. 109			
Granata				SEC. DELTA			
Yanyo		Boyle					
DESCRIPTION	MAN				JOB NO.	024610	

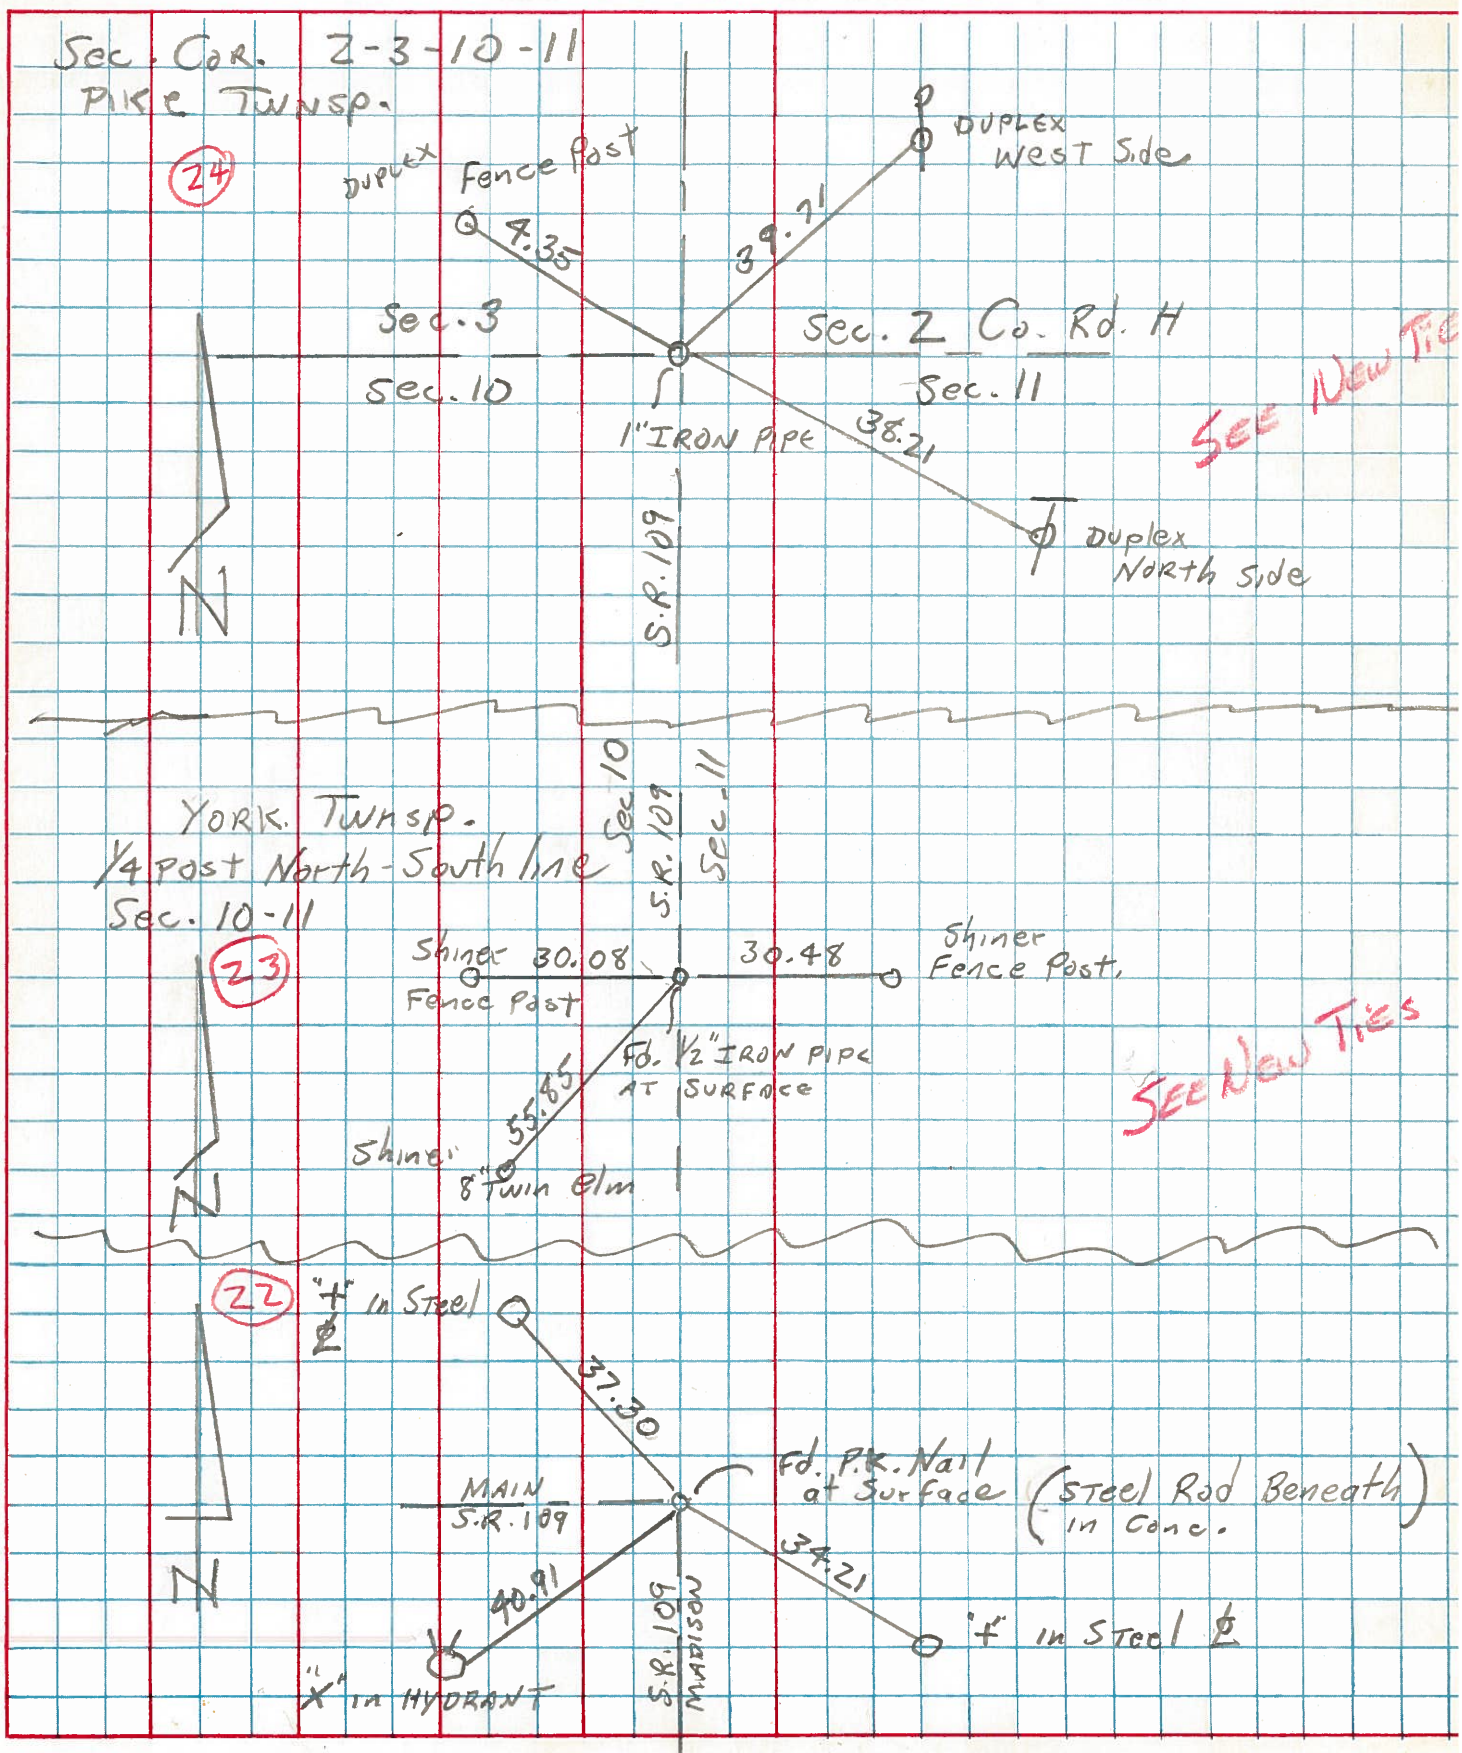

PERSONNEL	TITLE	PERSONNEL	TITLE
Red Beach			
Newcomb			
Knappe			
Wise			

COUNTY Fulton DATE Sept. 1970

S. R. 109 WEATHER _____

SEC. Delta TEMP. _____

DESCRIPTION CONTROL POINTS JOB NO. _____

