

O.D.O.T. DISTRICT 2 SURVEY OFFICE (USE ONLY)

PERSONNEL

REFERENCE NO. 24BA

NOTES PRESTON-COLVIN

DATE 10/14/25

ROUTE SR 109

H.C. NIESE

WEATHER CLEAR

COUNTY FULTON

R.C. BARRIERE

TEMP. 52°

TOWNSHIP PIKE

SECTION 3

DWG BY BARRIERE


PID 94331

T 7 N R 7 E

TYPE MONUMENT MAG NAIL/WASHER

ON SURFACE - BELOW ON

OFFSET $\mathcal{C}$ PAVEMENT ON

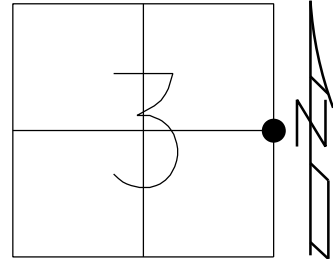

STATION: 507+92.55

HORZ.DATUM: NAD83(11)/FUL OCCS

GEOID: 18

GRID: NORTHING: 706364.721

EASTING: 1547939.218

LDP: NORTHING: 362825.660

EASTING: 194785.005

RECORD:
P.I. STA 79+29.3
FUL-109-09.68-1983
 $\Delta = 02^{\circ}27'$
D= 01°
T= 122.52'
R= 5729.58'
L= 245'

FD MAG SPIKE SHANK
10/02/23, TDN
FD BENT MAG SPIKE
4/14/25, TDN
SET MAG/WASHER
SET REF 24BA
10/14/25, TDN

"x" IN 2" POST
74.19'

24BA

NOTCH IN T-POST
60.24'

"x" IN 2" POST
55.14'

$\mathcal{C}$ SR 109

 24B