

O.D.O.T. DISTRICT 2 SURVEY OFFICE (USE ONLY)

PERSONNEL

REFERENCE NO. 25

NOTES PRESTON-COLVIN

DATE 4/14/25

ROUTE SR 109

H.C. NIESE

WEATHER CLEAR

COUNTY FULTON

R.C. PRESTON-COLVIN

TEMP. 52°

TOWNSHIP PIKE

SECTION 3

DWG BY BARRIERE

PID 94331

T 7 N R 7 E

TYPE MONUMENT MONBOX W/ 1" IPIN

ON SURFACE - BELOW ON

OFFSET $\mathcal{C}$ PAVEMENT ON

STATION: 510+24.71

HORZ.DATUM: NAD83(11)/FUL OCCS


GEOID: 18

GRID: NORTHING: 706596.494


EASTING: 1547953.213

LDP: NORTHING: 363057.667

EASTING: 194794.611

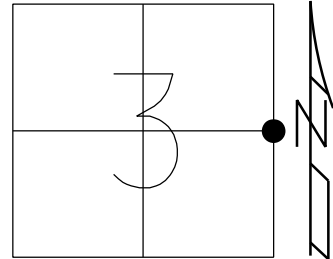

RECORD:
STA.15+62.33
STA.507+99
FD SM.R.R.SPIKE
8/31/90, MB
FD MONBOX
6/12/12
3/4/13
FD MONBOX
W/ 1" IPIN
REFC24
4/23/21, JFO
8/26/21, JFO
1/11/23, TDN
9/18/23, TDN
4/14/25, TDN
10/14/25, TDN

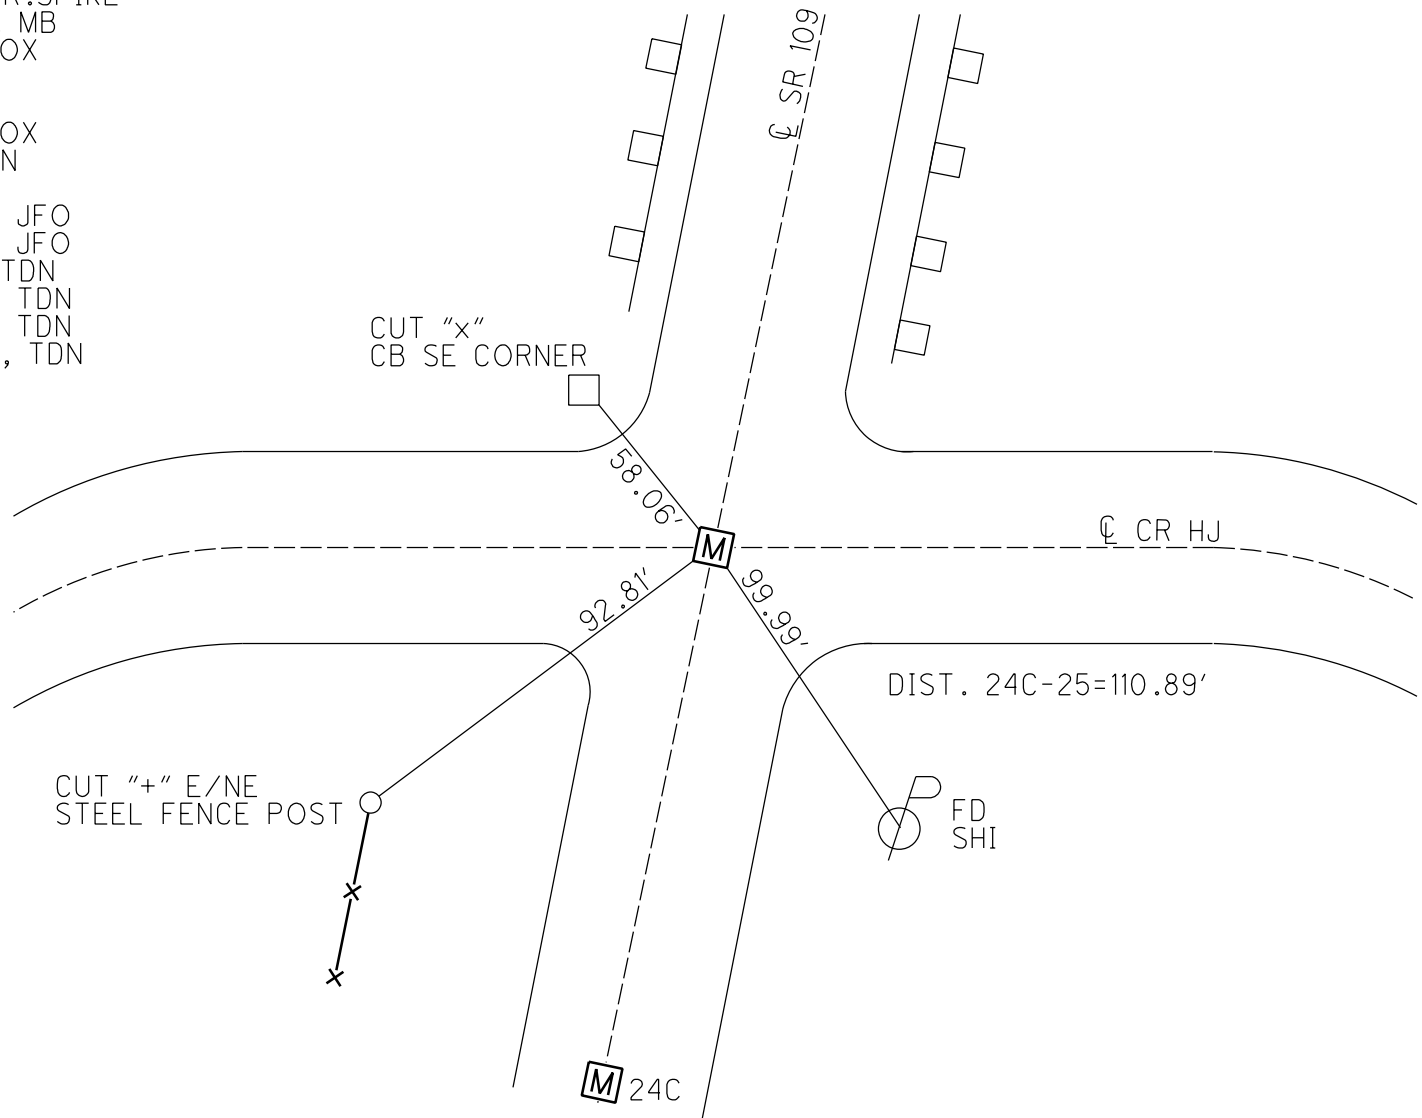

O.D.O.T. DISTRICT 2 SURVEY OFFICE (USE ONLY)

PERSONNEL

REFERENCE NO. 25

SHEET 7 OF 35

NOTES RHOADES
H.C. O'DONNELL
R.C. RHOADES

DATE 4/23/21
WEATHER CLOUDY
TEMP. 46°

ROUTE SR 109
COUNTY FULTON
TOWNSHIP PIKE
SECTION 2
T 7 N R 7 E

DWG BY NIESE PID PAVE TRAIN

TYPE MONUMENT MONBOX W/ 1" IPIN

ON SURFACE - ~~BELOW~~ ON

OFFSET $\varnothing$ PAVEMENT ON LT : RT
- TO - EDGE PAVEMENT



STATION: 510+24.71

HORZ.DATUM: NAD83(2011)

GEOID: 2018

GRID: NORTHING: 706596.506

EASTING: 1547953.257

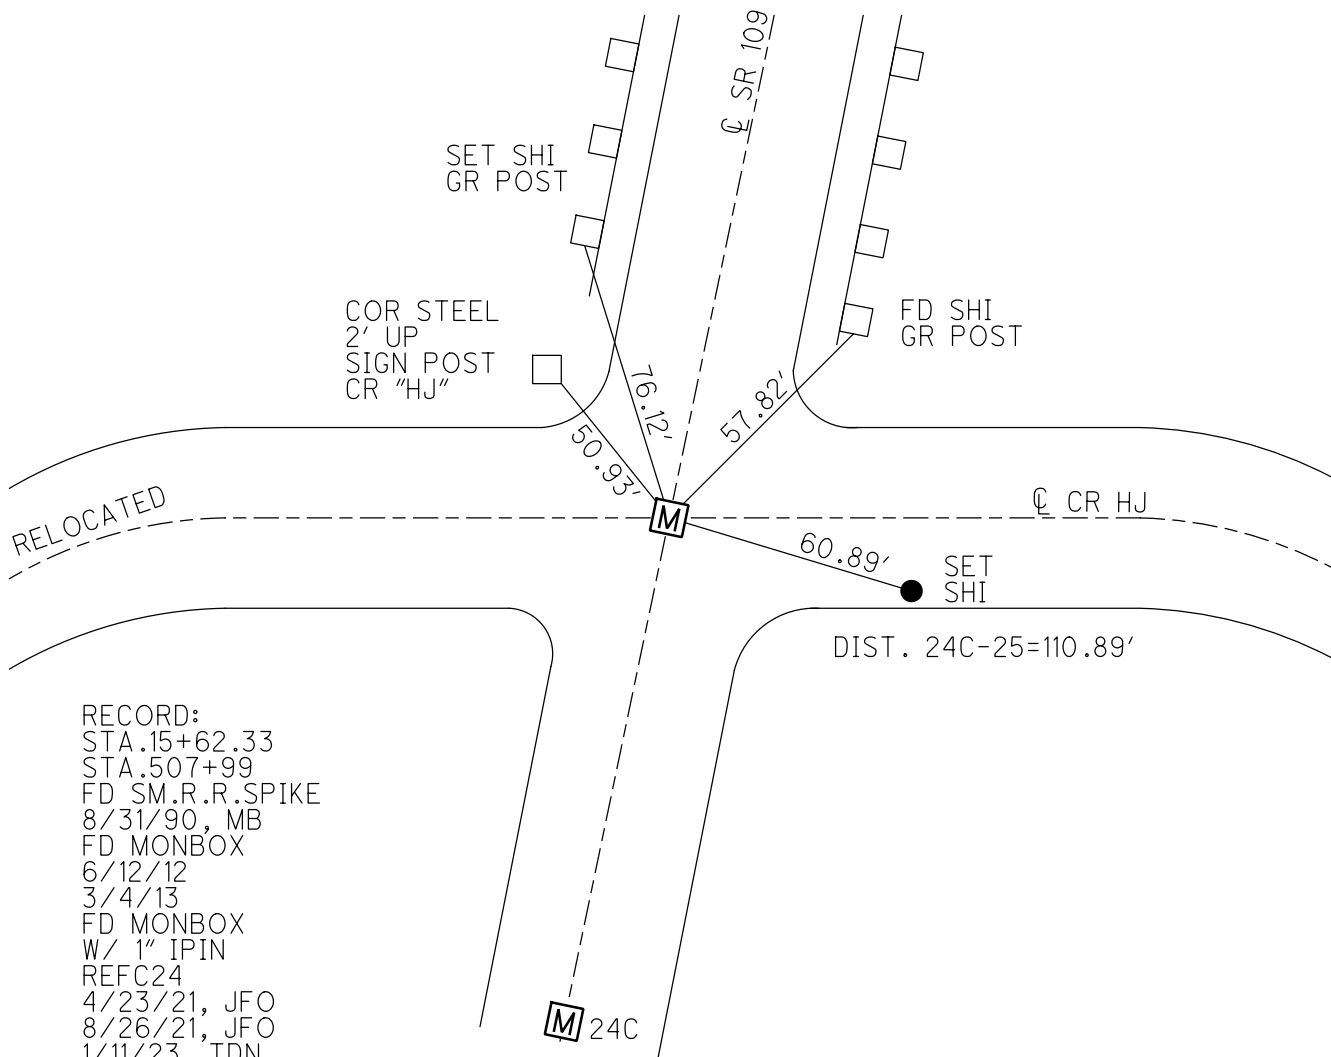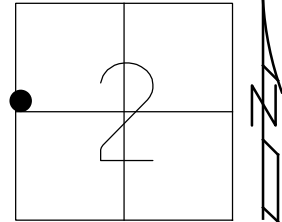

O.D.O.T. DISTRICT 2 SURVEY OFFICE (USE ONLY)

PERSONNEL

REFERENCE NO. 25

SHEET 7 OF 35

NOTES RHOADES

DATE 4/23/21

ROUTE SR 109

H.C. O'DONNELL

WEATHER CLOUDY

COUNTY FULTON

R.C. RHOADES

TEMP. 46°

TOWNSHIP PIKE

DWG BY NIESE

PID PAVE TRAIN

SECTION 2

T 7 N R 7 E

TYPE MONUMENT MONBOX W/ 1" IPIN

ON SURFACE - ~~BELOW~~ ON

OFFSET Q PAVEMENT ON LT : RT

- TO - EDGE PAVEMENT



STATION: 510+24.71

HORZ.DATUM: NAD83(2011)

GEOID: 2018

GRID: NORTHING: 706596.506

EASTING: 1547953.257

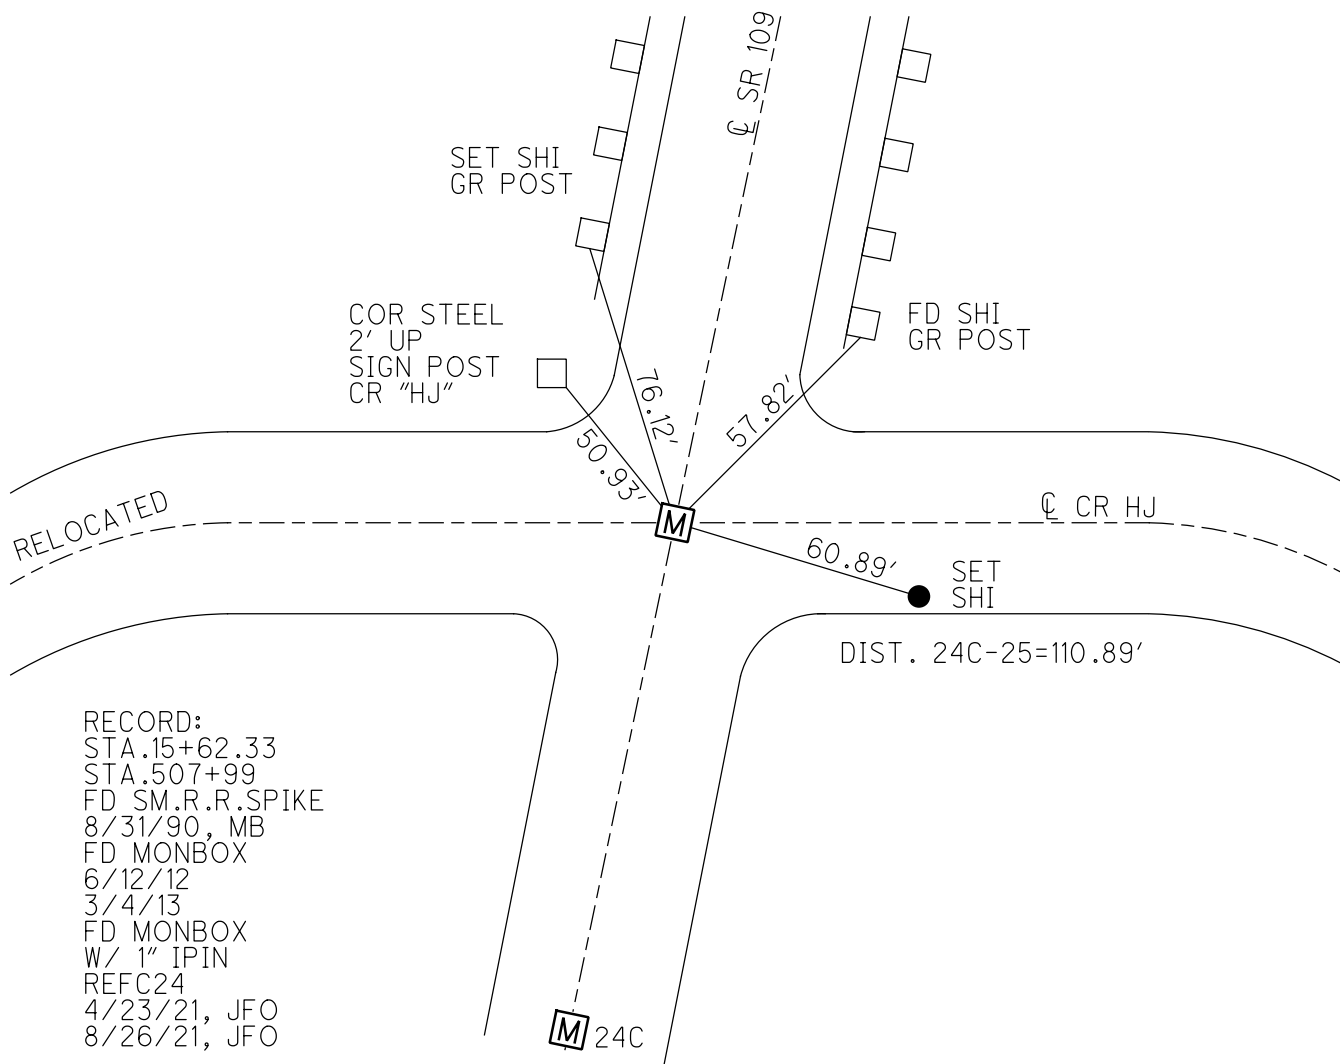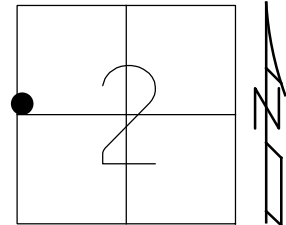

O.D.O.T. DISTRICT 2 SURVEY OFFICE (USE ONLY)

PERSONNEL

REFERENCE NO. 25-AA

SHEET 8 OF 35

NOTES HUSS

DATE 06-12-12

ROUTE SR 109

H.C. HUSS

WEATHER CLEAR

COUNTY FULTON

R.C. CANTERBURY

TEMP. 76°

TOWNSHIP PIKE

COUTCHER

SECTION 2

T 7 N R 7 E

TYPE MONUMENT MON BOX


ON SURFACE - BELOW ON

LEFT - Q PAV'T - RIGHT ON


- TO - EDGE PAVEMENT

S.L.M. 511+43

Grid: Northing: 706596.494 Easting: 1547953.204

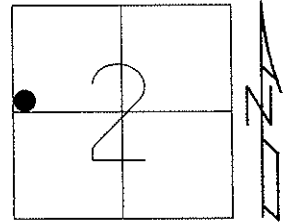

06-12-12 GPS REF A25, SAH
03-04-13 GPS FIN A25, MC

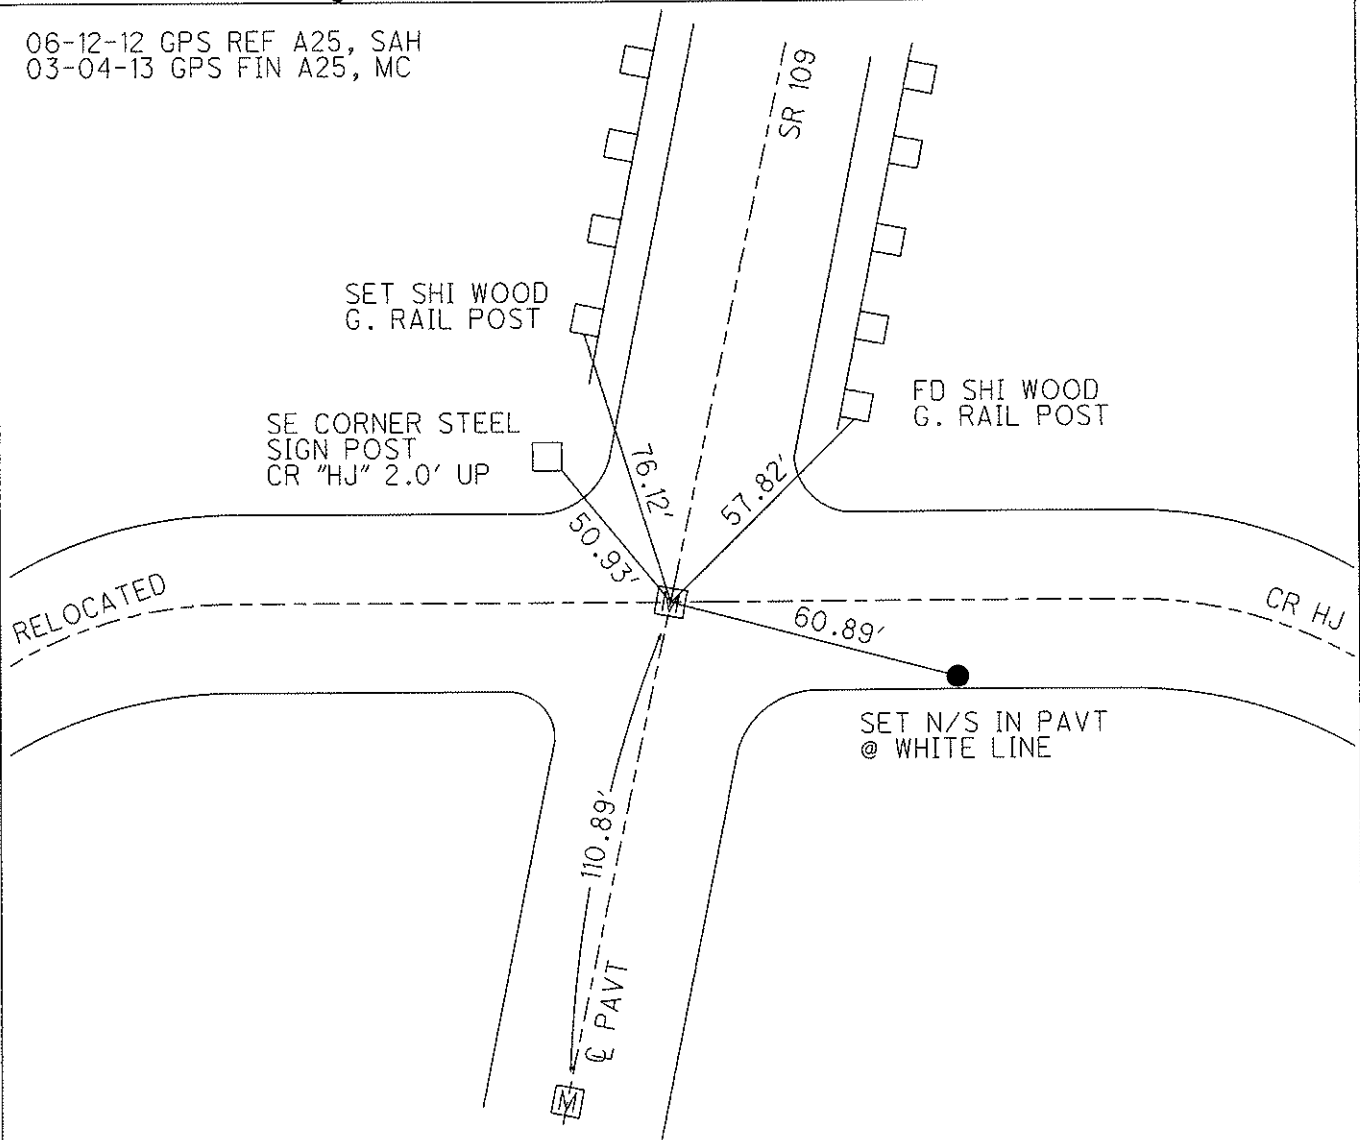

O.D.O.T. DISTRICT 2 SURVEY OFFICE (USE ONLY)

PERSONNEL

REFERENCE NO. 25

SHEET 6 OF 35


NOTES BARNHISEL
H.C. BARNHISEL
R.C. HOFFMAN

DATE 08-31-90
WEATHER CLEAR
TEMP. 72°

ROUTE SR 109
COUNTY FULTON
TOWNSHIP PIKE
SECTION 3
T 7 N R 7 E


TYPE MONUMENT SM RR SPK
ON SURFACE - BELOW ON
LEFT - Q PAV'T - RIGHT 3.5'
- TO - EDGE PAVEMENT
S.L.M. 507+99

Grid: Northing: _____ Easting: _____

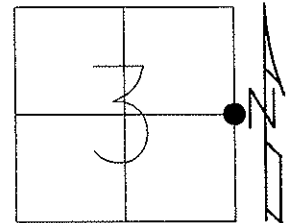

NOTE:
ROAD HJ WAS
RELOCATED BY
THE TURNPIKE
INTERCHANGE
PROJECT; 1996

SEE NEXT SHEET

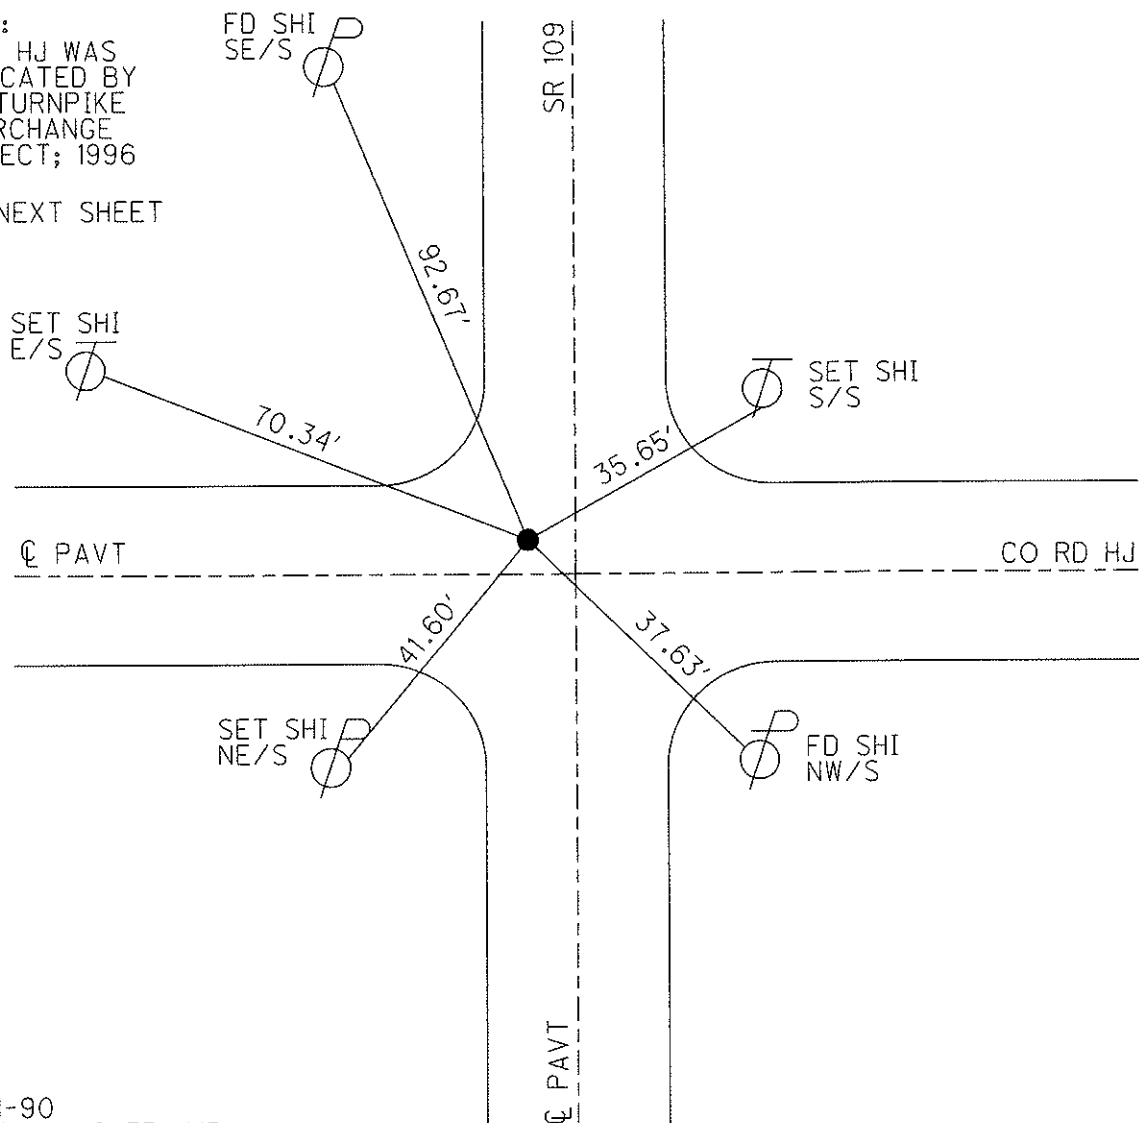

10-01-90
SET PK/WASHER, MB

O.D.O.T. DISTRICT 2 SURVEY OFFICE

PERSONNEL

REFERENCE NO. 25

SHEET 5 OF 28

NOTES BARNHISEL

H.C. " "

R.C. HOFFMAN

DATE 8-31-90

WEATHER clear

TEMP. +72°

ROUTE 109

COUNTY Fulton

TOWNSHIP PIKE

SECTION 3

T 7 N R 7 E

TYPE MONUMENT Sm RR Spk


ON SURFACE - BELOW yes

LEFT-~~C~~ PAV'T. - RIGHT 3.5

— TO — EDGE PAVEMENT


S.L.M. 507+99

2.5 N. OF E. W.

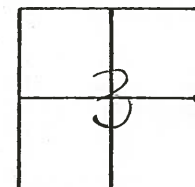

NOTE:
Road HJ was
Relocated by the
Turnpike Interchange
Project; 1996

Set P.K. & Washer
10-1-90
MB

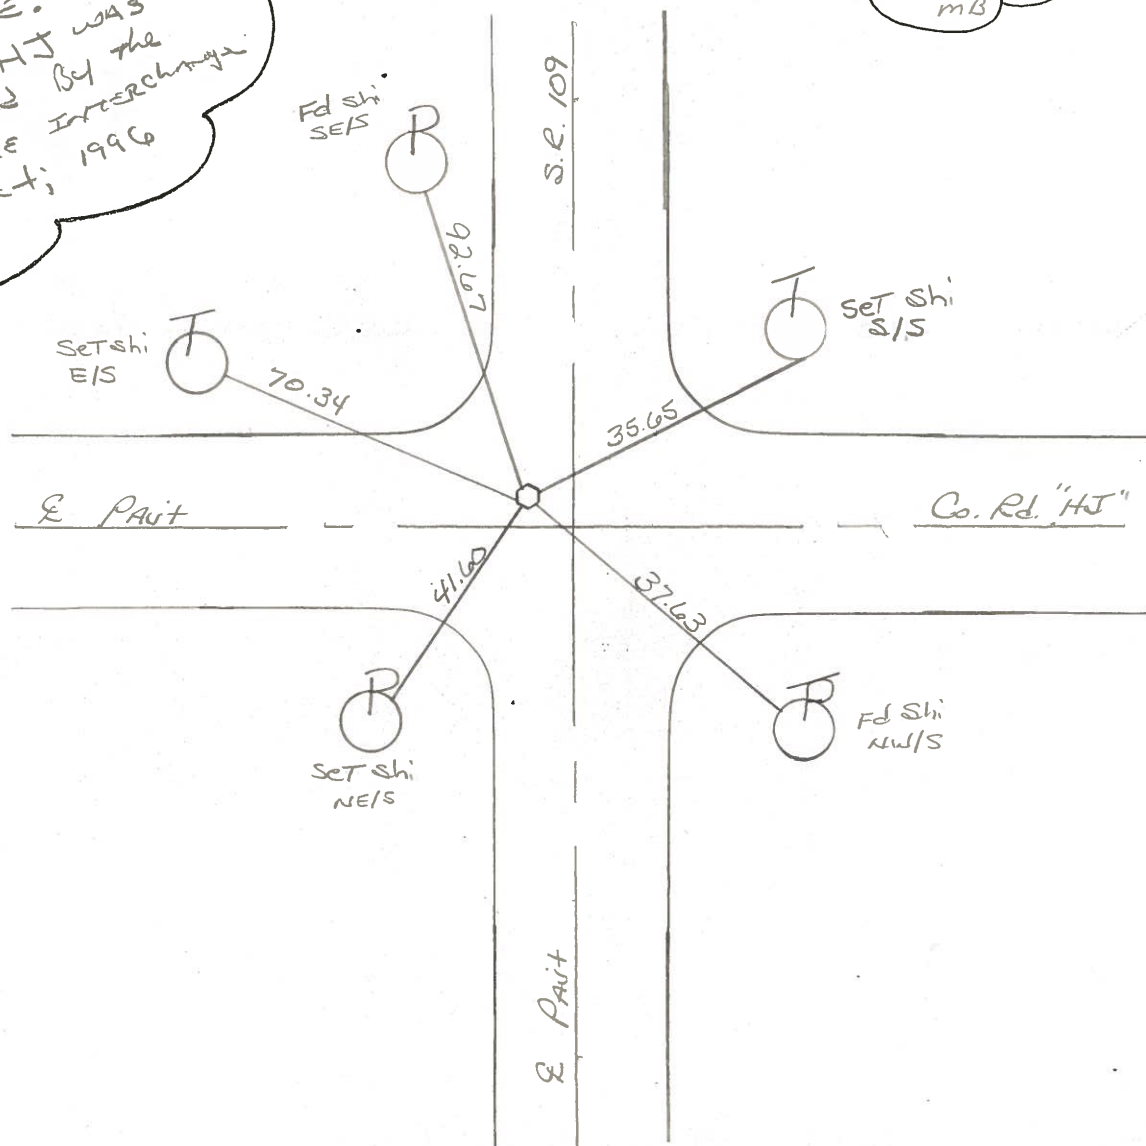

SHEET 3 OF

County Fulton S. R. 109

Township RIKE

Section 2-3

T_N, R_E

Personnel 1.5400

P. Neuse


R. Michael

D. Curtis


Date 11 April 84



Weather Fair

Temp. 480

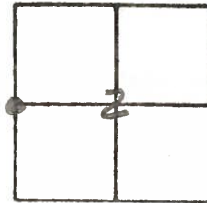

REF. NO. 25

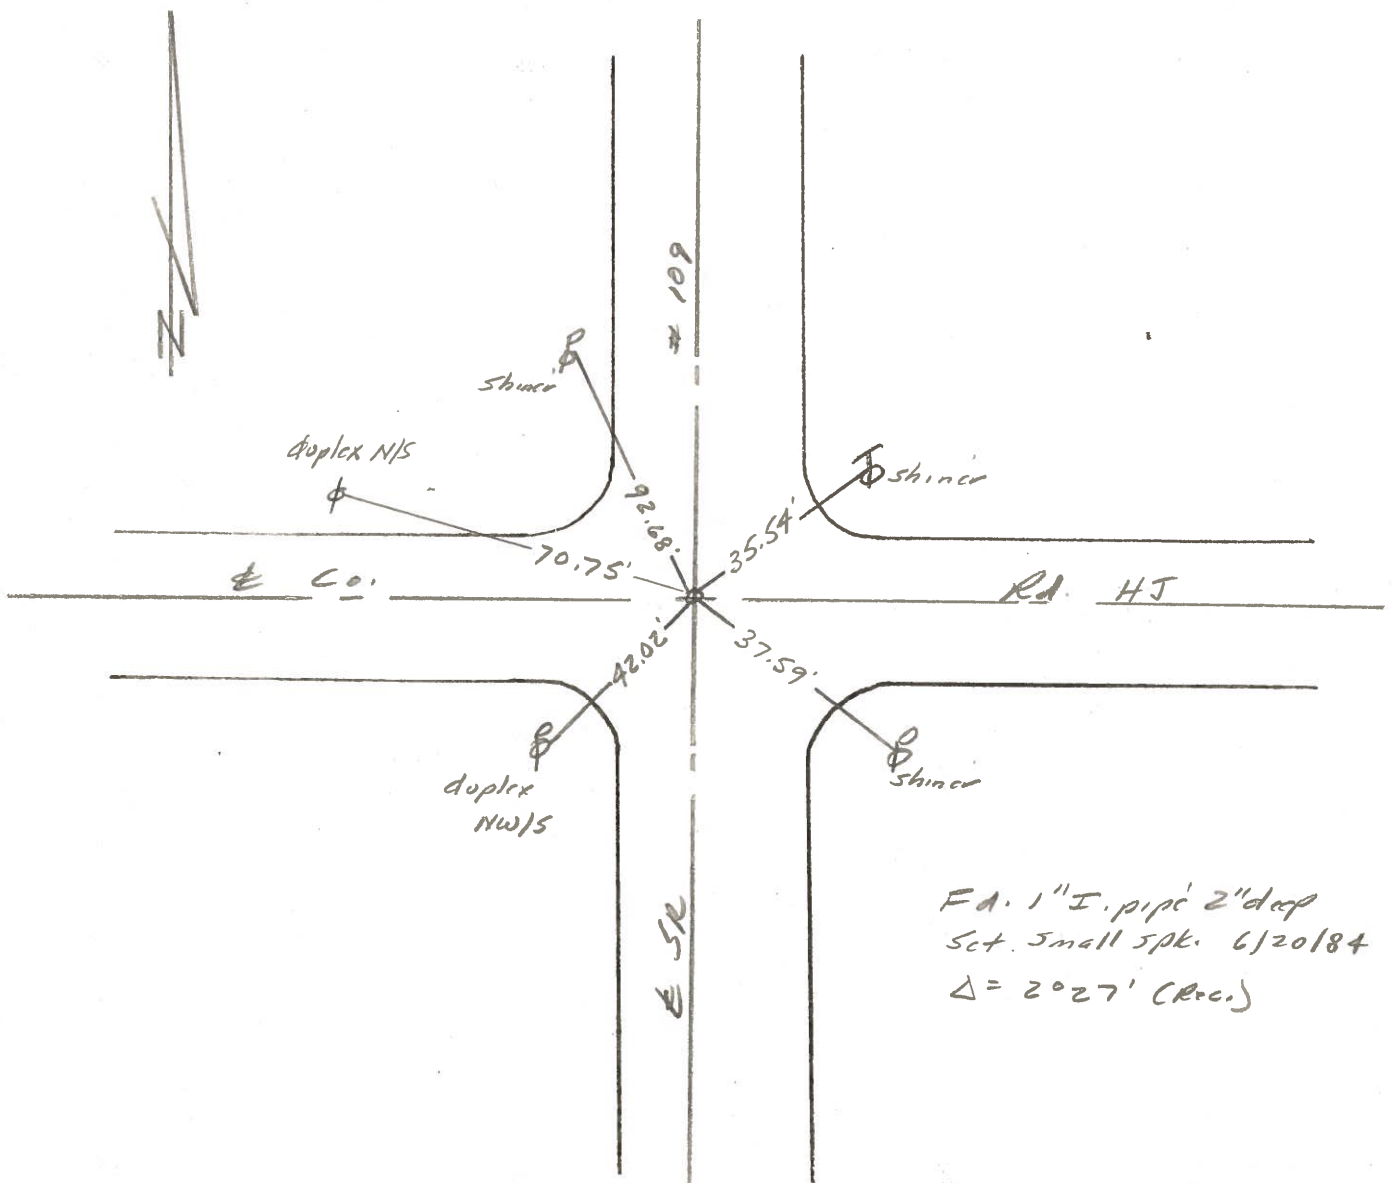

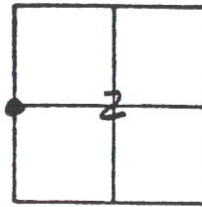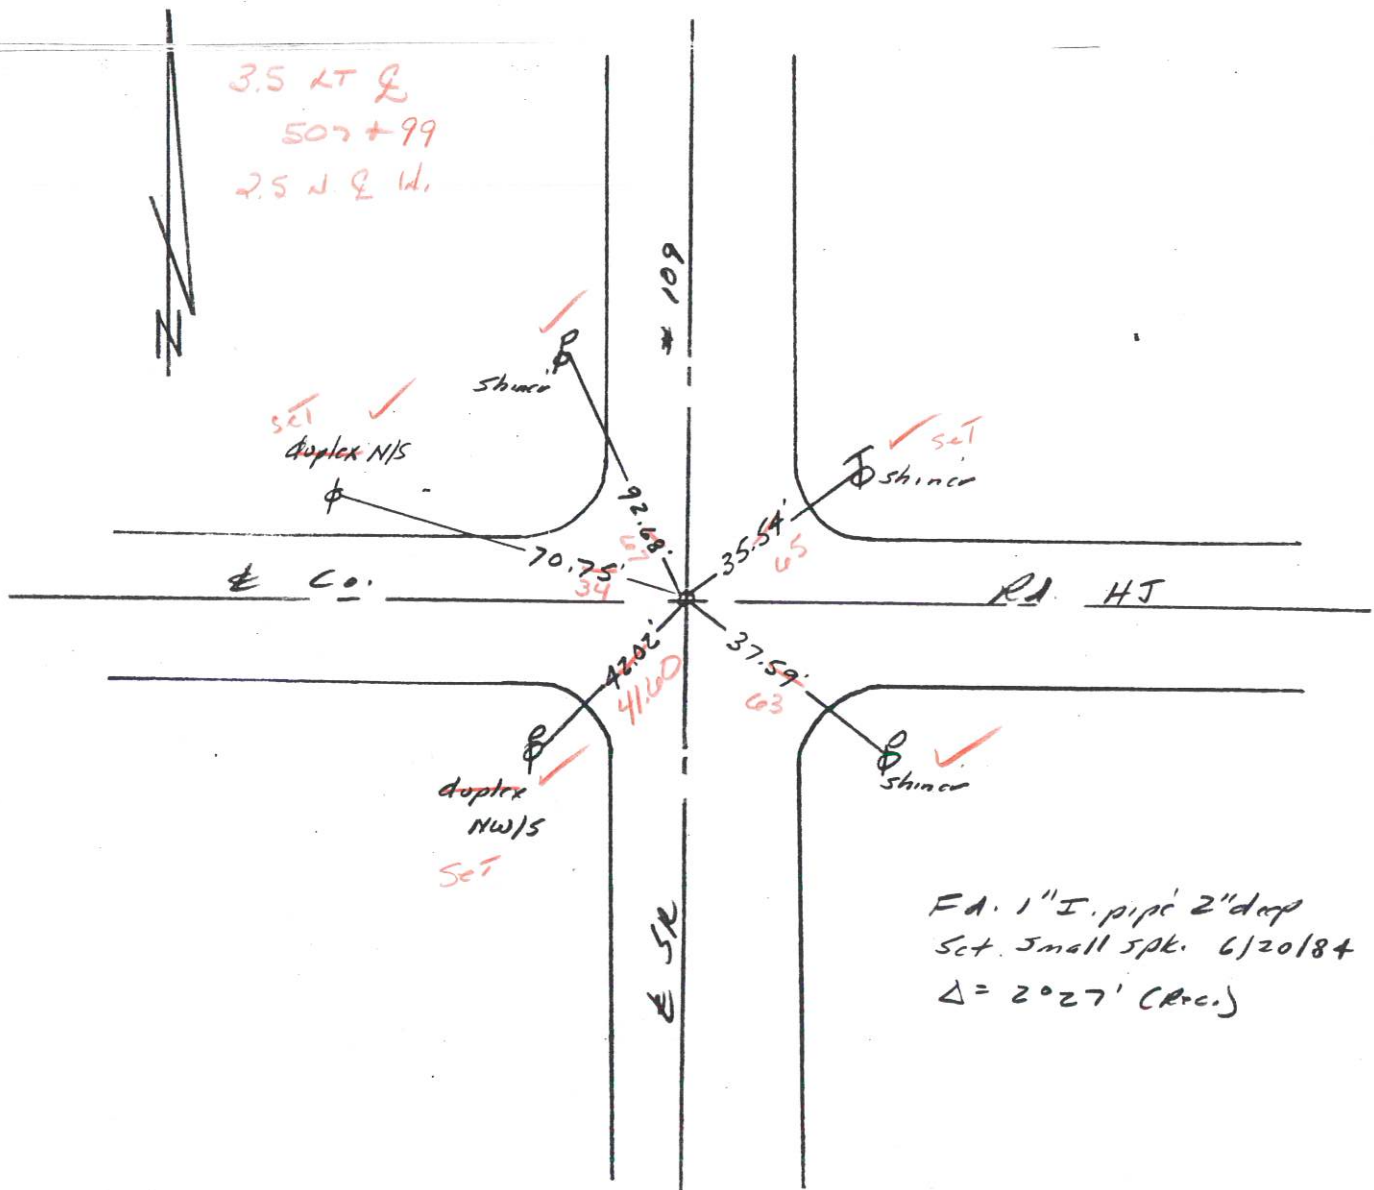County Fulton S.R. 109Township PIKESection 2-3T N, R EPersonnel I. StoneP. NeaseR. MichaelD. CurtisDate 11 April 84Weather FairTemp. 480REF. NO. 25

ODOT DISTRICT 2 SURVEY OFFICE

SHEET 1 OF 3

County Fulton S.R. 109

Township PIKE

Section 2-3

T N, R E

Personnel I. Stone

P. Noosce

R. Mikaluk

D. Curtis

Date 6 Jan. 82


Weather cloudy

Temp. 35°

34	35
3	2



REF NO. 25

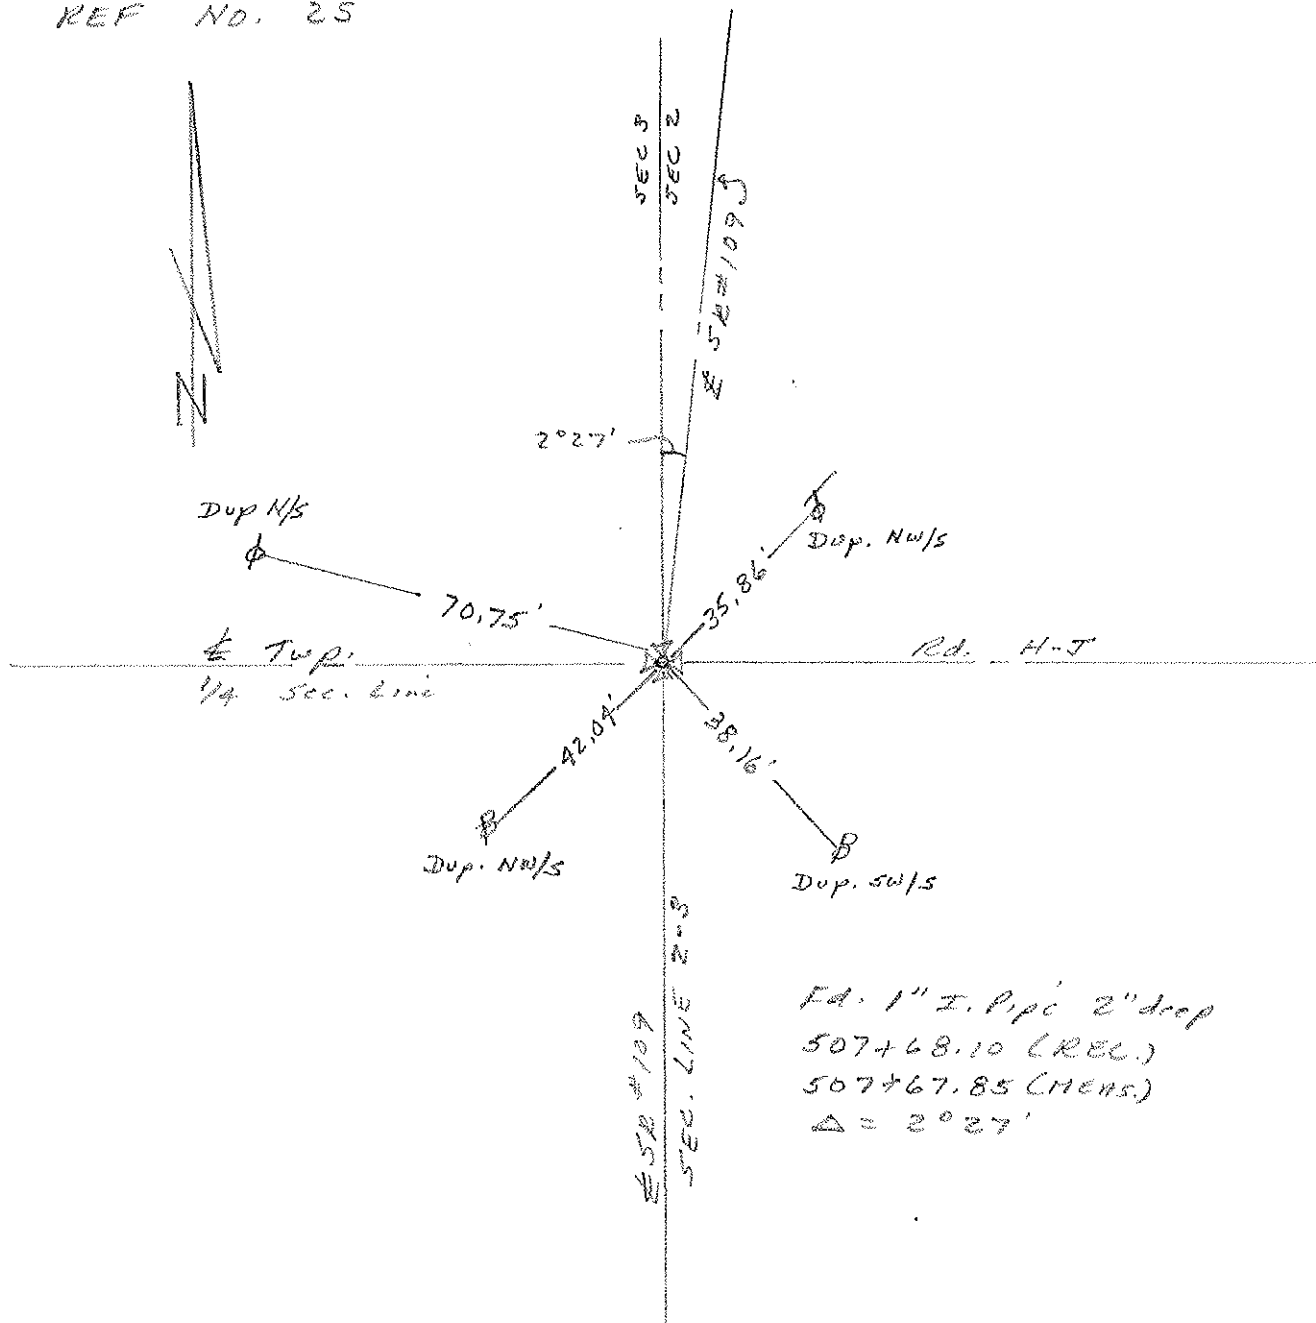

Ed. 1" I. Pipe 2" drop
 507+68.10 (REL.)
 507+67.85 (MENS.)
 $\Delta = 2^{\circ} 27'$

PERSONNEL TITLE PERSONNEL TITLE

Red BeachW. KnappeCOUNTY FultonDATE 15 Feb '77S. R. 109

WEATHER



SEC. PIKE TWP.

TEMP.

DESCRIPTION

CONTROL POINTS


JOB NO.

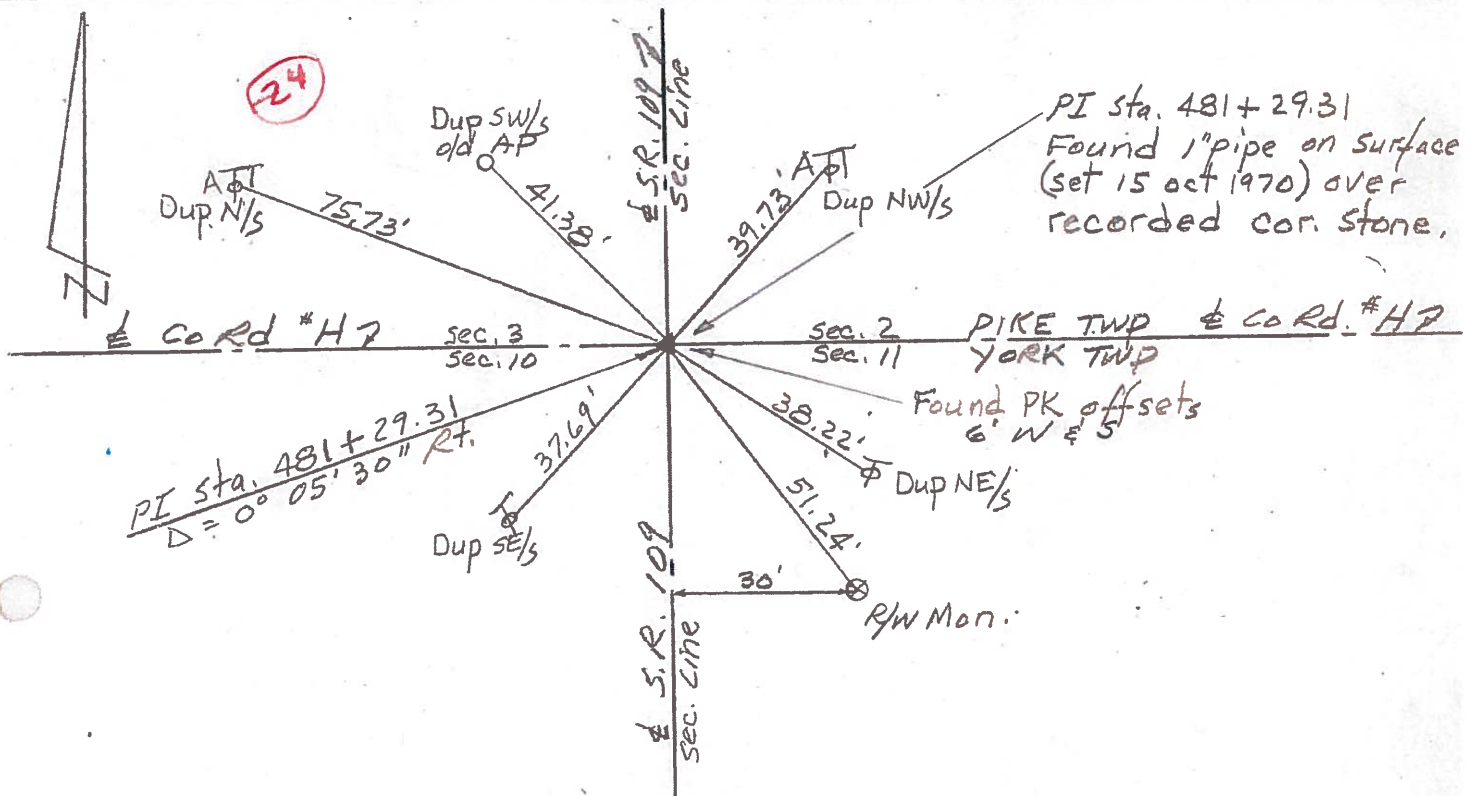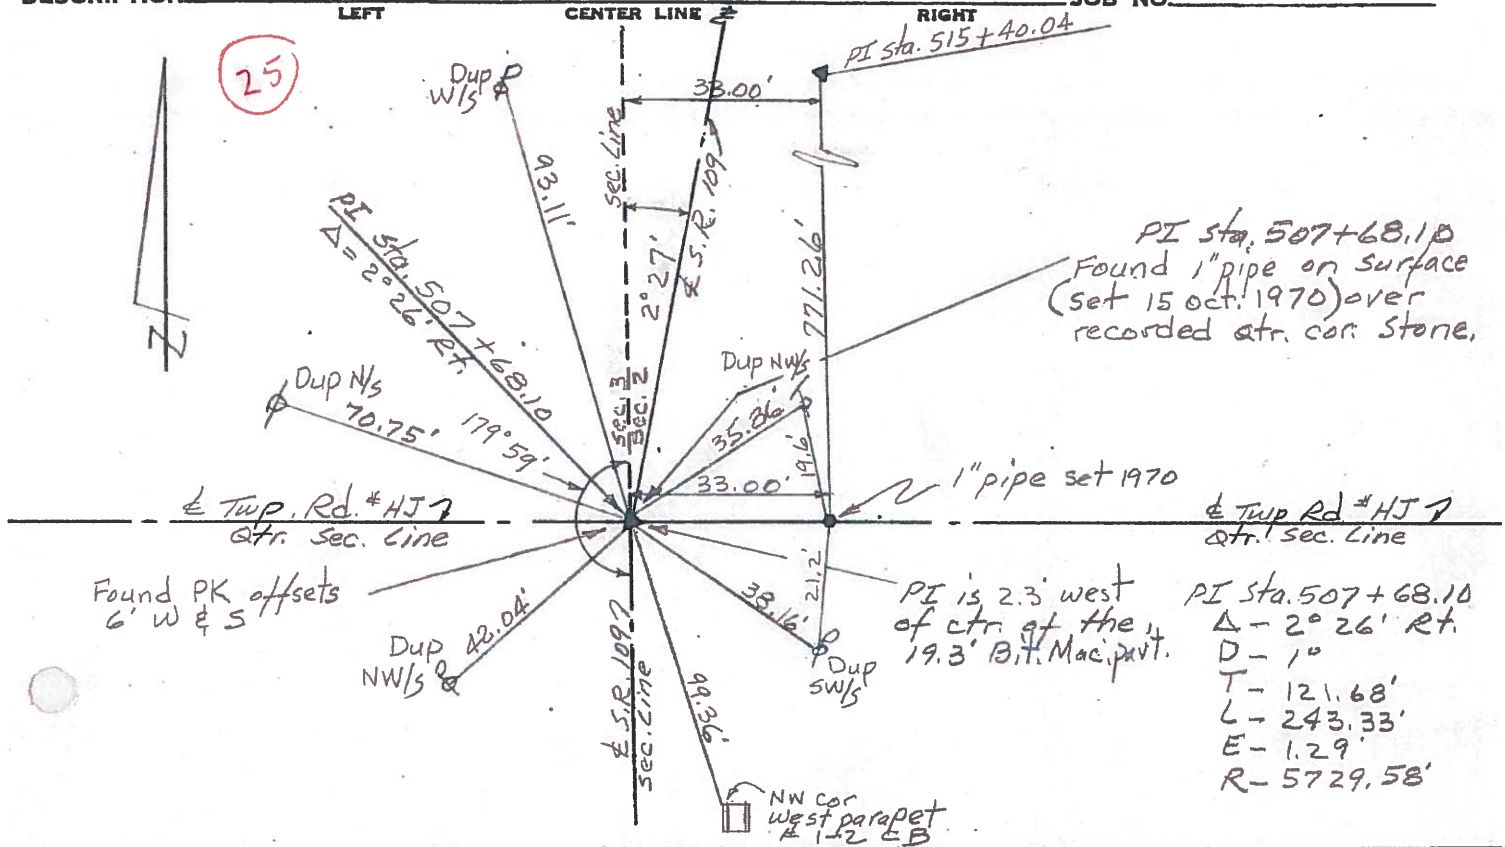

SHEET NO. 12

PERSONNEL	TITLE	PERSONNEL	TITLE	COUNTY	DATE	WEATHER	TEMP.
Tomsic		Granata		Fulton	July-18-73	80°	clear
Neuser				S. R. 109			
Vanjo				SEC.			
Boyle							

DESCRIPTION MON LEFT CENTER LINE RIGHT JOB NO. 02 4610

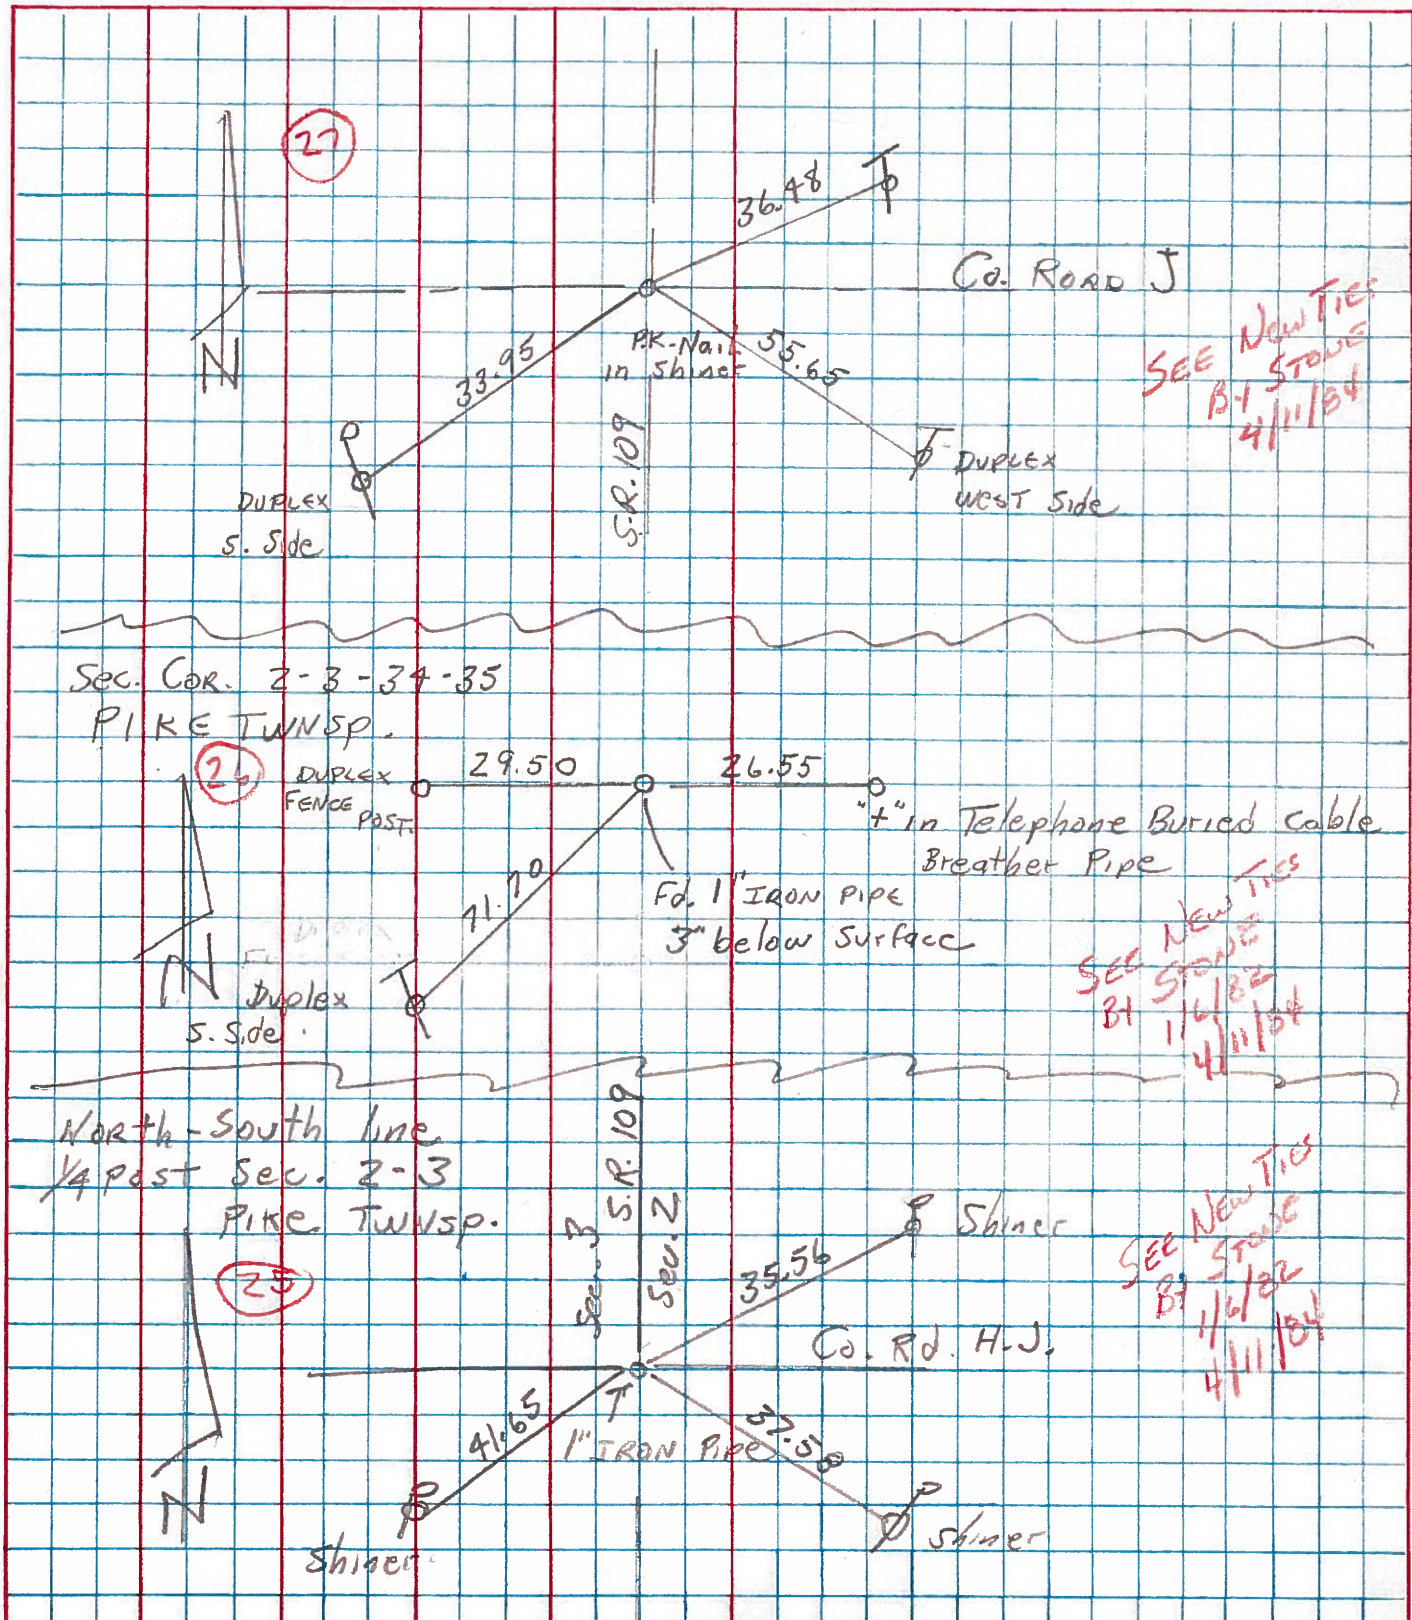

PERSONNEL	TITLE	PERSONNEL	TITLE
1	2	3	4
5	6	7	8
9	10	11	12
13	14	15	16
17	18	19	20
21	22	23	24
25	26	27	28
29	30	31	32
33	34	35	36
37	38	39	40
41	42	43	44
45	46	47	48
49	50	51	52
53	54	55	56
57	58	59	60
61	62	63	64
65	66	67	68
69	70	71	72
73	74	75	76
77	78	79	80
81	82	83	84
85	86	87	88
89	90	91	92
93	94	95	96
97	98	99	100

Red Beach
Newcomb
Knape
Wise

COUNTY FULTON

DATE Oct. 1970

S. R. 109

WEATHER

SEC. YORK - PIKE TWP TEMP

DESCRIPTION

CONTROL POINTS

JOB NO.

LEFT

CENTER LINK

RICH

N 1/4 Stone, Sec 15 YORK TWP
S 1/4 Stone, Sec 16 YORK TWP

Robt. Williams
Brick
Ranch Type

Part Metal - 5" Bit. Mac.
8" W.B. Mac.
6" I-22
19" total part.
on sand subgrade

sec 10
sec 15

Sec Line 7/

of Const. US 20-A.

Dup NW/s 66.0-
10" pine

Found good stone
while 43 1/2" below pit
Surface. Found 3 1/4" Red
22" below surface and
9" East of Stone.
Est. 4 1/2" x 1" pipe
over stone.
6 Oct. 1970.
Did not disturb 3 1/4" Red.
Stone is 10 1/2" north of
r of 24" pit.

COR. SEC. 2 & 3 PIKE TWP T-7-N
COR. SEC. 10 & 11 YORK TWP

Dup
2017

Q^{AD}

ABT 75.73'

Page 3
2014

11.29.31

AT Ga. 481 + 0.

PL 3

70151

Found Dip St

99

S 1/4 post, Sec 2, PIKE TWP. T-7-N
N 1/4 post, Sec 11, YORK TWP. T-7-N

ATT Line runs 20' N of &
Telephone Line 20' S of &

4. S.R. 109 - 2647.96

PIKE TWP
YORK TWP

Found Wyrick's 8"x1" Rod
on surface. Set 14"x1" pipe
over rod, driving rod
to 5' below surface
and leaving pipe
on surface.
8 Oct. 1970.
point is 0.4'
South of ctr. of
17' Bit. Mac. Post.

42.18'
15.72'
26.98'
39.36'

Dup NW/4 AP
old wit.

Dup NE/4
Panel Post

Dup N/4
old wit.

Panel Post

4 Co. Rd. H-7

S¹/₄ Post Sec 3 PIKE TWP T-7-N
N¹/₄ Post Sec 10 YORK TWP

Part, Metal =
 2 1/2" Bit, Mac,
 6" W.B. Mac,
 8 1/2" Metal
 Dup S.W.
 ATT Line
 25' North

60-d. W/S
 19" W. Oak

60-d SSE/
 21" Walnut

60-d S.W.
 1/4" Ash

63.52'
 59.99'
 80.57'

48.06'
 20.83'

STONE

stone is 14" high
 Tapered to top.
 cross-hatched "x" on 2"x3"
 rectangular shaped top

A hand-drawn survey map showing several land parcels and their boundaries. The map includes the following features:

- Roads:**
 - W¹/₄ post, Sec 2
 - E¹/₄ post, Sec 3
 - Twp. Rd. HJ7
 - S.R. 1097
- Parcels and Measurements:**
 - Parcel 1 (Top Left):** "Found Stone w/back 22" below pavt. surface. Found 10" pin 3" below and approx. over stone. Removed Pin". Dimensions: ϕ Dup W/S 93.13', ϕ Dup N/S 70.85'.
 - Parcel 2 (Top Right):** "Good Stone with N-S ridge. Est. 16'x1" pipe over stone. 15 oct. 70 Stone is 2.3' w & ctr. of 19.5' pavt.". Dimensions: 35.80', 12.2'.
 - Parcel 3 (Bottom Left):** Dimensions: ϕ Dup SE/S 32.75', ϕ 32.75'.
 - Parcel 4 (Bottom Center):** Dimensions: 33.00', 99.34'.
 - Parcel 5 (Bottom Right):** Dimensions: 50.7 + 68.10'. Note: "NW cor. west parapet #1-2 CB".
 - Other Labels:** "Sec 2", "Sec 3", "Dup NW/S", "Est. 12'x1" pipe", "PK 6", "PK 7".
- Orientation:** A north arrow pointing towards the top-left corner of the page.

PERSONNEL	TITLE	PERSONNEL	TITLE
Red Beach			
Newcomb			
Knappe			
Wise			

COUNTY Fulton DATE Oct. 1970

S. R. 109 WEATHER _____

SEC. Pike Twp TEMP. _____

DESCRIPTION

CONTROL POINTS

JOB NO.

ctr. Post Stone, Sec. 3, Pike Twp T-7-N

Found stone w/brick
9" below road surface,
chiseled "+" top of stone
lowered stone to 2.7"
below surface and est.
24"x1" pipe over stone
20 Oct. 1970

Near side 4" steel
Panhandle East.
pipeline marker

Dup E/S AP
33.91'
Dup WNW/S
underground
Pipeline
Marker post

STONE
Mens. 262.7.68'

Dup E/S
AP

Dup NE/S

20.43'

29.49'

79.7'

24.11'

33.91'

20.43'

29.49'

79.7'

24.11'

33.91'

20.43'

29.49'

79.7'

24.11'

33.91'

20.43'

29.49'

79.7'

24.11'


33.91'

20.43'


Near side 4" steel
Panhandle East.
pipeline marker

Stone is 2' east of ctr. of 14' stone Rd #9-2.
Stone is in ctr. of 14' stone Rd "HJ".
Road metal is 5" of stone & gravel on
sandy subgrade.


ctr. Post, Sec. 2, Pike Twp. T-7-N

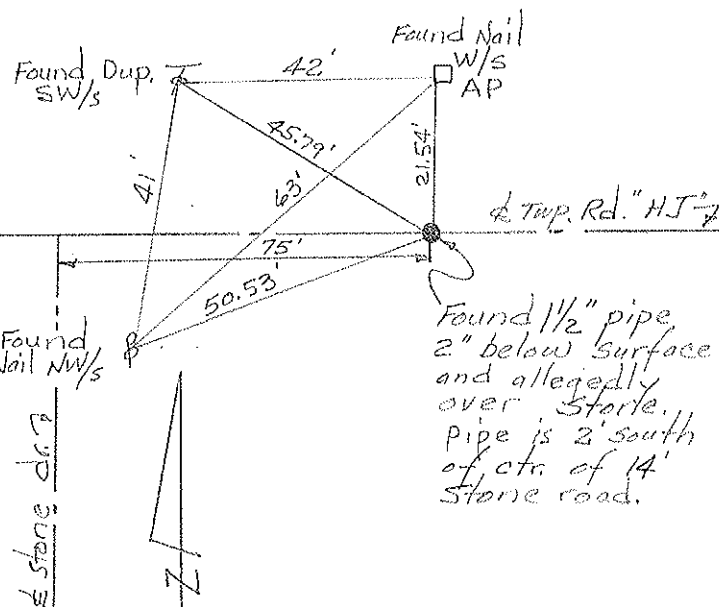

W 1/4 Post Stone, Sec. 2, Pike Twp. T-7-N
E 1/4 Post Stone, Sec. 3, Pike Twp. T-7-N

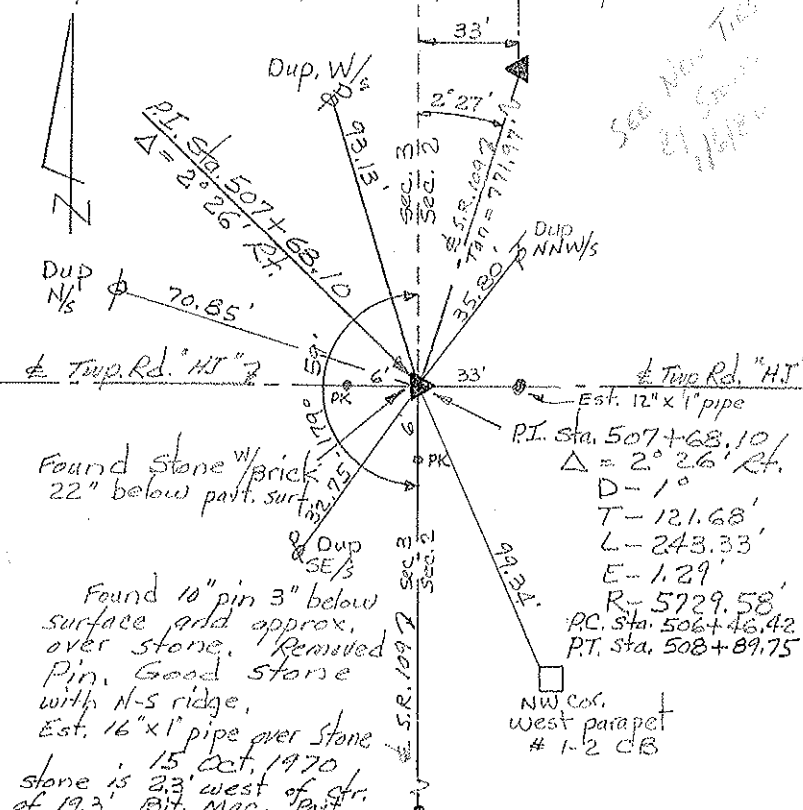

PI sta. 515 + 40.04

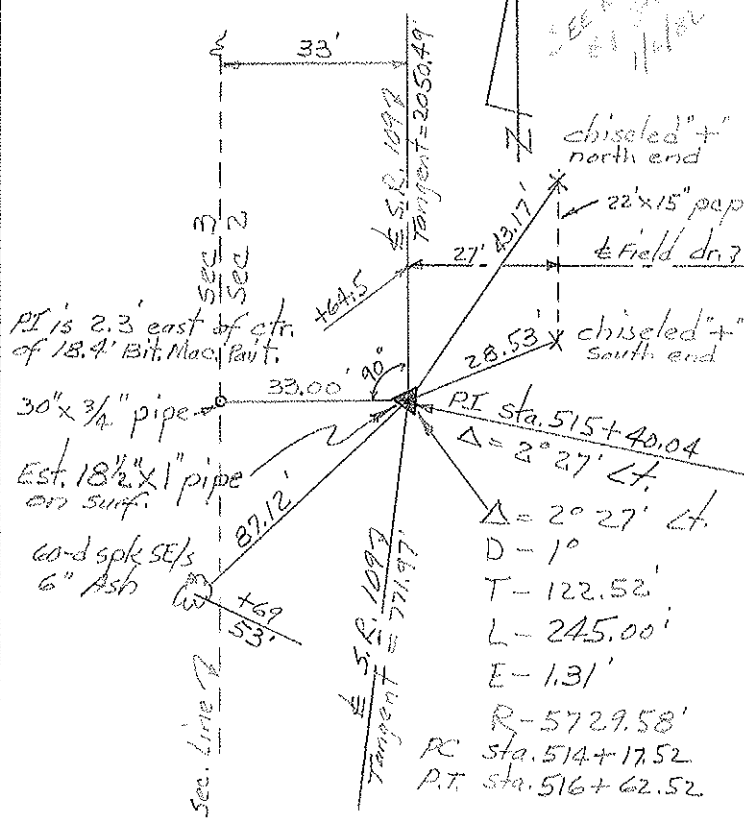

PERSONNEL	TITLE	PERSONNEL	TITLE
1	2	3	4
5	6	7	8
9	10	11	12
13	14	15	16
17	18	19	20
21	22	23	24
25	26	27	28
29	30	31	32
33	34	35	36
37	38	39	40
41	42	43	44
45	46	47	48
49	50	51	52
53	54	55	56
57	58	59	60
61	62	63	64
65	66	67	68
69	70	71	72
73	74	75	76
77	78	79	80
81	82	83	84
85	86	87	88
89	90	91	92
93	94	95	96
97	98	99	100

Red Beach

Newcomb

Кнаре

Wise

COUNTY FULTON

DATE Oct. 1970

S. R. 109

WEATHER


SEC PIRE TWP

TEMP.


DESCRIPTION

ALIGNMENT & CONTROLS

JOB NO

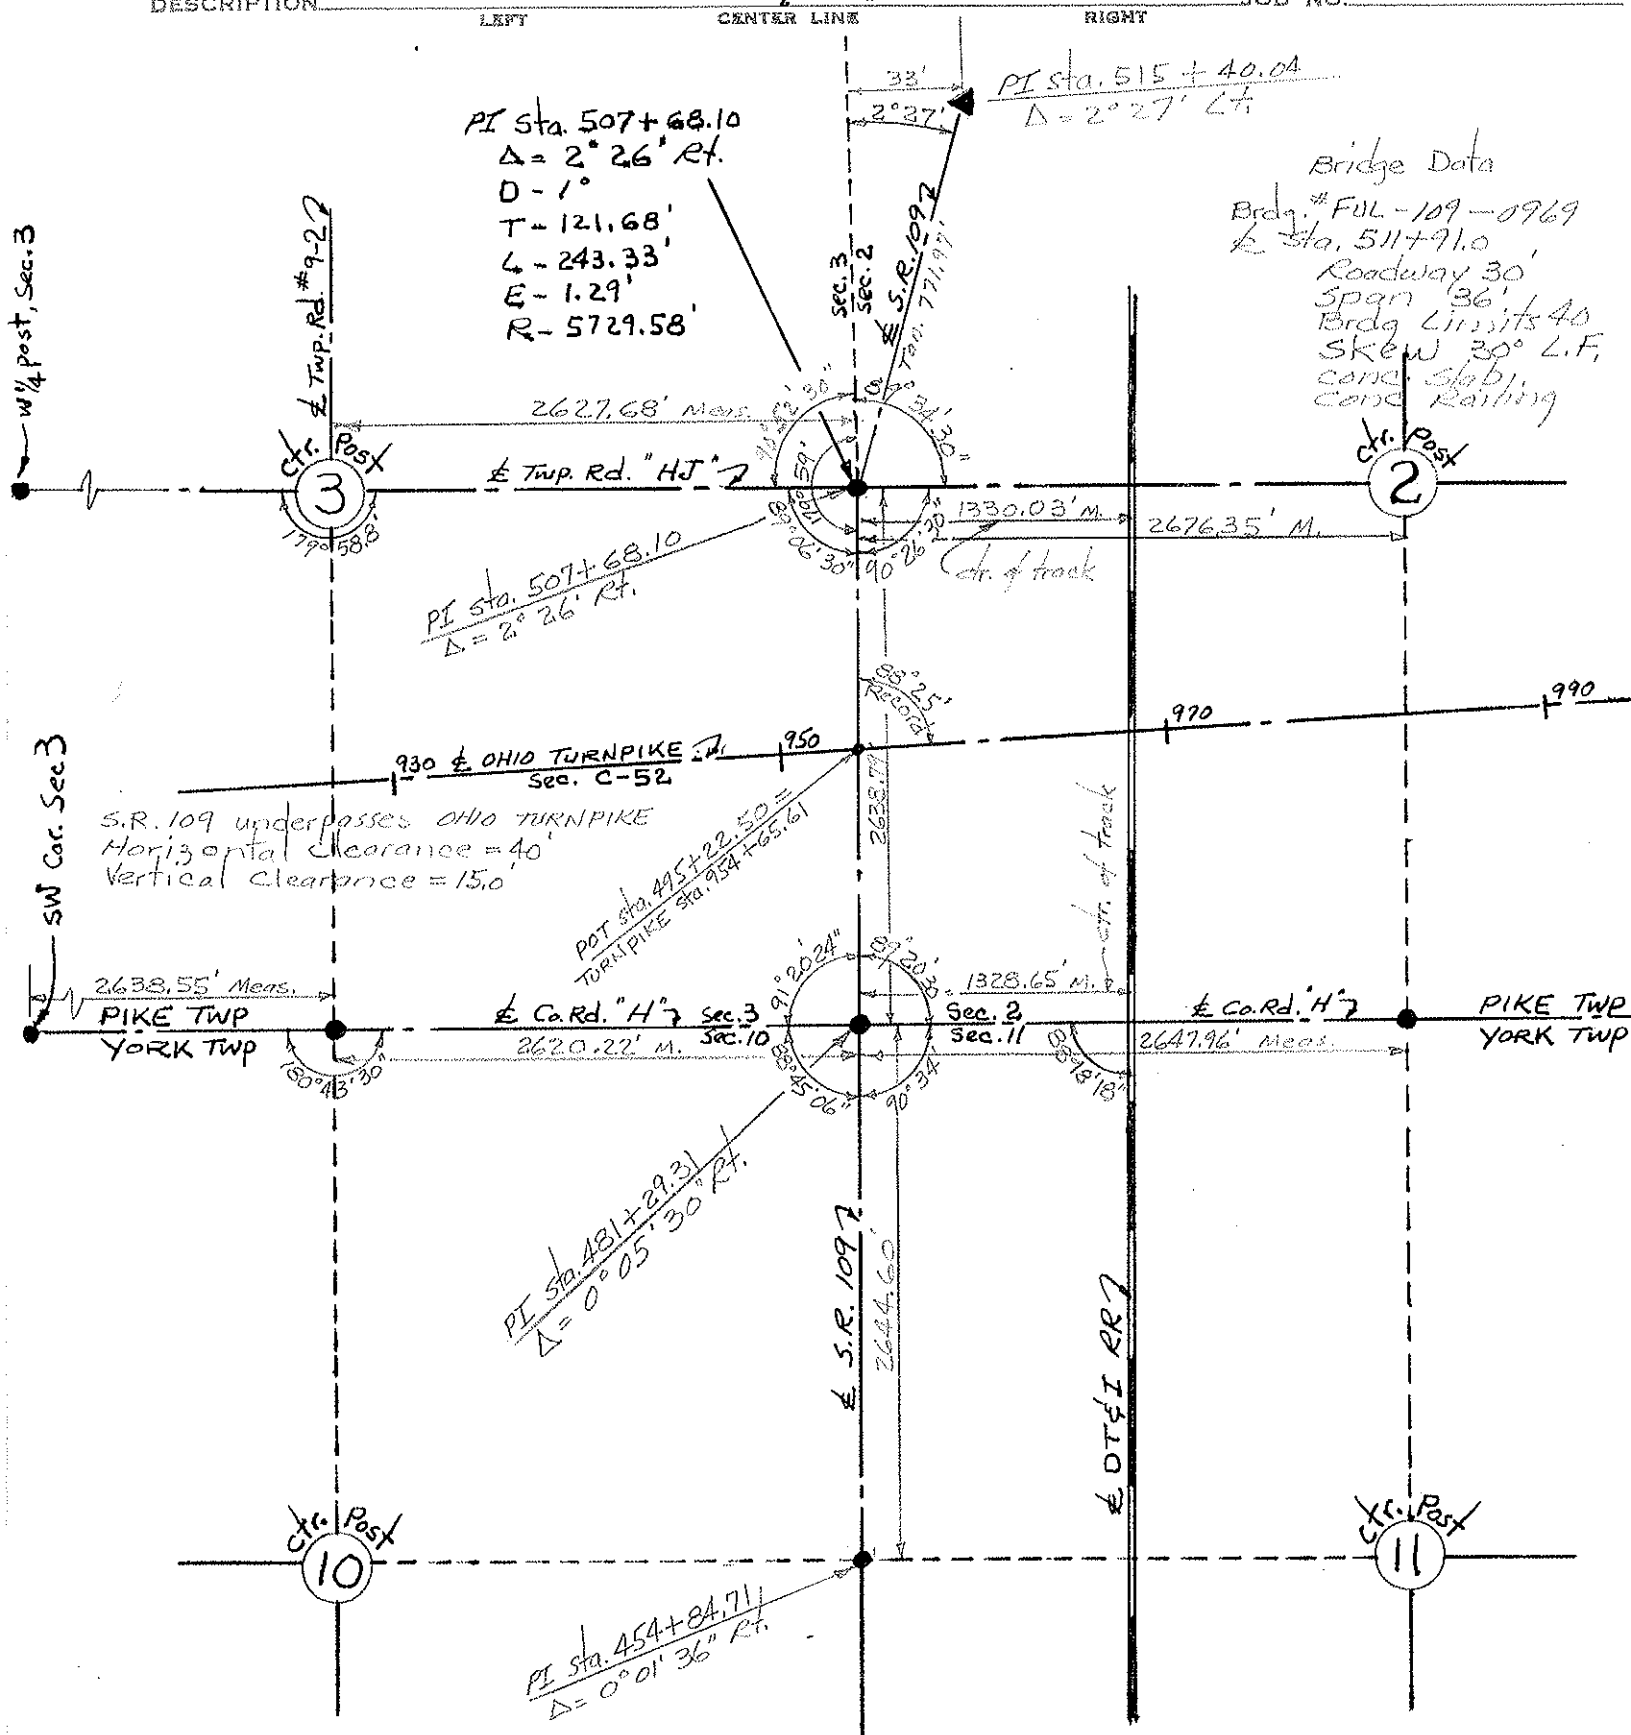

PERSONNEL	TITLE	PERSONNEL	TITLE	COUNTY	DATE
Red Beach				FULTON	OCT-NOV. '70
Newcomb				S. R. 109	WEATHER
Knappe				SEC. PIKE TWP	TEMP.
Wise					
ALIGNMENT & CONTROLS				JOB NO.	

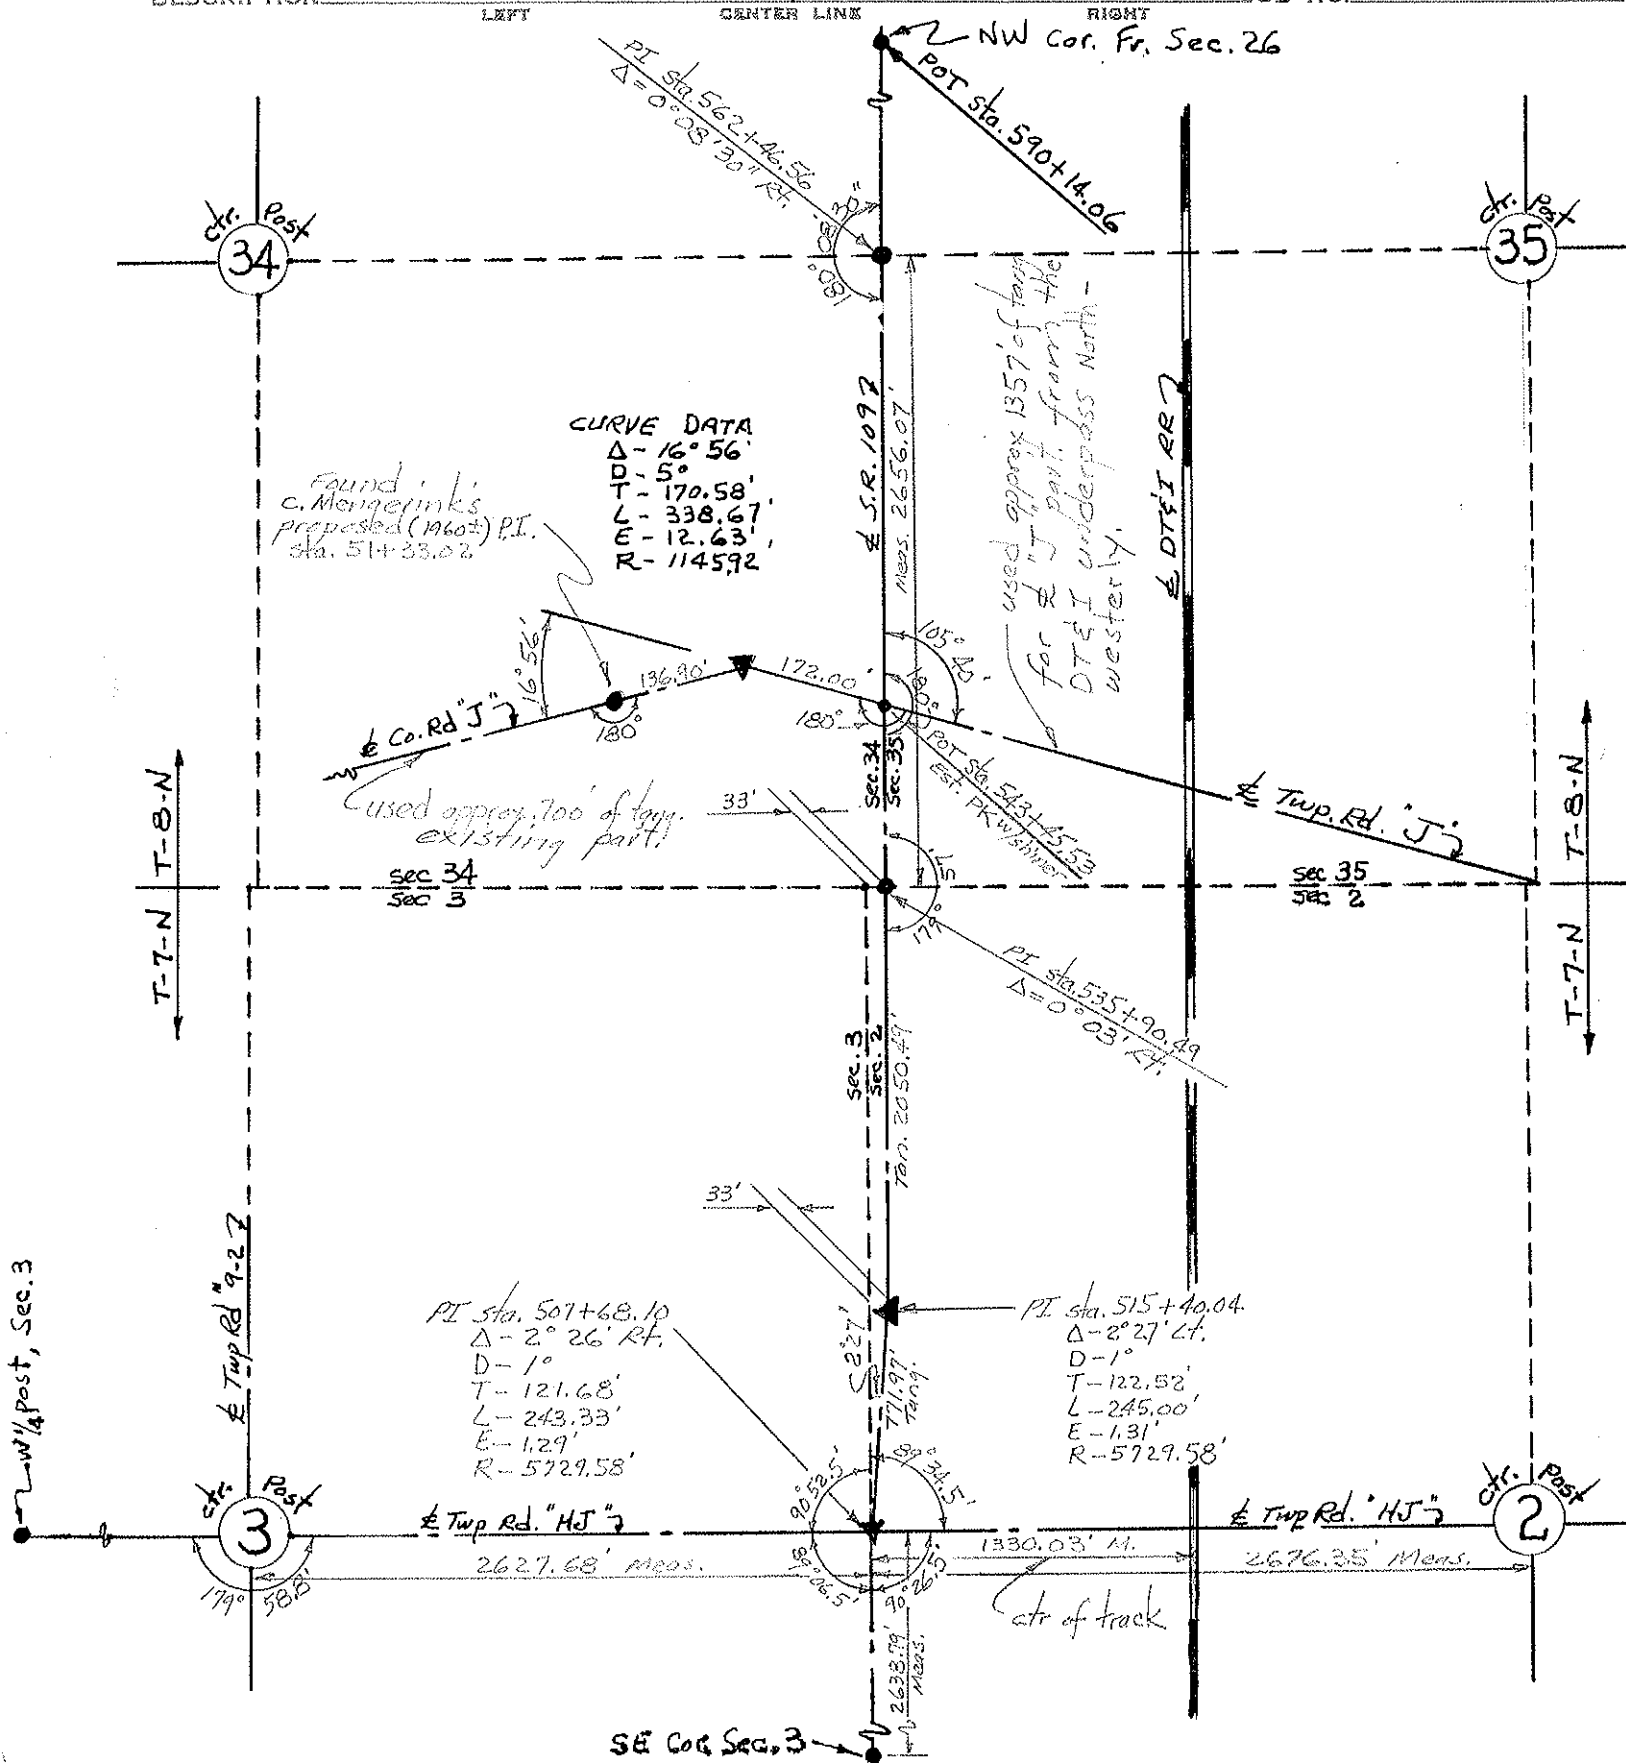

PERSONNEL	TITLE	PERSONNEL	TITLE
1	2	3	4
5	6	7	8
9	10	11	12
13	14	15	16
17	18	19	20
21	22	23	24
25	26	27	28
29	30	31	32
33	34	35	36
37	38	39	40
41	42	43	44
45	46	47	48
49	50	51	52
53	54	55	56
57	58	59	60
61	62	63	64
65	66	67	68
69	70	71	72
73	74	75	76
77	78	79	80
81	82	83	84
85	86	87	88
89	90	91	92
93	94	95	96
97	98	99	100

Red Beach

Newcomb

Knappe

Wise!

COUNTY FULTON

DATE Oct. 1970

S. R. 109

WEATHER

SEC. US-20-A North

TEMP

DESCRIPTION	ALIGNMENT & CONTROLS
-------------	----------------------

JOB NO.

LEFT

CENTER LINE

RIGHT

