


O.D.O.T. DISTRICT 2 SURVEY OFFICE (USE ONLY)


PERSONNEL _____ REFERENCE NO. 30 C SHEET 16 OF 35
 NOTES RHOADES DATE 4/26/21 ROUTE SR 109
 H.C. O'DONNELL WEATHER CLOUDY COUNTY FULTON
 R.C. NIESE TEMP. 45° TOWNSHIP PIKE
 _____ SECTION 10
 DWG BY NIESE PID PAVE TRAIN T 10 S R 3 E

TYPE MONUMENT MAG SHANK
 ON SURFACE - ~~BELOW~~ ON
 OFFSET CL PAVEMENT 2.3' LT : ~~RT~~
8.3' TO LT EDGE PAVEMENT
 STATION: 601+62.09

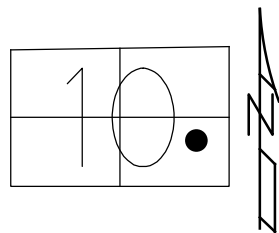

HORZ. DATUM: NAD83(2011) GEOID: 2018
 GRID: NORTHING: 715704.571 EASTING: 1548285.984

RECORD: P.T.
 1/2" IPIPE
 ±6" DOWN
 FD P.K./WASHER
 6/15/12, MC
 SET MAG/WASHER
 3/7/13, MC
 FD MAG SHANK
 REFC30
 4/26/21, JFO
 8/26/21, JFO

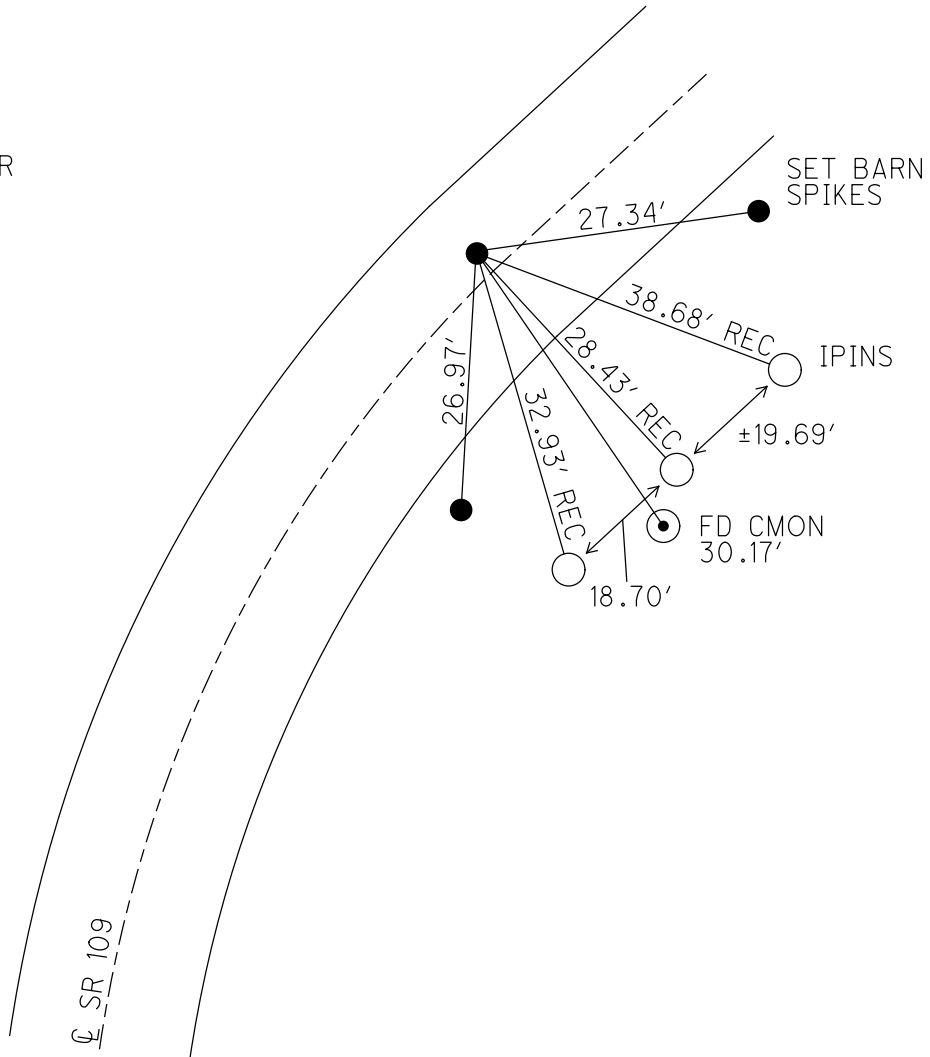

O.D.O.T. DISTRICT 2 SURVEY OFFICE (USE ONLY)

PERSONNEL

REFERENCE NO. 30-C

SHEET 17 OF 35

NOTES CANTERBURY
 H.C. ROUSOS
 R.C. LOEHRKE
HARBAUGH
COUTCHER

DATE 06-15-12
 WEATHER FAIR
 TEMP. 75°

ROUTE SR 109
 COUNTY FULTON
 TOWNSHIP PIKE
 SECTION 10
T 10 S R 3 E

TYPE MONUMENT PK/WASHER


ON SURFACE - BELOW ON

LEFT - Q PAV'T - RIGHT 2.3'

8.3' TO LT. EDGE PAVEMENT

S.L.M. 601+64

Grid: Northing: 715704.579 Easting: 1548285.934

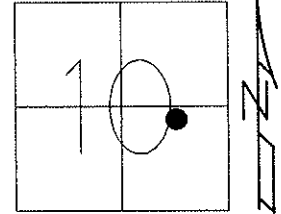


RECORD:

P.T. OF CURVE
 0.5" IRON PIPE ±6" DOWN

03-07-13 RESET MAG/WASHER, MC

06-14-12 GPS REF C30
 03-07-13 GPS FIN C30

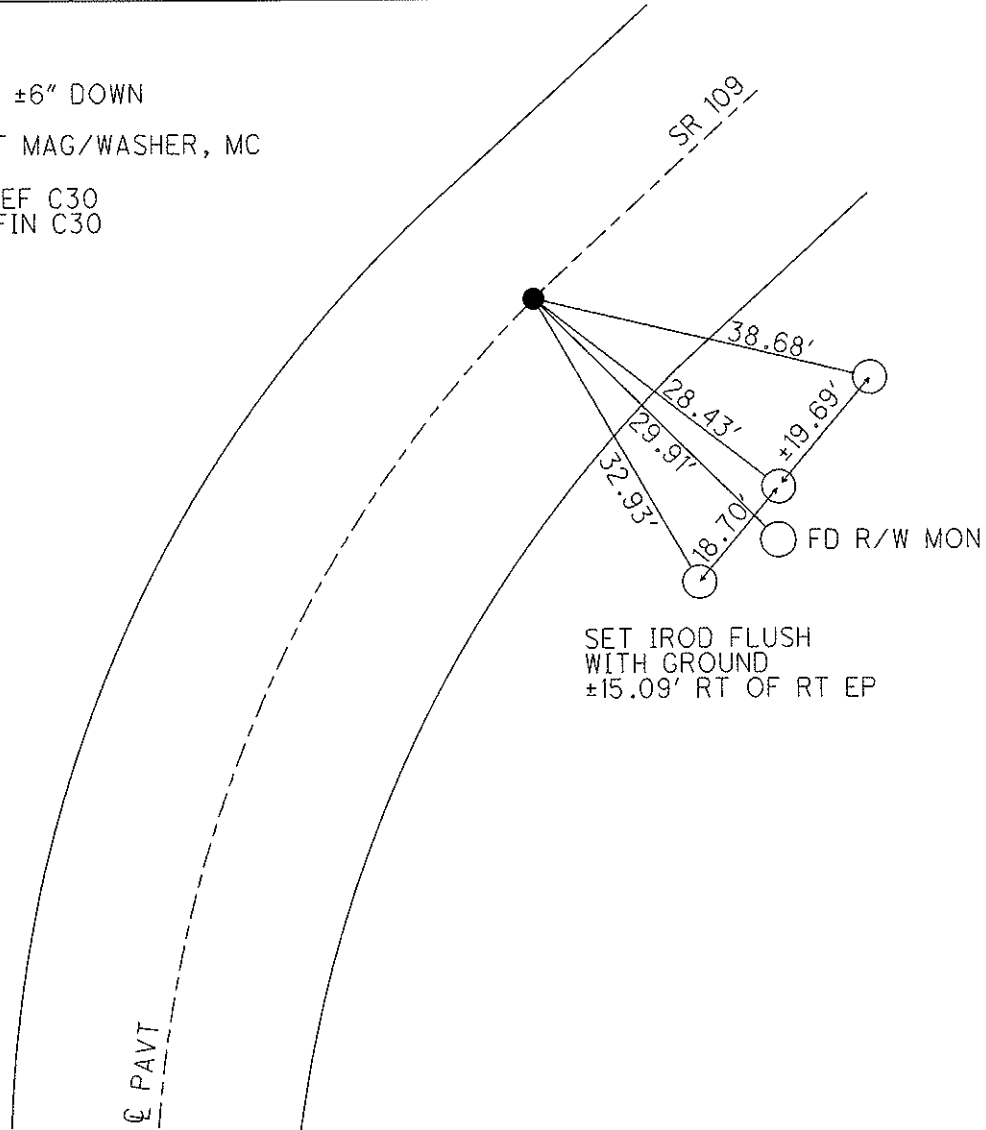

O.D.O.T. DISTRICT 2 SURVEY OFFICE

PERSONNEL _____

REFERENCE NO. 30-C

SHEET 14 OF 28

NOTES CANTERBURY

H.C. " "

R.C. LOEHRKE

DATE 8-26-96

WEATHER FAIR

TEMP. +80°

ROUTE S.R. 109

COUNTY FULTON

TOWNSHIP PIKE

SECTION 10

T 10 S R 3 E

Reset
10-2-97
C.L.


TYPE MONUMENT P.K. WASHER

ON SURFACE - BELOW YES

LEFT-~~C~~ PAV'T. - RIGHT .90 LT 2


2.265 TO LT EDGE PAVEMENT

S.L.M. 18 + 330.75 (601+64)

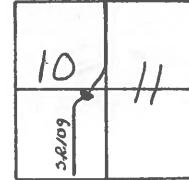

RECORD. P.T. of Curve
1/2" IRON PIPE ± 6" DOWN

SET P.K./WASHER IN LEVELING
COURSE 11/20/96. MRC

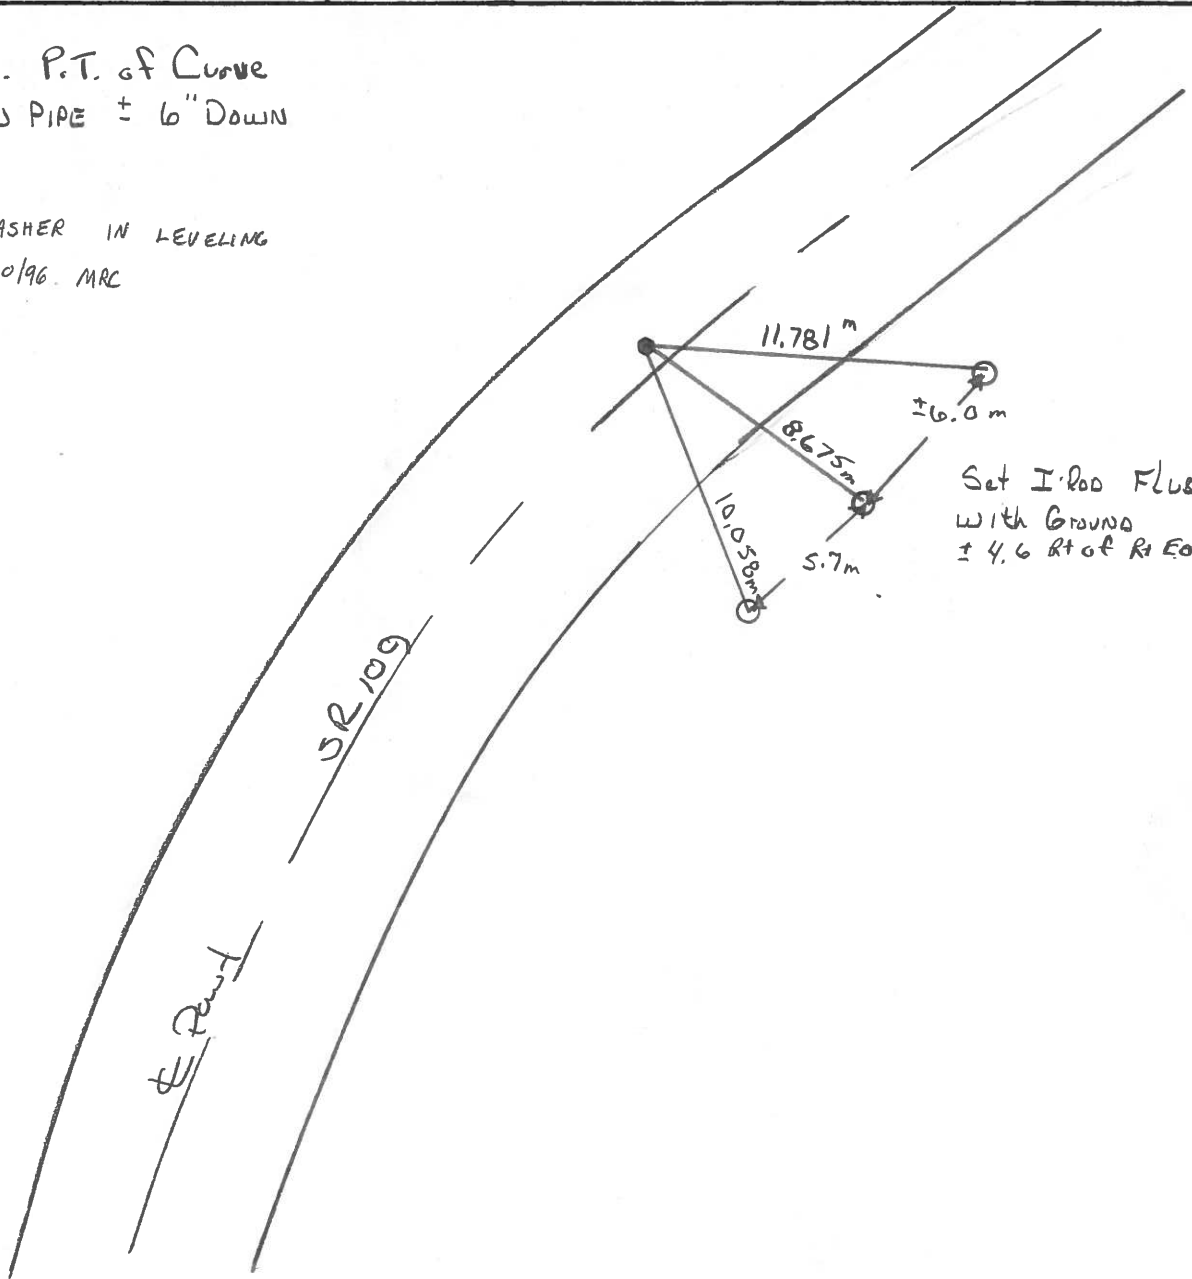

O.D.O.T. DISTRICT 2 SURVEY OFFICE

PERSONNEL

REFERENCE NO. 30-C

SHEET _____ OF _____

NOTES BARNHISEL

H.C. _____

R.C. HOFFMAN

DATE 9-5-90

WEATHER clear

TEMP. +80°

ROUTE 109

COUNTY Fulton

TOWNSHIP PIKE

SECTION 10

T. 10 S. R 3 E


TYPE MONUMENT P.K. NAIL

ON SURFACE - BELOW yes

LEFT - 0 PAV'T. - RIGHT 2.5

8.7 TO LT EDGE PAVEMENT


S.L.M. 601 + 64

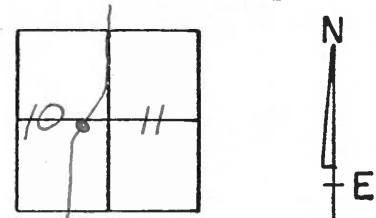

NOTE: Used tacked hubs to reset control, then removed all hubs.

Set P.K. & Washer 10-1-90 MB

Record:
P.T. OF CURVE,
Fd 1/2" I. Pipe 2" down
IN APRIL OF 1984

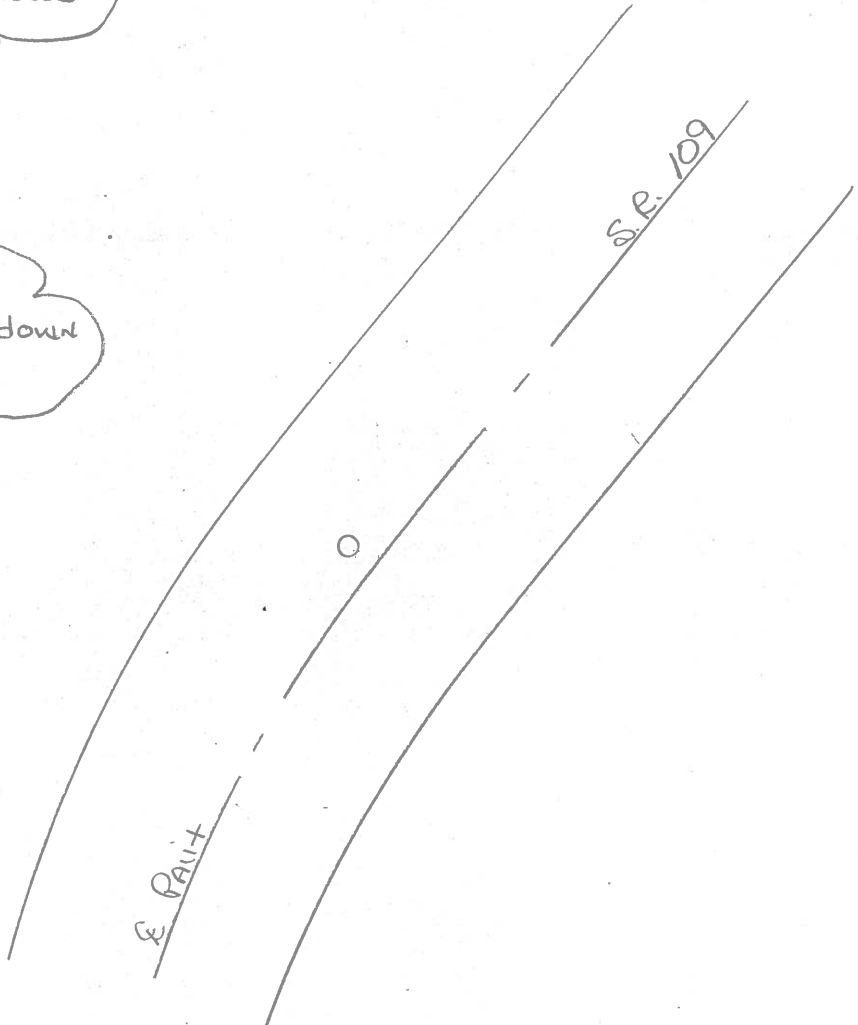

Q.D.O.T. DISTRICT 2 SURVEY OFFICE

SHEET 11 OF

County Fulton S.R. 109

Date 11 April 84

Township PIKE

Weather Fair

Section 11

Temp. 50°


T N, R E

Personnel 1. Stone

P. Neuse


R. Michalale

D. Curtis

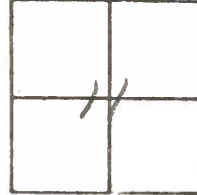

REF. NO. 30-C

601480

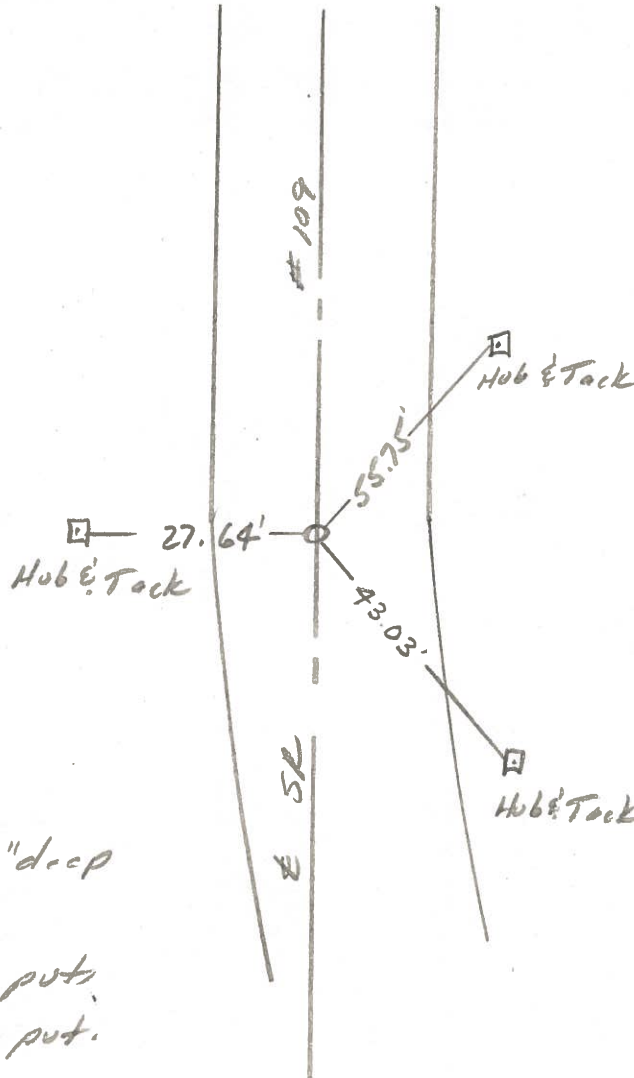

P.T. CURVE

Fd 1/2" I. pipe 2" deep
Set PK Nail

11.9' to E. edge put.
8.2' to W. edge put.


PERSONNEL	TITLE	PERSONNEL	TITLE
Tomsic			
Neuser			
Vanyo			
Granata		Boyle	

COUNTY _____ DATE July-19-73

S. R. 109 WEATHER clear


SEC. _____ TEMP. 82°

DESCRIPTION MON- LEFT CENTER LINE RIGHT JOB NO. 024610

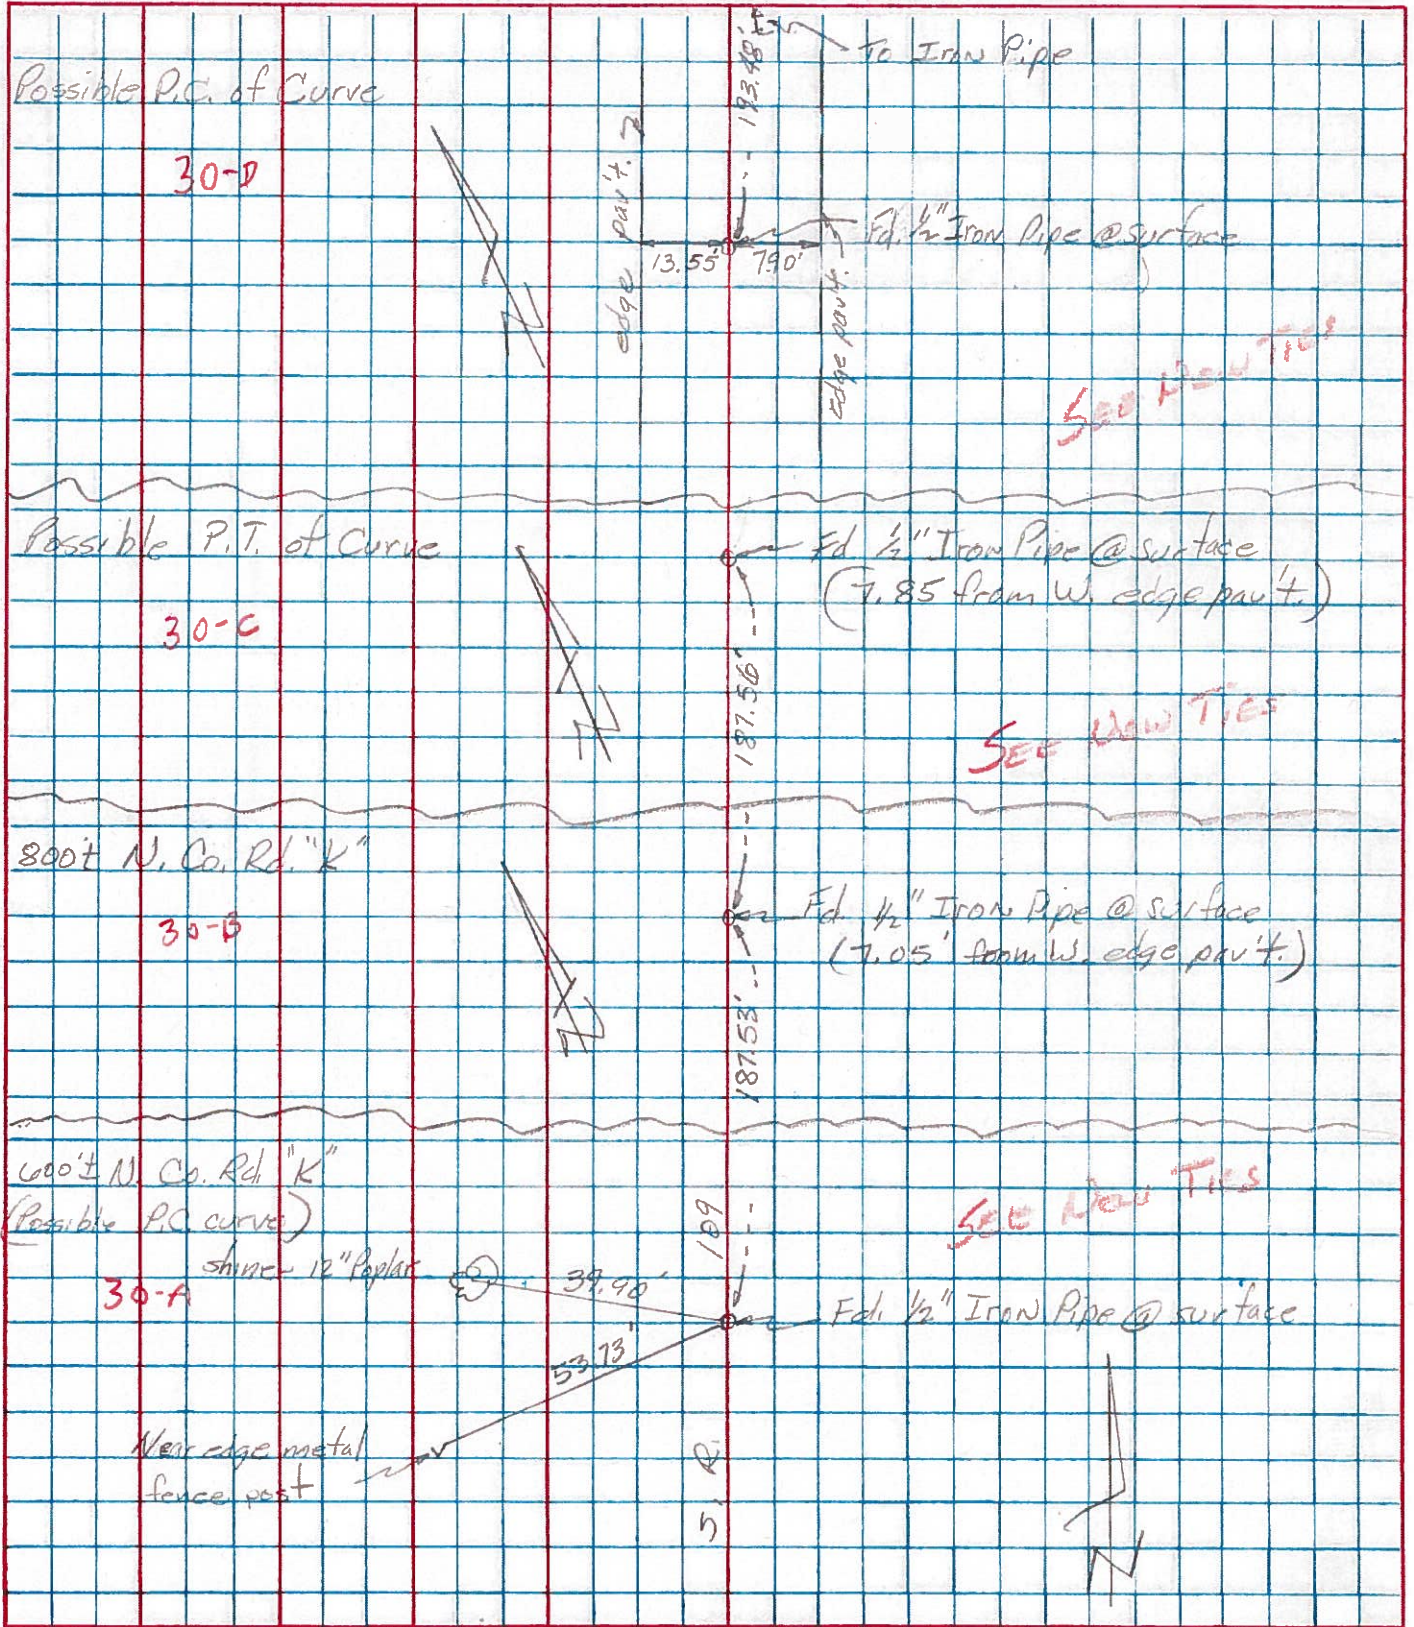

PERSONNEL	TITLE	PERSONNEL	TITLE	COUNTY	DATE
Red Beach				FULTON	Nov. 1970
Newcomb				S. R. 109	WEATHER
Knape				SEC. PIKE TWP.	TEMP.
Wise				DESCRIPTION	JOB NO.

ALIGNMENT & CONTROLS

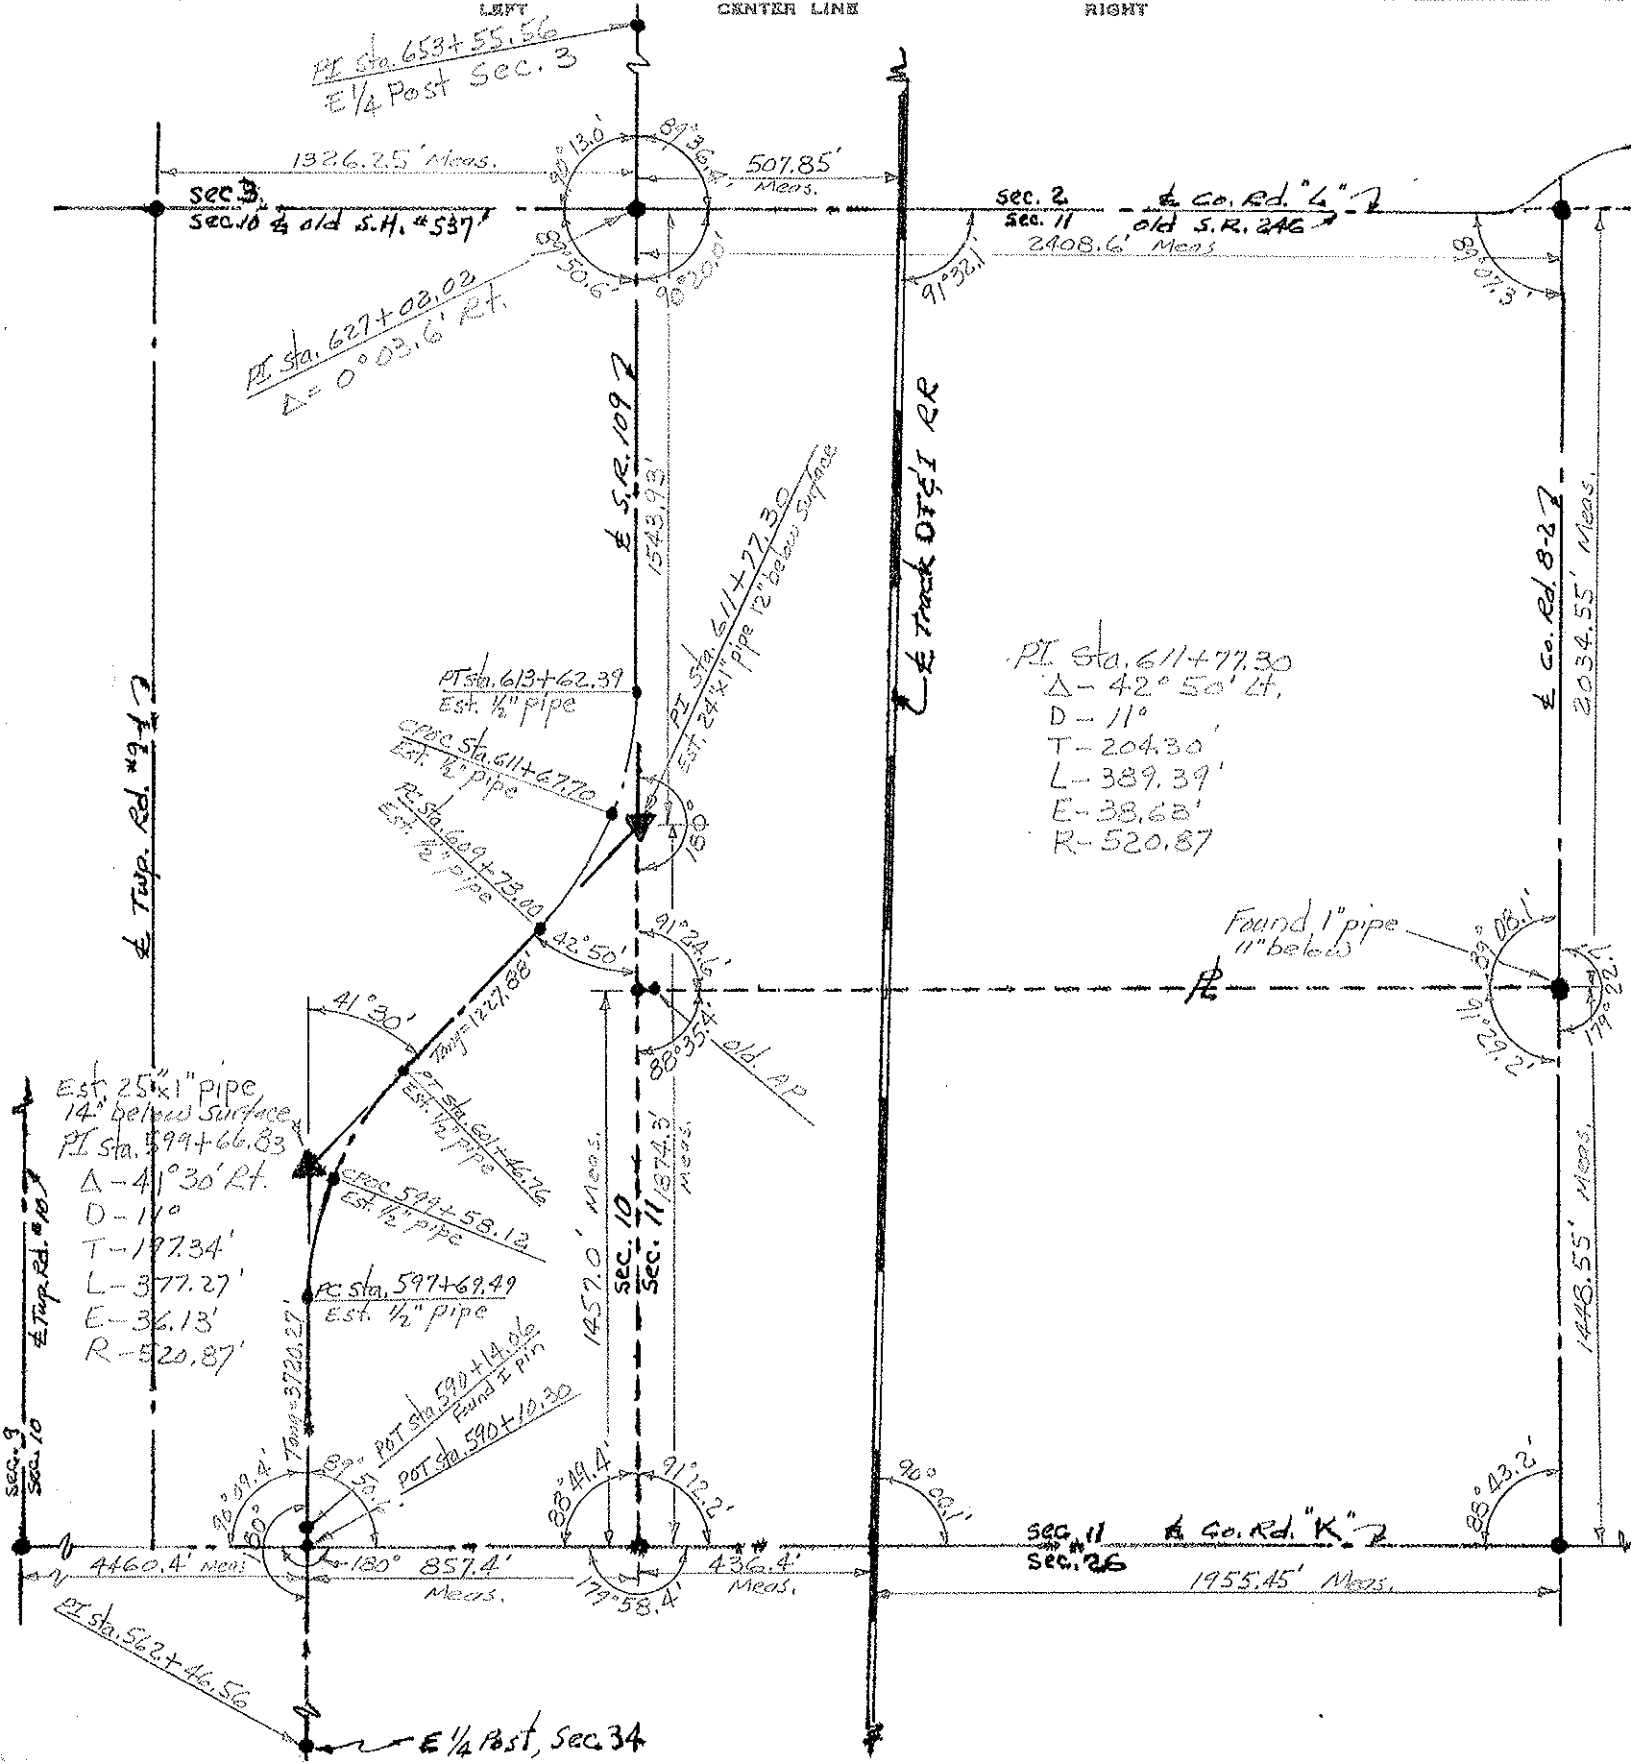

PI Sta. 653+55.56
E 1/4 Post Sec. 3

1326.25' Meas.
sec. 3
sec. 10 1/4 old S.H. #537

PI Sta. 627+02.02
Δ = 0° 03' 16" Rt.

507.85'
Meas.

sec. 2
sec. 11
2408.6' Meas.
Co. Rd. "L" 2
old S.R. 246

PI Sta. 611+77.30
Δ - 42° 50' Lt.
D - 11°
T - 204.30'
L - 389.39'
E - 38.68'
R - 520.87

Found 1" pipe
11" below

Est. 25" x 1" pipe
14" below surface
PI Sta. 599+66.83
Δ - 41° 30' Rt.
D - 11°
T - 197.34'
L - 377.27'
E - 36.13'
R - 520.87'

PI Sta. 601+46.76
Est. 1/2" pipe
PI Sta. 599+58.12
Est. 1/2" pipe
PI Sta. 597+69.49
Est. 1/2" pipe

PI Sta. 590+14.86
Found E Pipe
PI Sta. 590+10.30

PI Sta. 611+67.70
Est. 1/2" pipe
PI Sta. 613+62.39
Est. 1/2" pipe

sec. 10
sec. 11
1874.3' Meas.

1457.0' Meas.

179° 58.4'

436.4' Meas.

sec. 11
sec. 26
1955.45' Meas.
Co. Rd. "K" 2

PI Sta. 562+46.56

E 1/4 Post, Sec. 34

PERSONNEL	TITLE	PERSONNEL	TITLE	COUNTY	DATE
Red Beach				FULTON	Nov. 1970
Newcomb				S. R. 109	WEATHER
Knape				SEC. PIKE TWP.	TEMP
Wise					

CONTROL POINTS

DESCRIPTION	LEFT	CENTER LINE	RIGHT	JOB NO.
-------------	------	-------------	-------	---------

