


O.D.O.T. DISTRICT 2 SURVEY OFFICE (USE ONLY)


PERSONNEL	REFERENCE NO. <u>36-B</u>	SHEET <u>28</u> OF <u>35</u>
NOTES <u>HARBAUGH</u>	DATE <u>06-25-12</u>	ROUTE <u>SR 109</u>
H.C. <u>HUSS</u>	WEATHER <u>FAIR</u>	COUNTY <u>FULTON</u>
R.C. <u>COUTCHER</u>	TEMP. <u>68°</u>	TOWNSHIP <u>PIKE</u>
		SECTION <u>35</u>
		T <u>9</u> S R <u>3</u> E

TYPE MONUMENT _____ PK/WASHER _____
 ON SURFACE - BELOW _____ 0.1' _____
 LEFT - ϕ PAV'T - RIGHT _____ 3.8' _____
 _____ 6.0' TO LT EDGE PAVEMENT _____
 S.L.M. _____ 716+78 _____

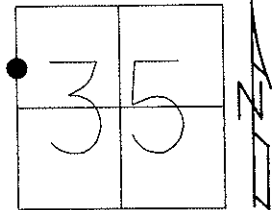

Grid: Northing: 726856.335 Easting: 1548945.965

11-23-96 SET PK/WASHER
 IN LEVELING COURSE, MRC
 03-08-13 RESET MAG/WASHER, MC
 06-25-12 GPS REF B36, SAH
 03-08-13 GPS FIN B36, MC

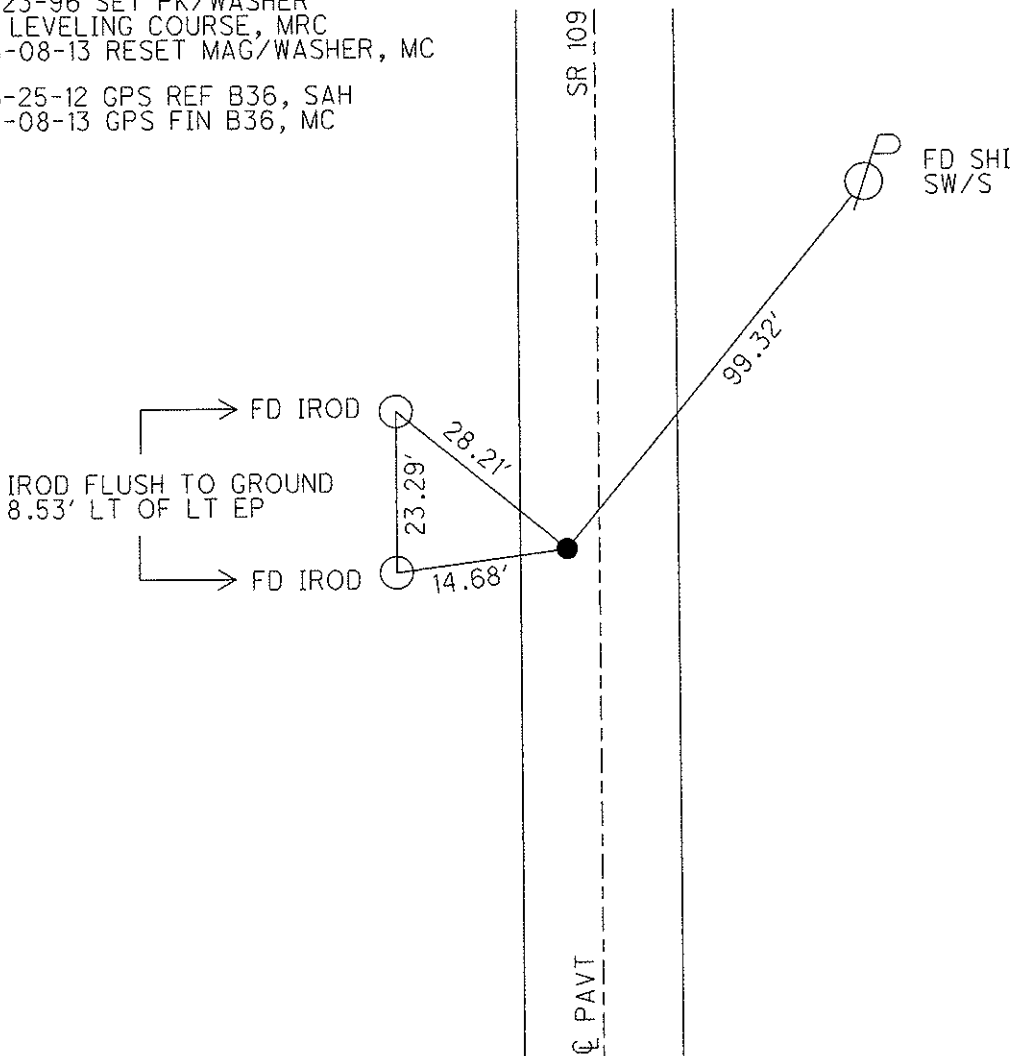

O.D.O.T. DISTRICT 2 SURVEY OFFICE

PERSONNEL _____

REFERENCE NO. 36-B SHEET 24 OF 28

NOTES CANTERBURY

H.C. Rouses

R.C. CANTERBURY

DATE 9-3-96

WEATHER FAIR

TEMP. +80°

ROUTE SR 109

COUNTY FULTON

TOWNSHIP PIKE

SECTION 35

T 9 S R 3 E

Reset
10-6-97
C.L.


TYPE MONUMENT P.K. / WASHER

ON SURFACE - ~~BELOW~~ Yes


LEFT - CL PAV'T. - ~~RIGHT~~ 1.04 LT &

1.705 TO LT EDGE PAVEMENT

S.L.M. 21 + 807 (716 + 78)

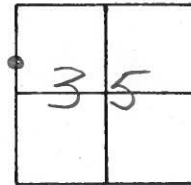

SET P.K./WASHER IN LEVELING
Course 11/23/96. MRC.

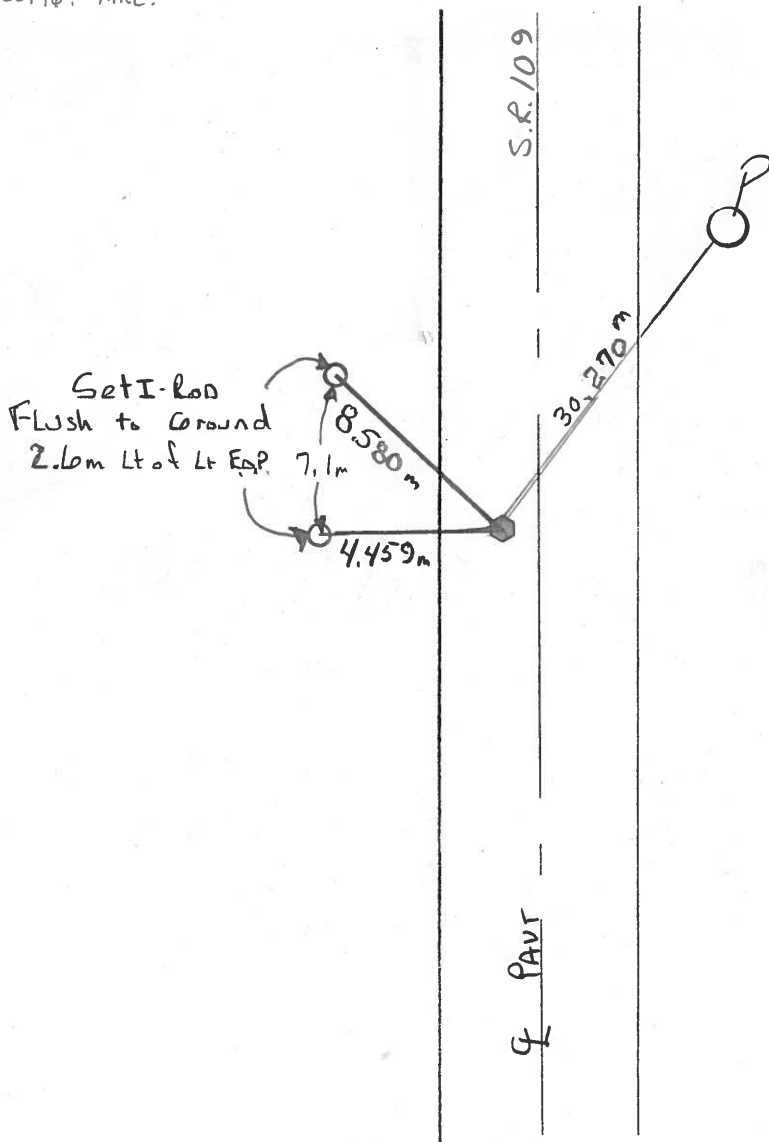

O.D.O.T. DISTRICT 2 SURVEY OFFICE

PERSONNEL _____

REFERENCE NO. 36-B

SHEET _____ OF _____

NOTES BAENHISEL

H.C. " "

DATE 9-4-90

ROUTE 109

R.C. HOFFMAN

WEATHER CLEAR

COUNTY Fulton

TEMP. +85°

TOWNSHIP PIKE

SECTION 35

T 9 S R 3 E


TYPE MONUMENT Sm RR Spk

ON SURFACE - ~~BELOW~~ YES


LEFT-~~C~~ PAV'T. - RIGHT 3.7

6.0 TO LT EDGE PAVEMENT

S.L.M. 716 + 78

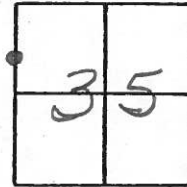

SET PK & Washers
 10-1-90
 MB

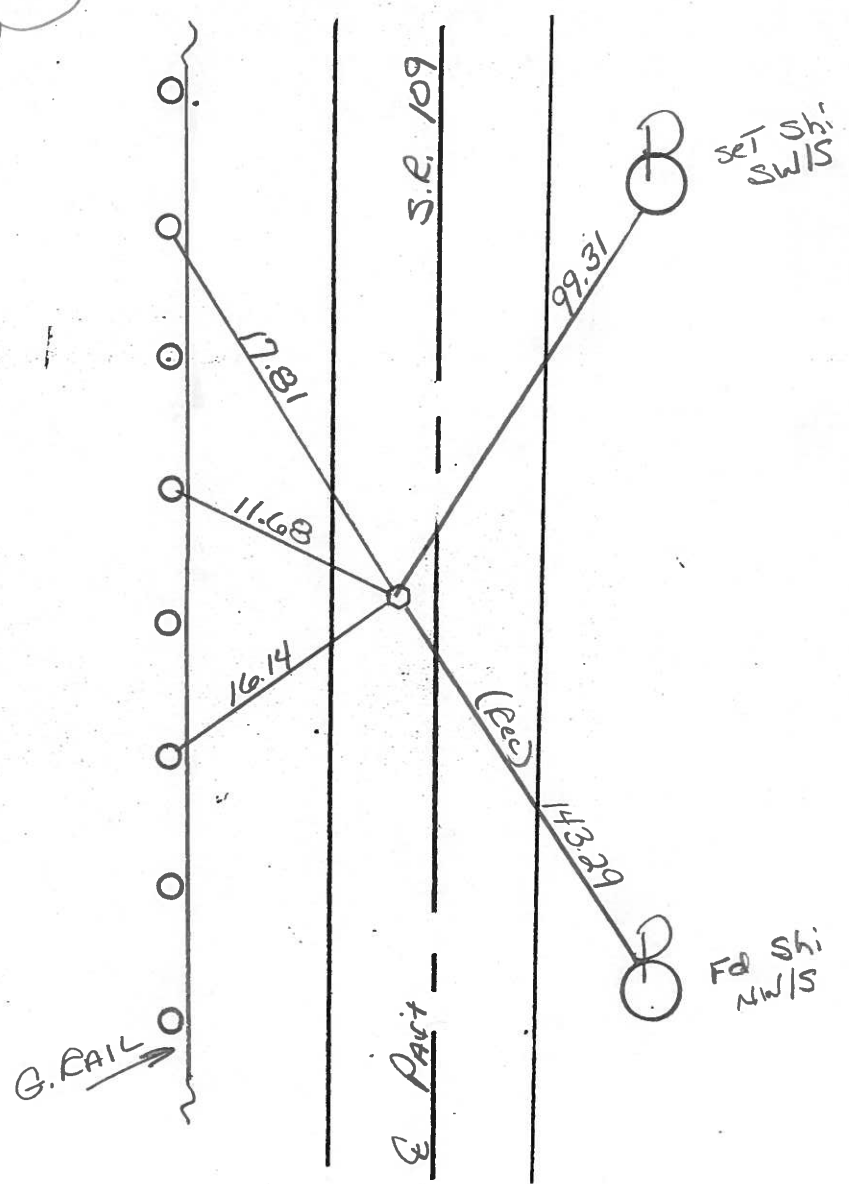

Q.D.O.T. DISTRICT 2 SURVEY OFFICE

SHEET 21 OF

County Fulton S.R. 109

Date 12 April 84

Township Pike


Weather Sunny

Section 35

Temp. 52°

T N, R E

Personnel W. Stone

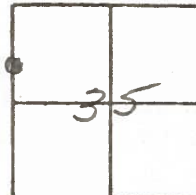


P. Neuse

R. Michalak

D. Curtis

REF. NO. 36-15

7154 93

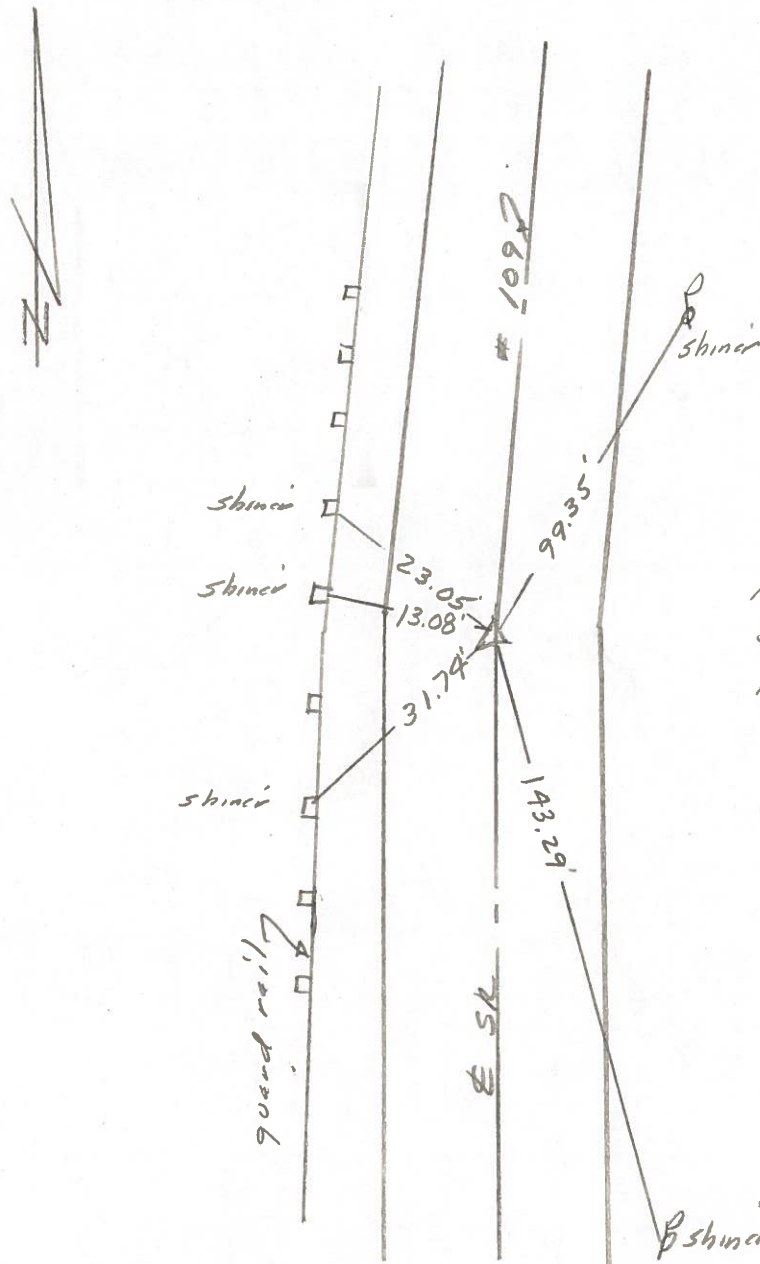

Fd 1/2" I.P. pipe 1 1/2" deep
Set Small Spk. 6/21/83
12.9' to E. edge put
6.0' to W. edge put.

PERSONNEL TITLE PERSONNEL TITLE


COUNTY Fulton DATE 24-25 Feb '77

Red Beach
W. Knape

S. R. 109 WEATHER _____

SEC. PIKE TWP TEMP. _____

DESCRIPTION CONTROL POINTS JOB NO. _____

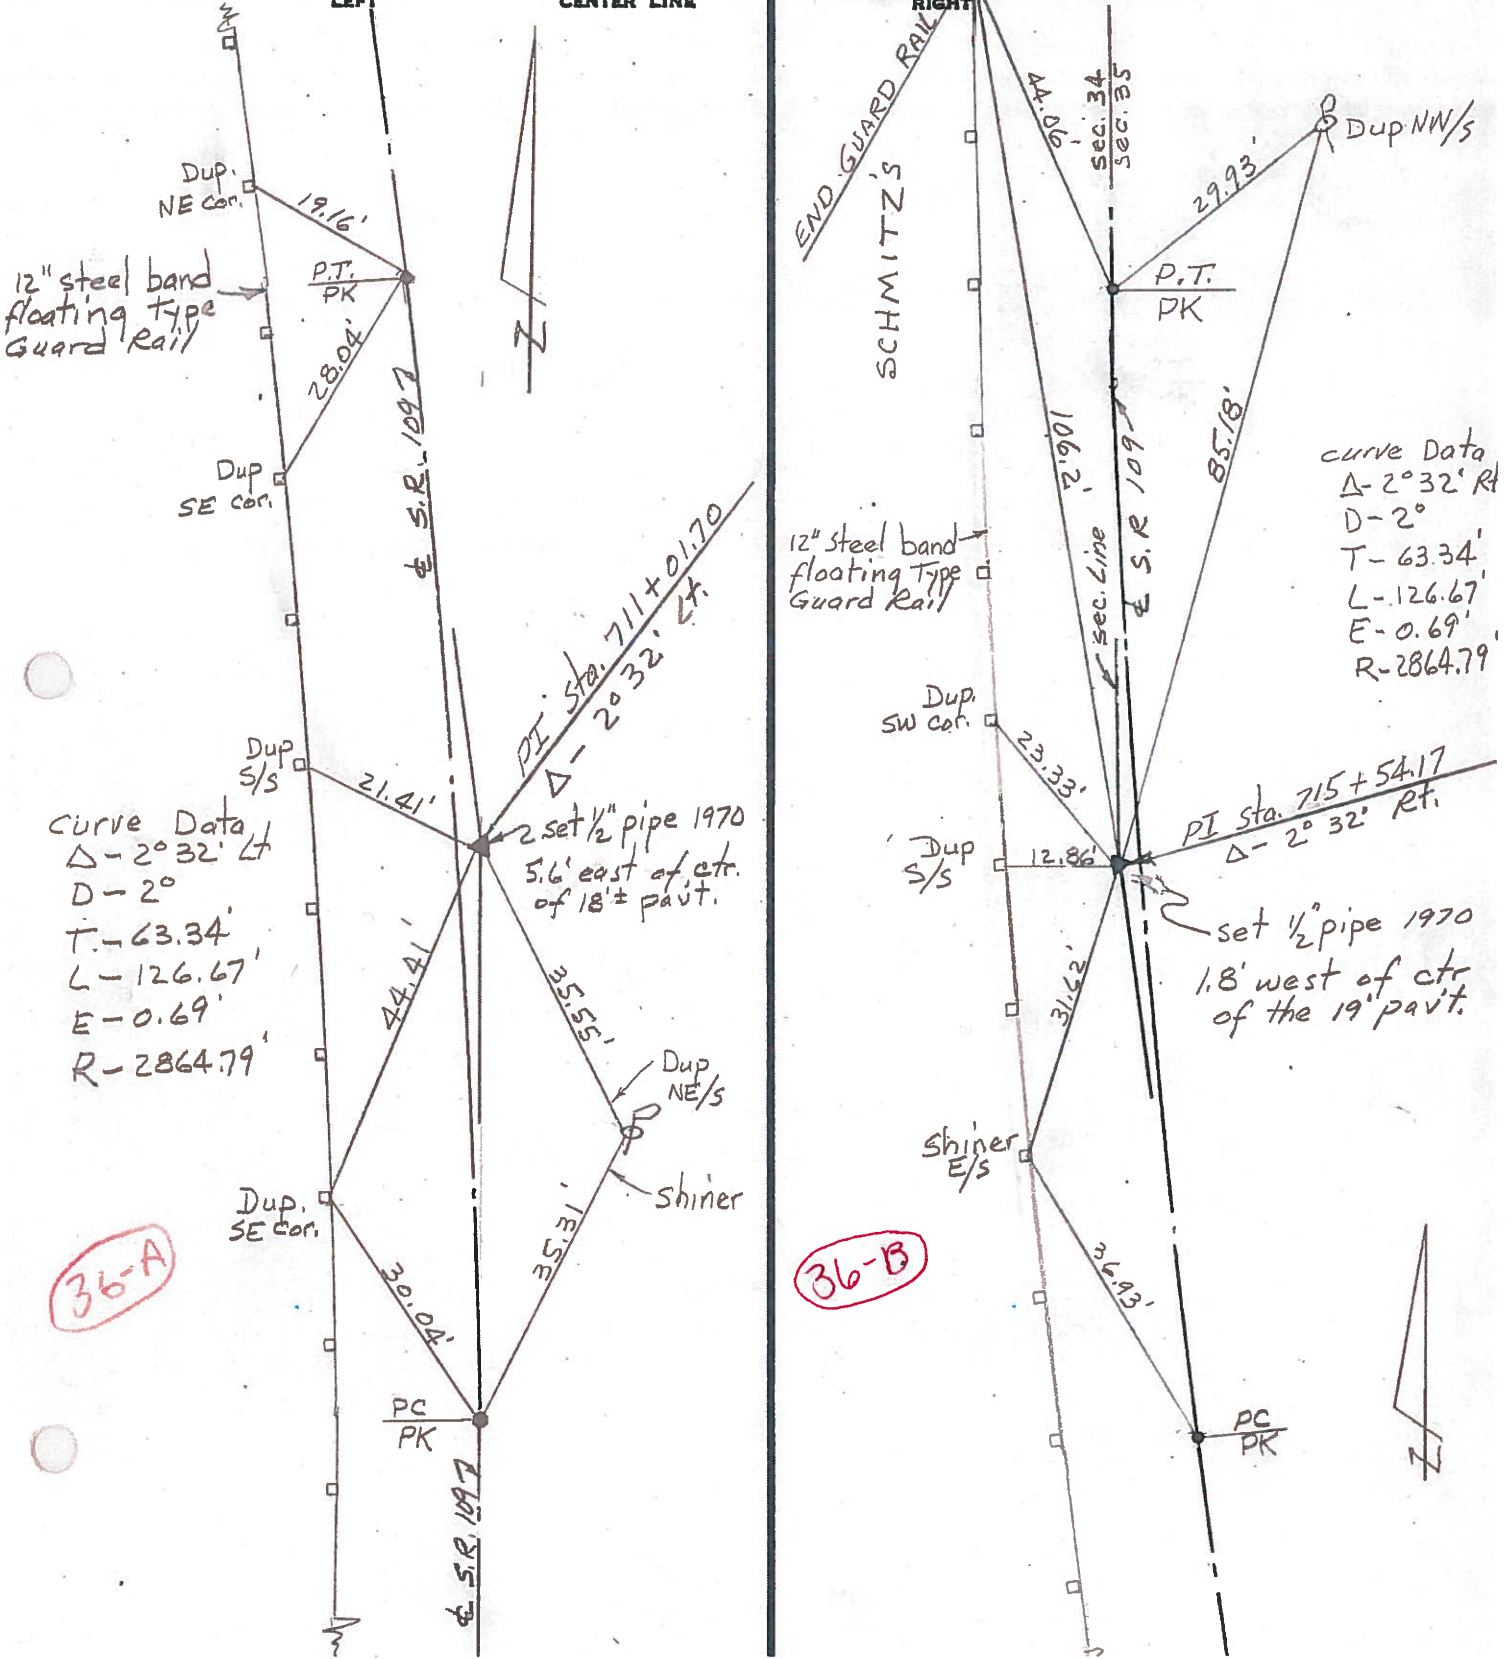

PERSONNEL	TITLE	PERSONNEL	TITLE	COUNTY	DATE	WEATHER	TEMP.
Tamsic		Boyle		Fulton	JULY, 23, 1973		
Neuser				S. R. 109			
Granata				SEC. Royalton Twp			
Vanya							

DESCRIPTION _____ LEFT _____ CENTER LINE _____ RIGHT _____ JOB NO. _____

