

O.D.O.T. DISTRICT 2 SURVEY OFFICE (USE ONLY)

PERSONNEL

REFERENCE NO. 38 D

SHEET 35 OF 35

NOTES HOFFMAN

DATE 5/26/81

ROUTE 109

H.C. HOUSEHOLDER

WEATHER CLOUDY

COUNTY FULTON

R.C. LOEHRKE

TEMP. 70

TOWNSHIP ROYALTON

SECTION 23

T 9 S R 3 E

TYPE MONUMENT IRON PIN W/ DRILL HOLE


ON SURFACE - BELOW ON

LEFT - Q PAV'T - RIGHT ON


TO EDGE PAVEMENT

S.L.M. _____

GRID: NORTHING: _____ EASTING: _____

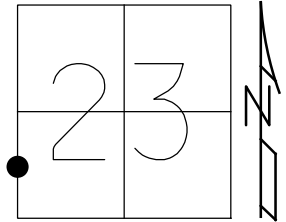

RECORD:
 FD IRON PIN
 W/ DRILL HOLE
 5-26-81, HOFFMAN
 DNF
 1-30-17 JFO

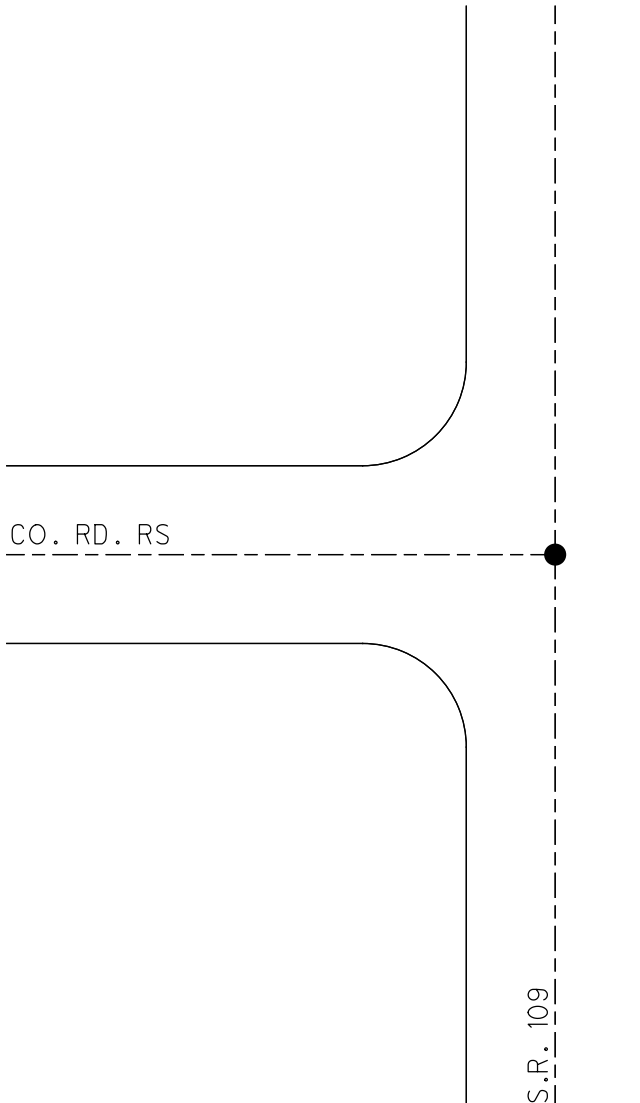

S.R. 109