


O.D.O.T. DISTRICT 2 SURVEY OFFICE (USE ONLY)


PERSONNEL _____ REFERENCE NO. 1 SHEET 1 OF 50
 NOTES NIESE _____ DATE 4/27/22 ROUTE SR 120
 H.C. O'DONNELL _____ WEATHER BREEZY COUNTY FULTON
 R.C. AUBLE _____ TEMP. 37° TOWNSHIP CHESTERFIELD
 PARADYSZ _____ SECTION 9
 DWG BY RHOADES _____ PID 99582 T 9 N R 2 E

TYPE MONUMENT MAG/WASHER
 ON SURFACE - ~~BELOW~~ ON
 OFFSET Q PAVEMENT 2.0' ~~LT~~ : RT
8.4' TO RT EDGE PAVEMENT
 STATION: 0+00

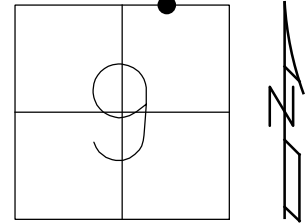

HORIZ. DATUM: NAD83 2011 GEOID: NAVD88 2012A
 GRID: NORTHING: 749435.590 EASTING: 1510950.832


RECORD:
 1926 PLAN
 FD R.R.SPIKE
 8/19/02, DCH
 FD MAG/WASHER
 REF1
 5/12/17
 5/7/19, JLL
 FD MAG/WASHER
 REF1
 9/22/20, JFO
 2/26/21, JMR
 4/27/22, JFO
 SET MAG/WASHER
 7/26/22, TDN

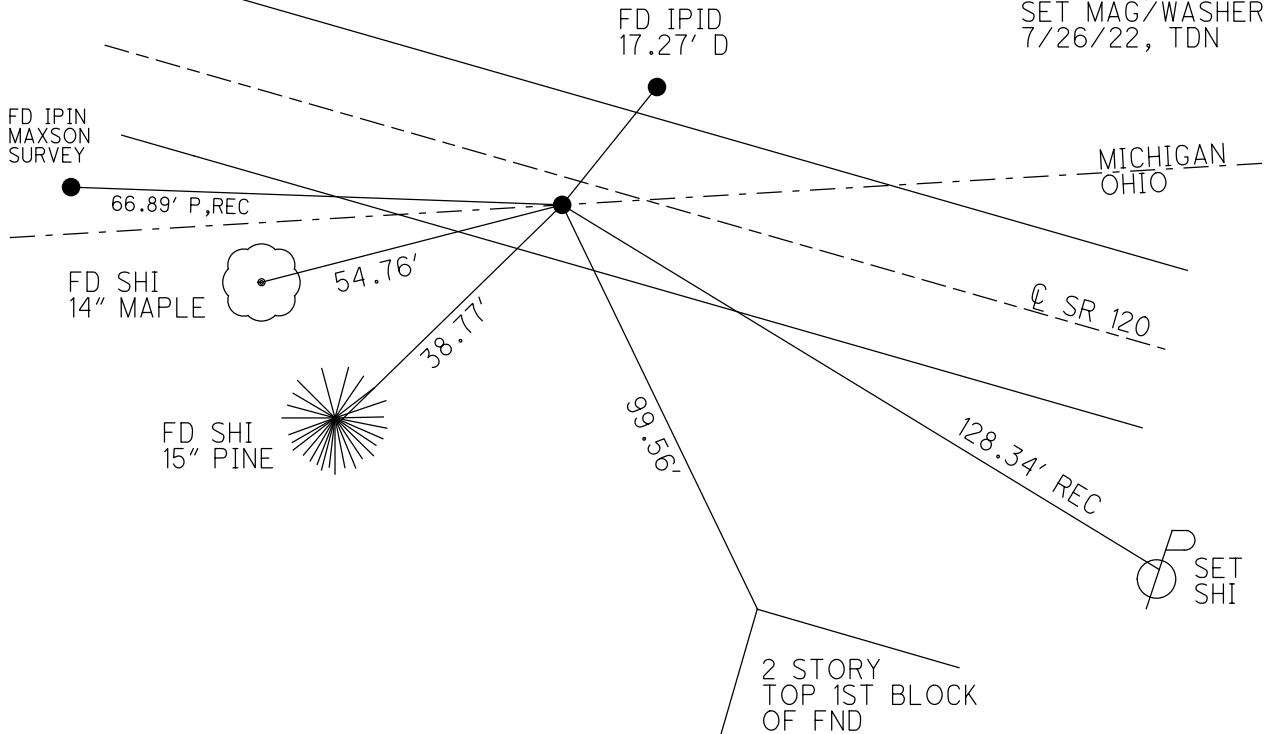

O.D.O.T. DISTRICT 2 SURVEY OFFICE (USE ONLY)


PERSONNEL _____ REFERENCE NO. 1 SHEET 1 OF 47
 NOTES NIESE _____ DATE 2/26/21 ROUTE SR 120
 H.C. RHOADES _____ WEATHER FAIR COUNTY FULTON
 R.C. _____ TEMP. 30° TOWNSHIP CHESTERFIELD
 DWG BY NIESE _____ PID PAVETRAIN _____ SECTION 9
 T 9 N R 2 E

TYPE MONUMENT MAG/WASHER
 ON SURFACE - ~~BELOW~~ ON
 OFFSET CL PAVEMENT 2.0' ~~LT~~ : RT
8.4' TO RT EDGE PAVEMENT
 STATION: 0+00

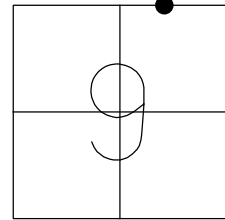

HORZ. DATUM: NAD83 2011 GEOID: NAVD88 2012A
 GRID: NORTHING: 749435.625 EASTING: 1510950.879


RECORD:
 1926 PLAN
 FD RR SPIKE
 8/19/02, DCH
 FD MAG/WASHER
 REF1
 5/12/17, JLL
 FD MAG/WASHER
 REF1
 9/22/20, JFO
 2/26/21, JMR

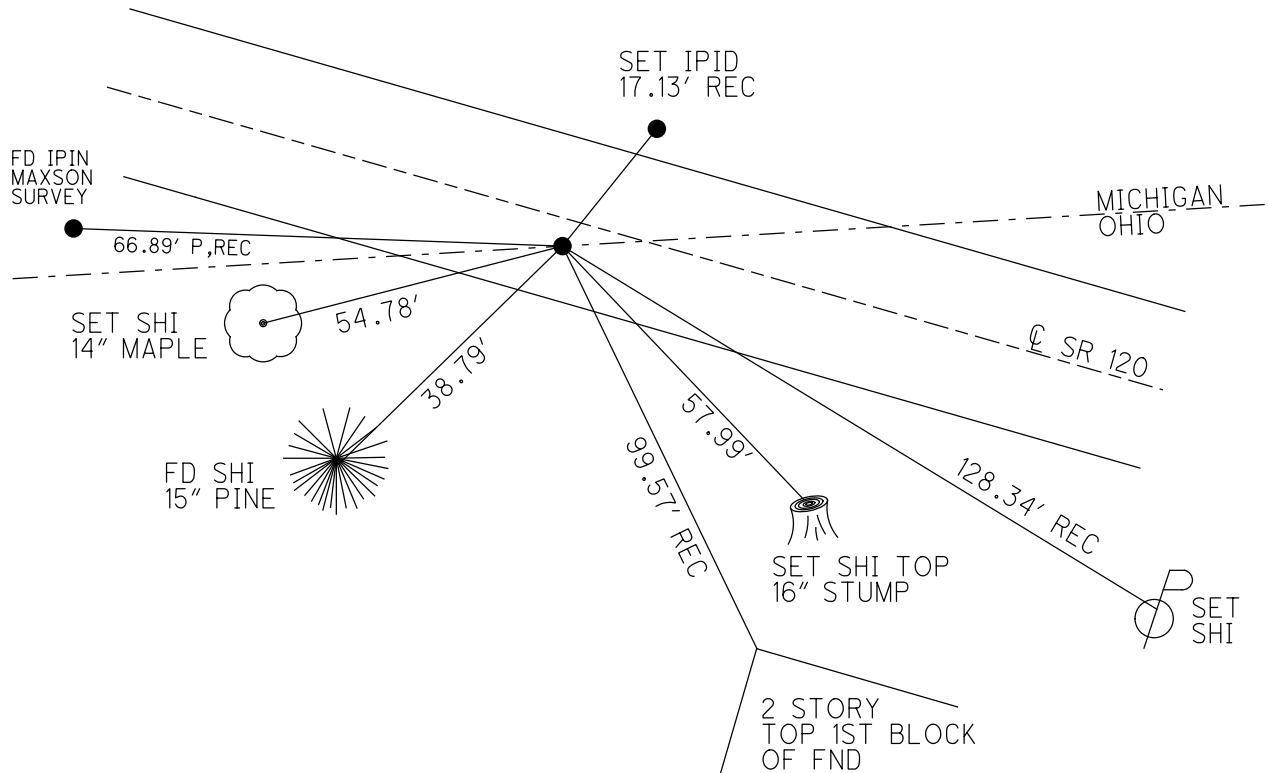

O.D.O.T. DISTRICT 2 SURVEY OFFICE (USE ONLY)


PERSONNEL _____ REFERENCE NO. 1 SHEET 1 OF 47
 NOTES RHOADES DATE 9/22/20 ROUTE SR 120
 H.C. O'DONNELL WEATHER SUNNY COUNTY FULTON
 R.C. AUBLE TEMP. 51° TOWNSHIP CHESTERFIELD
 DWG BY RHOADES PID PAVETRAIN SECTION 9
 T 9 N R 2 E

TYPE MONUMENT MAG/WASHER
 ON SURFACE - ~~BELOW~~ ON
 OFFSET \varnothing PAVEMENT 2.0' ~~LT~~ : RT
8.4' TO RT EDGE PAVEMENT
 STATION: 0+00

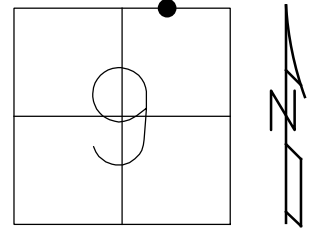

HORZ. DATUM: NAD83 2011 GEOID: NAVD88 2012A
 GRID: NORTHING: 749435.625 EASTING: 1510950.879


RECORD:
 1926 PLAN
 FD RR SPIKE
 8-19-02, DCH
 FD MAG/WASHER
 REF1
 5-12-17, JLL
 FD MAG/WASHER
 REF1
 9/22/20, JFO

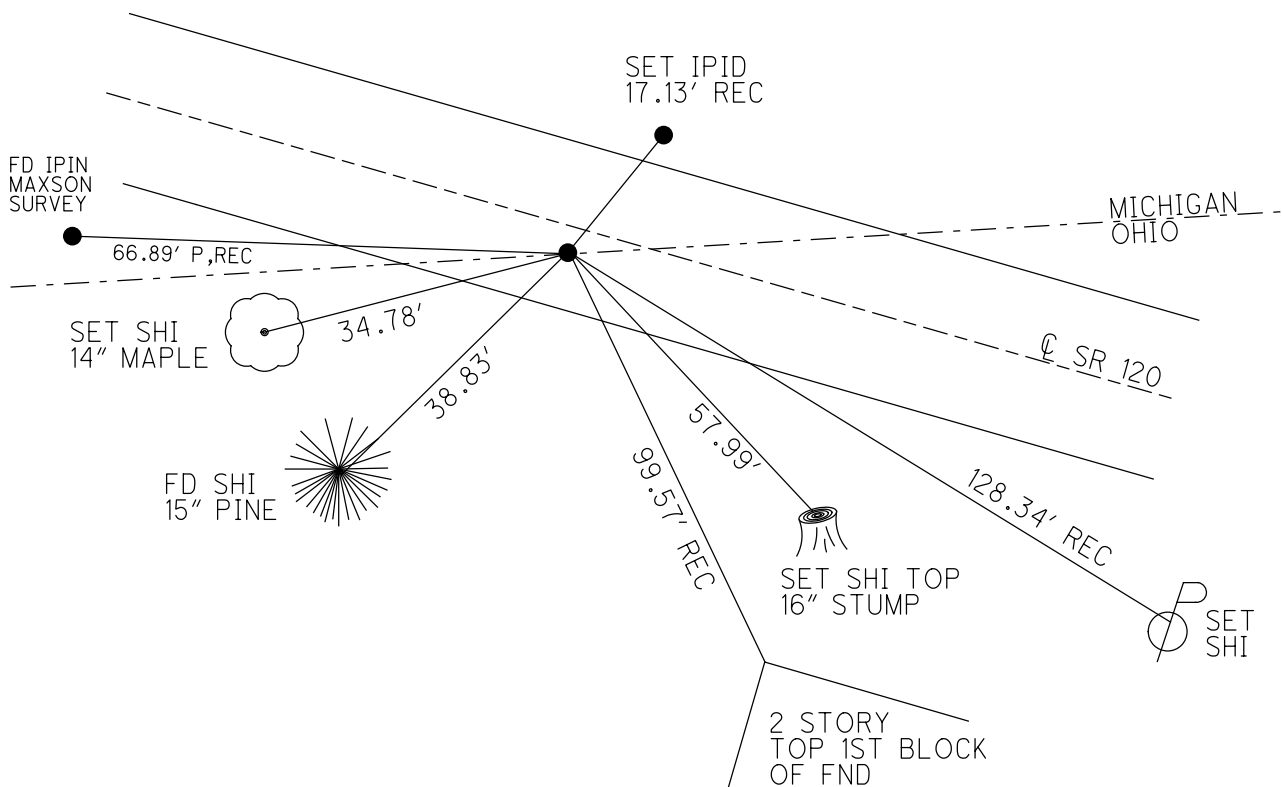

O.D.O.T. DISTRICT 2 SURVEY OFFICE (USE ONLY)


PERSONNEL _____ REFERENCE NO. 1 SHEET 1 OF 45
 NOTES LEU _____ DATE 5/12/17 ROUTE SR 120
 H.C. HOMAN WEATHER SUNNY COUNTY FULTON
 R.C. LEU TEMP. 59° TOWNSHIP CHESTERFIELD
 _____ SECTION 9
 _____ T 9 N R 2 E

TYPE MONUMENT MAG/WASHER
~~ON SURFACE~~ - BELOW ON
~~LEFT~~ - ℄ PAV'T - RIGHT 2.0'
8.4' TO RT EDGE PAVEMENT
 S.L.M. 0+00

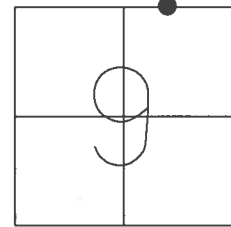

GRID: NORTHING: 749435.643 EASTING: 1510950.821

RECORD: 1926 PLAN
 FD R.R. SPIKE
 8/19/02, DCH
 FD MAG/WASHER
 REF1
 5/12/17, JLL

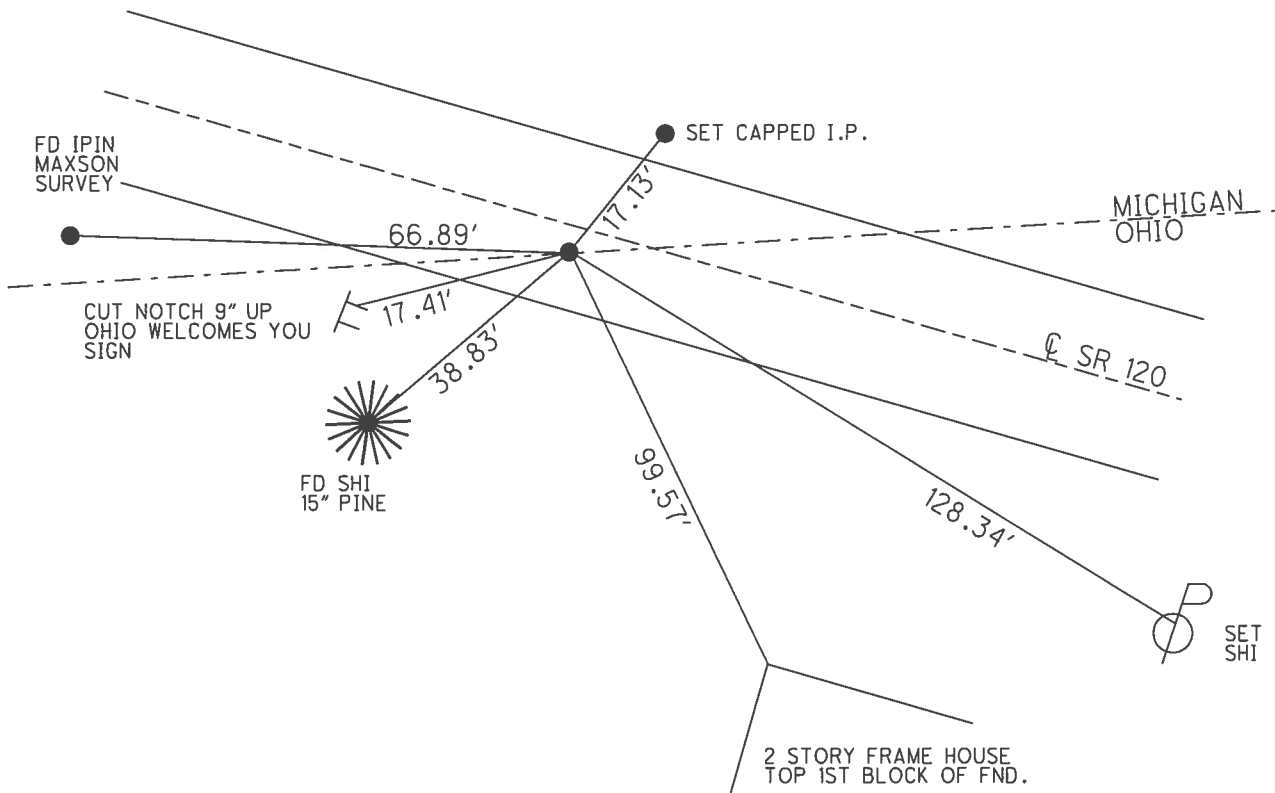

O.D.O.T. DISTRICT 2 SURVEY OFFICE

PERSONNEL _____

REFERENCE NO. 1 A

SHEET 1 OF 45

NOTES HOMAN

DATE 8/19/02

ROUTE SR 120

H.C. NUHFER

WEATHER SUNNY

COUNTY FULTON

R.C. MEYERS

TEMP. 71°

TOWNSHIP CHESTERFIELD

SECTION 9

T 9 N R 2 E

TYPE MONUMENT R.R.SPIKE


~~ON SURFACE~~ - BELOW 10"

~~LEFT~~ - Q PAV'T - RIGHT 2.0'

8.4' TO RT EDGE PAVEMENT

S.L.M. 0+00

Grid: Northing: _____ Easting: _____

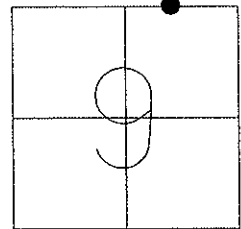

REFERENCE TO 1926 PLAN:
FD R.R.SPIKE, ORIGINAL REF.
TIE TO HOUSE FIT PLAN

