

O.D.O.T. DISTRICT 2 SURVEY OFFICE

PERSONNEL _____

REFERENCE NO. _____

SHEET 3 OF _____

NOTES 1. Stone

H.C. D. Curtis

R.C. J. Householder

DATE 12 June 90

WEATHER Fair

TEMP. 68°

ROUTE SR#120

COUNTY Fulton

TOWNSHIP Chesterfield

SECTION 10

T _____ R _____


TYPE MONUMENT PK Nail

ON SURFACE - BELOW Surface

LEFT - \odot PAV'T. - RIGHT _____


_____ TO _____ EDGE PAVEMENT

S.L.M. 49+77

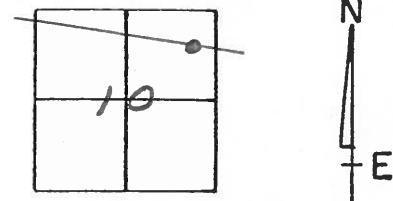

Set PK Nail 8-8-90 IKS

2 AB

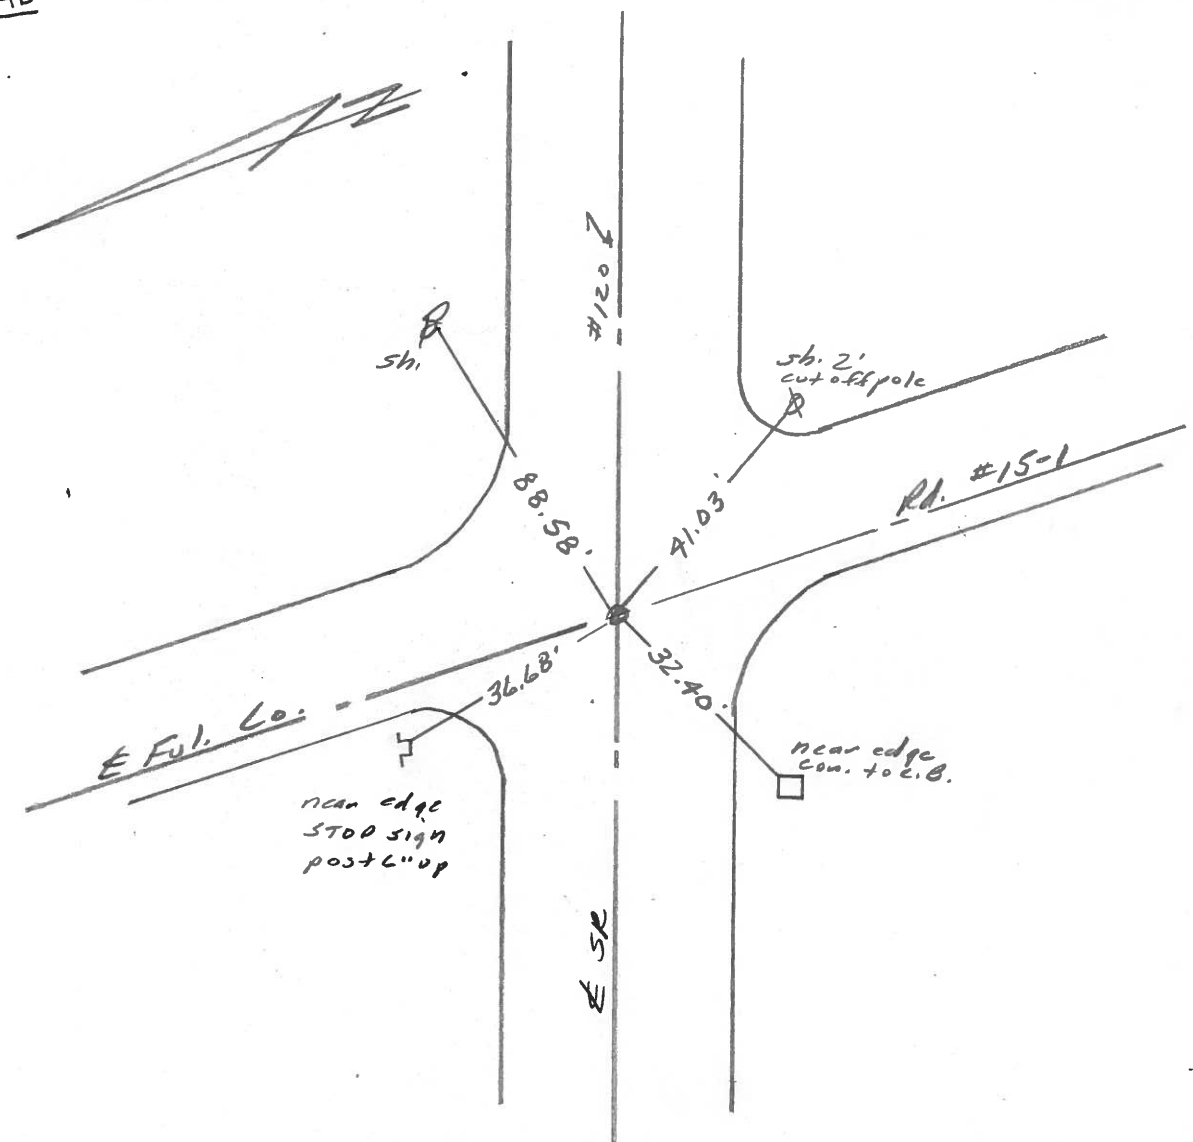

County Fulton S.R. 120

Township Chesterfield

Section 10

T N, R E

Personnel I. Stone

P. Newser


R. Michalak

D. Curtis

Date 29 Aug. 83

Weather Warm

Temp. 83

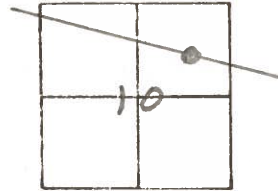

SLM STA. 49+80

Ref. No.

2 AB

