

O.D.O.T. DISTRICT 2 SURVEY OFFICE

PERSONNEL _____

REFERENCE NO. _____

SHEET 4 OF _____

NOTES L. Stone

H.C. D. Curtis

R.C. J. Householder

DATE 12 June 90

WEATHER Fair

TEMP. 68°

ROUTE SR#120

COUNTY Fulton

TOWNSHIP Chatterfield

SECTION 10

T. _____ R. _____


TYPE MONUMENT Sm. RR. Spk.

ON SURFACE - BELOW Surface

LEFT- & PAV'T. - RIGHT _____


_____ TO _____ EDGE PAVEMENT

S.L.M. 63+69

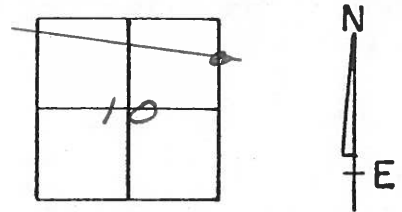

Set PK Nail 8-8-90 IRS

ZAC

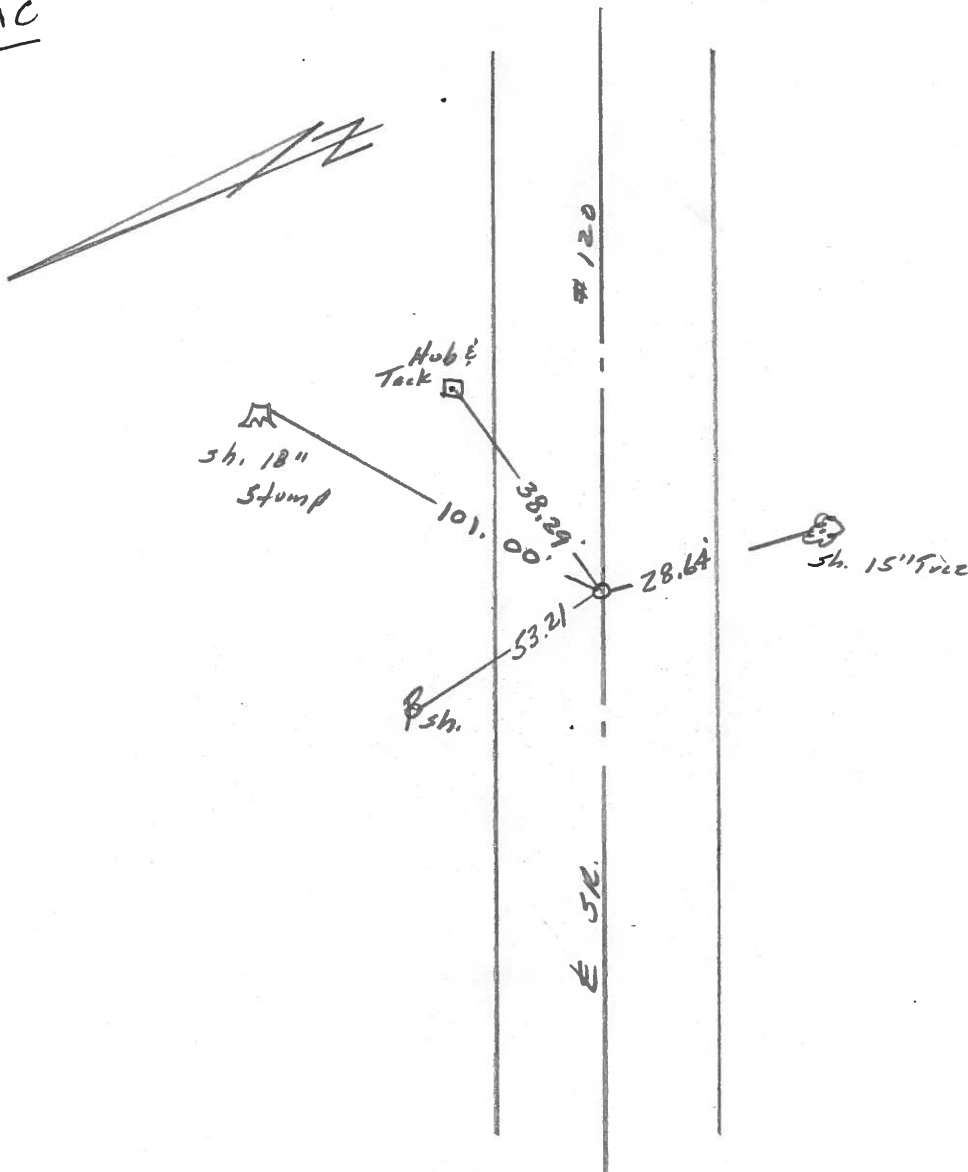

County Fulton S.R. 120

Township Chesterfield

Section 10

T N, R E

Personnel 1. Stone

P. Neuser


R. Michalek

D. Curtis

Date 29 Aug. 83

Weather Warm

Temp. 83

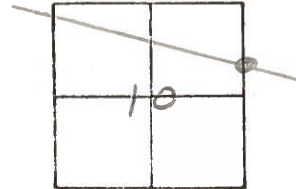

SLM Sta. 63+72

REF. No.

ZAC

