


O.D.O.T. DISTRICT 2 SURVEY OFFICE (USE ONLY)


PERSONNEL _____ REFERENCE NO. 8 SHEET 15 OF 50
 NOTES NIESE _____ DATE 4/27/22 ROUTE SR 120
 H.C. O'DONNELL _____ WEATHER WINDY COUNTY FULTON
 R.C. PARADYSZ _____ TEMP. 45° TOWNSHIP ROYALTON
 AUBLE _____ SECTION 7
 DWG BY RHOADES PID 99582 T 9 N R 3 E

TYPE MONUMENT MAG/WASHER
 ON SURFACE - ~~BELOW~~ ON
 OFFSET \odot PAVEMENT 1.3' LT : ~~RT~~
8.6' TO LT EDGE PAVEMENT
 STATION: 227+35

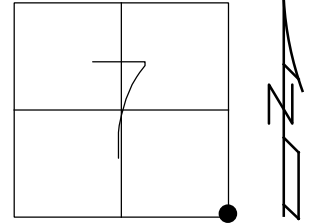

HORIZ. DATUM: NAD83 2011 GEOID: NAVD88 2012A
 GRID: NORTHING: 744436.911 EASTING: 1532913.104


RECORD: 1926 PLAN
 STA. 227+33.2
 FD IPIPE
 SET MAG/WASHER
 9/8/03, DCH
 FD MAG/WASHER
 5/23/11, RJL
 FD MAG/WASHER
 REF8
 5/7/19, JLL
 9/23/20, JFO
 2/26/21, JMR
 SET MAG/WASHER
 7/27/22, TDN

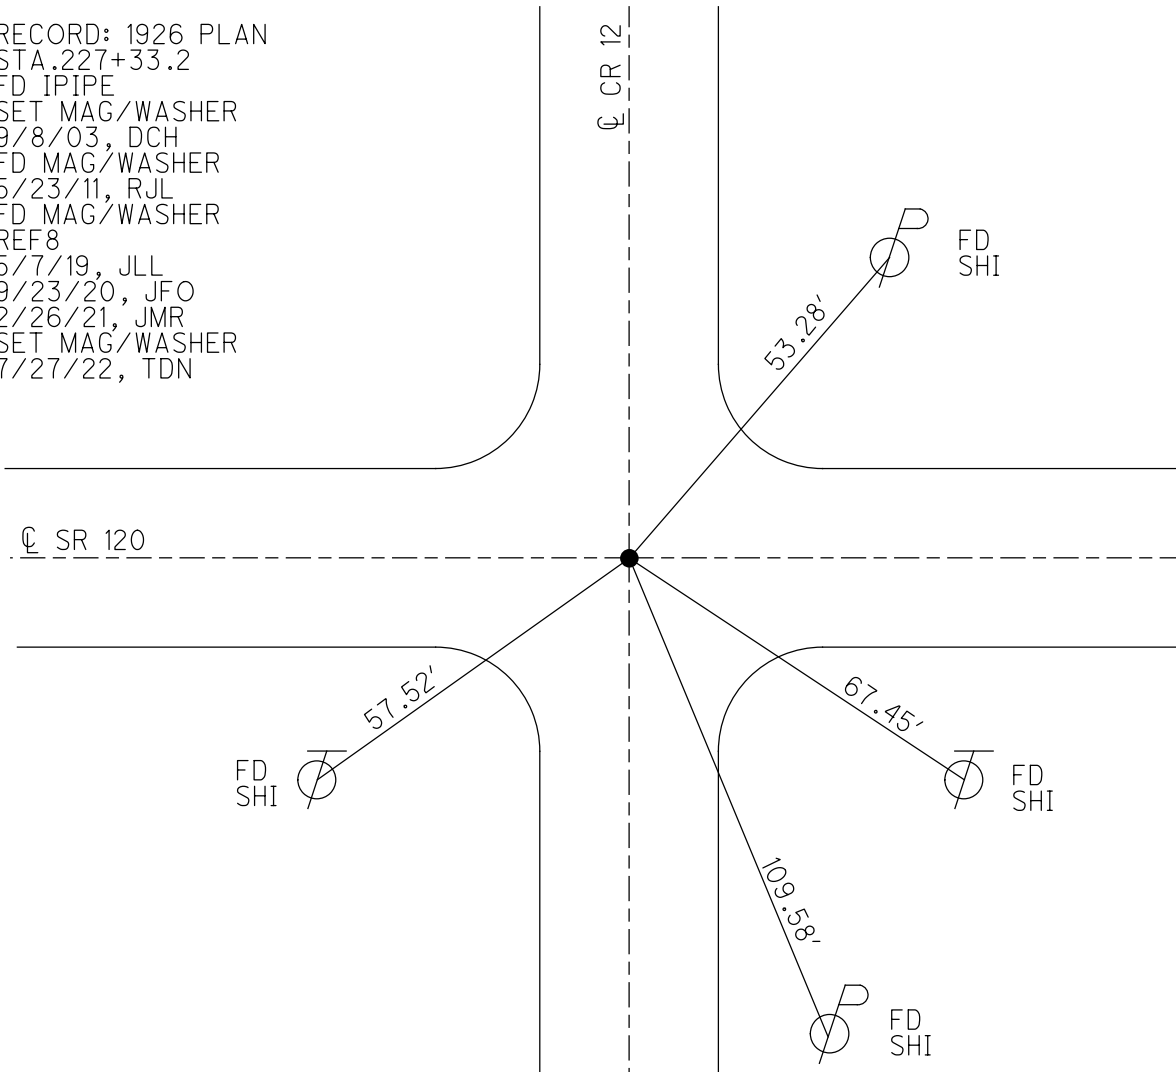

O.D.O.T. DISTRICT 2 SURVEY OFFICE (USE ONLY)


PERSONNEL _____ REFERENCE NO. 8 SHEET 14 OF 47
 NOTES NIESE DATE 2/26/21 ROUTE SR 120
 H.C. RHOADES WEATHER FAIR COUNTY FULTON
 R.C. _____ TEMP. 30° TOWNSHIP ROYALTON
 DWG BY NIESE PID PAVETRAIN SECTION 7
 T 9 N R 3 E

TYPE MONUMENT MAG/WASHER
 ON SURFACE - ~~BELOW~~ ON
 OFFSET Q PAVEMENT 1.3' LT : ~~RT~~
8.6' TO LT EDGE PAVEMENT
 STATION: 227+35

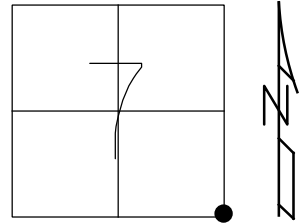

HORZ. DATUM: NAD83 2011 GEOID: NAVD88 2012A
 GRID: NORTHING: 744436.918 EASTING: 1532913.085


RECORD: 1926 PLAN
 STA. 227+33.2
 FD IPIPE
 SET MAG/WASHER
 9/8/03, DCH
 FD MAG/WASHER
 5/23/11, RJL
 FD MAG/WASHER
 REF8
 9/23/20, JFO
 2/26/21, JMR

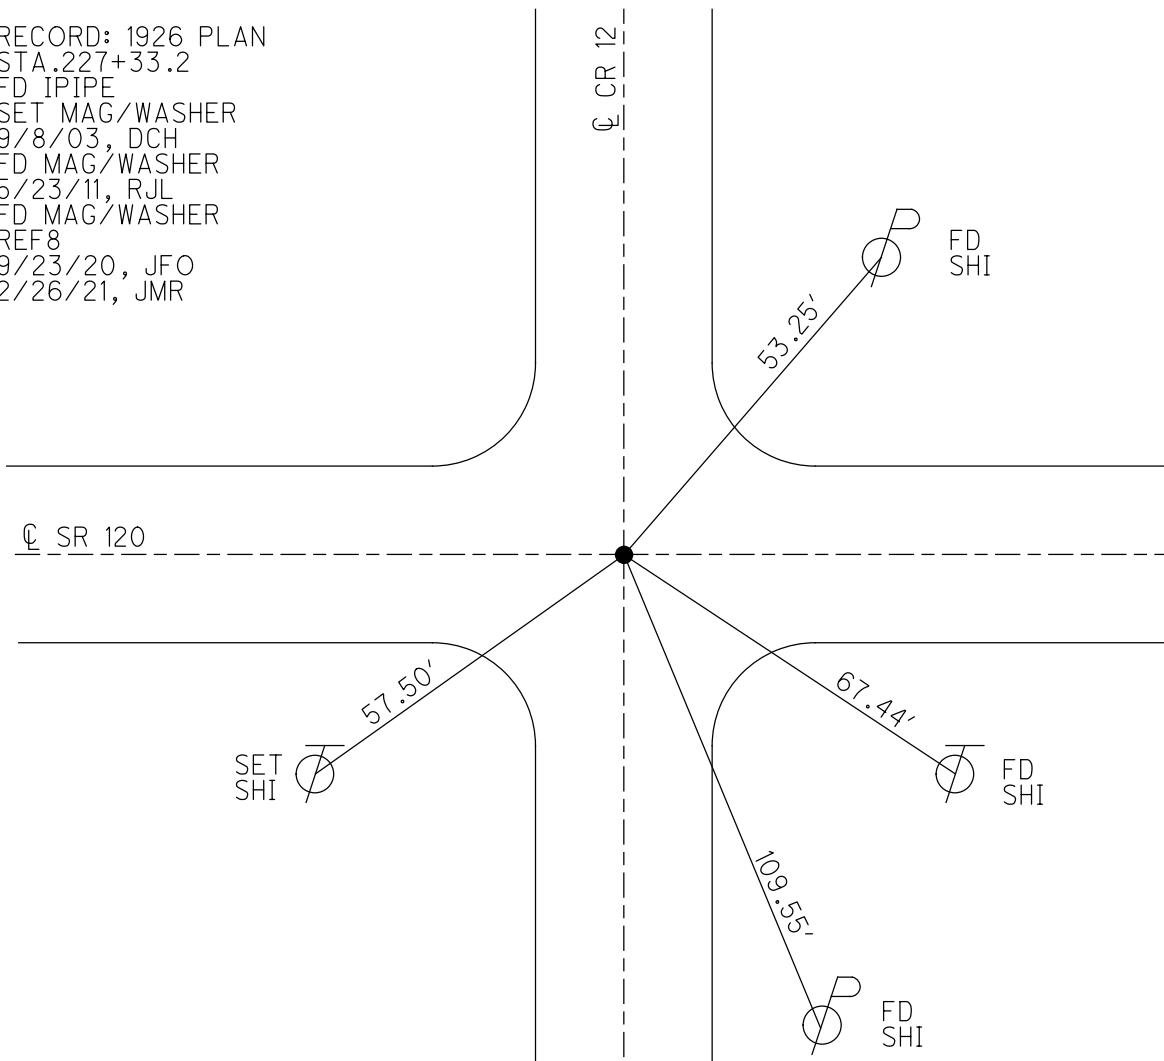

O.D.O.T. DISTRICT 2 SURVEY OFFICE (USE ONLY)


PERSONNEL _____ REFERENCE NO. 8 SHEET 14 OF 47
 NOTES RHOADES DATE 9/23/20 ROUTE SR 120
 H.C. O'DONNELL WEATHER SUNNY COUNTY FULTON
 R.C. AUBLE TEMP. 52° TOWNSHIP ROYALTON
 DWG BY RHOADES PID PAVETRAIN SECTION 7
 T 9 N R 3 E

TYPE MONUMENT MAG/WASHER
 ON SURFACE - ~~BELOW~~ ON
 OFFSET Q PAVEMENT 1.3' LT : RT
8.6' TO LT EDGE PAVEMENT
 STATION: 227+35

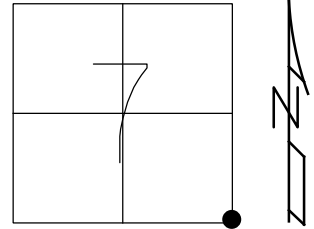

HORZ. DATUM: NAD83 2011 GEOID: NAVD88 2012A
 GRID: NORTHING: 744436.918 EASTING: 1532913.085

RECORD: 1926 PLAN
 STA.227+33.2
 FD IPIPE
 SET MAG/WASHER
 9/8/03, DCH
 FD MAG/WASHER
 5/23/11, RJL
 FD MAG/WASHER
 REF8
 9/23/20, JFO

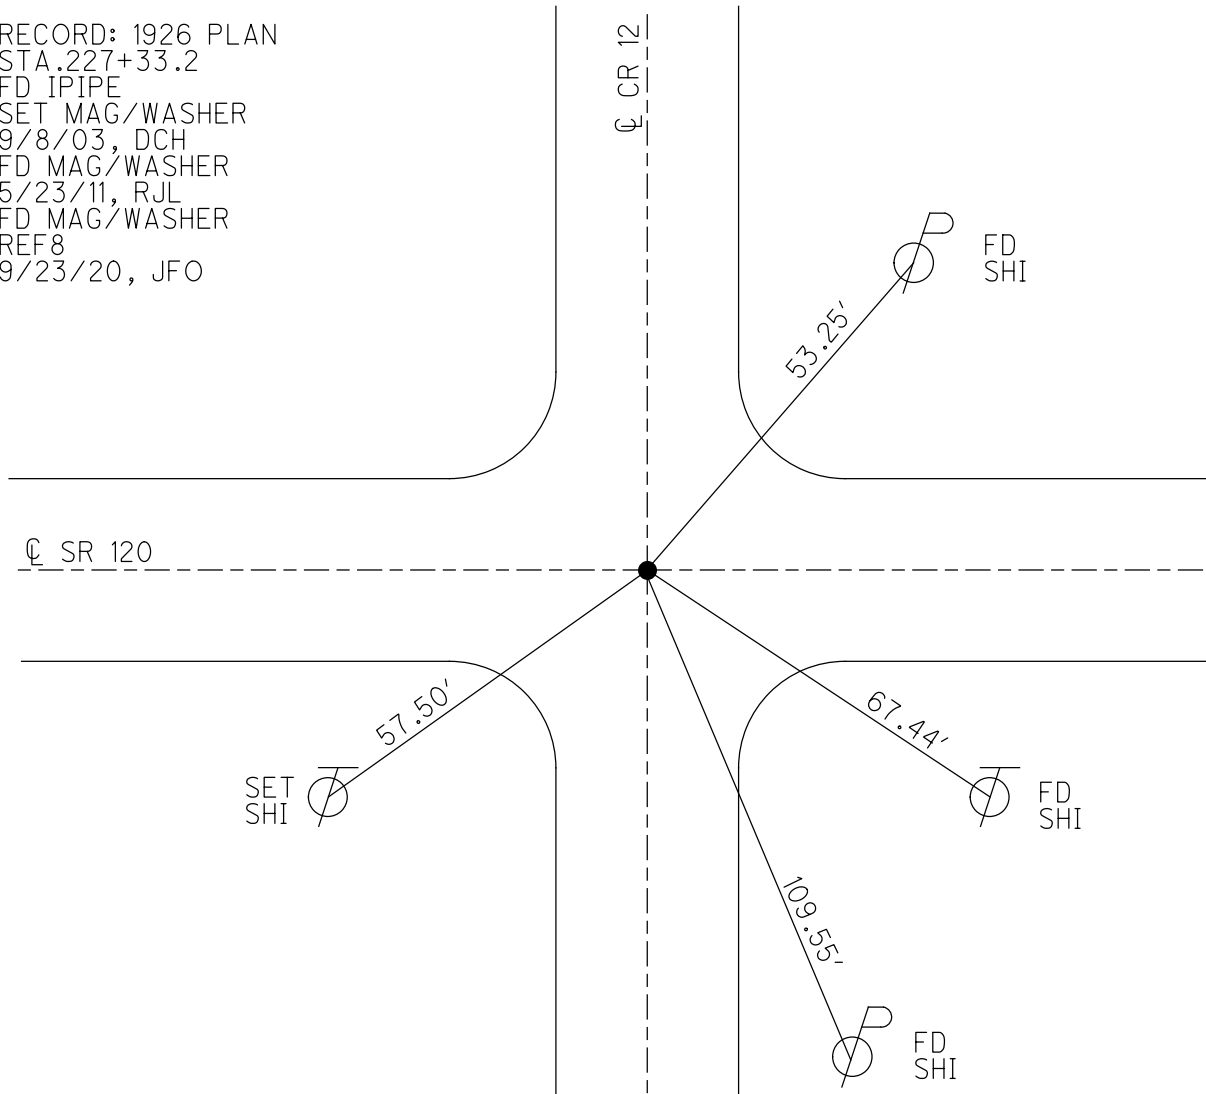

O.D.O.T. DISTRICT 2 SURVEY OFFICE

PERSONNEL _____

REFERENCE NO. 8

SHEET 14 OF 45

NOTES FINGER

DATE 5/23/11

ROUTE SR 120

H.C. LUMBREZER

WEATHER SUNNY

COUNTY FULTON

R.C. MOSER

TEMP. 70°

TOWNSHIP ROYALTON

SECTION 7

T 9 N R 3 E


TYPE MONUMENT MAG NAIL/WASHER

ON SURFACE - ~~BELOW~~ ON

LEFT - Q PAV'T - ~~RIGHT~~ 1.3'

8.6' TO LT EDGE PAVEMENT

S.L.M. 227+35

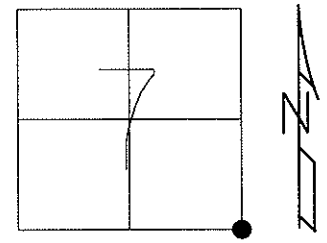


Grid: Northing: 744436.879 Easting: 1532913.073

REFERENCE TO 1926 PLAN:
FD PIPE AT PLAN STA.227+33.2

SET MAG NAIL/WASHER
9/8/03, DCH

FD MAG/WASHER
GPS 5/23/11, RJL

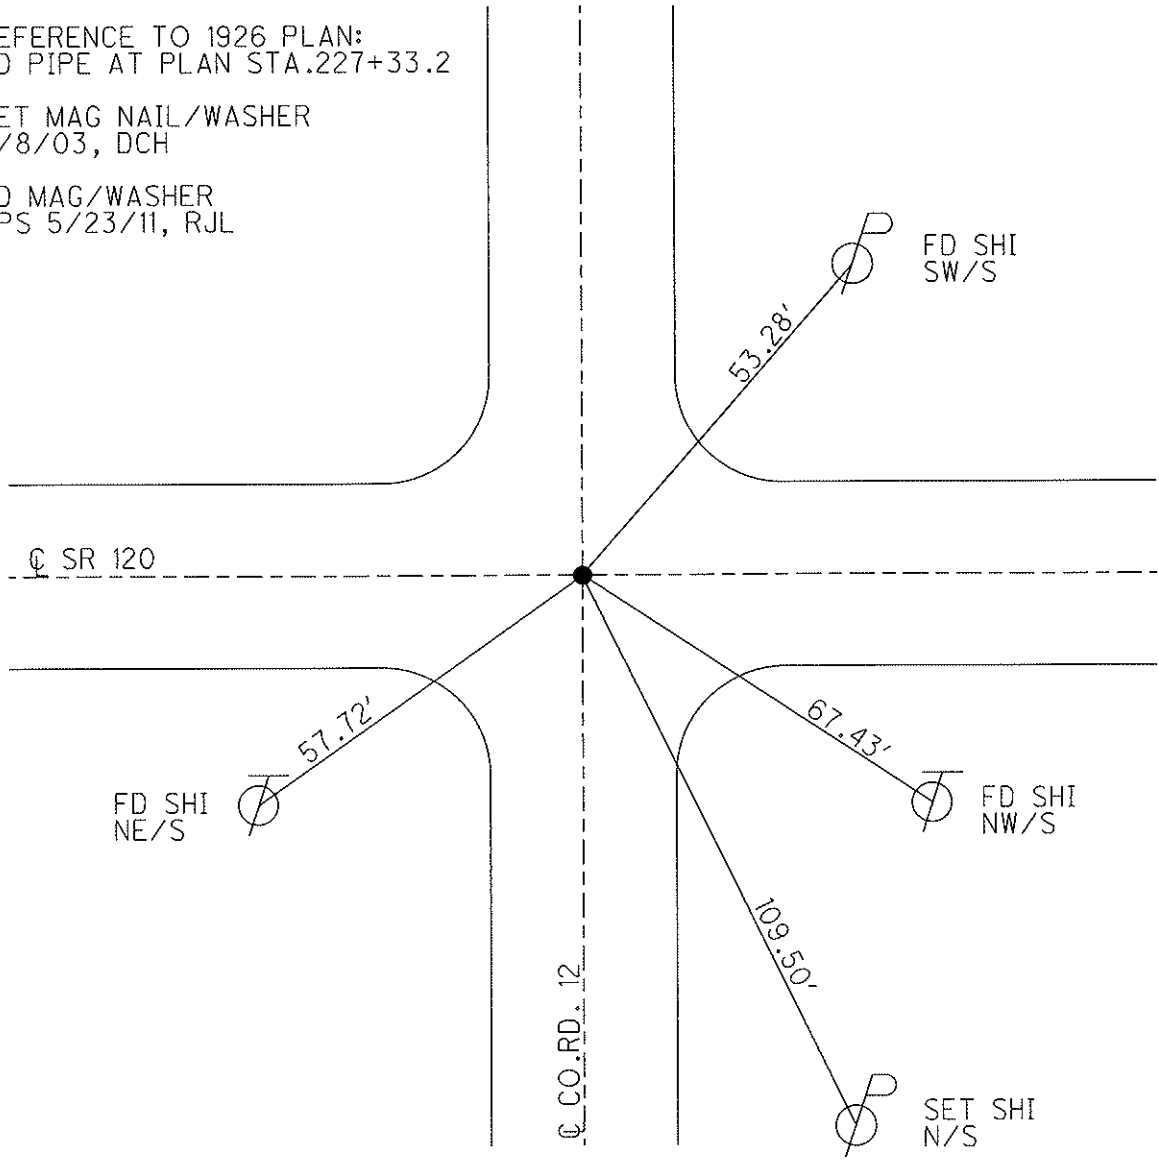

O.D.O.T. DISTRICT 2 SURVEY OFFICE

PERSONNEL

REFERENCE NO. 8

SHEET 12 OF 12

NOTES HOMAN

DATE 9-8-03

ROUTE SR 120

H.C. NUHFER

WEATHER SUNNY

COUNTY FULTON

R.C. BALLMER

TEMP. 75°

TOWNSHIP ROYALTON

BRUMBAUGH

SECTION 7,8,18,17

T 9 S R 3 E

TYPE MONUMENT GAS PIPE

~~ON SURFACE~~ - ~~BELOW~~ 9"

~~LEFT - Q PART - RIGHT~~ 0.5

TO EDGE PAVEMENT


S.L.M. 227+35

7	8
18	17



SET MAG NAIL
& WASHER
9-8-03
DCH

Reference to 1926 plan:
FD pipe at plan station 227+33.2

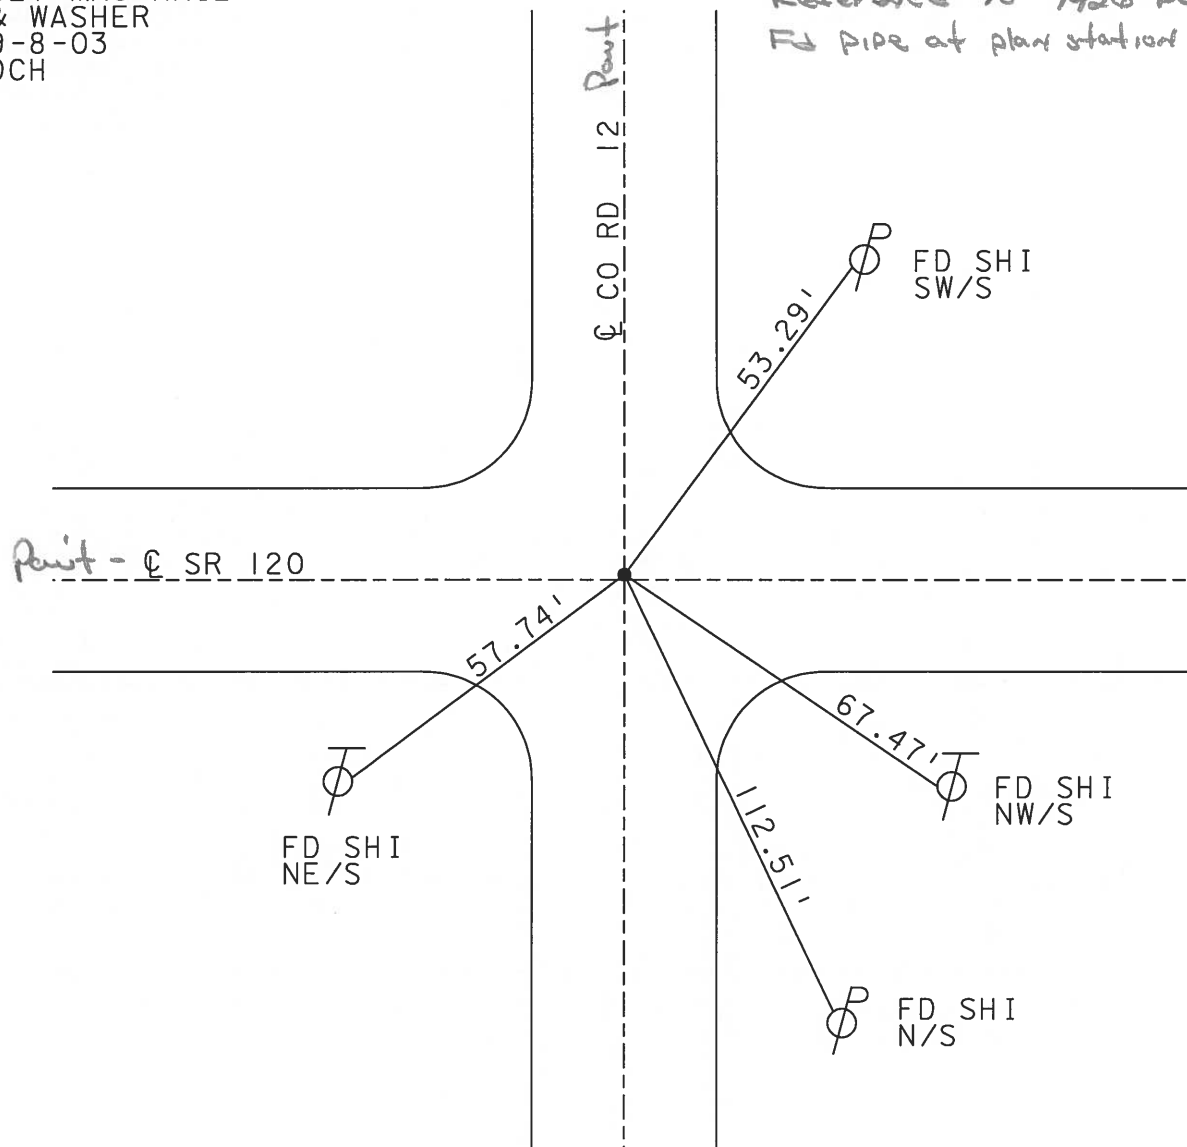

O.D.O.T. DISTRICT 2 SURVEY OFFICE

PERSONNEL _____

REFERENCE NO. 8

SHEET 10 OF _____

NOTES 1. Stone

H.C. D. Curtis

R.C. J. Householder

DATE 12 June 90

WEATHER Cloudy

TEMP. 68°

ROUTE SR#120

COUNTY Fulton

TOWNSHIP Royalton

SECTION 7-8-18-17

T _____ R _____

TYPE MONUMENT PK Nail

ON SURFACE - BELOW Surface

LEFT- & PAV'T. - RIGHT _____


_____ TO _____ EDGE PAVEMENT

S.L.M. 227 + 35

7	8
18	17



Set PK Nail 8-8-90 IRS

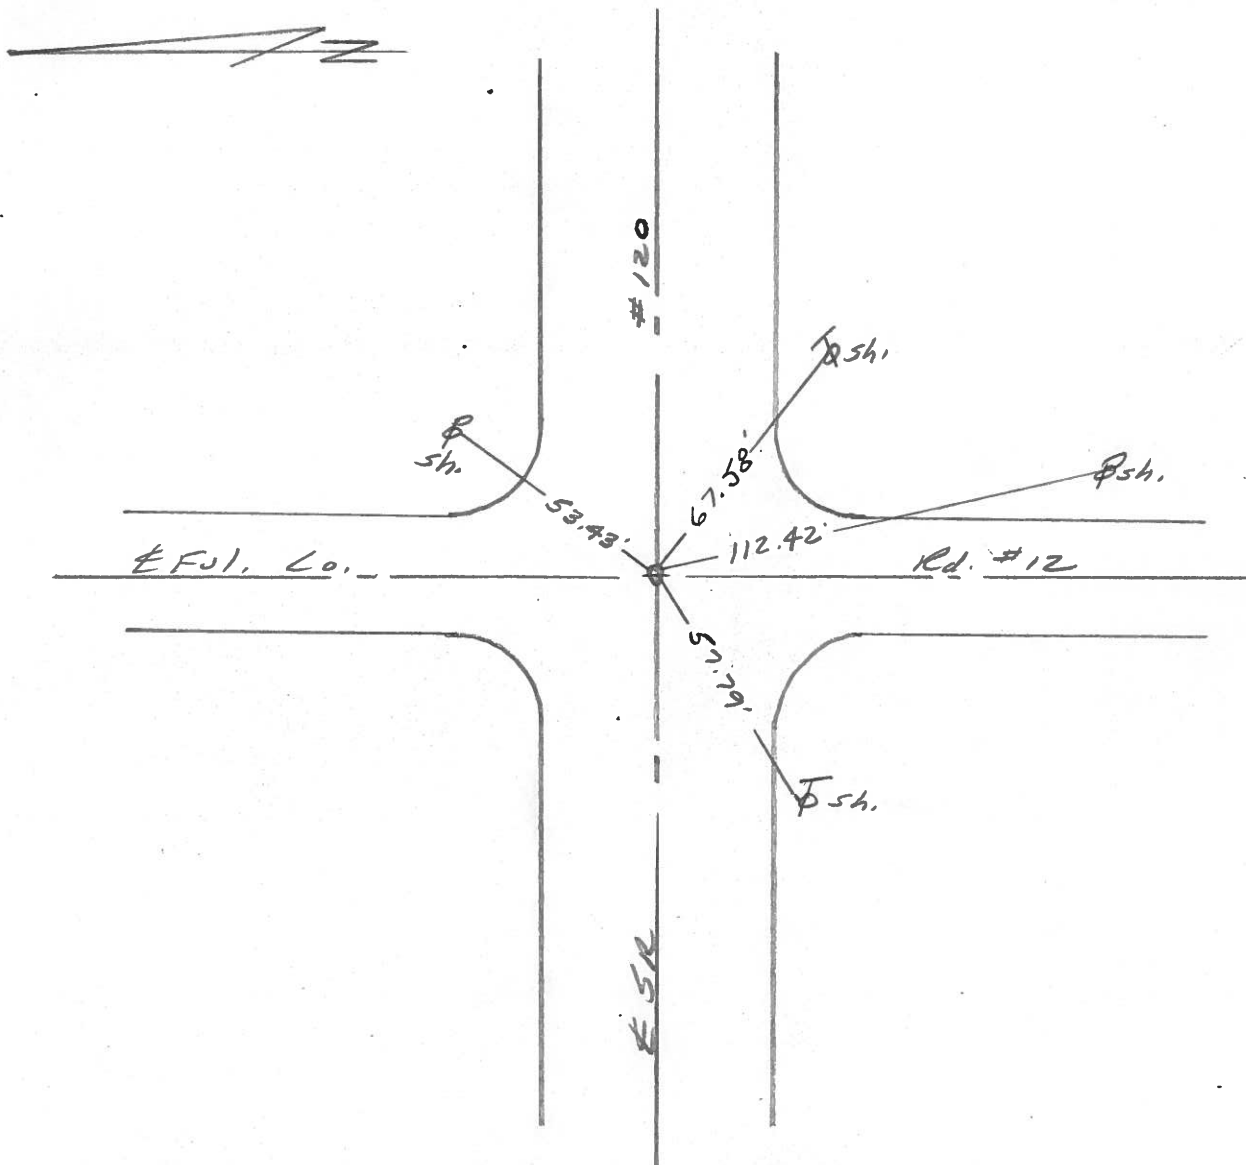

County Fulton S.R. 120

Date 18 Sept. 84

Township Royalton

Weather Mild

Section 8-17

Temp. 70°


T_N, R_E

Personnel D. Curtis


P. Neuser

R. Michalak

8

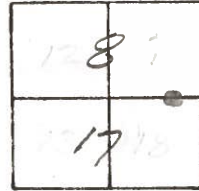

Z →

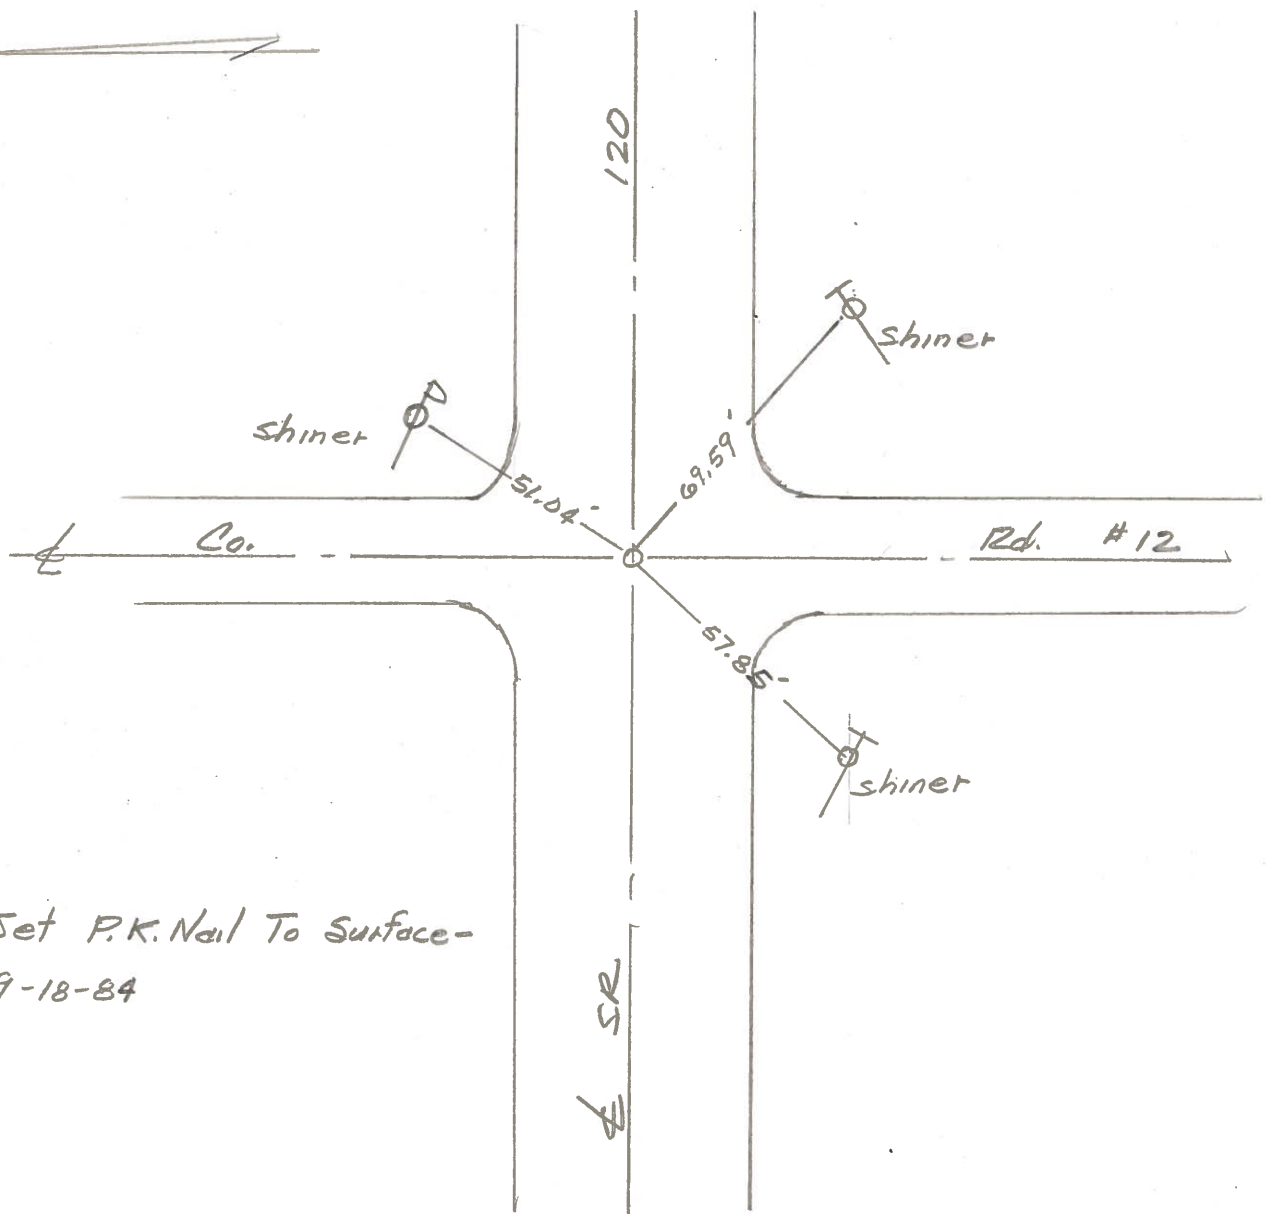

Set P.K. Nail To Surface -
9-18-84

<u>PERSONNEL</u>	<u>TITLE</u>	<u>PERSONNEL</u>	<u>TITLE</u>	<u>COUNTY</u>	<u>DATE</u>
Tomsic		Boyle		Fulton	July 10, 1973
Nausser				S. R. <u>120</u>	<u>WEATHER</u>
Granata				SEC. <u>Royalton Twp.</u>	<u>TEMP</u>
Vanyo					

DESCRIPTION LEFT CENTER LINE RIGHT JOB NO.

