


O.D.O.T. DISTRICT 2 SURVEY OFFICE (USE ONLY)


PERSONNEL _____ REFERENCE NO. 9 C SHEET 24 OF 50
 NOTES RHOADES DATE 4/28/22 ROUTE SR 120
 H.C. O'DONNELL WEATHER SUNNY COUNTY FULTON
 R.C. RHOADES TEMP. 40° TOWNSHIP ROYALTON
 SECTION 9
 DWG BY RHOADES PID 99582 T 9 N R 3 E

TYPE MONUMENT MAG SHANK
 ON SURFACE - ~~BELOW~~ ON
 OFFSET ☉ PAVEMENT ON LT : RT
- TO - EDGE PAVEMENT
 STATION: 298+96

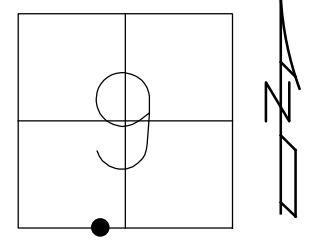

HORZ. DATUM: NAD83 2011 GEOID: NAVD88 2018
 GRID: NORTHING: 744443.341 EASTING: 1540068.766


RECORD:
 FD MAG NAIL
 8/15/03, DCH
 SET MAG/WASHER
 12/29/03, DCH
 FD MAG/WASHER
 REFC9
 5/7/19, JLL
 FD MAG SHANK
 4/28/22, JFO
 SET MAG/WASHER
 7/29/22, TDN

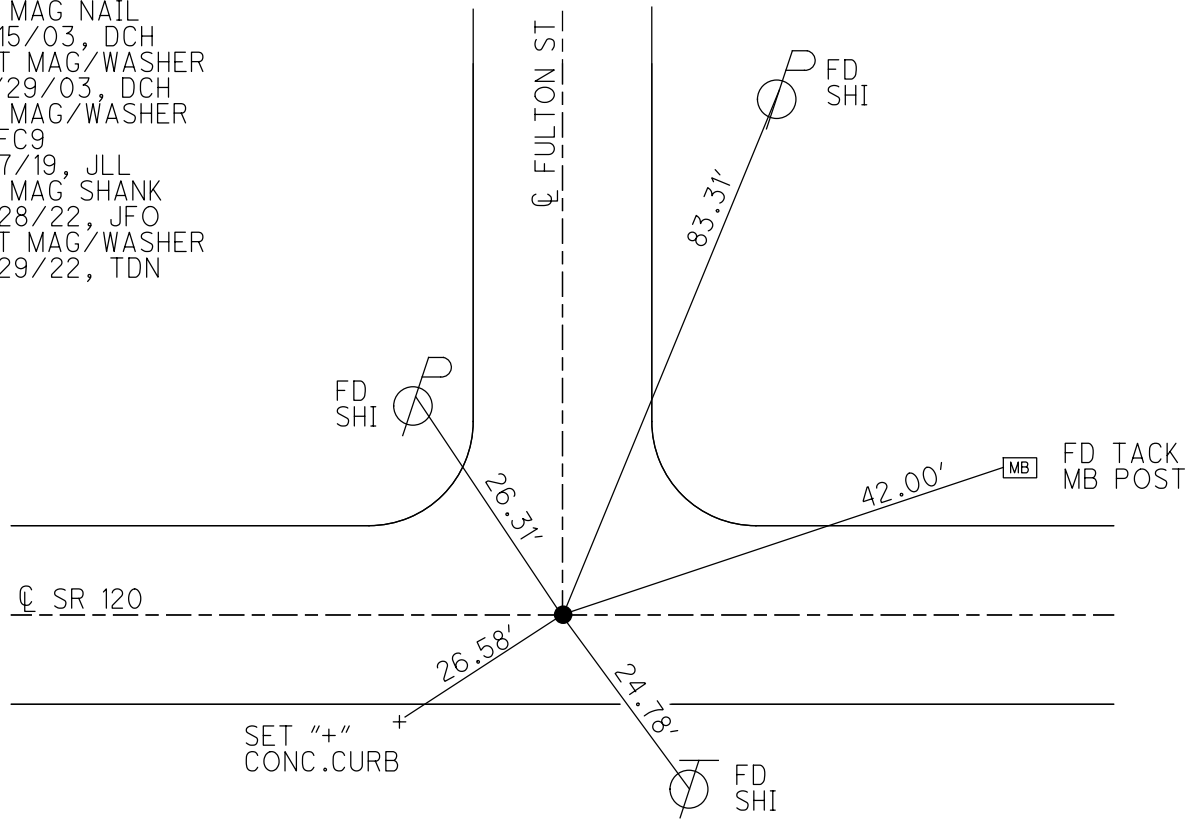


O.D.O.T. DISTRICT 2 SURVEY OFFICE (USE ONLY)

PERSONNEL _____ REFERENCE NO. 9 C SHEET 21 OF 45
 NOTES HOMAN DATE 8/15/03 ROUTE SR 120
 H.C. HOMAN WEATHER CLOUDY COUNTY FULTON
 R.C. MEYERS TEMP. 80° TOWNSHIP ROYALTON
 _____ SECTION 9
 _____ T 9 N R 3 E

TYPE MONUMENT MAG NAIL
 ON SURFACE - ~~BELOW~~ ON _____
 LEFT - ☉ PAV'T - RIGHT ON _____
 _____ TO _____ EDGE PAVEMENT
 S.L.M. 298+96
 GRID: NORTHING: _____ EASTING: _____

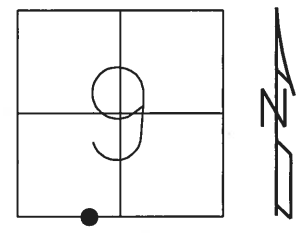

SET MAG/WASHER
 12/29/03, DCH

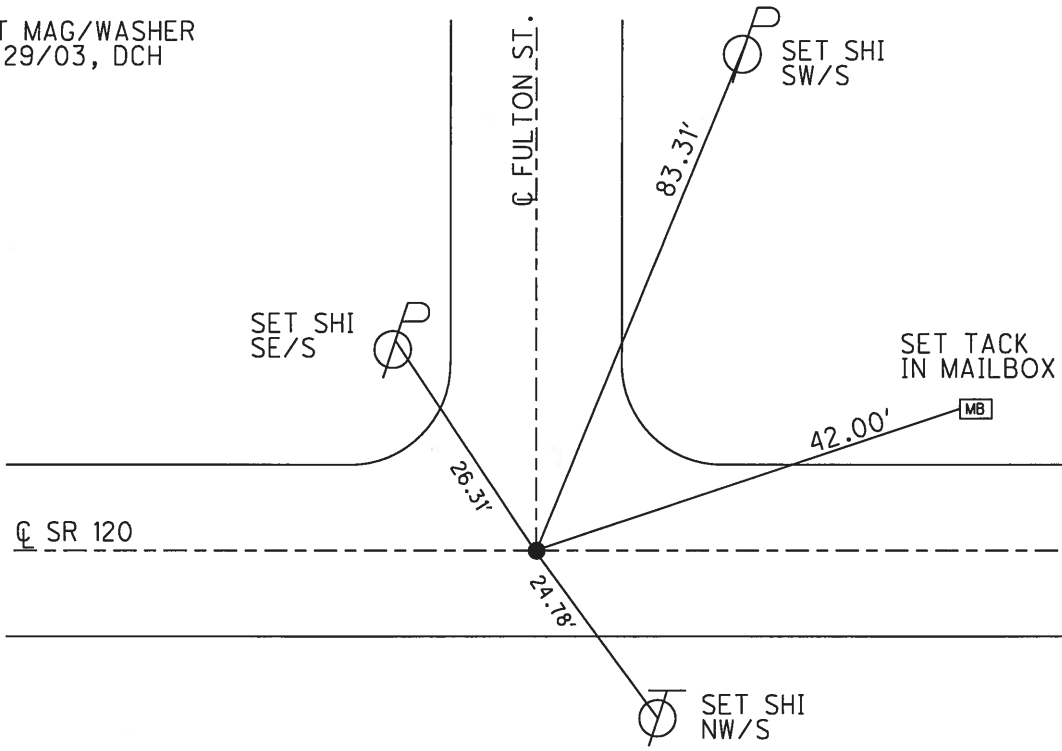

O.D.O.T. DISTRICT 2 SURVEY OFFICE

PERSONNEL

REFERENCE NO. 9c

SHEET 6 OF 9

NOTES HOMAN

DATE 8-15-03

ROUTE S.R. 120

H.C. HOMAN

WEATHER CLOUDY

COUNTY FULTON

R.C. MEYERS

TEMP. 80°

TOWNSHIP ROYALTON

SECTION _____

T 9 S R 3 E


TYPE MONUMENT _____ MAG NAIL _____

ON SURFACE - ~~BELOW~~ _____ ON _____

~~LEFT~~ - Q PAV'T - ~~RIGHT~~ _____ ON _____


_____ TO _____ EDGE PAVEMENT

S.L.M. _____ 298+96 _____

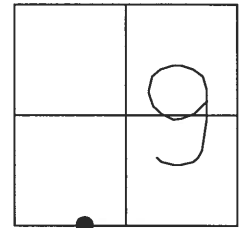


SET MAG & WASHER
12-29-03
DCH

NOTE: POINT Re-set per sewer project plans.

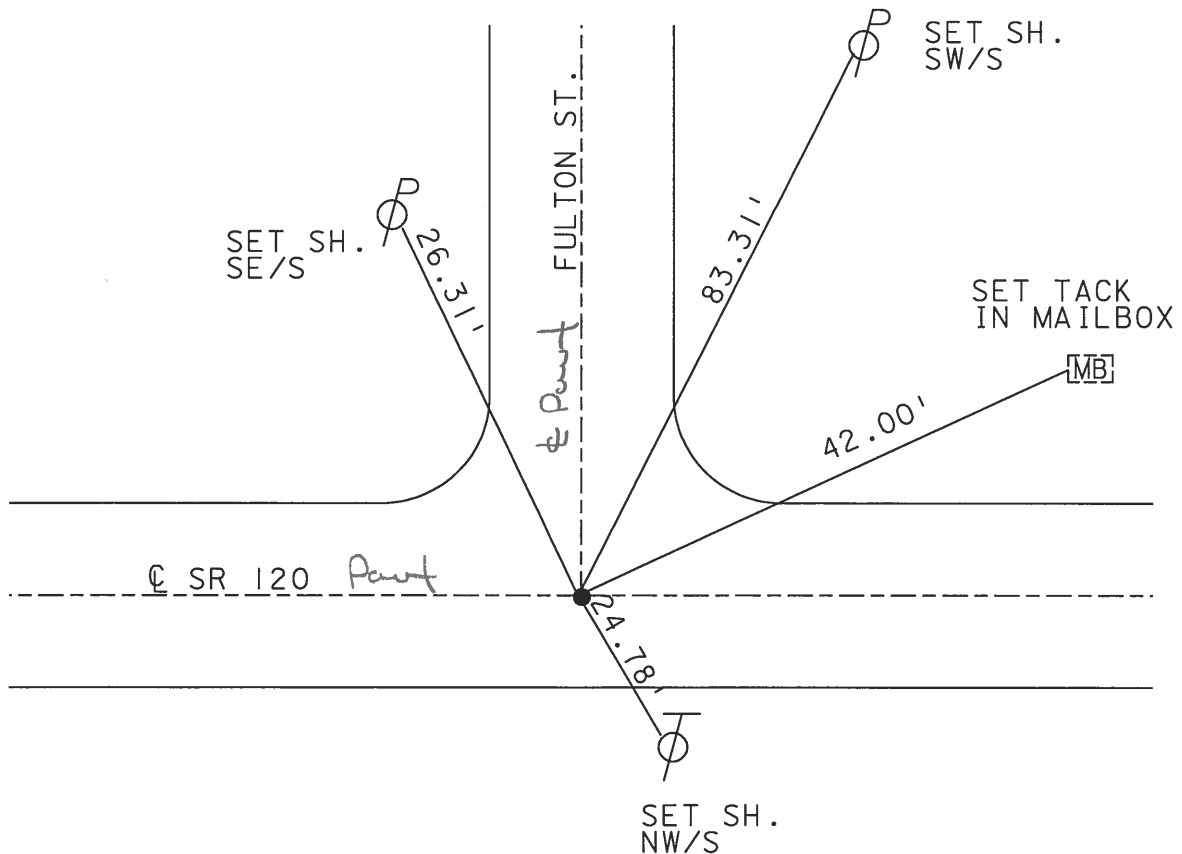


(9C)

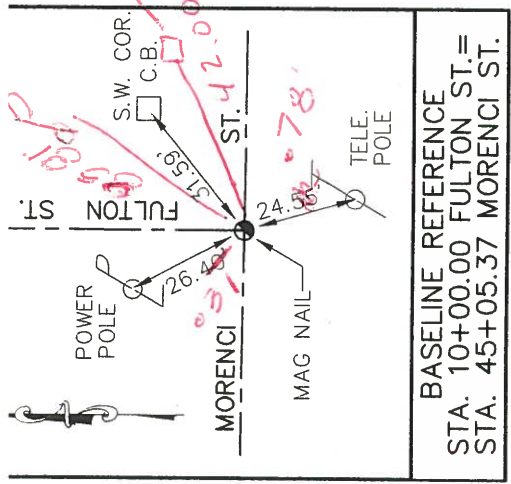

APPROXIMATE LOCATION OF ABANDONED RAILWAY (SEE SPECIFICATIONS)

SEE SHEET NO. 24 FOR ADDITIONAL INFO

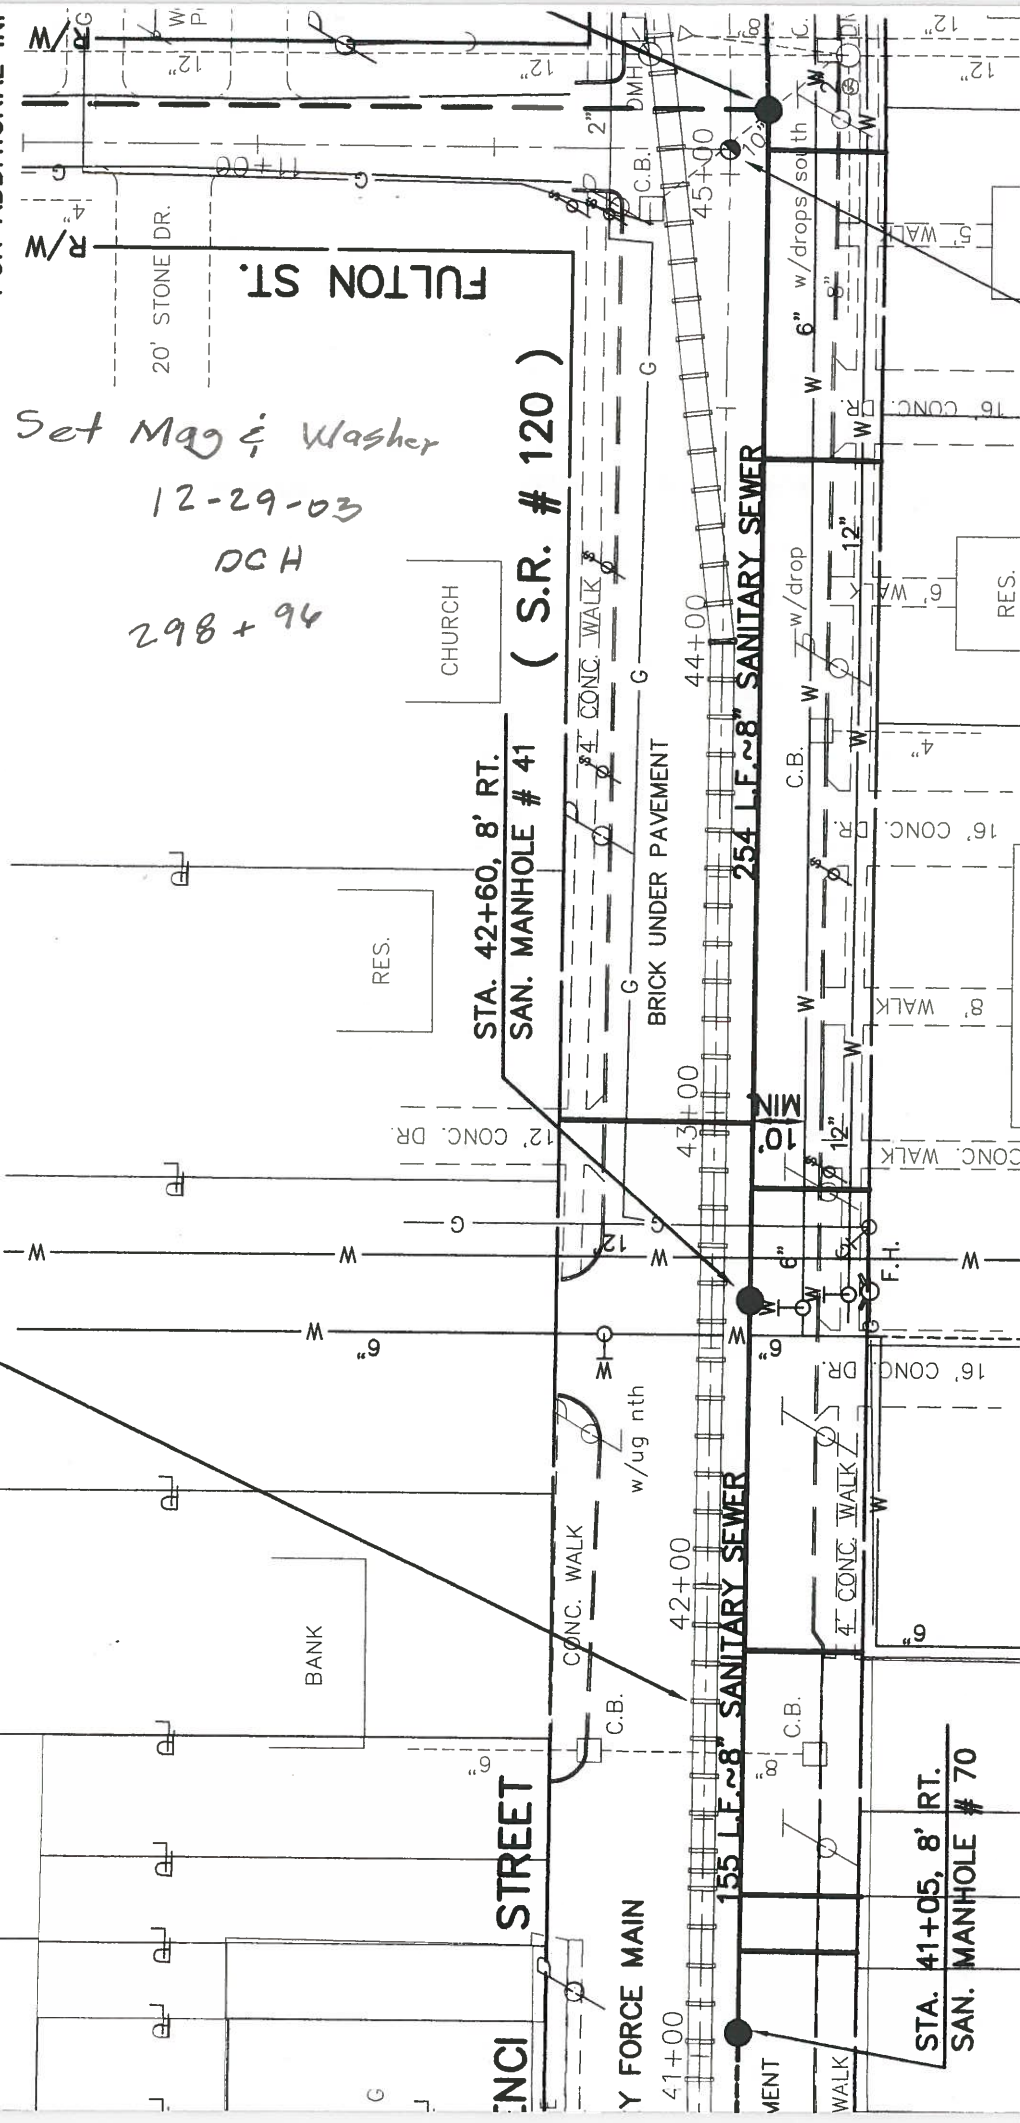

Set Mag & Washer
12-29-03
DCH
298 + 94

Track in main road

STA. 41+05, 8' RT. SAN. MANHOLE # 70

STA. 42+60, 8' RT. SAN. MANHOLE # 41 (S.R. # 120)

155 L.F. ~ 8" SANITARY SEWER

254 L.F. ~ 8" SANITARY SEWER

MORENCI STREET

FULTON ST.

20' STONE DR.

WATER FORCE MAIN

41+00

42+00

43+00

44+00

45+00

RES.

RES.

CHURCH

CONC. WALK

w/ug nth

BRICK UNDER PAVEMENT

CONC. WALK

CONC. WALK

16' CONC. WALK

16' CONC. WALK

16' CONC. WALK

16' CONC. WALK

DR.

DR.

6"

6"

