
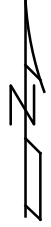


O.D.O.T. DISTRICT 2 SURVEY OFFICE (USE ONLY)


PERSONNEL _____ REFERENCE NO. 10 SHEET 27 OF 50
 NOTES RHOADES DATE 4/28/22 ROUTE SR 120
 H.C. O'DONNELL WEATHER SUNNY COUNTY FULTON
 R.C. RHOADES TEMP. 45° TOWNSHIP ROYALTON
 DWG BY RHOADES PID 99582 SECTION 9
 T 9 N R 3 E

TYPE MONUMENT MAG/WASHER
 ON SURFACE - ~~BELOW~~ ON
 OFFSET \odot PAVEMENT 0.6' ~~RT~~ : RT
 TO EDGE PAVEMENT
 STATION: 320+42.64

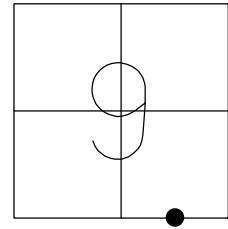

HORZ. DATUM: NAD83 2011 GEOID: NAVD88 2018
 GRID: NORTHING: 744452.147 EASTING: 1542184.386


RECORD:
 FD R.R.SPIKE
 8/15/03, DCH
 SET MAG/WASHER
 12/29/03, DCH
 FD MAG NAIL
 REF23
 6/8/10, DCH
 FD MAG/WASHER
 REF10
 5/7/19, JLL
 4/28/22, JFO
 SET MAG/WASHER
 7/29/22, TDN

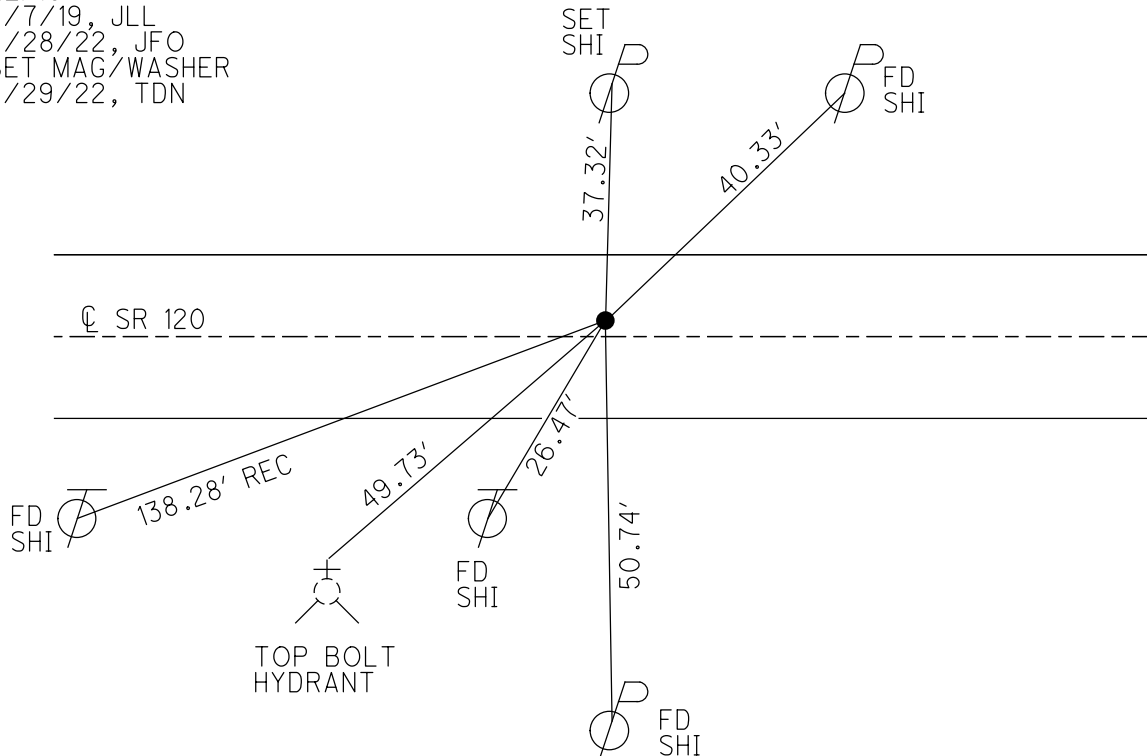

O.D.O.T. DISTRICT 2 SURVEY OFFICE (USE ONLY)


PERSONNEL _____ REFERENCE NO. 10 SHEET 24 OF 45
 NOTES HOMAN DATE 5/11/12 ROUTE SR 120
 H.C. ROUSOS WEATHER SUNNY COUNTY FULTON
 R.C. HOMAN TEMP. 55° TOWNSHIP ROYALTON
 _____ SECTION 9
 _____ T 9 N R 3 E

TYPE MONUMENT MAG NAIL
 ON SURFACE - ~~BELOW~~ ON
 LEFT - CL PAV'T - RIGHT ON
TO EDGE PAVEMENT
 S.L.M. 320+42.64

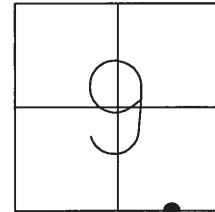

GRID: NORTHING: 744452.136 EASTING: 1542184.330

RECORD:
 FD R.R.SPIKE
 8/15/03, DCH
 SET MAG/WASHER
 12/29/03, DCH
 FD MAG NAIL
 REF23
 6/8/10, DCH

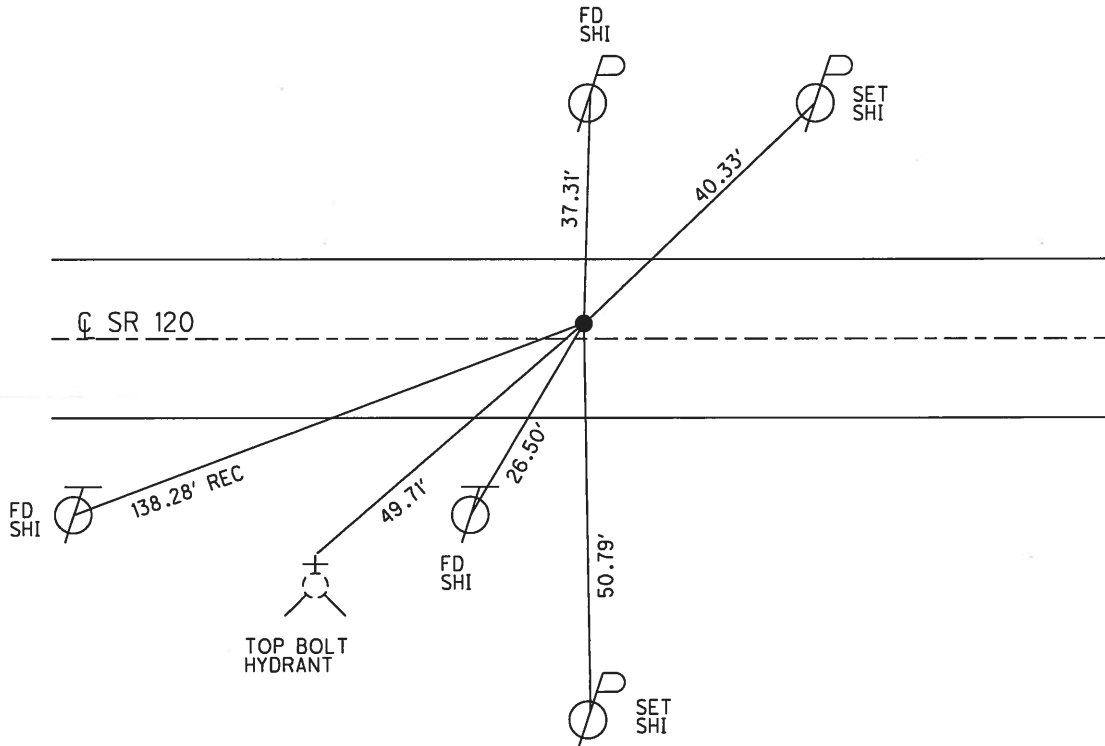

O.D.O.T. DISTRICT 2 SURVEY OFFICE

PERSONNEL _____

REFERENCE NO. 10

SHEET 24 OF 45

NOTES HOMAN

DATE 8/15/03

ROUTE SR 120

H.C. HOMAN

WEATHER CLOUDY

COUNTY FULTON

R.C. MEYERS

TEMP. 85°

TOWNSHIP ROYALTON

SECTION 9

T 9 N R 3 E

TYPE MONUMENT R.R. SPIKE


ON SURFACE - ~~BELOW~~ ON

LEFT - CL PAV'T - RIGHT ON


TO EDGE PAVEMENT

S.L.M. 320+05

Grid: Northing: _____ Easting: _____

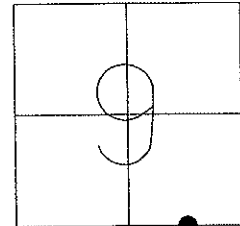

SET MAG/WASHER
12/29/03, DCH

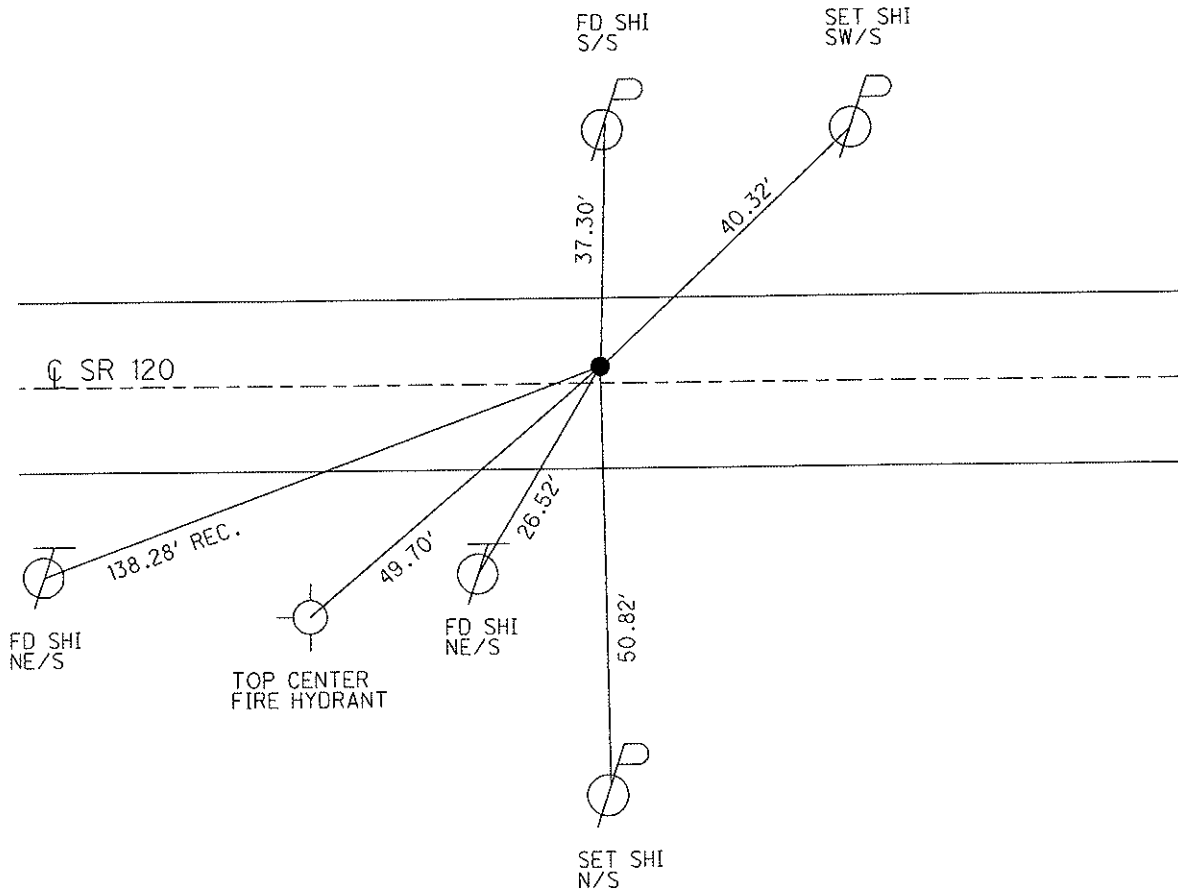

County Fulton S.R. 120

Township Royalton

Section 9-16

T.N, R.E

Personnel D. Curtis

P. Neuser

R. Michalak

Date 19 Sept. 84

Weather Mild


Temp. 75°

9	9
16	16



10

SLM 320+31

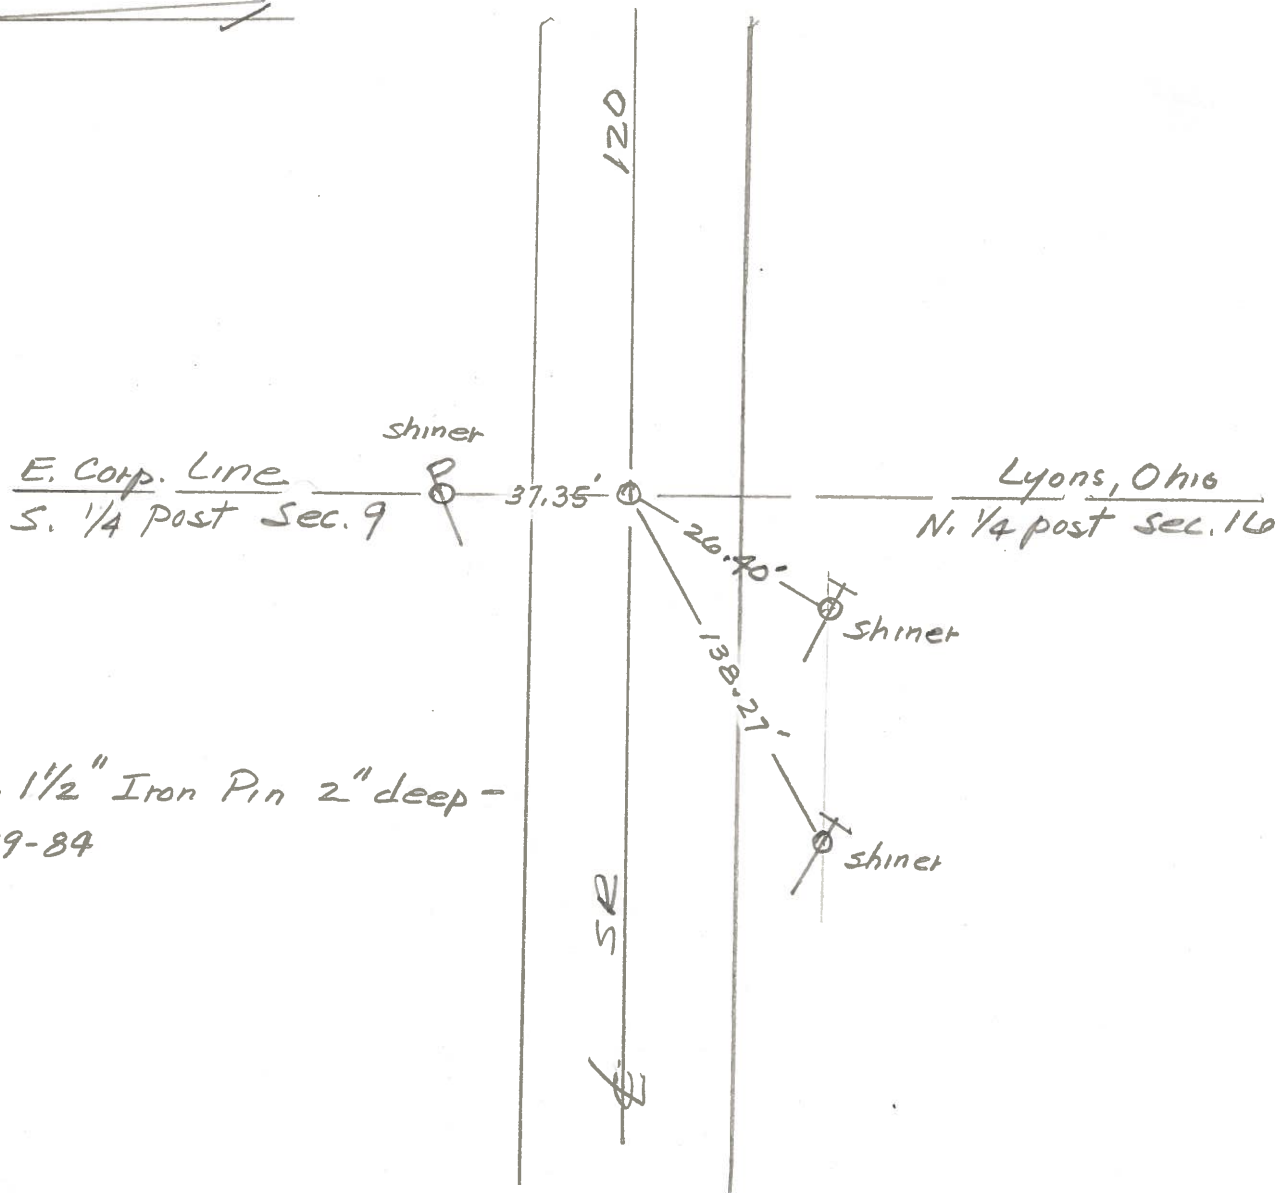

O.D.O.T. DISTRICT 2 SURVEY OFFICE

PERSONNEL _____

REFERENCE NO. 10

SHEET 18 OF 20

NOTES 1. Stone

H.C. D. Curtis

R.C. J. Householder

DATE 14 June 90

WEATHER Warm

TEMP. 77°

ROUTE SR#120

COUNTY Fulton

TOWNSHIP Royalton

SECTION 9

T _____ R _____


TYPE MONUMENT 1/2" I. pin

ON SURFACE - BELOW 3" deep


LEFT - ☉ PAV'T. - RIGHT _____

_____ TO _____ EDGE PAVEMENT

S.L.M. 320+05

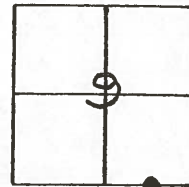


SET R.R. SPK. TO SURFACE
9-20-90
WJC

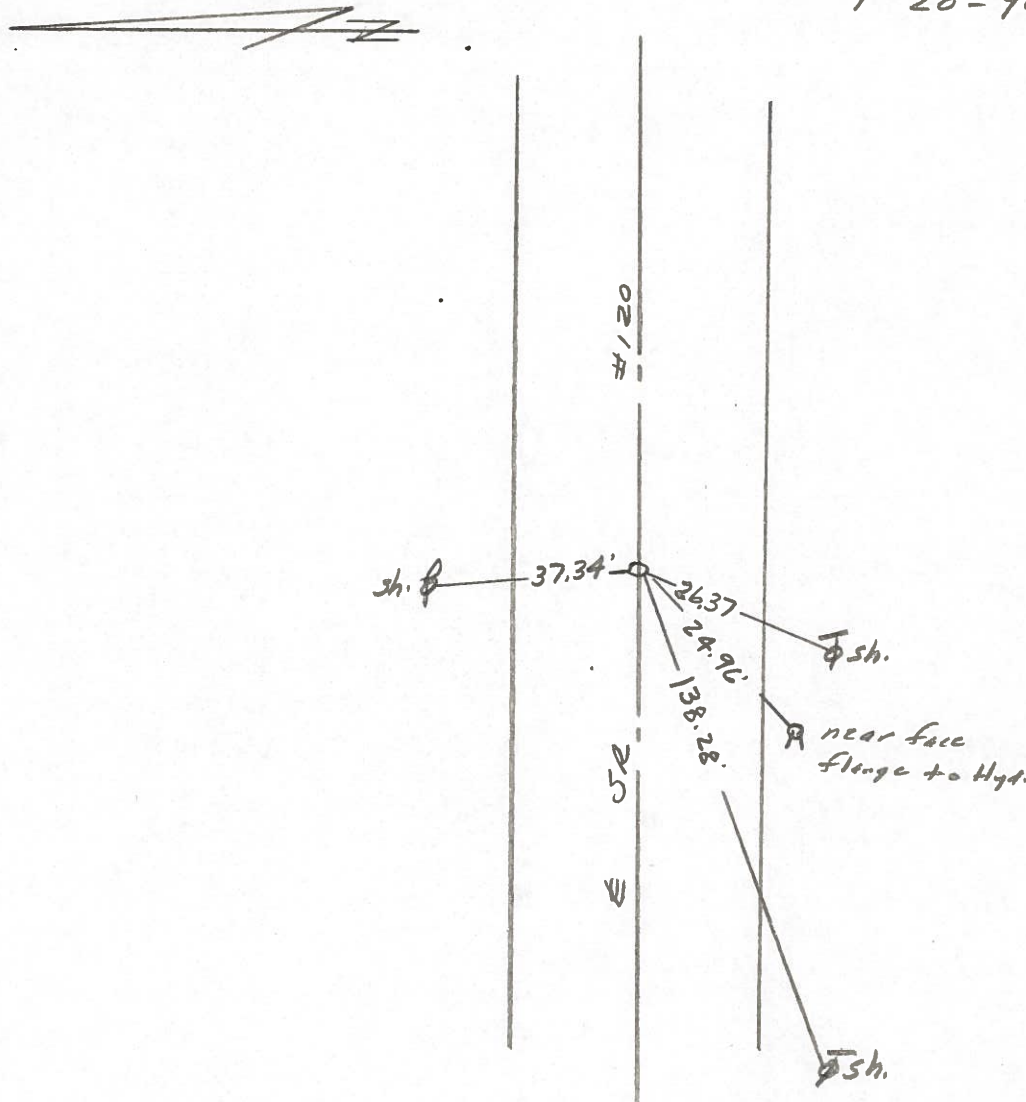

PERSONNEL	TITLE	PERSONNEL	TITLE
Tornsic		Boyle	
Neuser			
Granata			
Vany			

COUNTY Fulton DATE July 10, 1973
 S. R. 120 WEATHER _____
 SEC. Royalton Twp. TEMP. _____

DESCRIPTION LEFT CENTER LINE RIGHT JOB NO.

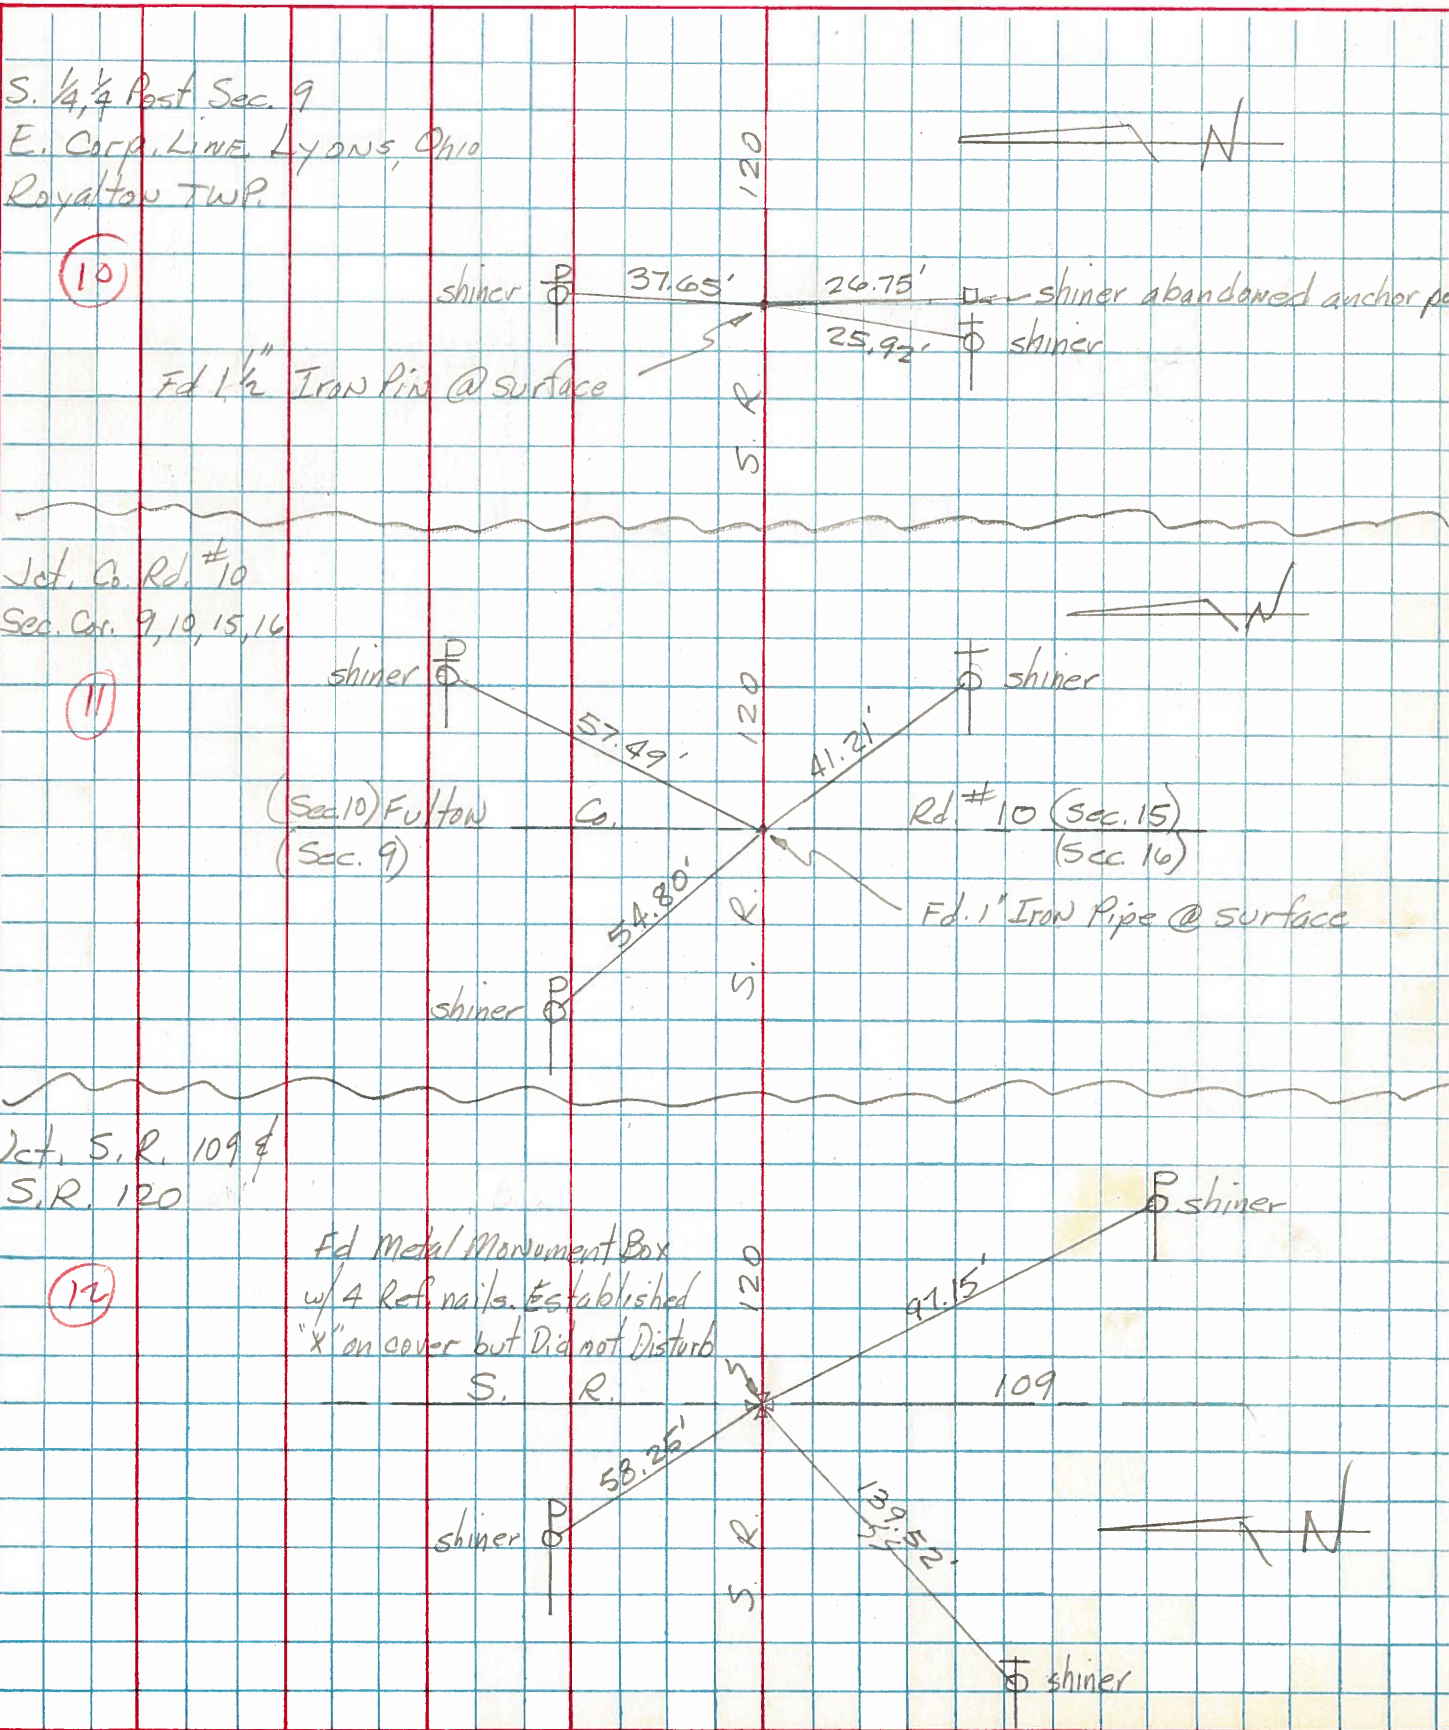

COMPUTATION SHEET

STATE OF OHIO - DEPARTMENT OF HIGHWAYS - BUREAU OF LOCATION AND DESIGN _____ COLUMBUS, OHIO
BY Denno - Granata - Curtis - Omev DATE June 7, 1966 NO. _____ OF _____ SHEETS
COUNTY Fulton SECTION _____
DIV. NO. _____ S.R. 120 U.S.R. _____ I. R. _____
SUBJECT OF THIS SHEET Monument Ref SR.120

