


O.D.O.T. DISTRICT 2 SURVEY OFFICE (USE ONLY)


PERSONNEL _____ REFERENCE NO. 11 SHEET 28 OF 50
 NOTES HOMAN DATE 5/11/12 ROUTE SR 120
 H.C. ROUSOS WEATHER SUNNY COUNTY FULTON
 R.C. HOMAN TEMP. 55° TOWNSHIP ROYALTON
 DWG BY RHOADES PID PAVETRAIN SECTION 9
 T 9 N R 3 E

TYPE MONUMENT R.R.SPIKE
 ON SURFACE - ~~BELOW~~ ON
 OFFSET C PAVEMENT 2.5' LT : ~~RT~~
- TO - EDGE PAVEMENT
 STATION: 333+58.27

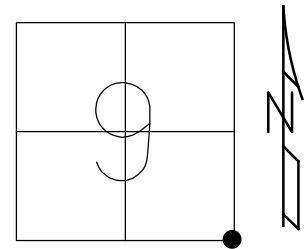

HORIZ. DATUM: NAD83 2011 GEOID: NAVD88 2018
 GRID: NORTHING: 744464.689 EASTING: 1543499.941


RECORD:
 FD 1" IPIPE
 2" DOWN
 6/14/90, IRS
 FD R.R.SPIKE
 8/15/03, DCH
 SET MAG/WASHER
 12/29/03, DCH
 FD R.R.SPIKE
 REF24
 6/8/10, DCH
 SET P.K./WASHER
 NEWREF24
 8/9/12, DCH
 FD MAG/WASHER
 REF11
 5/7/19, JLL
 FD P.K./WASHER
 REF11
 7/1/22, DSA
 4/12/23, JMR

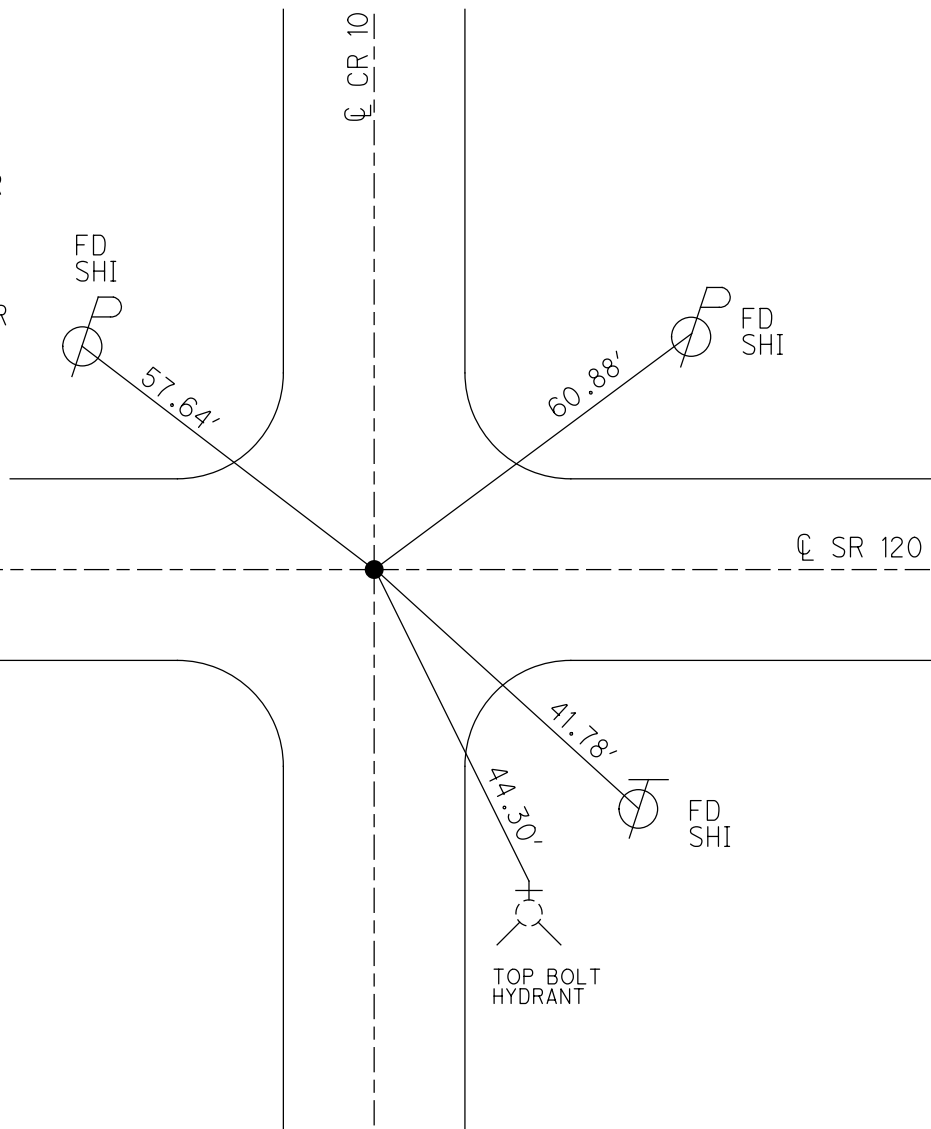

O.D.O.T. DISTRICT 2 SURVEY OFFICE (USE ONLY)


PERSONNEL _____ REFERENCE NO. 11 SHEET 28 OF 50
 NOTES HOMAN DATE 5/11/12 ROUTE SR 120
 H.C. ROUSOS WEATHER SUNNY COUNTY FULTON
 R.C. HOMAN TEMP. 55° TOWNSHIP ROYALTON
 DWG BY RHOADES PID 99582 SECTION 9
 T 9 N R 3 E

TYPE MONUMENT R.R.SPIKE
 ON SURFACE - ~~BELOW~~ ON
 OFFSET ☉ PAVEMENT 2.5' LT : ~~RT~~
- TO - EDGE PAVEMENT
 STATION: 333+58.27

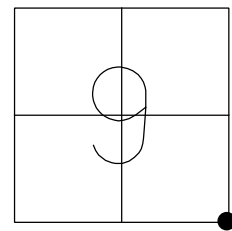

HORZ. DATUM: NAD83 2011 GEOID: NAVD88 2018
 GRID: NORTHING: 744464.689 EASTING: 1543499.941

RECORD:
 FD 1" IPIPE
 2" DOWN
 6/14/90, IRS
 FD R.R.SPIKE
 8/15/03, DCH
 SET MAG/WASHER
 12/29/03, DCH
 FD R.R.SPIKE
 REF24
 6/8/10, DCH
 SET P.K./WASHER
 NEWREF24
 8/9/12, DCH
 FD MAG/WASHER
 REF11
 5/7/19, JLL


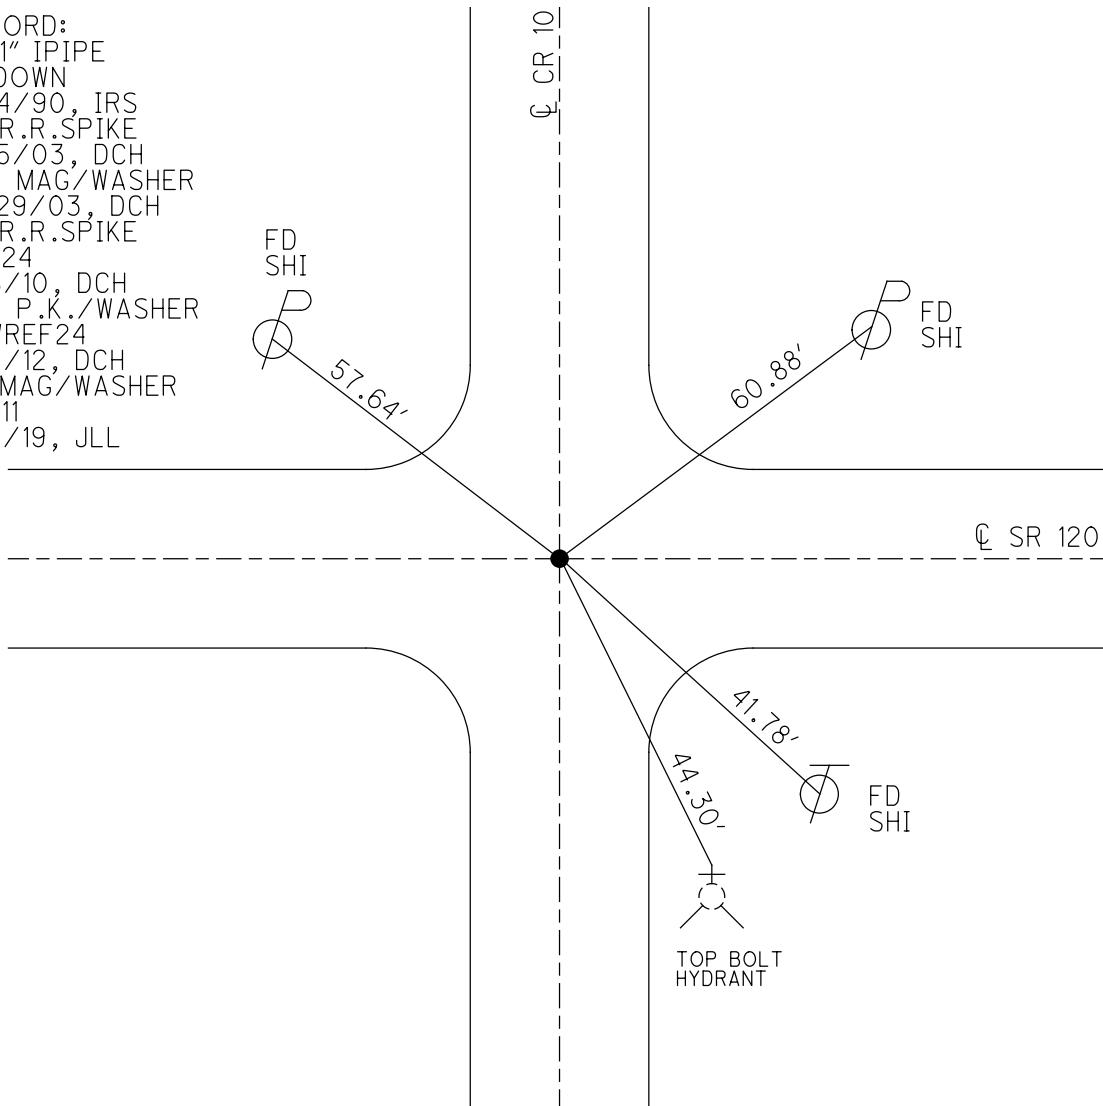


O.D.O.T. DISTRICT 2 SURVEY OFFICE (USE ONLY)

PERSONNEL _____ REFERENCE NO. 11 SHEET 25 OF 45
 NOTES HOMAN _____ DATE 5/11/12 ROUTE SR 120
 H.C. ROUSOS _____ WEATHER SUNNY COUNTY FULTON
 R.C. HOMAN _____ TEMP. 55° TOWNSHIP ROYALTON
 _____ SECTION 9
 _____ T 9 N R 3 E

TYPE MONUMENT R.R.SPIKE
~~ON SURFACE~~ - BELOW ON
 LEFT - ℄ PAV'T - ~~RIGHT~~ 2.5'
- TO - EDGE PAVEMENT
 S.L.M. 333+58.27

GRID: NORTHING: 744464.649 EASTING: 1543499.873

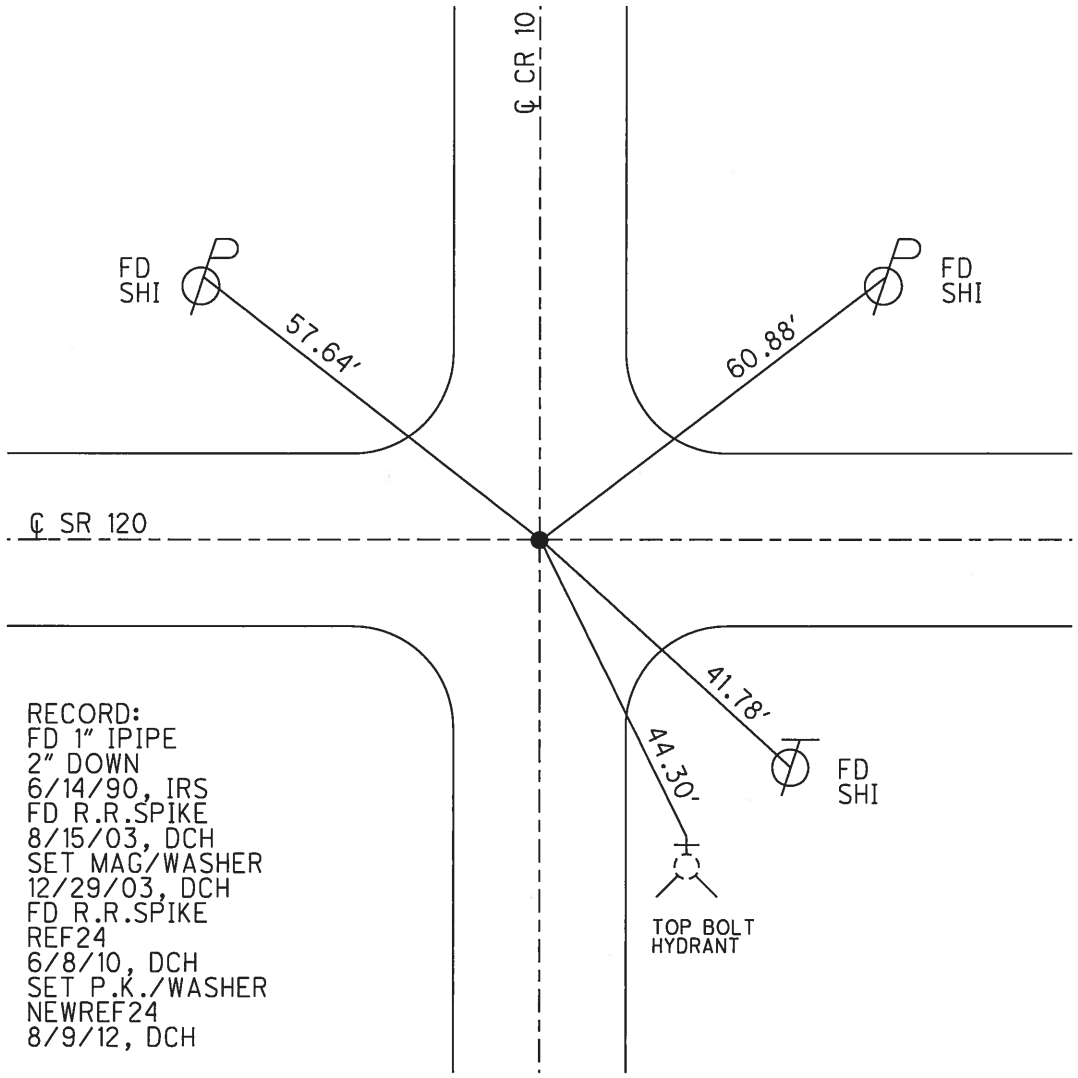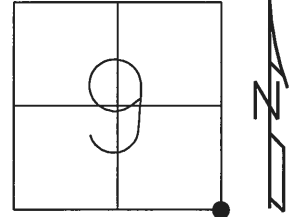

RECORD:
 FD 1" IPIPE
 2" DOWN
 6/14/90, IRS
 FD R.R.SPIKE
 8/15/03, DCH
 SET MAG/WASHER
 12/29/03, DCH
 FD R.R.SPIKE
 REF24
 6/8/10, DCH
 SET P.K./WASHER
 NEWREF24
 8/9/12, DCH

O.D.O.T. DISTRICT 2 SURVEY OFFICE

PERSONNEL _____

REFERENCE NO. 11

SHEET 25 OF 45

NOTES STONE

DATE 6/14/90

ROUTE SR 120

H.C. CURTIS

WEATHER WARM

COUNTY FULTON

R.C. HOUSEHOLDE

TEMP. 77°

TOWNSHIP ROYALTON

SECTION 9,10,15,16

T 9 N R 3 E


TYPE MONUMENT 1" IPIPE

~~ON SURFACE~~ - BELOW 2"

LEFT - ℄ PAV'T - ~~RIGHT~~ 2.5'


TO EDGE PAVEMENT

S.L.M. 333+20

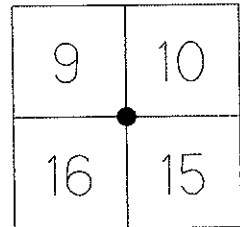

Grid: Northing: _____ Easting: _____

SET R.R. SPIKE
TO SURFACE
9/20/90, DC

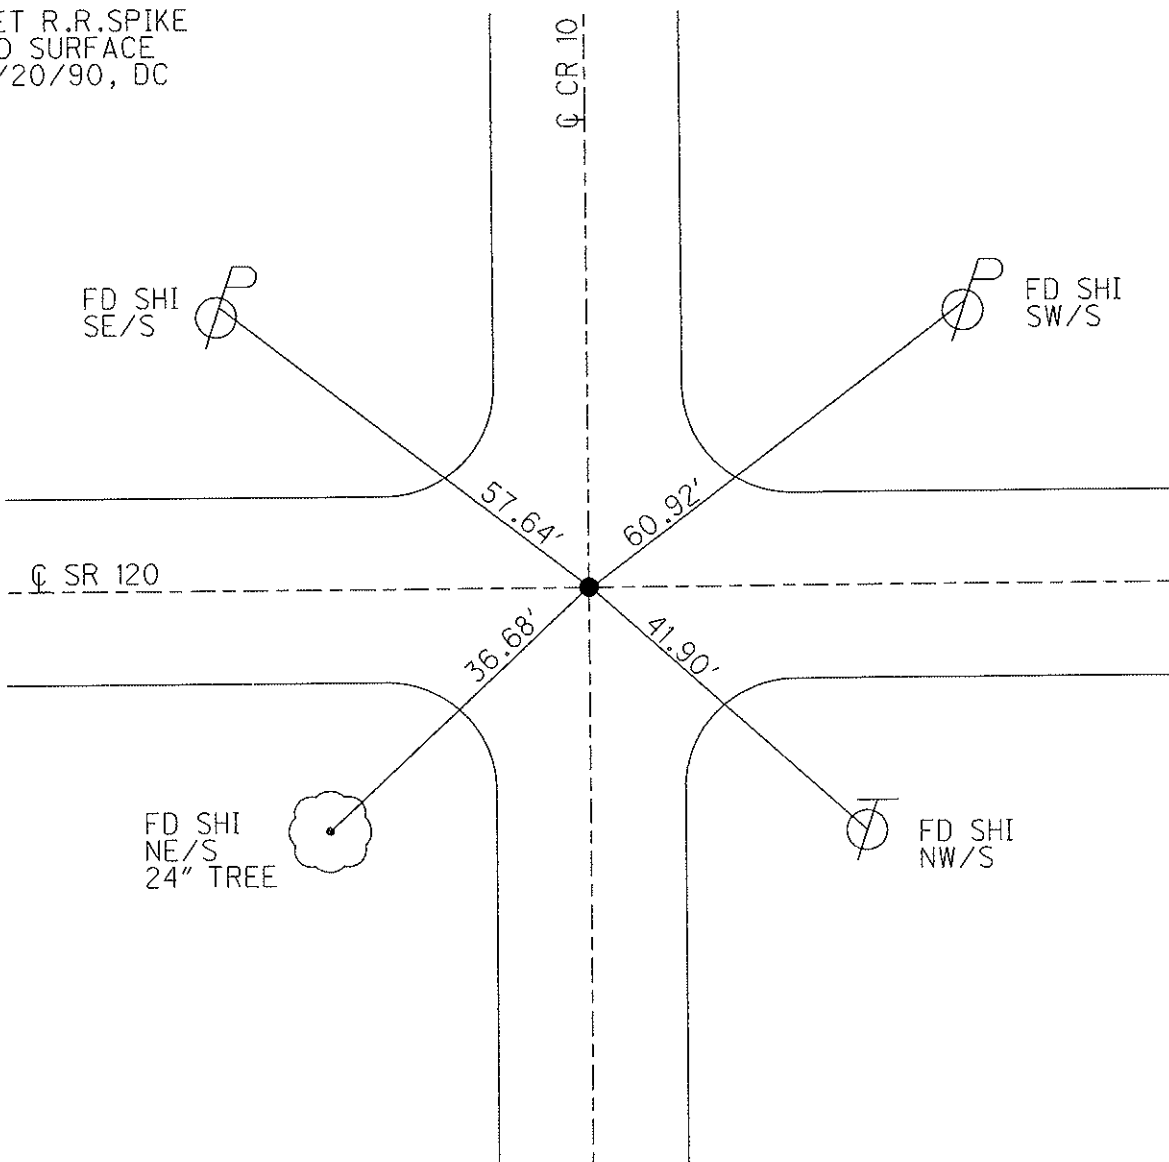

O.D.O.T. DISTRICT 2 SURVEY OFFICE

PERSONNEL

REFERENCE NO. 11

SHEET 1 OF 18

NOTES I. STONE

DATE 6-14-90

ROUTE S.R. 120

H.C. D. CURTIS

WEATHER WARM

COUNTY FULTON

R.C. J. HOUSEHOLDE

TEMP. 77°

TOWNSHIP ROYALTON

SECTION 9-10-15-16

T 9 S R 3 E

TYPE MONUMENT 1" I. PIPE

~~ON SURFACE~~ - BELOW 2"

LEFT - ~~C~~ PAV'T - RIGHT 2.5'


TO EDGE PAVEMENT

S.L.M. 333+20

9	10
16	15



SET R.R. SPIKE
TO SURFACE
9-20-90
DCURTIS

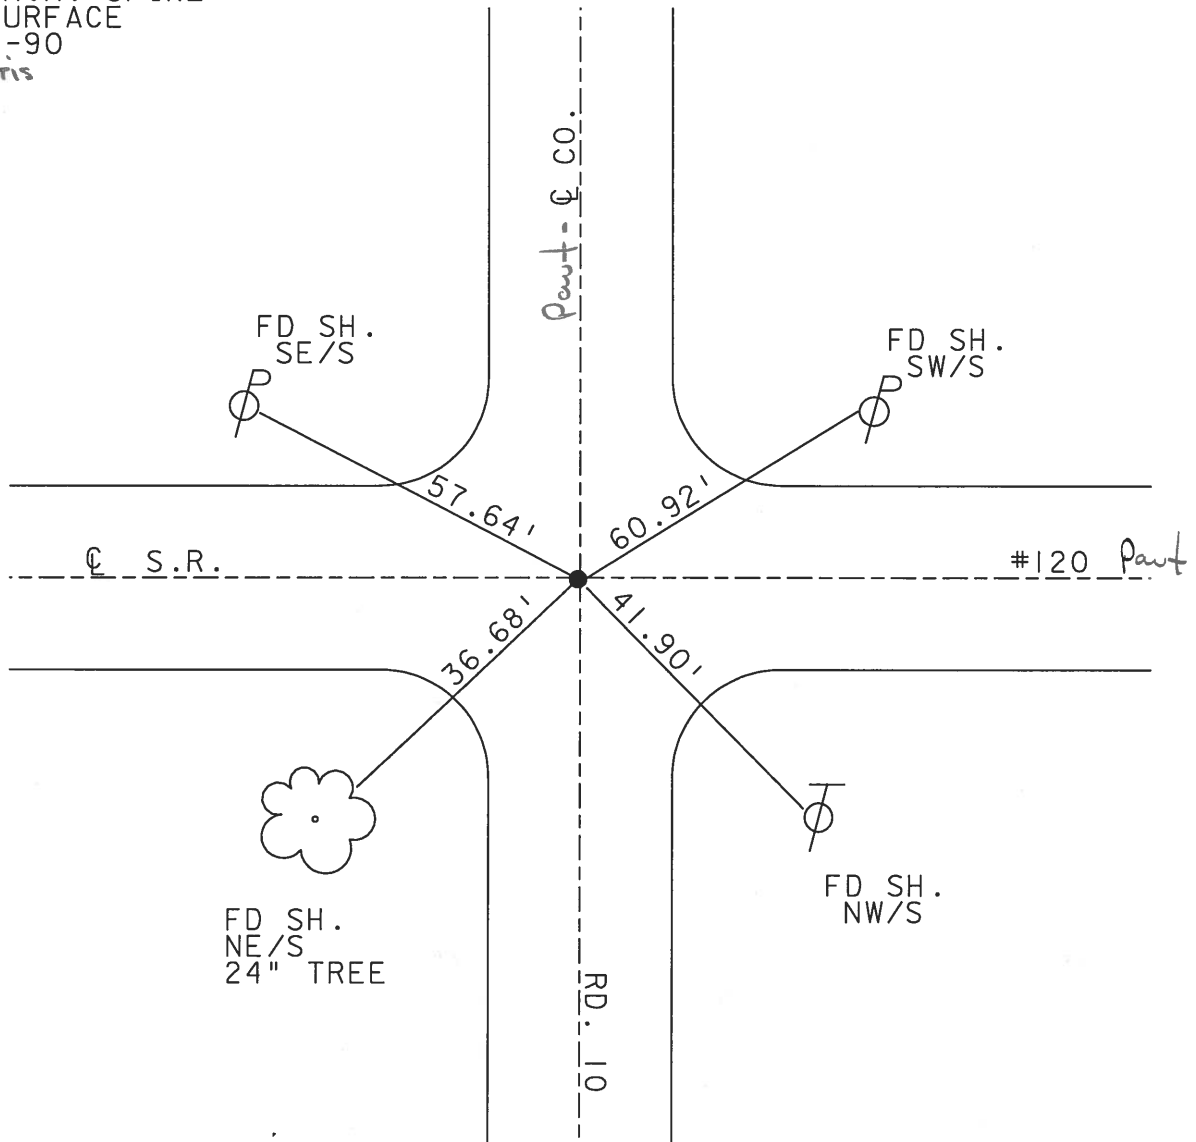

Redrawn - #11 to #13; Resurfaced #14 to #18 2003

O.D.O.T. DISTRICT 2 SURVEY OFFICE

PERSONNEL

REFERENCE NO. 11

SHEET 19 OF 20

NOTES 1. Stone

H.C. D. Curtis

R.C. J. Householder

DATE 14 June 90

WEATHER Warm

TEMP. 77°

ROUTE SR#120

COUNTY Fulton

TOWNSHIP Royalton

SECTION 9-10-15-16

T R


TYPE MONUMENT 1" I. pipe

ON SURFACE - BELOW 3" deep


LEFT - ~~E PAV'T.~~ RIGHT 2.5' Lt.

 TO EDGE PAVEMENT

S.L.M. 333+20

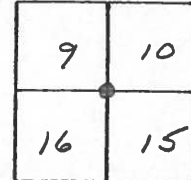

SET R.R. SPK. TO SURFACE
9-20-90
AJC

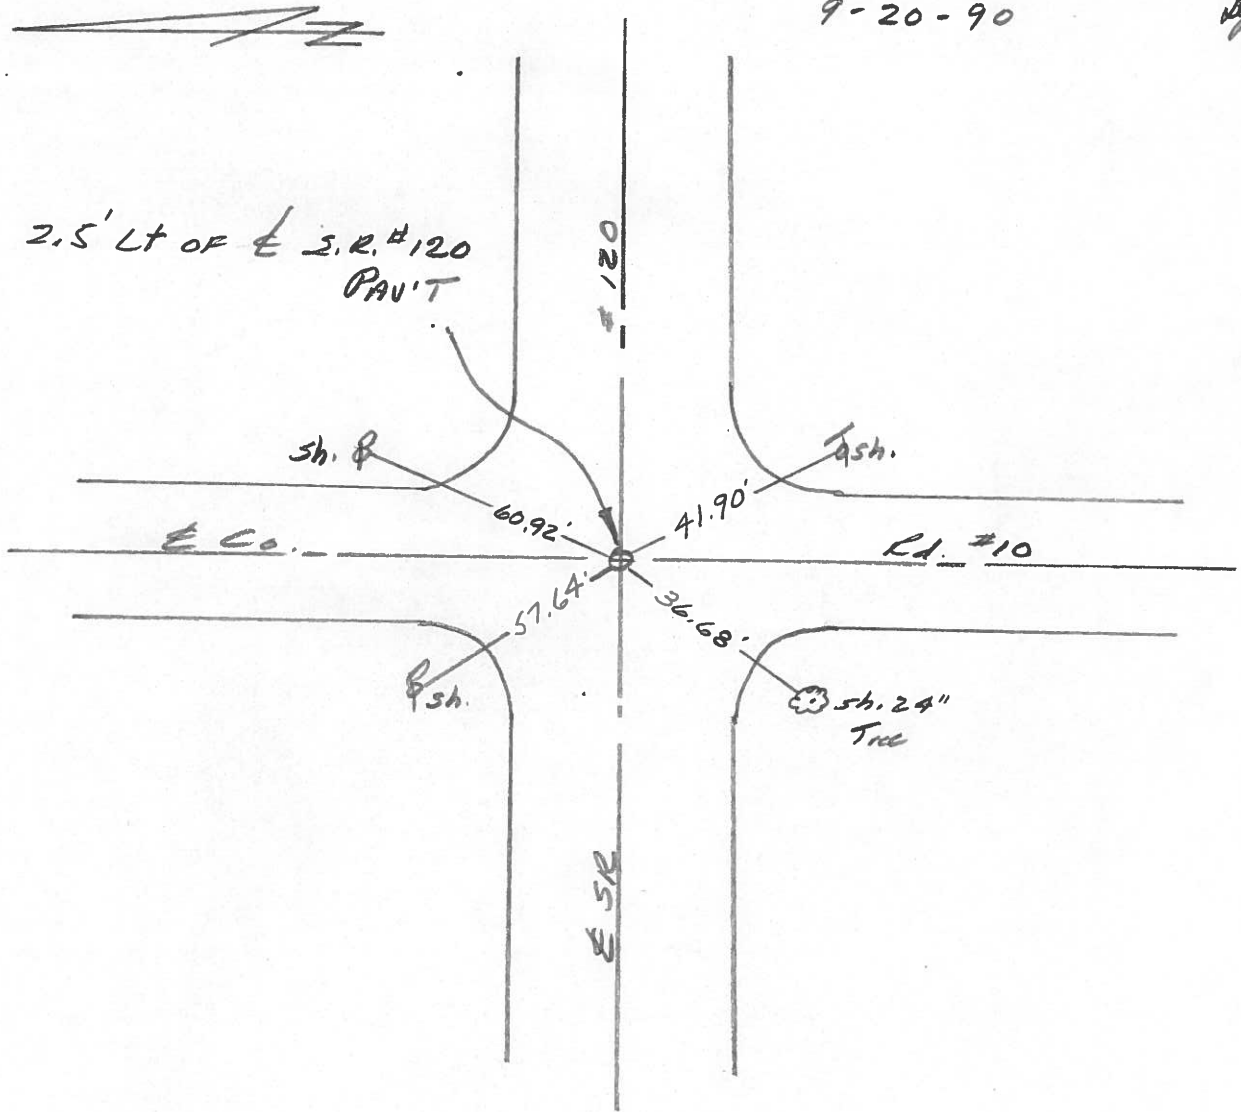

County Fulton S.R. 120

Township Royalton

Section 9-10-15-16

T_N, R_E

Personnel D. Curtis

P. Neuser

R. Michalak

Date 19 Sept. 84


Weather Mild

Temp. 75°

9	10
16	15




11

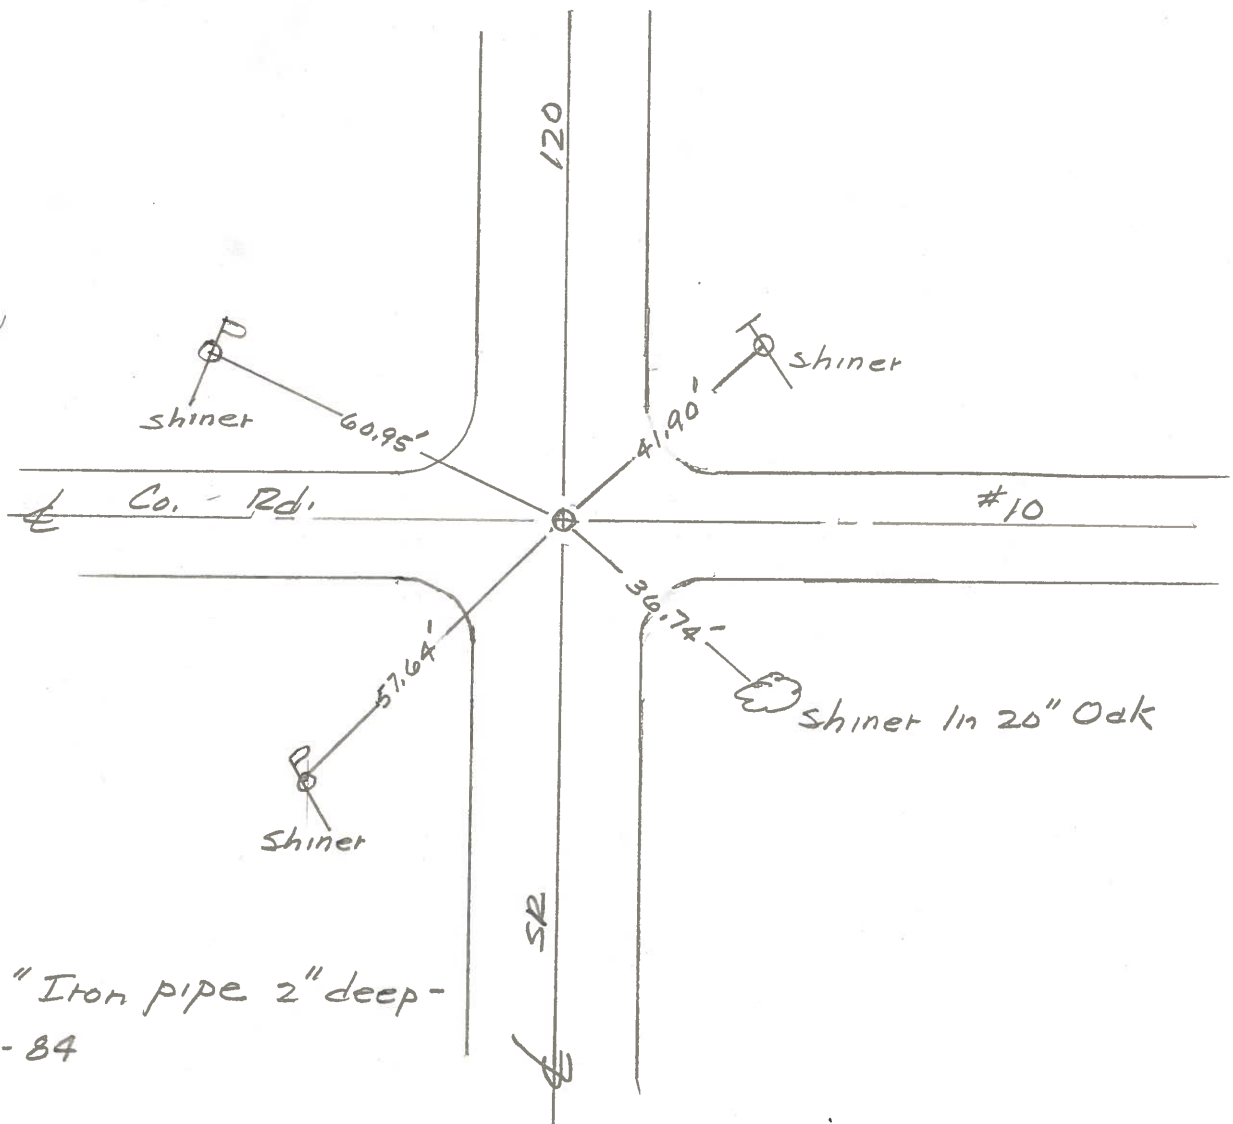

Fd. 1" Iron pipe 2" deep -
9-19-84

<u>Tomsir</u>	<u>Boyle</u>	COUNTY <u>Fulton</u>	DATE <u>July 10, 1913</u>
<u>Mouser</u>		S. R. <u>120</u>	WEATHER _____
<u>Granata</u>		SEC. <u>Royalton Twp</u>	TEMP _____
<u>Vaner</u>			

DESCRIPTION _____ LEFT _____ CENTER LINE _____ RIGHT _____ JOB NO. _____

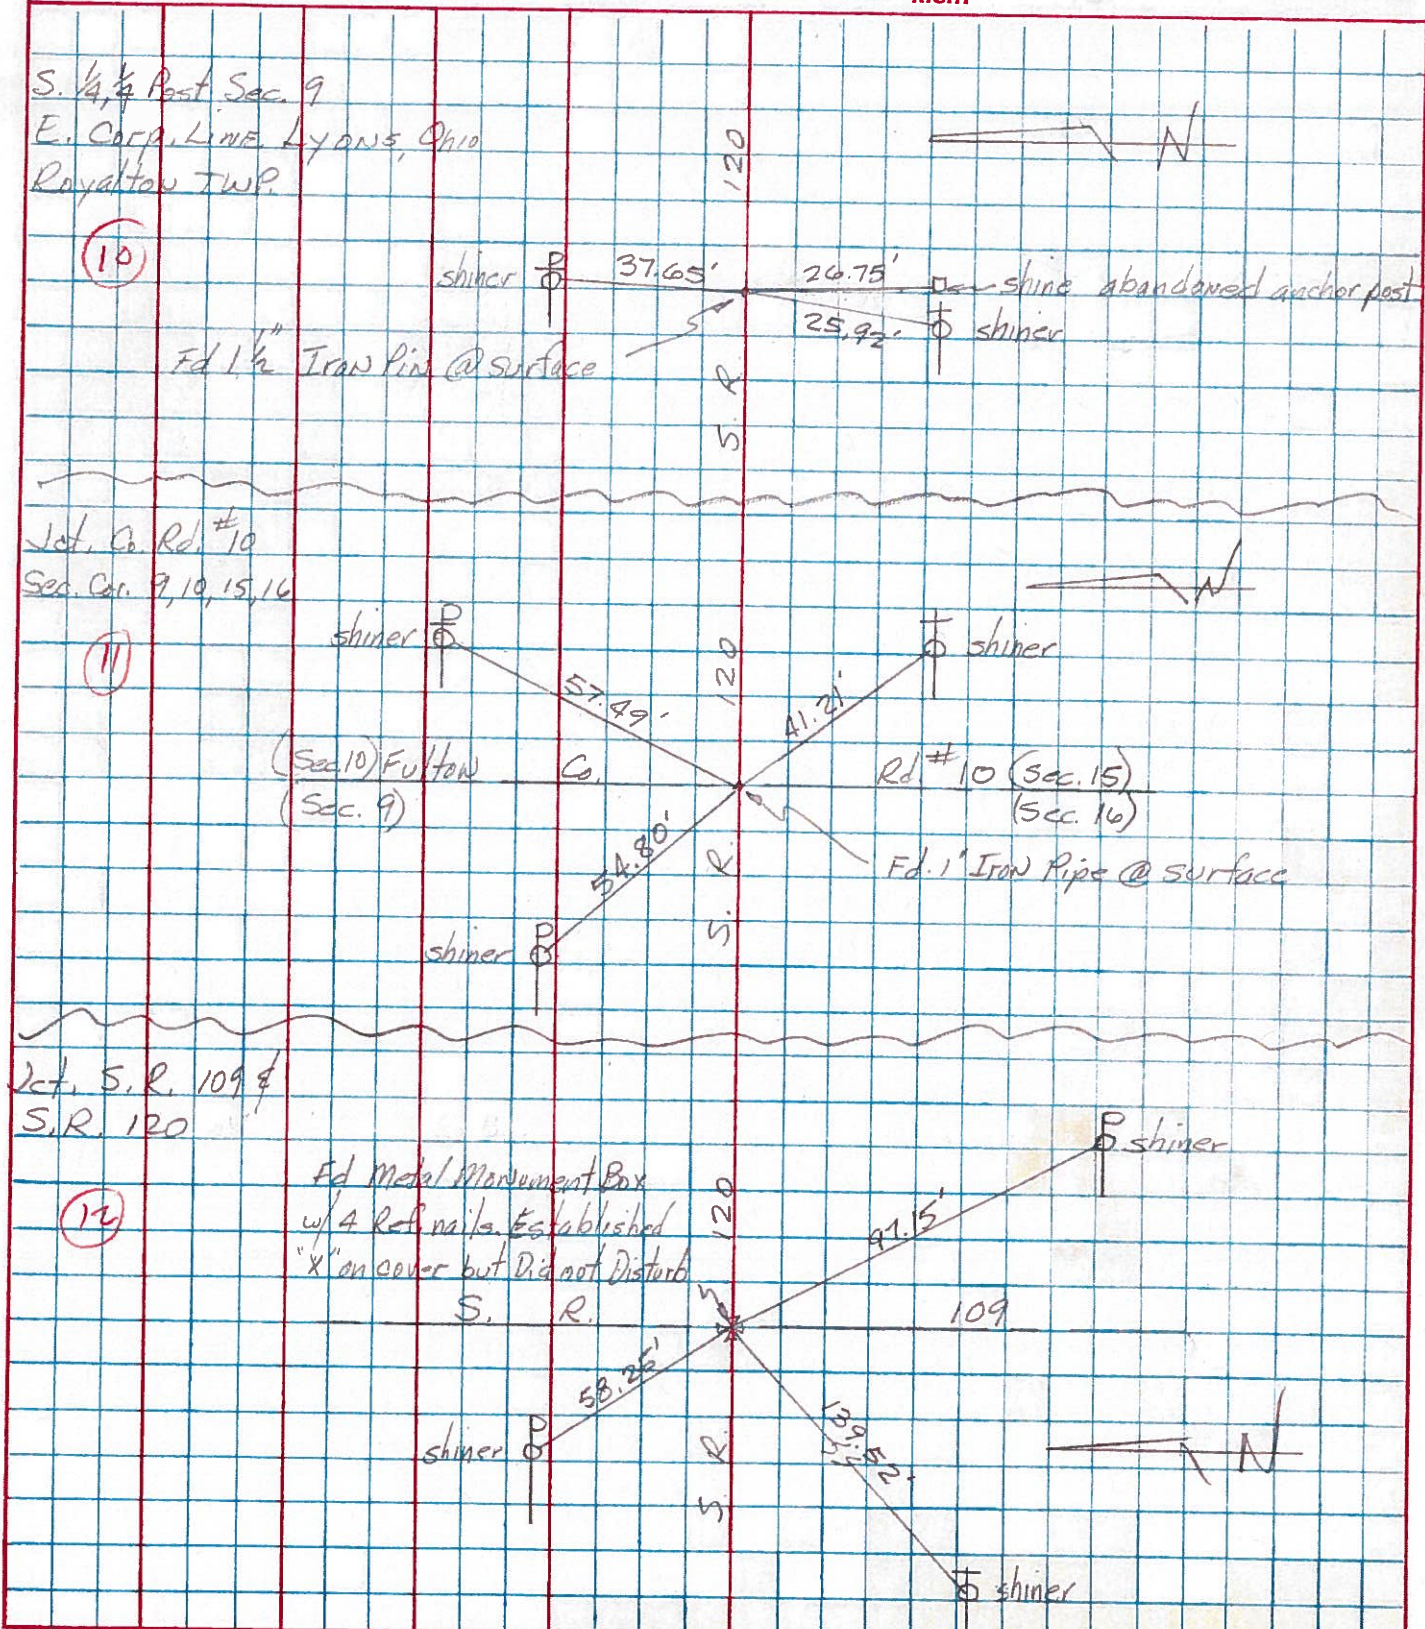

COMPUTATION SHEET

STATE OF OHIO - DEPARTMENT OF HIGHWAYS - BUREAU OF LOCATION AND DESIGN _____ COLUMBUS, OHIO
BY Denno - Granata - Curtis - Omev DATE June 7, 1966 NO. _____ OF _____ SHEETS
COUNTY Fulton SECTION _____
DIV. NO. _____ S.R. 120 U.S.R. _____ I. R. _____
SUBJECT OF THIS SHEET Monument Ref SR. 120

