


O.D.O.T. DISTRICT 2 SURVEY OFFICE (USE ONLY)


PERSONNEL _____ REFERENCE NO. 12 B SHEET 32 OF 50
 NOTES HOMAN DATE 5/11/12 ROUTE SR 120
 H.C. ROUSOS WEATHER SUNNY COUNTY FULTON
 R.C. HOMAN TEMP. 60° TOWNSHIP ROYALTON
 DWG BY RHOADES PID PAVETRAIN SECTION 11
 T 9 N R 3 E

TYPE MONUMENT MONBOX W/1" IPIN
 ON SURFACE - ~~BELOW~~ ON
 OFFSET Q PAVEMENT 3' LT : ~~RT~~
7.3' TO LT EDGE PAVEMENT
 STATION: 391+23.05

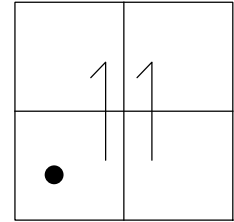

HORZ. DATUM: NAD83 2011 GEOID: NAVD88 2018
 GRID: NORTHING: 744695.209 EASTING: 1549185.185


RECORD: P.I.
 FD MONBOX
 5/12/81, DC
 FD MONBOX
 REF28
 6/8/10, DCH
 FD NEW MONBOX
 NEWREF28
 5/11/12, DCH
 FD MONBOX
 W/1" IPIN
 REFB12
 7/1/22, DSA
 4/12/23, JMR

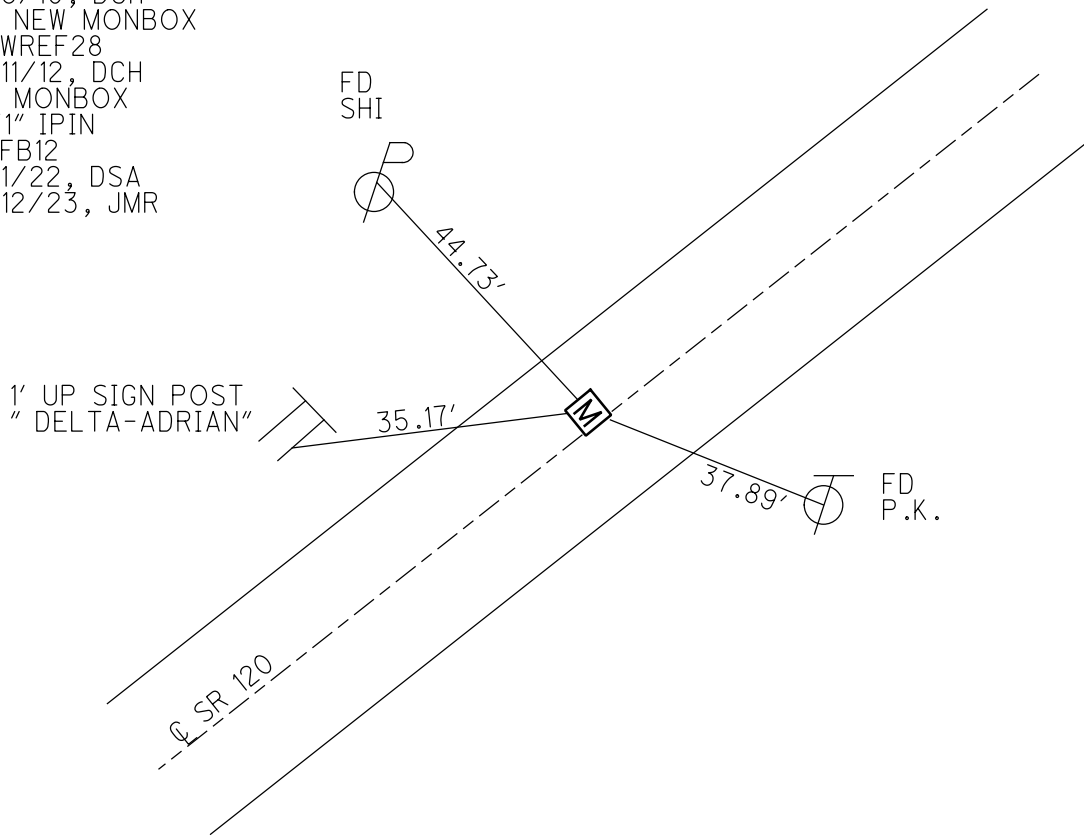

O.D.O.T. DISTRICT 2 SURVEY OFFICE (USE ONLY)


PERSONNEL _____ REFERENCE NO. 12 B SHEET 29 OF 45
 NOTES HOMAN DATE 5/11/12 ROUTE SR 120
 H.C. ROUSOS WEATHER SUNNY COUNTY FULTON
 R.C. HOMAN TEMP. 60° TOWNSHIP ROYALTON
 _____ SECTION 11
 _____ T 9 N R 3 E

TYPE MONUMENT MONBOX
 ON SURFACE - ~~BELOW~~ ON _____
 LEFT - CL PAV'T - ~~RIGHT~~ 3'
7.3' TO LT EDGE PAVEMENT
 S.L.M. 391+23.05

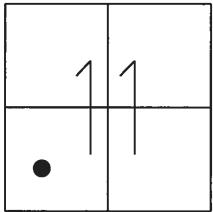

GRID: NORTHING: 744695.148 EASTING: 1549185.772

RECORD: P.I.
 FD MONBOX
 5/12/81, DC
 FD MONBOX
 REF28
 6/8/10, DCH
 FD NEW MONBOX
 NEWREF28
 5/11/12, DCH

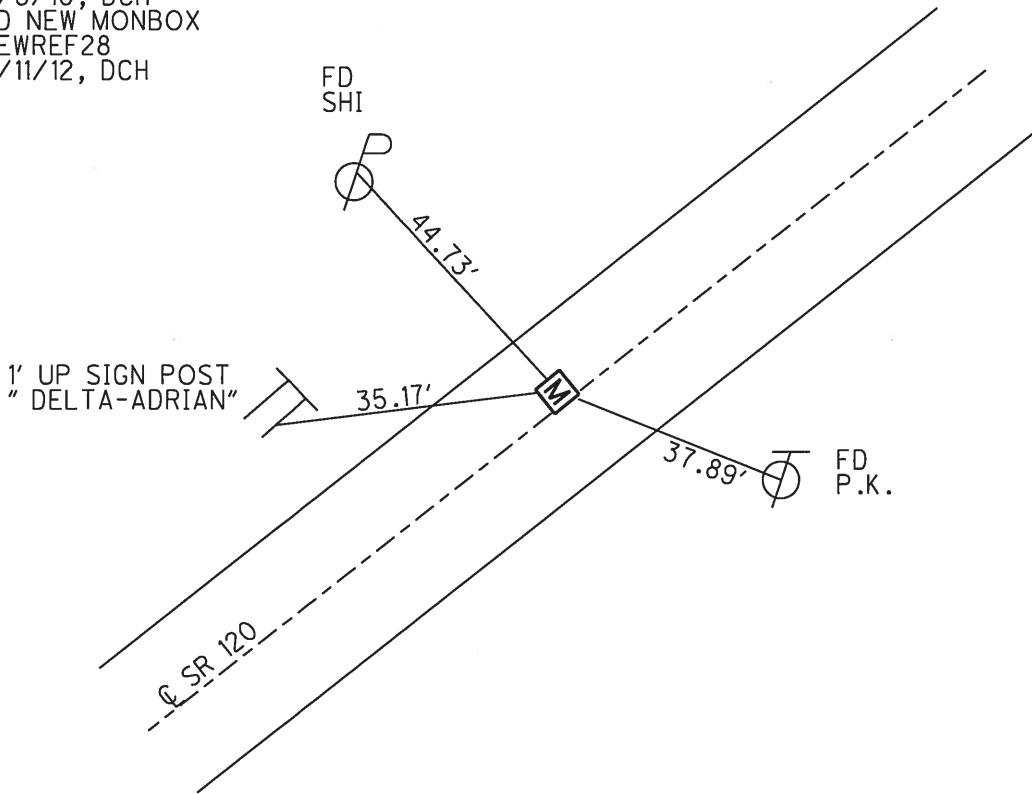

O.D.O.T. DISTRICT 2 SURVEY OFFICE

PERSONNEL

REFERENCE NO. 12 B

SHEET 29 OF 45

NOTES STONE
 H.C. NEUSER
 R.C. MICHALAK
CURTIS

DATE 5/12/81
 WEATHER CLEAR
 TEMP. 55°

ROUTE SR 120
 COUNTY FULTON
 TOWNSHIP ROYALTON
 SECTION 11
 T 9 N R 3 E

TYPE MONUMENT MON.BOX


ON SURFACE - ~~BELOW~~ ON

LEFT - Q PAV'T - ~~RIGHT~~ 3'


7.3' TO N EDGE PAVEMENT (12.9' to S.EDGE)

S.L.M. 391+69

Grid: Northing: _____ Easting: _____

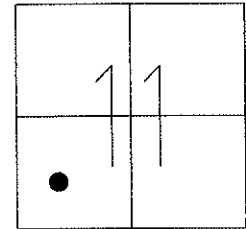

FD MON.BOX TO SURFACE.
 P.I. 256.10' RT.
 GOOD CONDITION, 7/28/81

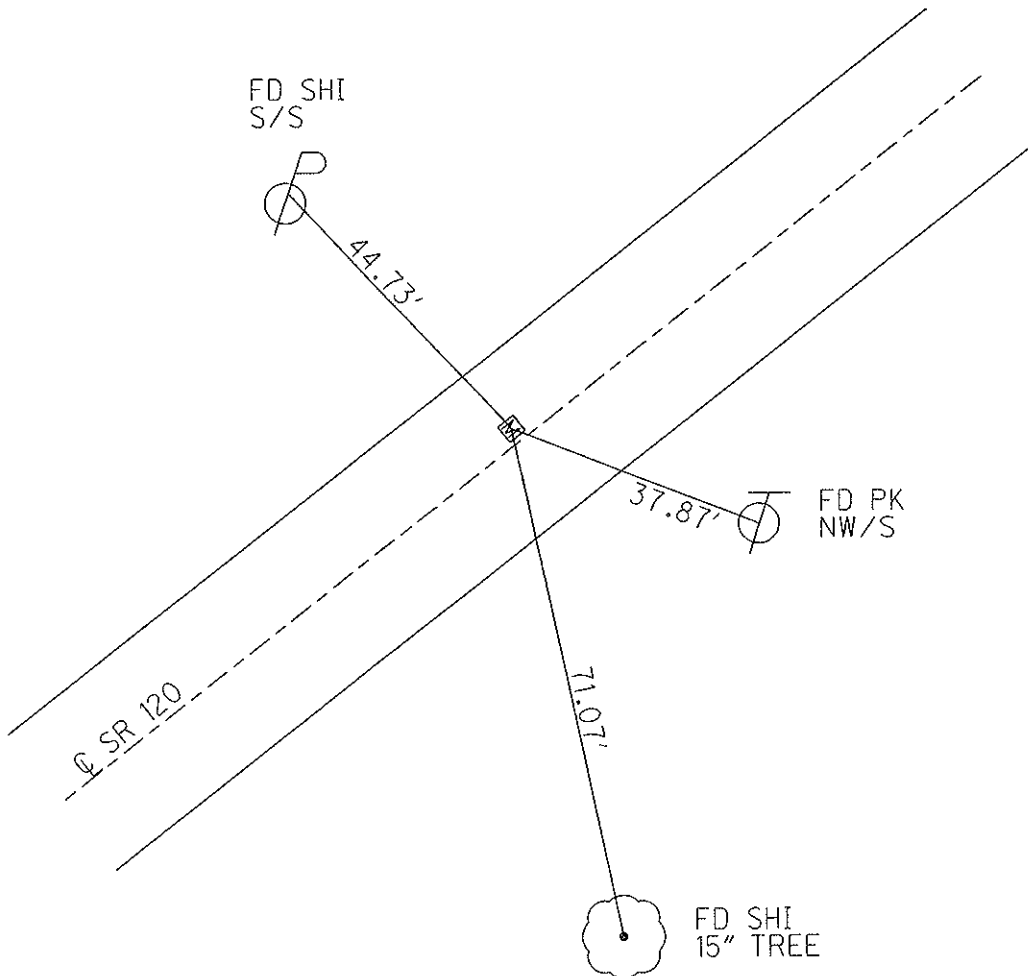

O.D.O.T. DISTRICT 2 SURVEY OFFICE

PERSONNEL

REFERENCE NO. 128

SHEET 5 OF 18

NOTES I. STONE

DATE 5-12-81

ROUTE S.R. 120

H.C. P. NEUSER

WEATHER CLEAR

COUNTY FULTON

R.C. R. MICHALAK

TEMP. 55°

TOWNSHIP ROYALTON

D. CURTIS

SECTION 11

T 9 S R 3 E


TYPE MONUMENT MON BOX

ON SURFACE - ~~BELOW~~ ON


LEFT - Q PAV'T - ~~RIGHT~~ 3'

TO EDGE PAVEMENT

S.L.M. _____

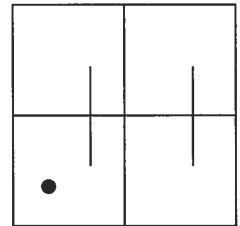

FD. MON. BOX TO SURFACE
 PI RT
 7.3' TO N. EDGE PVT.
 12.9' TO S. EDGE PVT.
 OK 7-28-81

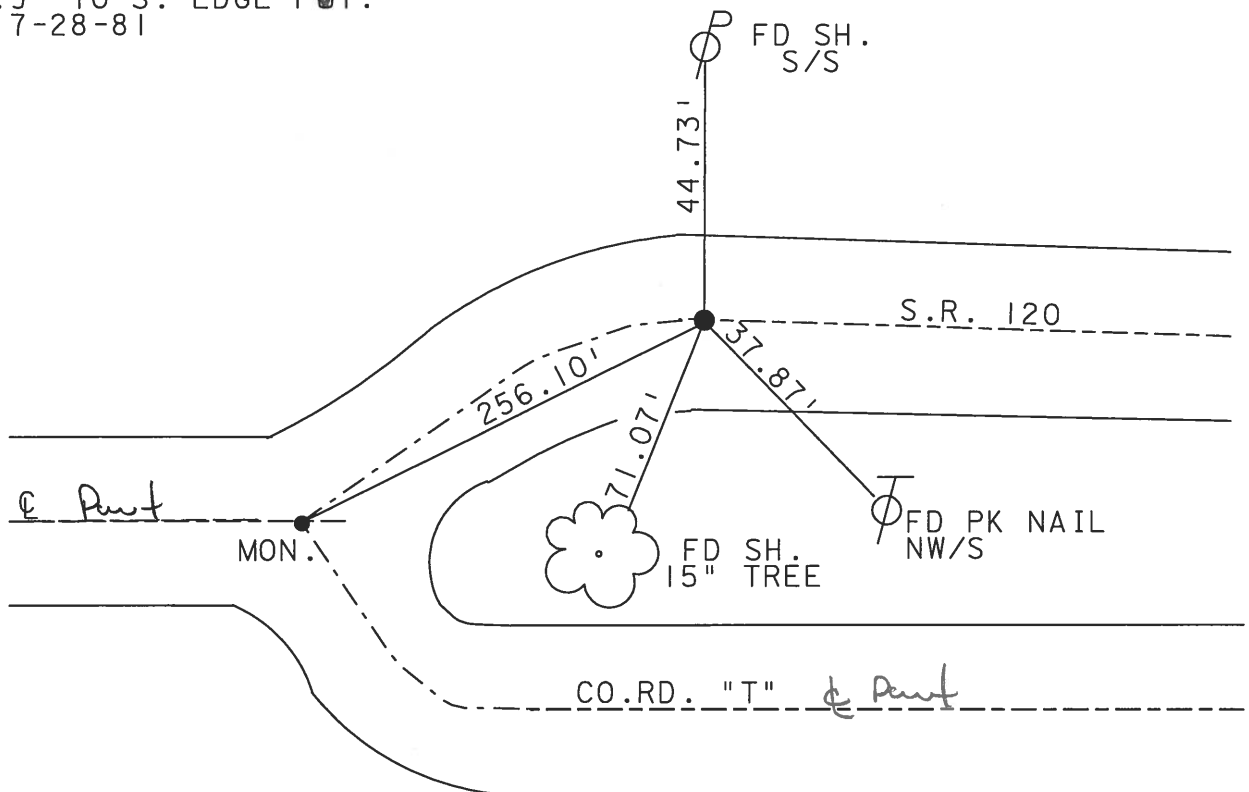

County Fulton S.R. 120

Date 12 May 81

Township Royalton

Weather Clear

Section 11

Temp. 55°


T N, R E

Personnel L. Stone


P. Neuser

R. Michalak

D. Curtis

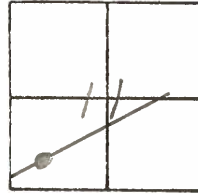

Ref No. 12 B

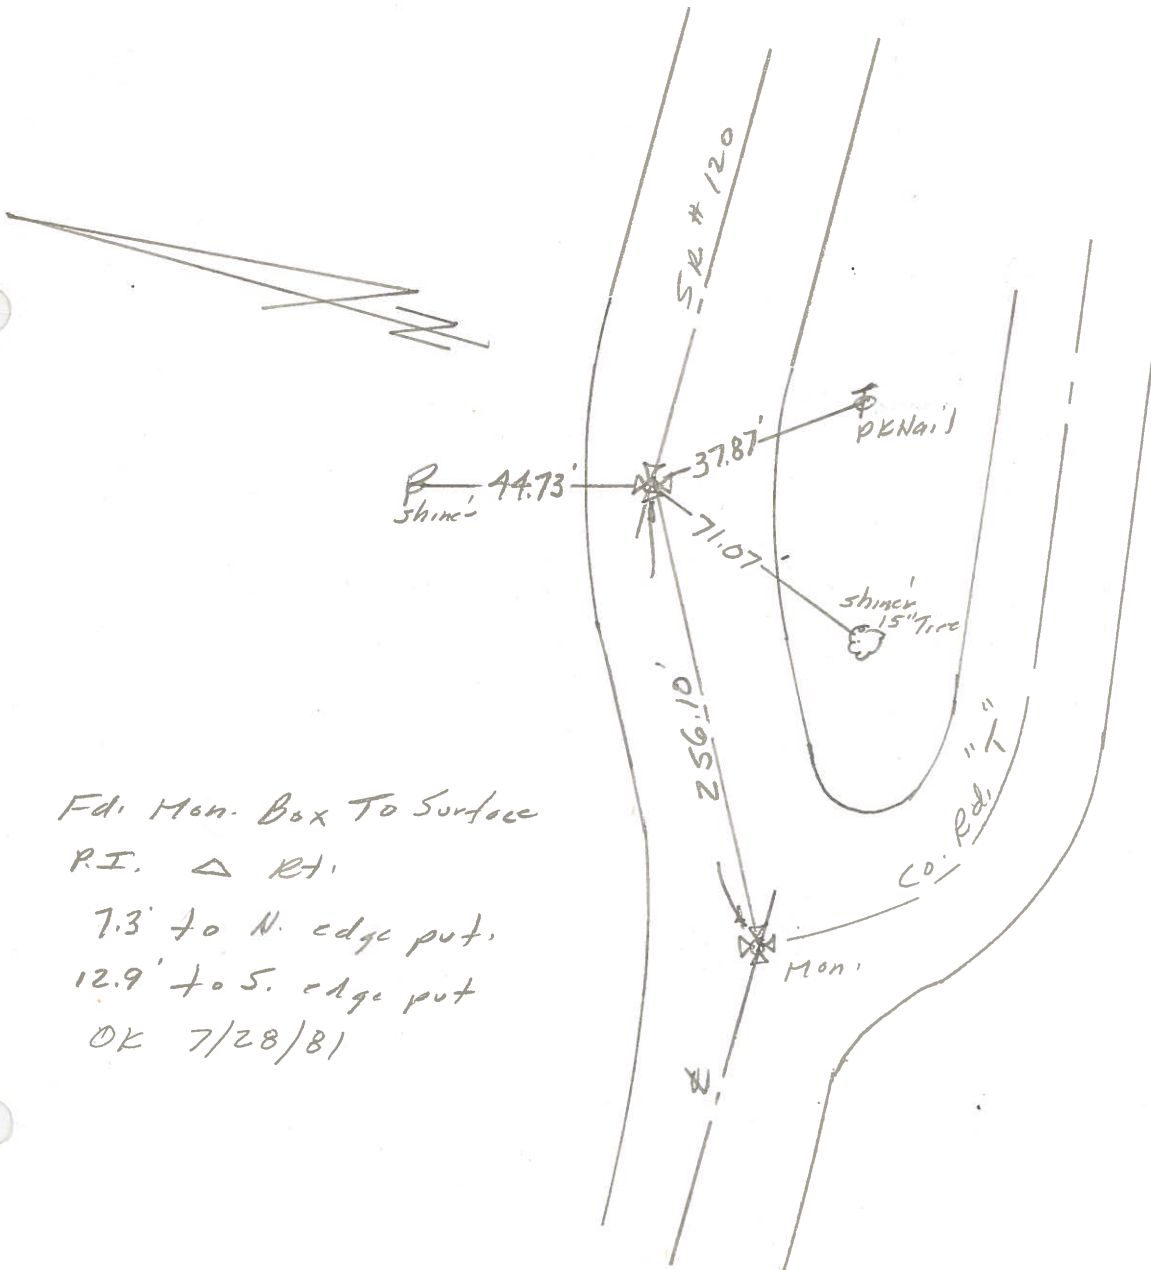

Fdi Man. Box To Surface

P.I. Δ RT.

7.3' to N. edge put.

12.9' to S. edge put

OK 7/28/81

| PERSONNEL | TITLE | PERSONNEL | TITLE |
|-----------|-------|-----------|-------|
| Tomsic | | | |
| Granata | | | |
| Vauvo | | | |
| Boyle | | | |

COUNTY Fulton DATE July 11, 1973

S. R. 120 WEATHER _____

SEC. Royalton Twp. TEMP. _____

DESCRIPTION _____ LEFT _____ CENTER LINE _____ RIGHT _____ JOB NO. _____

