


O.D.O.T. DISTRICT 2 SURVEY OFFICE (USE ONLY)


PERSONNEL \_\_\_\_\_ REFERENCE NO. 12 C SHEET 33 OF 50  
 NOTES HOMAN \_\_\_\_\_ DATE 5/11/12 \_\_\_\_\_ ROUTE SR 120  
 H.C. ROUSOS \_\_\_\_\_ WEATHER SUNNY \_\_\_\_\_ COUNTY FULTON  
 R.C. HOMAN \_\_\_\_\_ TEMP. 60° \_\_\_\_\_ TOWNSHIP ROYALTON  
 \_\_\_\_\_ SECTION 11  
 DWG BY RHOADES \_\_\_\_\_ PID PAVETRAN \_\_\_\_\_  
 \_\_\_\_\_ T 9 N R 3 E

TYPE MONUMENT MAG NAIL  
 ON SURFACE - ~~BELOW~~ ON  
 OFFSET 0.6' LT : ~~RT~~  
10' TO LT EDGE PAVEMENT  
 STATION: 394+41.34

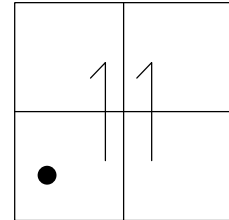

HORZ. DATUM: NAD83 2011 \_\_\_\_\_ GEOID: NAVD88 2018 \_\_\_\_\_  
 GRID: NORTHING: 744870.817 \_\_\_\_\_ EASTING: 1549451.367 \_\_\_\_\_


RECORD:  
 1928 PLAN  
 $\Delta = 0^\circ 13' 20''$   
 SET P.K.NAIL  
 4/17/91, IRS  
 FD P.K.NAIL  
 1991  
 SET P.K./WASHER  
 3/18/92  
 FD MAG NAIL  
 REF29  
 6/8/10, DCH  
 SET MAG/WASHER  
 NEWREF29  
 8/29/12, DCH  
 FD MAG/WASHER  
 REFC12  
 7/1/22, DSA  
 4/12/23, JMR

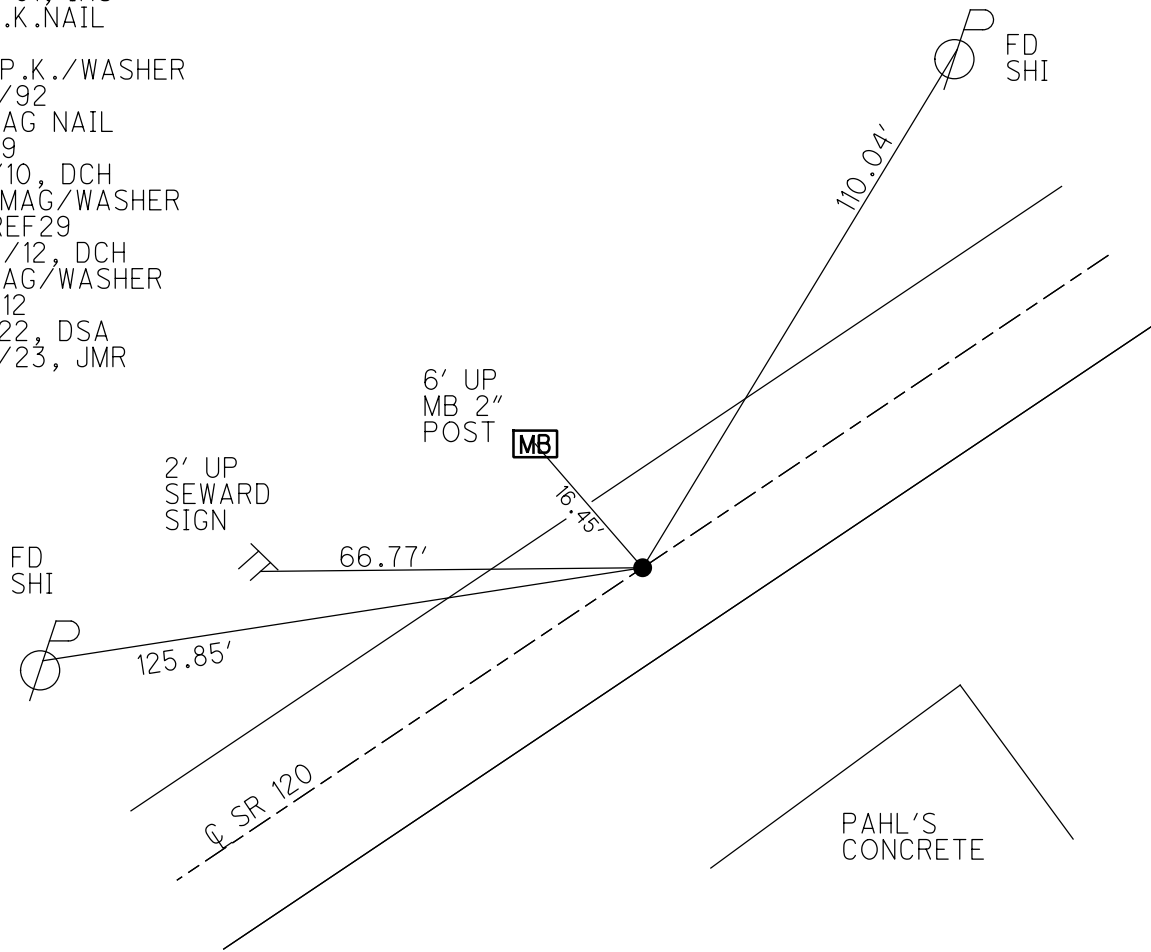

**O.D.O.T. DISTRICT 2 SURVEY OFFICE (USE ONLY)**


PERSONNEL \_\_\_\_\_ REFERENCE NO. 12 C SHEET 30 OF 45  
 NOTES HOMAN DATE 5/11/12 ROUTE SR 120  
 H.C. ROUSOS WEATHER SUNNY COUNTY FULTON  
 R.C. HOMAN TEMP. 60° TOWNSHIP ROYALTON  
 \_\_\_\_\_ SECTION 11  
 \_\_\_\_\_ T 9 N R 3 E

TYPE MONUMENT MAG NAIL  
 ON SURFACE - ~~BELOW~~ ON  
 LEFT - C PAV'T - ~~RIGHT~~ 0.6'  
10' TO LT EDGE PAVEMENT  
 S.L.M. 394+41.34

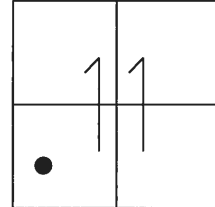

GRID: NORTHING: 744870.763 EASTING: 1549451.292

RECORD:  
 1928 PLAN  
 $\Delta = 0^\circ 13' 20''$   
 SET P.K.NAIL  
 4/17/91, IRS  
 FD P.K.NAIL  
 1991  
 SET P.K./WASHER  
 3/18/92  
 FD MAG NAIL  
 REF29  
 6/8/10, DCH  
 SET MAG/WASHER  
 NEWREF29  
 8/29/12, DCH

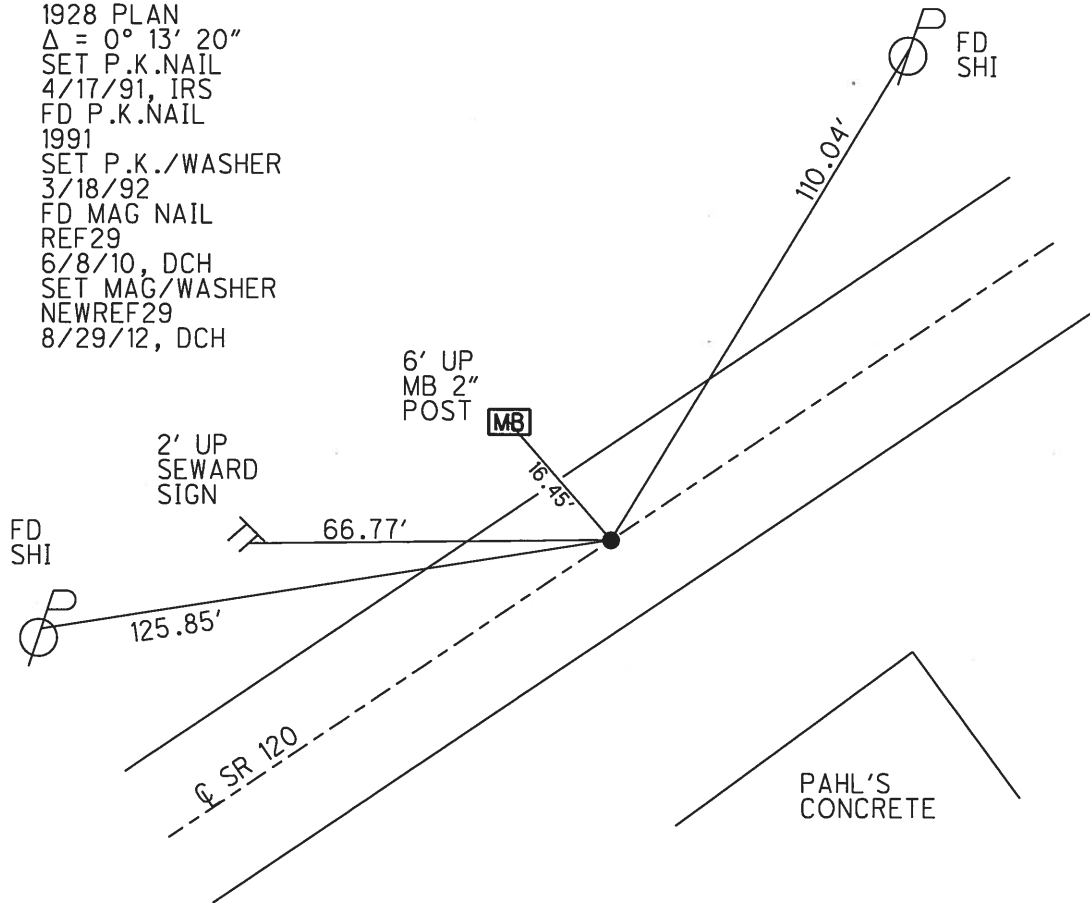

O.D.O.T. DISTRICT 2 SURVEY OFFICE

PERSONNEL \_\_\_\_\_

REFERENCE NO. 12 C

SHEET 30 OF 45

NOTES STONE

DATE 4/17/91

ROUTE SR 120

H.C. CURTIS

WEATHER COOL

COUNTY FULTON

R.C. HOUSEHOLDE

TEMP. 55°

TOWNSHIP ROYALTON

SECTION 11

T 9 N R 3 E

TYPE MONUMENT P.K.NAIL


ON SURFACE - ~~BELOW~~ ON \_\_\_\_\_

LEFT - Q PAV'T - ~~RIGHT~~ 0.6'

10' TO LT EDGE PAVEMENT


S.L.M. 394+47

Grid: Northing: \_\_\_\_\_ Easting: \_\_\_\_\_

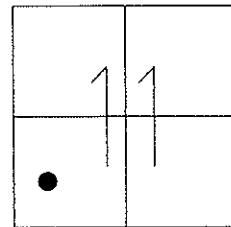

SET P.K. NAIL AS  
PER 1928 PLAN, 1991.  
DELTA= 0° 13' 20"

SET P.K./WASHER  
3/18/92

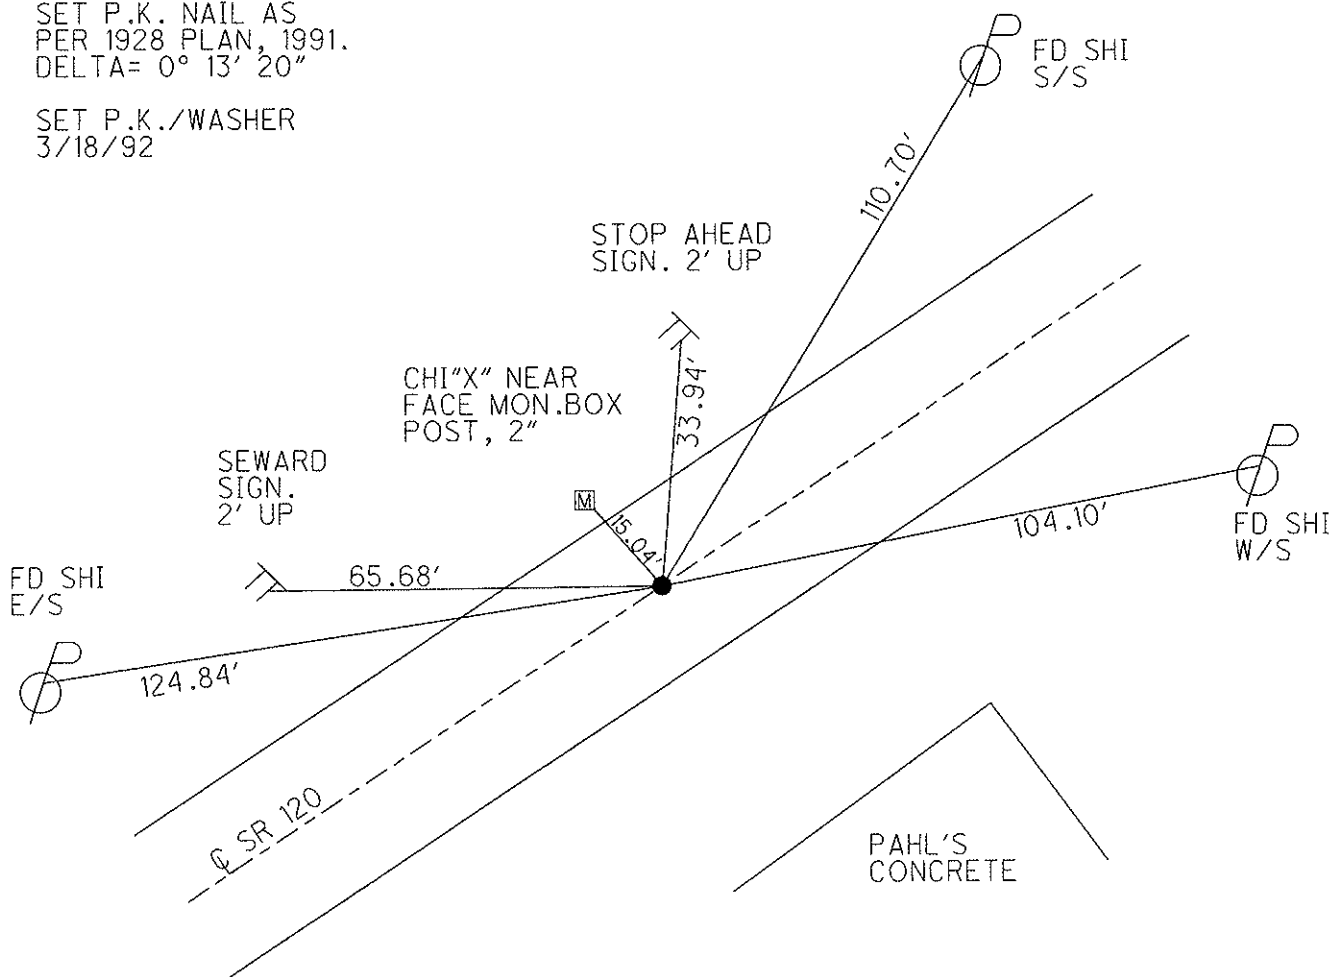

O.D.O.T. DISTRICT 2 SURVEY OFFICE

PERSONNEL

REFERENCE NO. 12c

SHEET 6 OF 18

NOTES I. STONE

DATE 4-17-91

ROUTE S.R. 120

H.C. D. CURTIS

WEATHER COOL

COUNTY FULTON

R.C. J. HOUSEHOLDE

TEMP. 55°

TOWNSHIP ROYALTON

SECTION 11

T 9 S R 3 E


TYPE MONUMENT PK NAIL

ON SURFACE ~~-BELOW~~ ON

LEFT ~~-C PAVT~~ RIGHT 0.6


10. TO LT EDGE PAVEMENT

S.L.M. 394+47

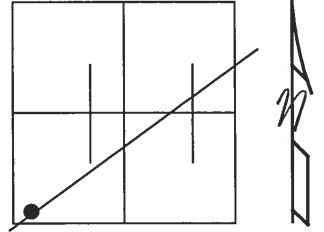

1991  
SET PK NAIL AS  
PER 1928 PLAN  
DELTA = 0° 13' 20" (MEAS)

3-18-1992  
Set P.C./washer

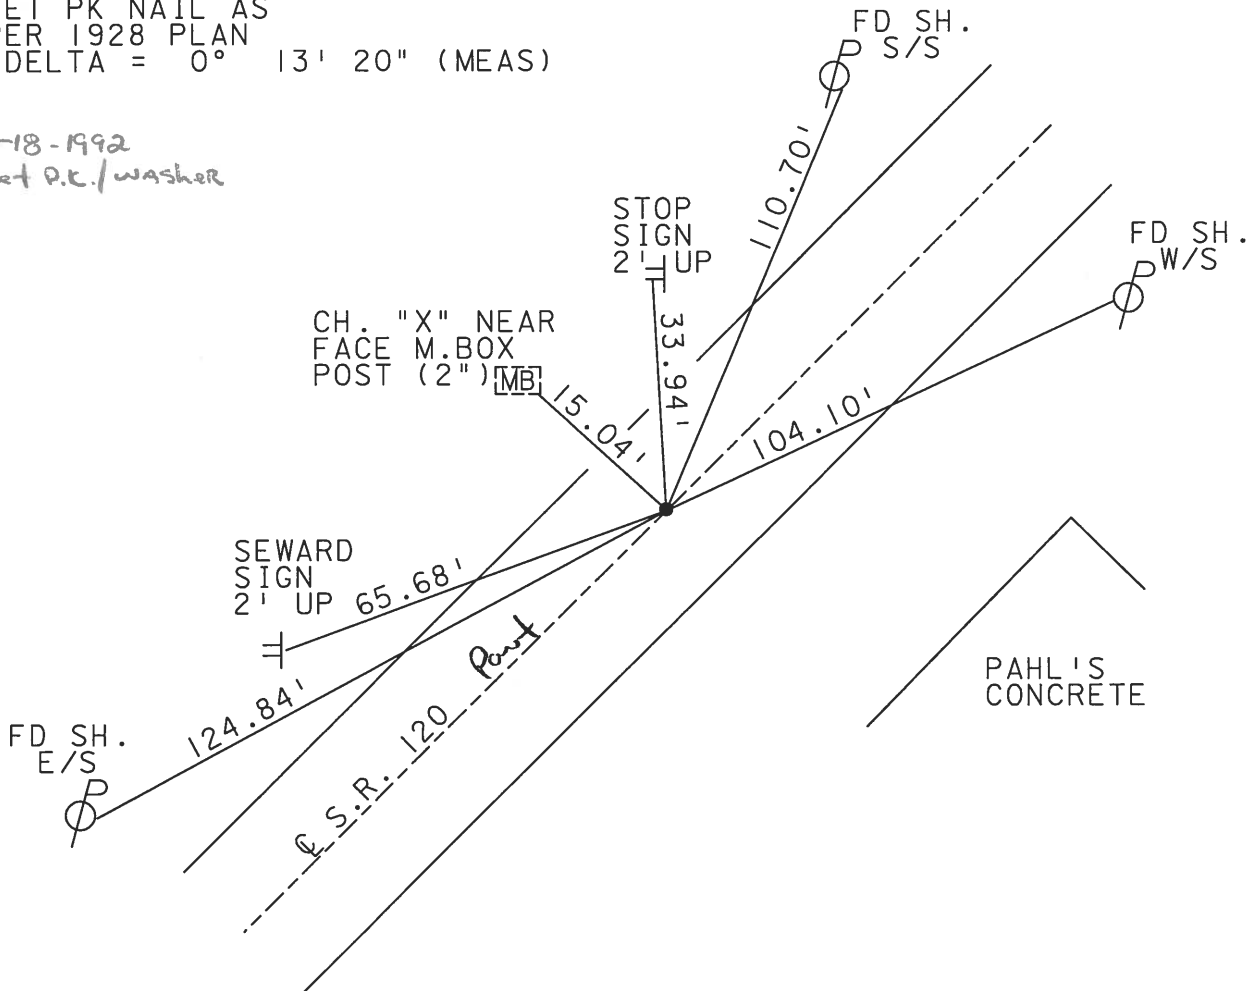

O.D.O.T. DISTRICT 2 SURVEY OFFICE

PERSONNEL

REFERENCE NO. 12-C

SHEET 1 OF       

NOTES 1. Stone

H.C. D. Curtis

R.C. J. Hooschelder

DATE 17 April 91

WEATHER Coal

TEMP. 55°

ROUTE SR #120

COUNTY Fulton

TOWNSHIP Royalton

SECTION 11

T        R       

TYPE MONUMENT PK Nail



ON SURFACE - BELOW Surface

LEFT - C PAV'T. - RIGHT 0.6

10.0 TO Lt EDGE PAVEMENT

S.L.M. 394+47

Set PK/WASHER  
3-18-92

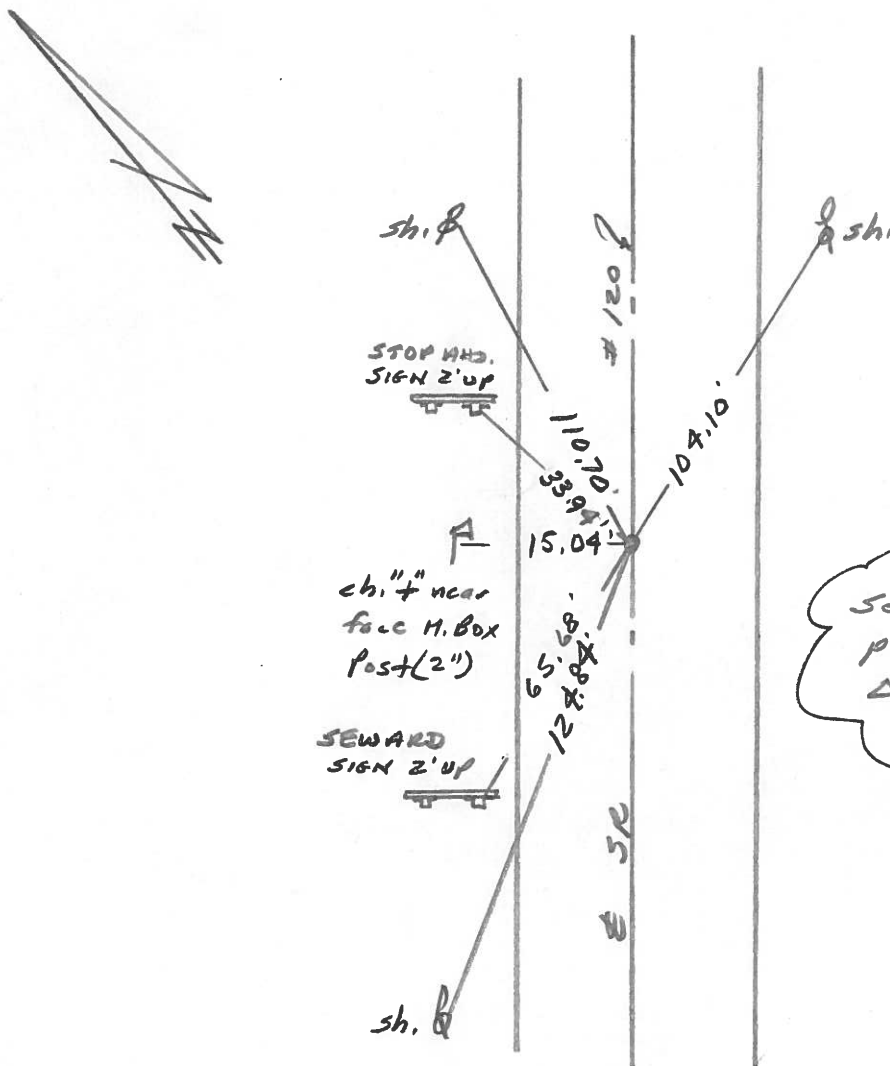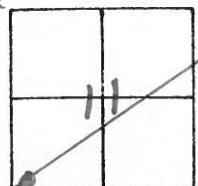

PAHL'S  
CONCRETE

Set PK Nail 45  
per 1928 plan.  
 $\Delta = 0^{\circ}13'20''$  (Meas.)