

O.D.O.T. DISTRICT 2 SURVEY OFFICE (USE ONLY)

PERSONNEL _____ REFERENCE NO. 13 SHEET 34 OF 50

NOTES HOMAN DATE 5/11/12 ROUTE SR 120
 H.C. ROUSOS WEATHER SUNNY COUNTY FULTON
 R.C. HOMAN TEMP. 60° TOWNSHIP ROYALTON
 SECTION 11

DWG BY RHOADES PID PAVETRAIN

T 9 N R 3 E


TYPE MONUMENT P.K.NAIL

ON SURFACE - ~~BELOW~~ ON

OFFSET ☉ PAVEMENT ON LT : RT

- TO - EDGE PAVEMENT


STATION: 448+98.32

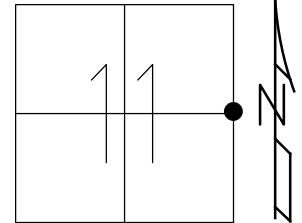

HORIZ. DATUM: NAD83 2011 GEOID: NAVD88 2018

GRID: NORTHING: 747481.874 EASTING: 1554108.960


RECORD:
 FD P.K.NAIL
 4/17/91, IRS
 SET P.K./WASHER
 3/18/92
 FD P.K. NAIL
 REF30
 6/8/10, DCH
 SET MAG/WASHER
 NEWREF30
 DCH
 FD P.K./WASHER
 REF13
 3-5-8,
 4-29-19, JFO
 7/1/22, DSA
 4/12/23, JMR

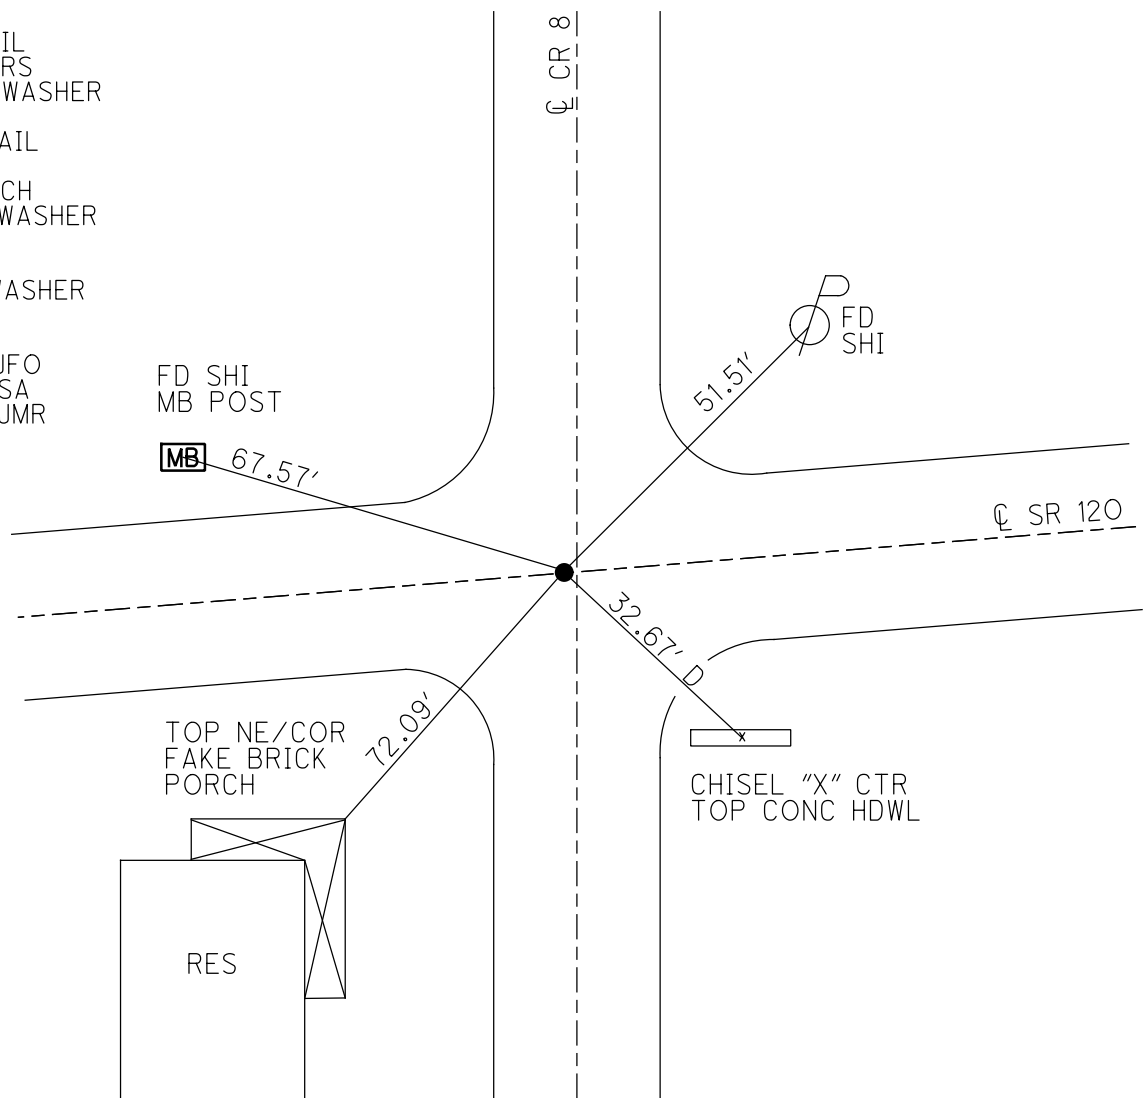

O.D.O.T. DISTRICT 2 SURVEY OFFICE (USE ONLY)


PERSONNEL _____ REFERENCE NO. 13 SHEET 31 OF 47
 NOTES HOMAN DATE 5/11/12 ROUTE SR 120
 H.C. ROUSOS WEATHER SUNNY COUNTY FULTON
 R.C. HOMAN TEMP. 65° TOWNSHIP ROYALTON
 DWG BY NASON PID 101243 SECTION 11
 T 9 N R 3 E

TYPE MONUMENT P.K. NAIL
 ON SURFACE - ~~BELOW~~ ON
 OFFSET Q PAVEMENT ON LT : RT
- TO - EDGE PAVEMENT
 STATION: 448+98.32

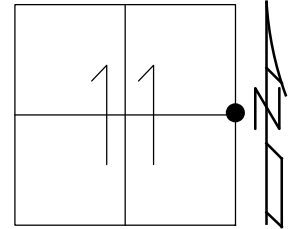

HORZ. DATUM: NAD83 (2011) GEOID: 2012A
 GRID: NORTHING: 747481.918 EASTING: 1554108.937


RECORD:
 FD P.K. NAIL
 4/17/91, IRS
 SET P.K./WASHER
 3/18/92
 FD P.K. NAIL
 REF30
 6/8/10, DCH
 SET MAG/WASHER
 NEWREF30
 DCH
 FD P.K./WASHER
 REF13
 3-5-8,
 4-29-19, JFO

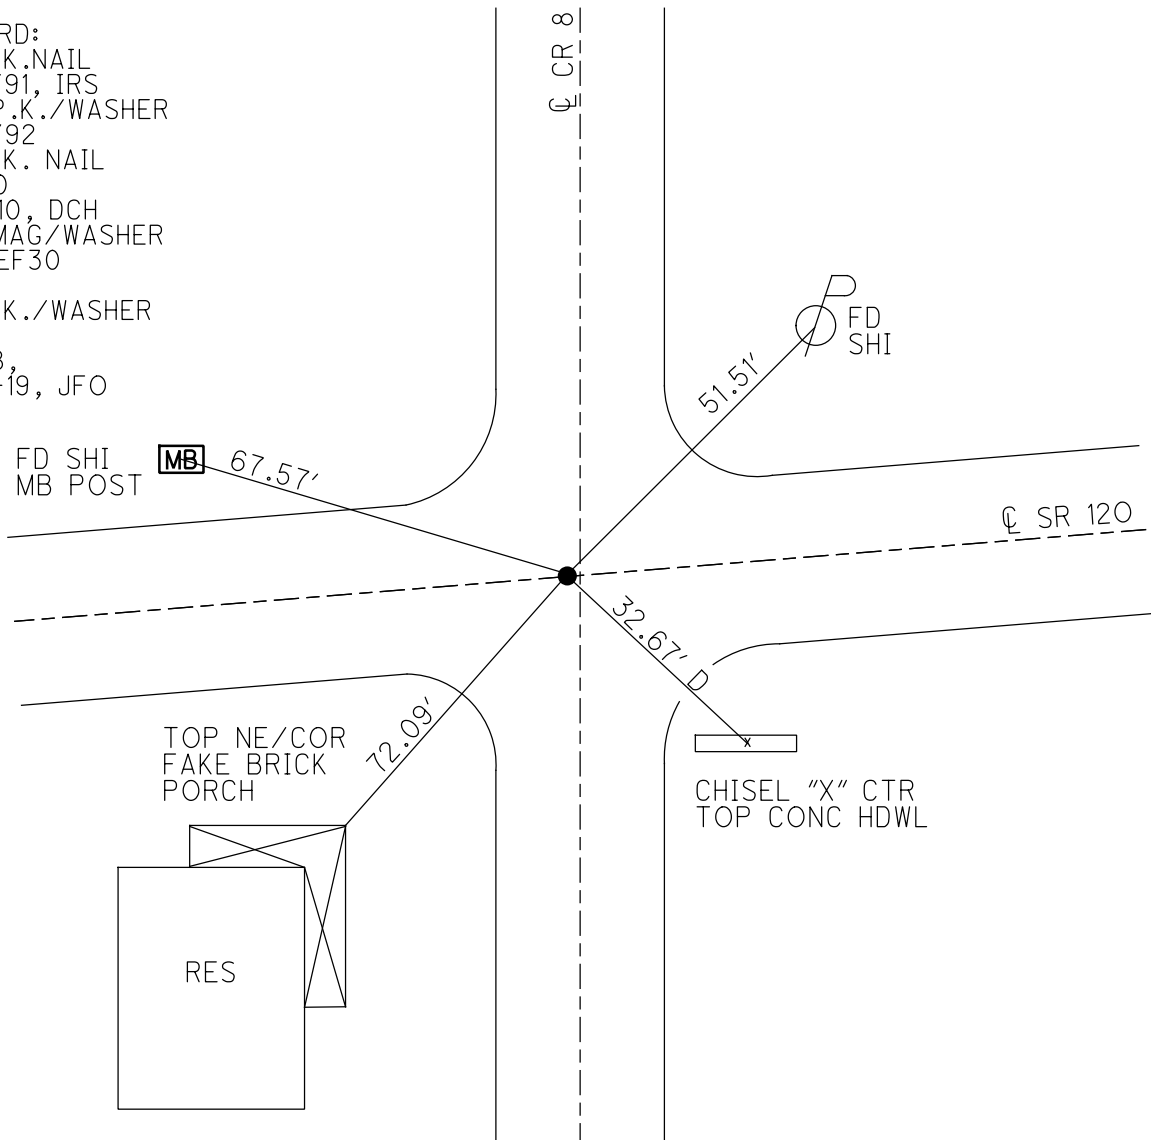

O.D.O.T. DISTRICT 2 SURVEY OFFICE (USE ONLY)


PERSONNEL _____ REFERENCE NO. 13 SHEET 31 OF 45
 NOTES HOMAN _____ DATE 5/11/12 ROUTE SR 120
 H.C. ROUSOS _____ WEATHER SUNNY COUNTY FULTON
 R.C. HOMAN _____ TEMP. 65° TOWNSHIP ROYALTON
 _____ SECTION 11
 _____ T 9 N R 3 E

TYPE MONUMENT P.K.NAIL
 ON SURFACE - ~~BELOW~~ ON
 LEFT - CL PAV'T - RIGHT ON
TO EDGE PAVEMENT
 S.L.M. 448+57.82

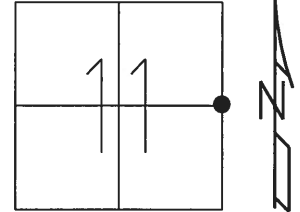

GRID: NORTHING: 747481.763 EASTING: 1554108.942

RECORD:
 FD P.K.NAIL
 4/17/91, IRS
 SET P.K./WASHER
 3/18/92
 FD P.K. NAIL
 REF30
 6/8/10, DCH
 SET MAG/WASHER
 NEWREF30, DCH

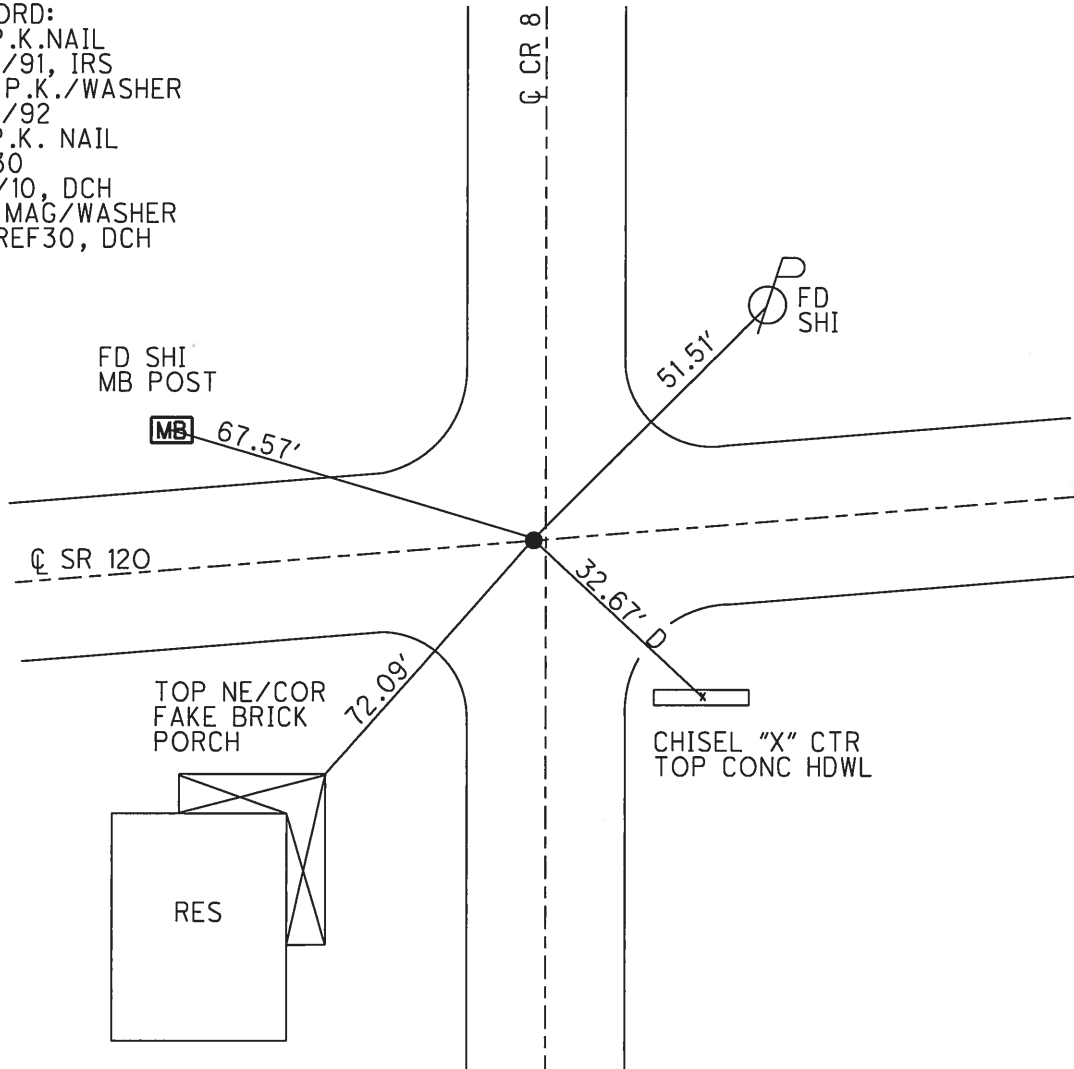

O.D.O.T. DISTRICT 2 SURVEY OFFICE

PERSONNEL _____

REFERENCE NO. 13

SHEET 31 OF 45

NOTES STONE

DATE 4/17/91

ROUTE SR 120

H.C. CURTIS

WEATHER COOL

COUNTY FULTON

R.C. HOUSEHOLDE

TEMP. 55°

TOWNSHIP ROYALTON

SECTION 11

T 9 N R 3 E

TYPE MONUMENT P.K.NAIL


ON SURFACE - ~~BELOW~~ ON _____

LEFT - Q PAV'T - RIGHT ON _____


_____ TO _____ EDGE PAVEMENT

S.L.M. 448+66 1.4' W.of
Q CR 8 S.

Grid: Northing: _____ Easting: _____

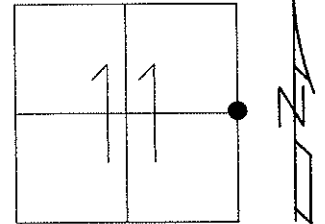

SET P.K./WASHER
3/18/92

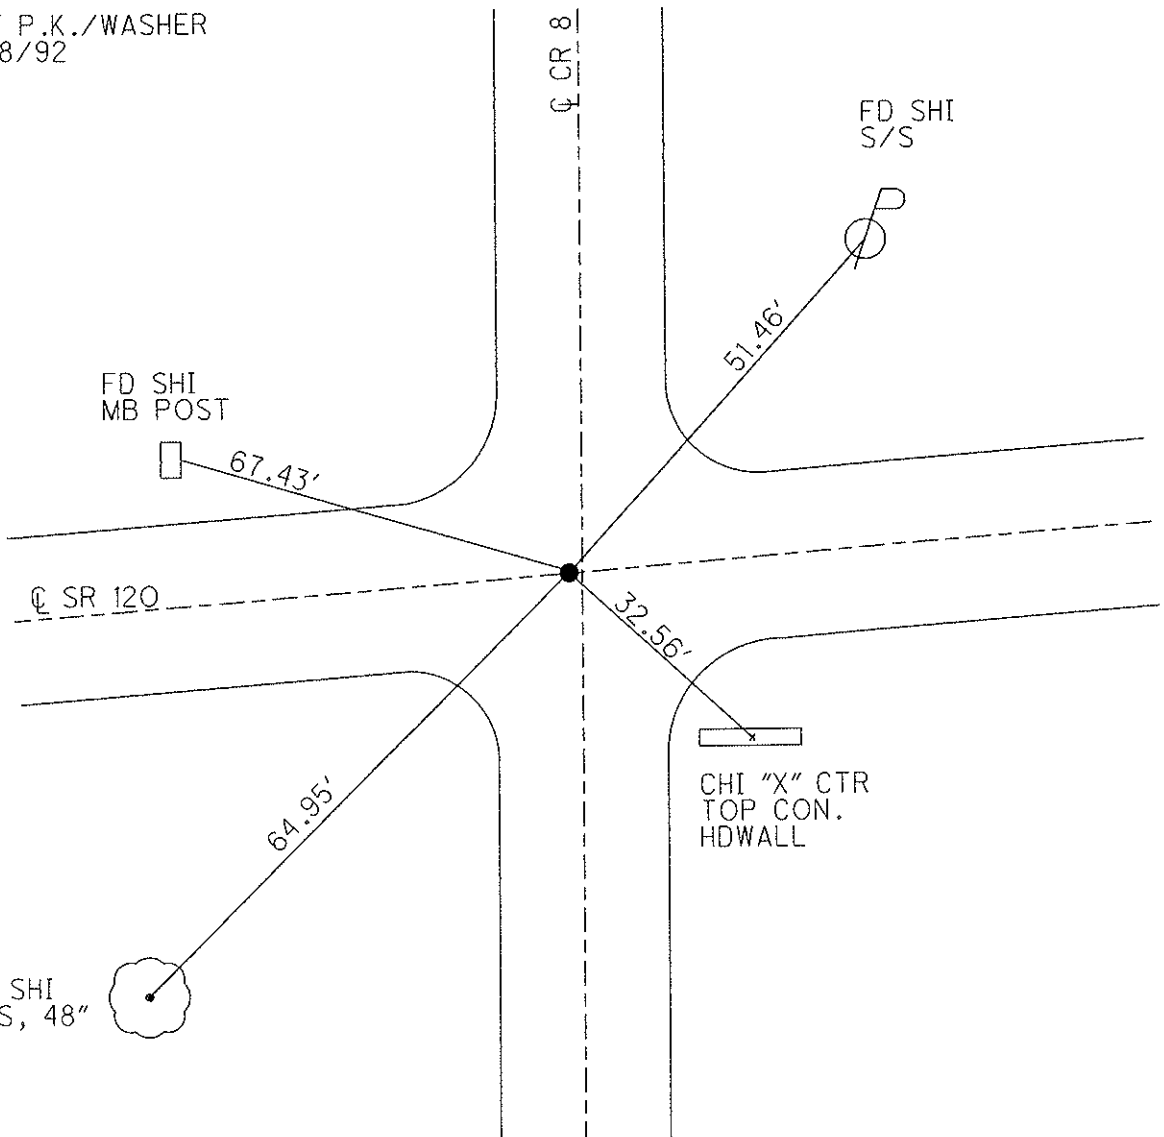

O.D.O.T. DISTRICT 2 SURVEY OFFICE

PERSONNEL

REFERENCE NO. 13

SHEET 7 OF 18

NOTES I. STONE

DATE 4-17-91

ROUTE S.R. 120

H.C. D. CURTIS

WEATHER COOL

COUNTY FULTON

R.C. J. HOUSEHOLDE

TEMP. 55°

TOWNSHIP ROYALTON

SECTION 11

T 9 S R 3 E


TYPE MONUMENT PK NAIL

ON SURFACE - ~~BELOW~~ ON

LEFT - Q PAV'T - RIGHT ON


TO EDGE PAVEMENT

S.L.M. 448+66

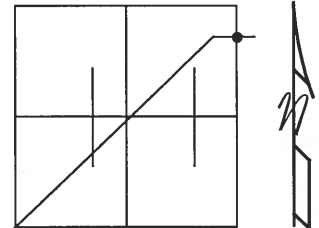

1.4' W OF Q PAV'T
CO.RD. 8 S

3-18-1992
Set P.K. / WASSNER

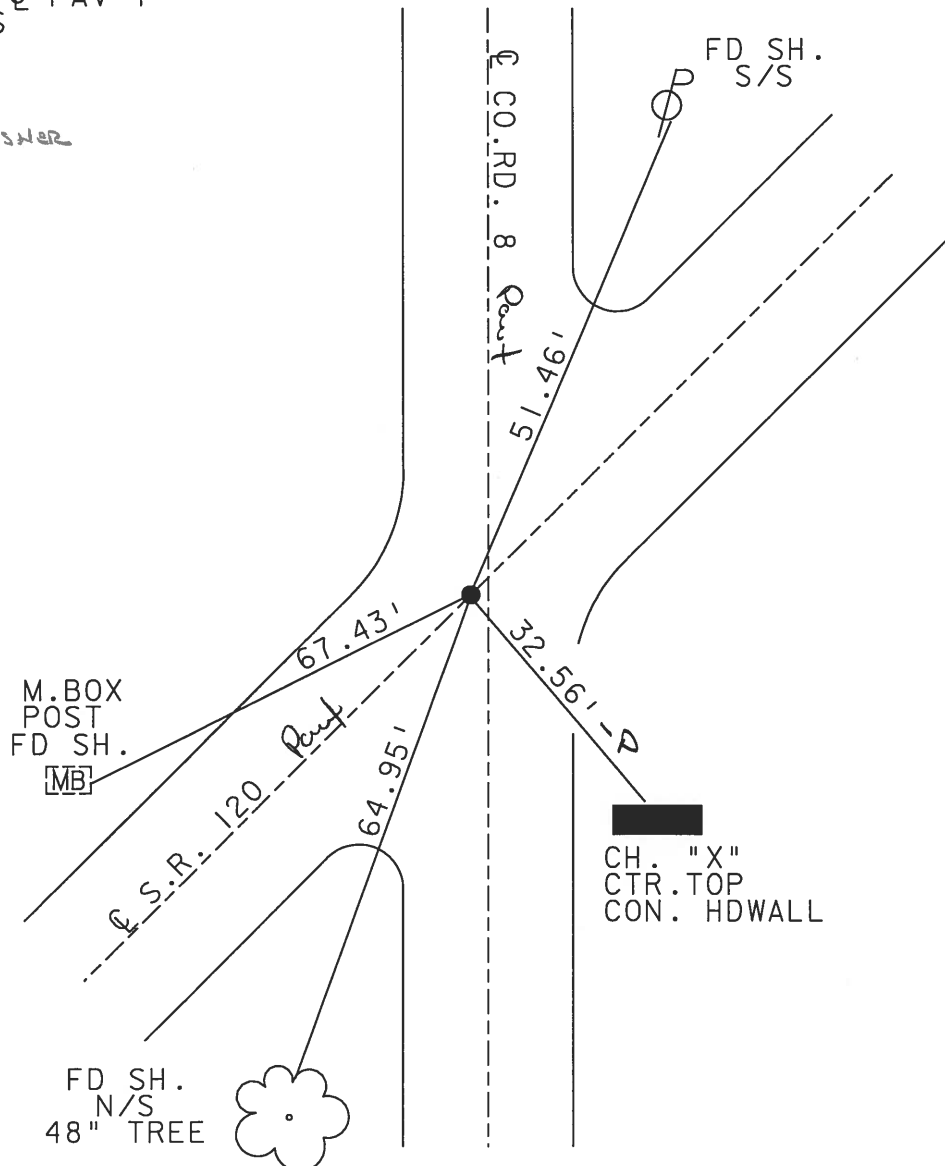

CH. "X"
CTR. TOP
CON. HDWALL

O.D.O.T. DISTRICT 2 SURVEY OFFICE

PERSONNEL

REFERENCE NO. 13

SHEET 2 OF

NOTES 1. Stone

H.C. D. Curtis

R.C. J. Hauscholder

DATE 17 April 91

WEATHER Cool

TEMP. 55°

ROUTE SR#120

COUNTY Fulton

TOWNSHIP Royalton

SECTION 11

T R

TYPE MONUMENT PK Nail



ON SURFACE - BELOW Surface

LEFT - ☉ PAV'T. - RIGHT ☉ S.R. 120

TO EDGE PAVEMENT

S.L.M. 448+66

Set P.K./WASHER
3-18-92

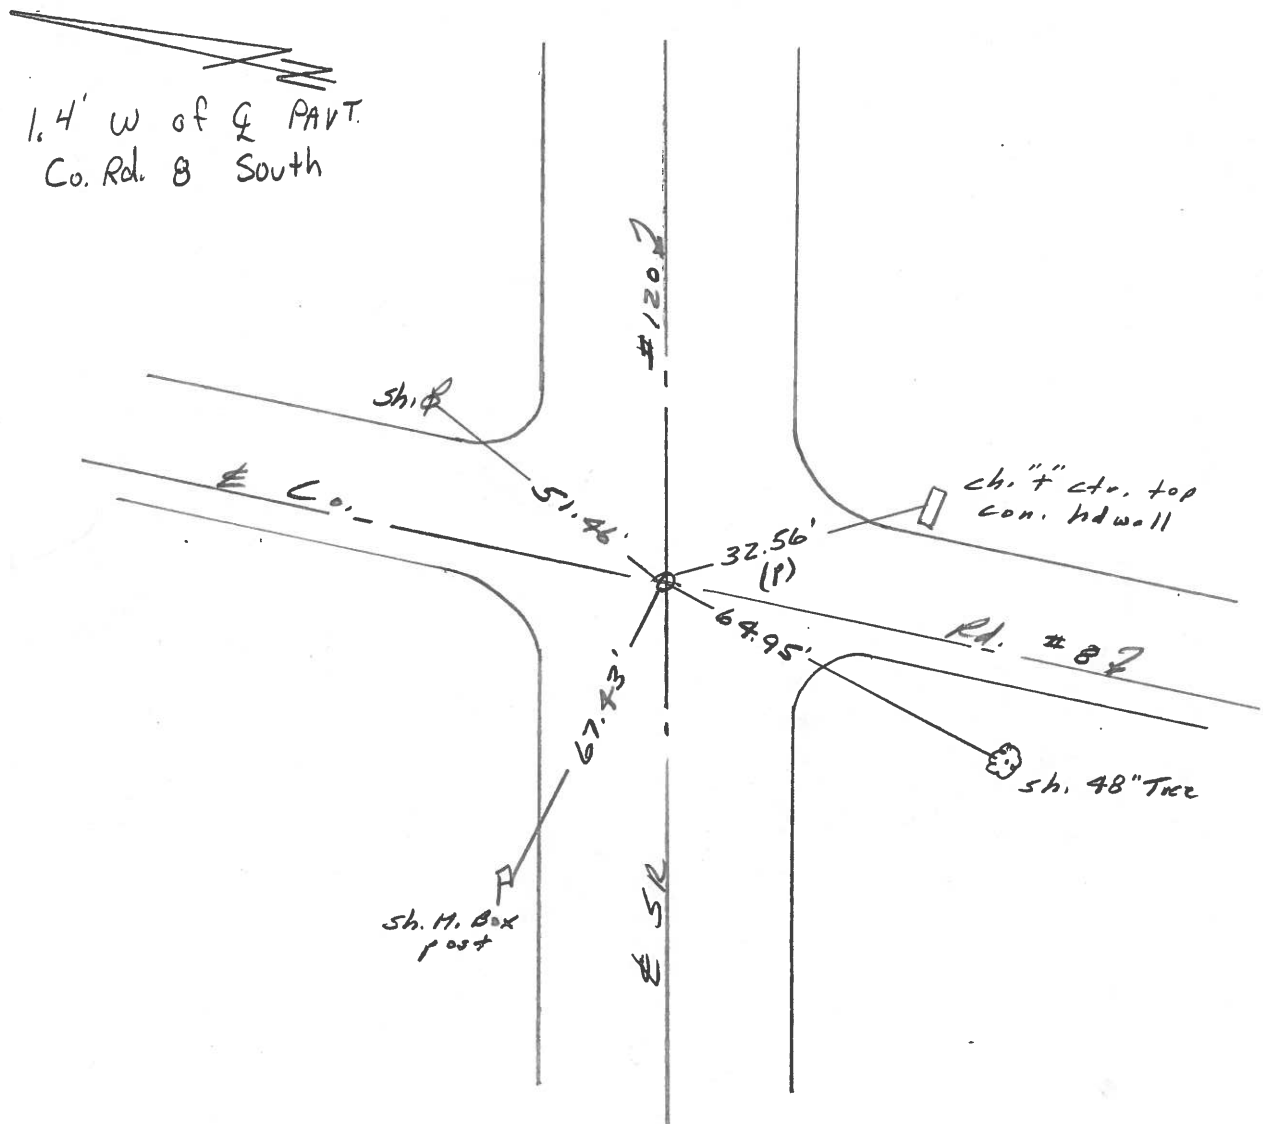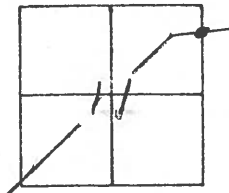

ODOT. DISTRICT 2 SURVEY OFFICE

SHEET 3 OF

County Fulton S.R. 120

Date 12 May 81

Township Royalton


Weather Clear

Section 11

Temp. 55°


T N, R E

Personnel L. S. Lane

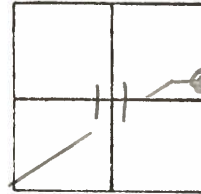

- P. Newson
- R. Michalak
- D. Curtis

Ref No. 13

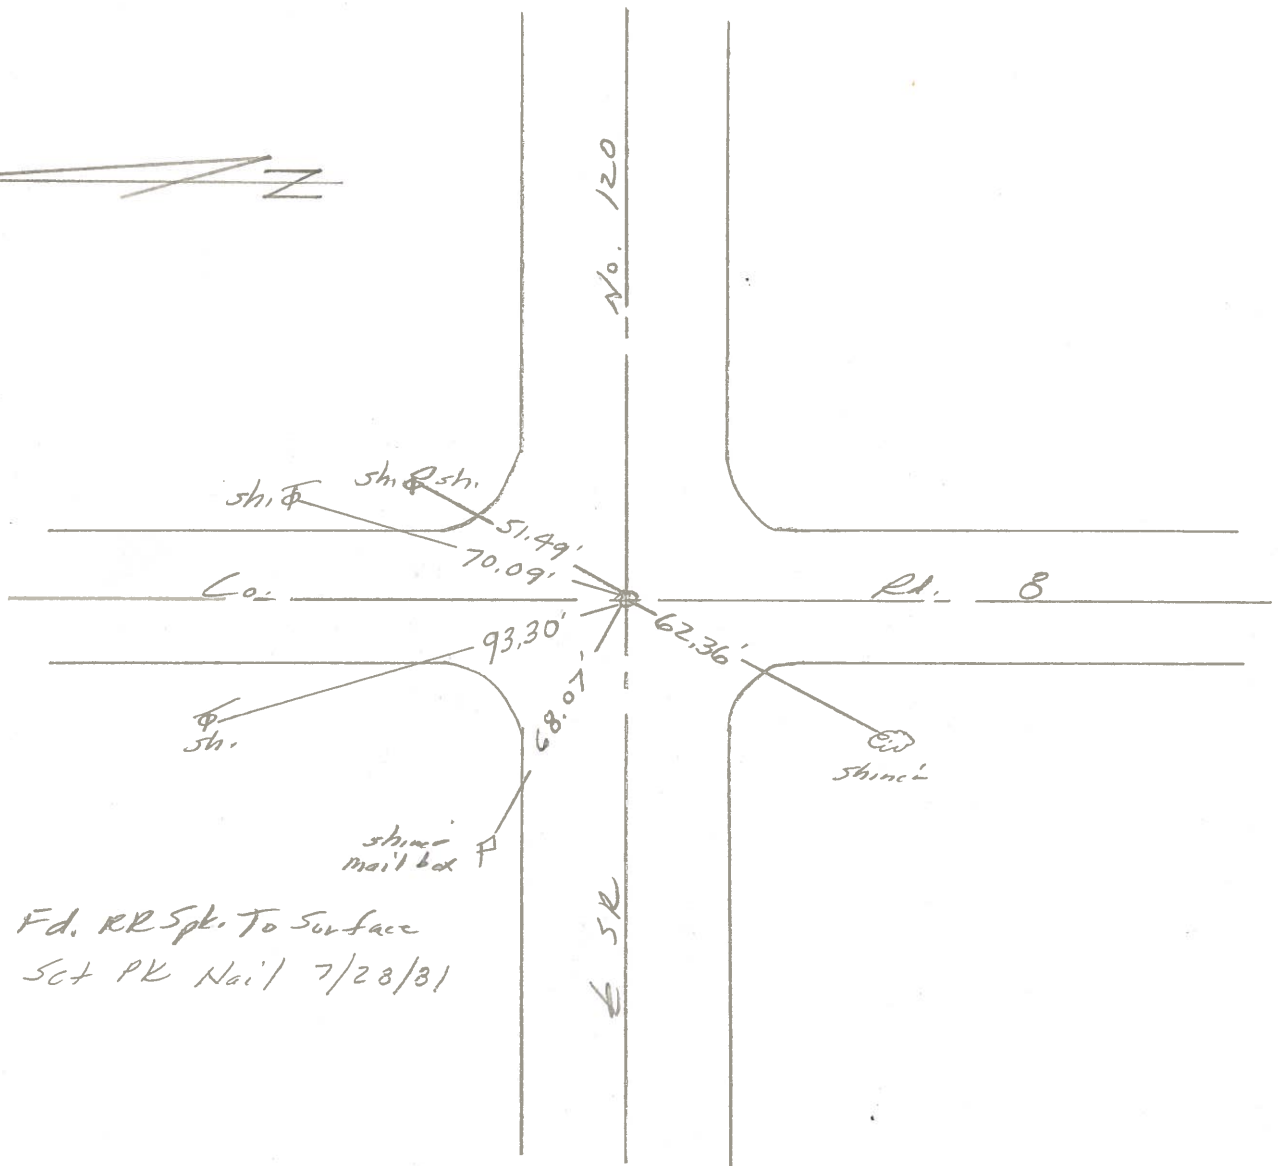

PERSONNEL	TITLE	PERSONNEL	TITLE
Tomsic			
Granata			
Vanyo			
Boyle			

COUNTY Fulton DATE July 11, 1973

S. R. 120 WEATHER _____

SEC. Rayton - Amboy Twp TEMP. _____

DESCRIPTION _____ LEFT _____ CENTER LINE _____ RIGHT _____ JOB NO. _____

