


O.D.O.T. DISTRICT 2 SURVEY OFFICE (USE ONLY)


PERSONNEL _____ REFERENCE NO. 14 A SHEET 33 OF 47
 NOTES RHOADES DATE 4/29/2019 ROUTE SR 120
 H.C. O'DONNELL WEATHER RAIN COUNTY FULTON
 R.C. RHOADES TEMP. 46° TOWNSHIP AMBOY
 DWG BY NASON PID 101243 SECTION 7
 T 9 N R 4 E

TYPE MONUMENT MAG/WASHER
 ON SURFACE - ~~BELOW~~ ON
 OFFSET \odot PAVEMENT 1.6' LT : RT
8.9' TO RT EDGE PAVEMENT
 STATION: 525+96.70

HORIZ.DATUM: NAD83 (2011) GEOID: 2012A
 GRID: NORTHING: 748156.407 EASTING: 1561777.717

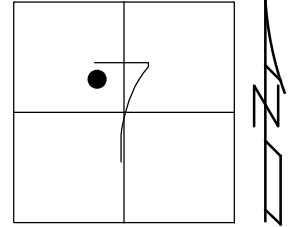

SET MAG/WASHER
 8/18/03, DCH
 FD MAG/WASHER
 5/20/11, RJL
 REF A14
 5/23/11, RJL
 FD MAG/WASHER
 REFA14
 3/5/18, JFO
 SET MAG/WASHER
 7/26/19, JFO

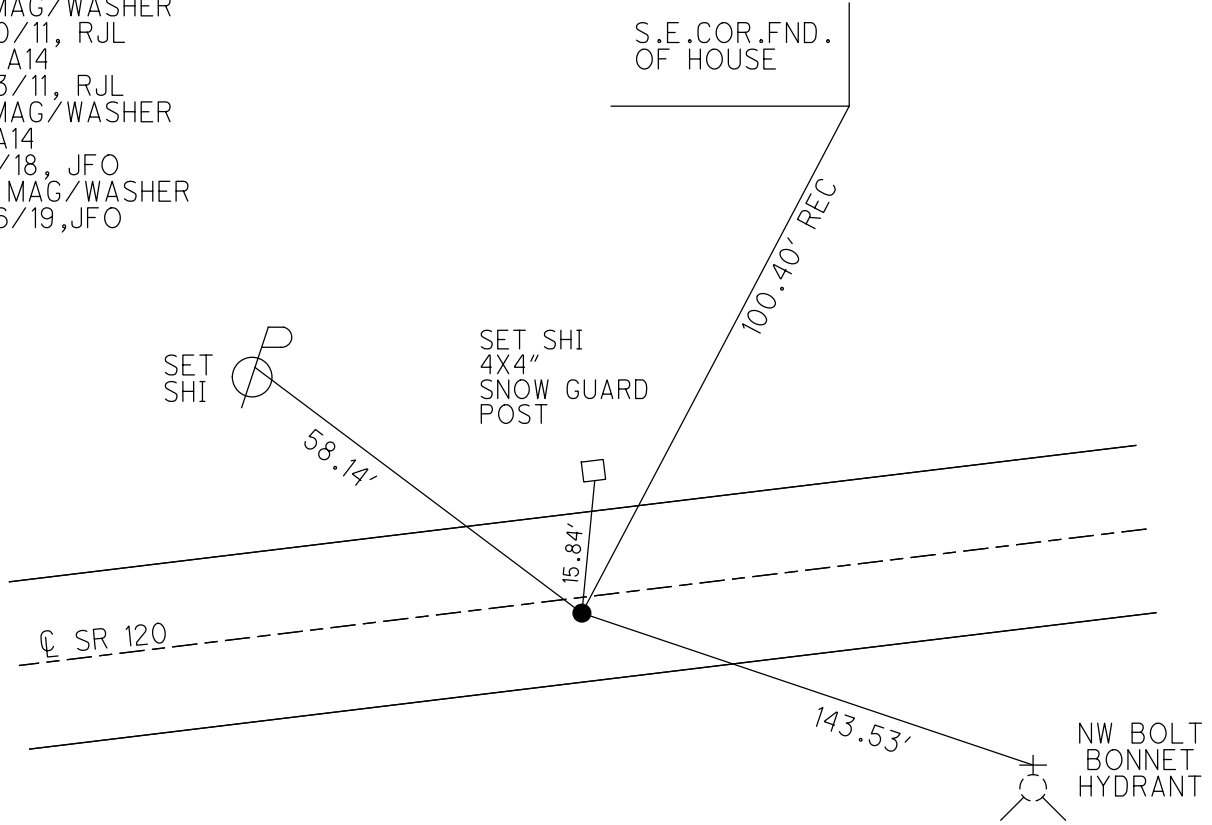

O.D.O.T. DISTRICT 2 SURVEY OFFICE

PERSONNEL

REFERENCE NO. 14 A

SHEET 33 OF 45

NOTES FINGER

DATE 5/20/11

ROUTE SR 120

H.C. LUMBREZER

WEATHER CLOUDY

COUNTY FULTON

R.C. MOSE

TEMP. 65°

TOWNSHIP AMBOY

SECTION 7

T 9 N R 4 E

TYPE MONUMENT MAG/WASHER


ON SURFACE - ~~BELOW~~ ON

~~LEFT~~ - Q PAV'T - RIGHT 1.6'

8.9' TO RT EDGE PAVEMENT

S.L.M. 525+66

Grid: Northing: 748156.390 Easting: 1561777.677

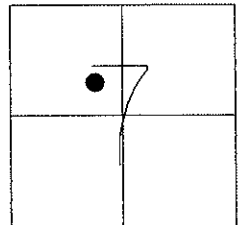


SET MAG/WASHER
8/18/03, DCH

FD MAG/WASHER
5/20/11, RJL

GPS, REF A14
5/23/11, RJL

S.E. COR. FND.
OF HOUSE

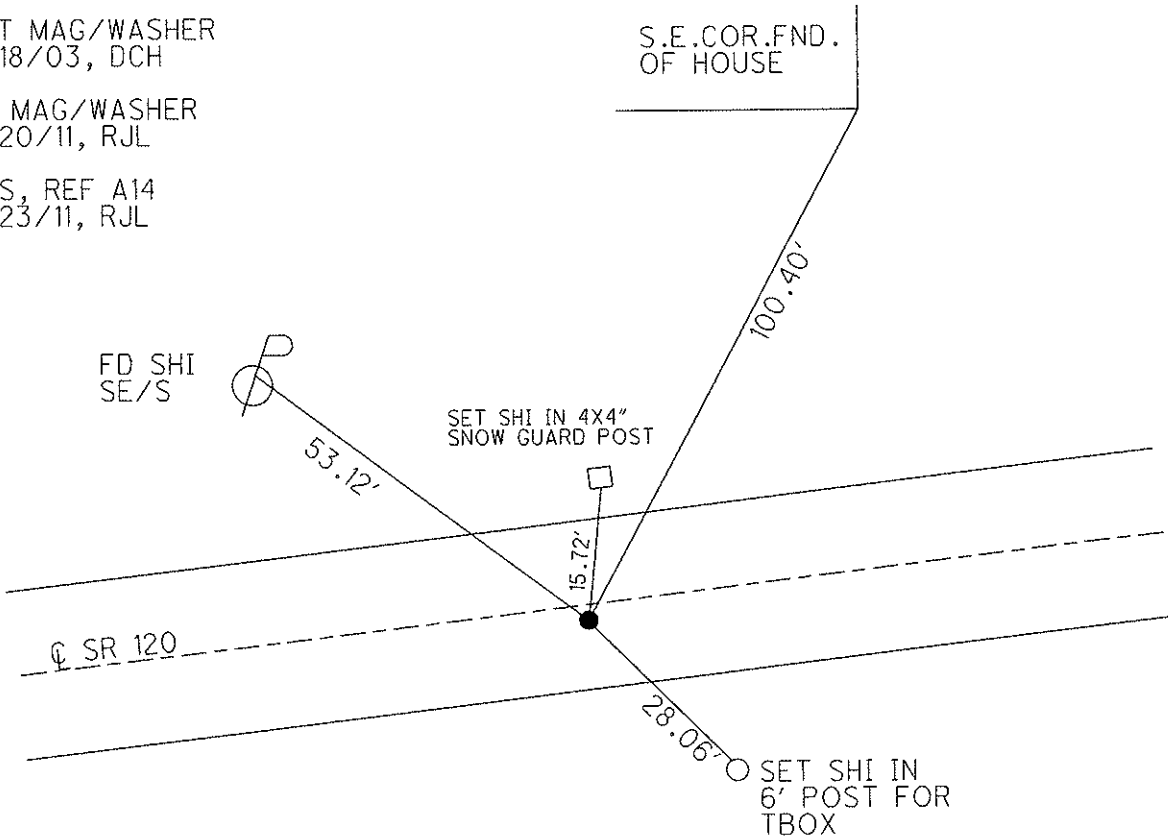

FD SHI
SE/S

SET SHI IN 4X4"
SNOW GUARD POST

SET SHI IN
6" POST FOR
TBOX

Q SR 120

O.D.O.T. DISTRICT 2 SURVEY OFFICE

PERSONNEL

REFERENCE NO. 14A

SHEET 9 OF 18

NOTES HOMAN

DATE 8-18-03

ROUTE SR 120

H.C. HOMAN

WEATHER SUNNY

COUNTY FULTON

R.C. MEYERS

TEMP. 85°

TOWNSHIP AMBOY

SECTION 7

T 9 S R 4 E


TYPE MONUMENT PK NAIL & WASHER

ON SURFACE - ~~BELOW~~ ON

~~LEFT - C~~ PAV'T - RIGHT 1.9'

8.6 TO RT EDGE PAVEMENT

S.L.M. 525+66

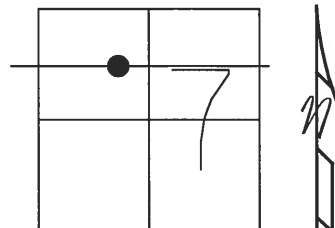

SET MAG NAIL
& WASHER
8-18-03
DCH

FD SHI
SE/S



53.10'

SE COR
FOUNDATION
OF HOUSE

SET SHI
IN MAIL BOX
POST



100.34'


16.92'

C SR 120 Pavt

28.01'



FD SHI
NW/S

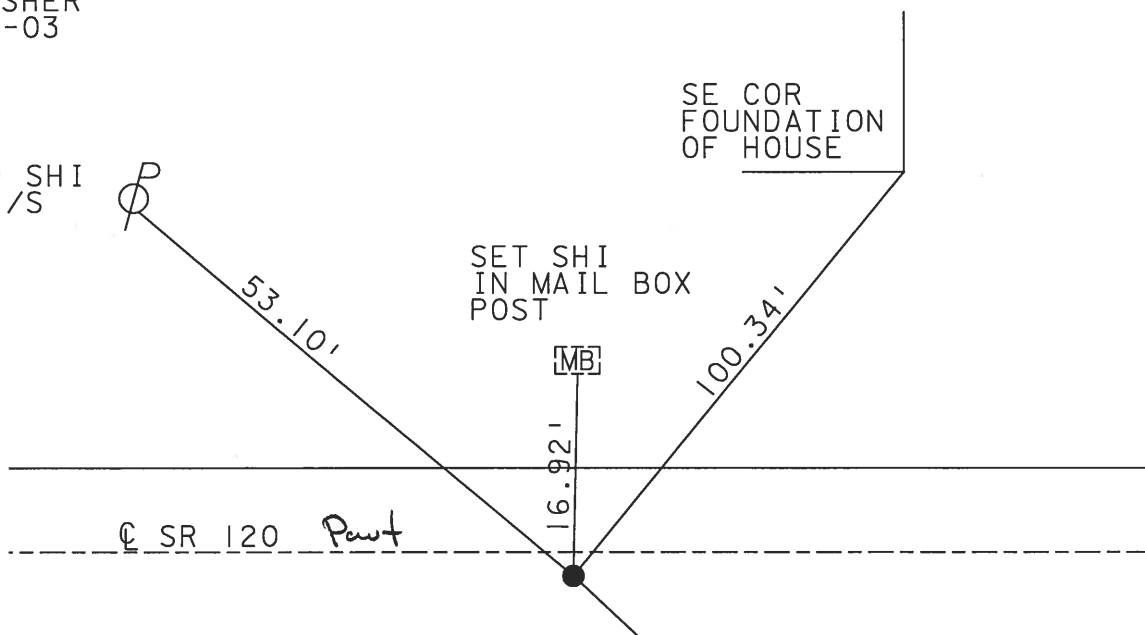

O.D.O.T. DISTRICT 2 SURVEY OFFICE

PERSONNEL _____

REFERENCE NO. 14-A

SHEET 4 OF _____

NOTES 1. Stone

H.C. D. Curtis

R.C. J. Householder

DATE 17 April 91

WEATHER Cool

TEMP. 560

ROUTE SR# 120

COUNTY Fulton

TOWNSHIP Amb 19

SECTION 7

T. _____ R. _____

TYPE MONUMENT PK Nail SET. PK_n/WASHER

ON SURFACE - BELOW Surface

~~LEFT~~ - & PAV'T. - RIGHT 1.9

0.6 TO RT EDGE PAVEMENT

S.L.M. 525+66

