

O.D.O.T. DISTRICT 2 SURVEY OFFICE (USE ONLY)

PERSONNEL

REFERENCE NO. 14 B

SHEET 34 OF 47

NOTES RHOADES DATE 4/29/19

H.C. O'DONNELL WEATHER RAIN

R.C. RHOADES TEMP. 46°

ROUTE SR 120

COUNTY FULTON

TOWNSHIP AMBOY

SECTION 7

DWG BY NASON PID 101243

T 9 N R 4 E

TYPE MONUMENT MAG/WASHER

ON SURFACE - ~~BELOW~~ ON

OFFSET \odot PAVEMENT ON LT : RT

10' TO LT EDGE PAVEMENT


STATION: 535+66.79

HORZ. DATUM: NAD83 (2011)


GEOID: 2012A

GRID: NORTHING: 748241.762

EASTING: 1562744.041

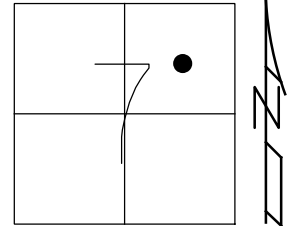


SET MAG/WASHER
8/18/03, DCH
FD MAG/WASHER
5/20/11, RJL
REF B14
5/23/11, RJL
FD MAG/WASHER
REFB14
3/5/18, JFO
SET MAG/WASHER
7/26/19, JFO

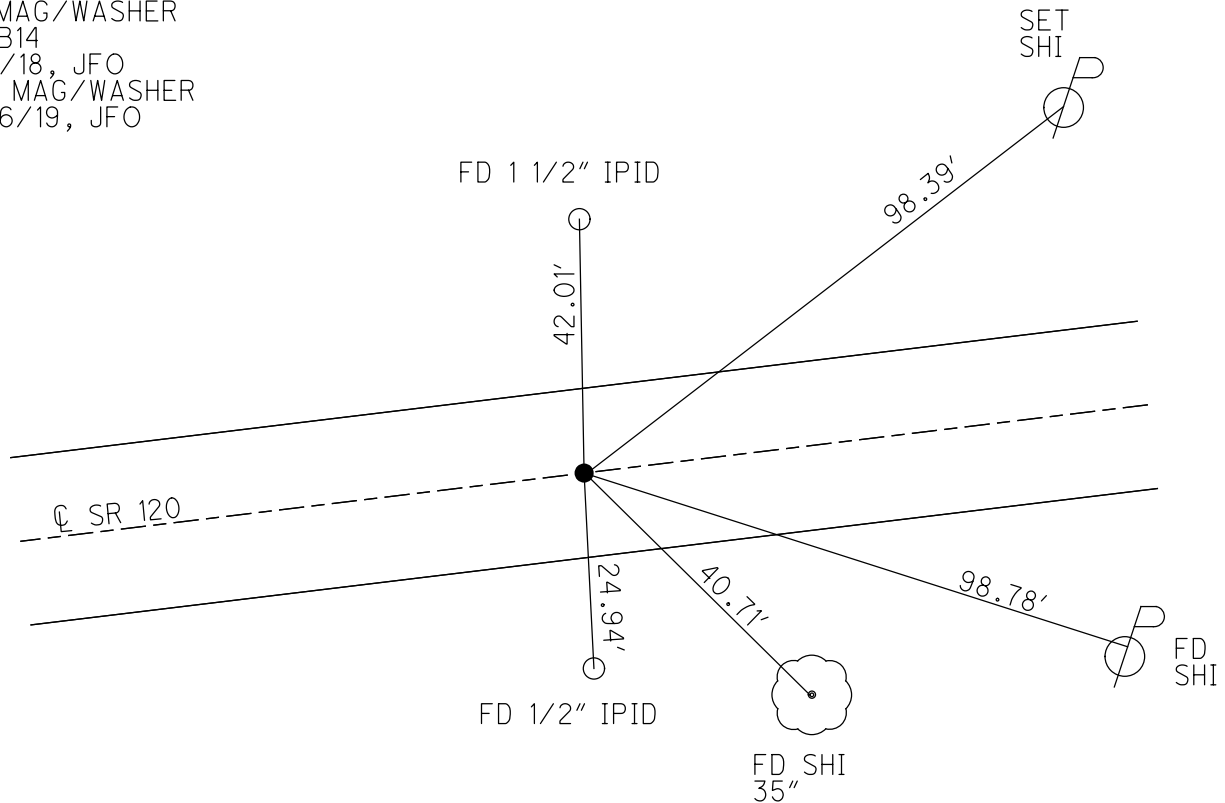

O.D.O.T. DISTRICT 2 SURVEY OFFICE

PERSONNEL	REFERENCE NO. <u>14 B</u>	SHEET <u>34</u> OF <u>45</u>
NOTES <u>FINGER</u>	DATE <u>5/20/11</u>	ROUTE <u>SR 120</u>
H.C. <u>LUMBREZER</u>	WEATHER <u>CLOUDY</u>	COUNTY <u>FULTON</u>
R.C. <u>MOSER</u>	TEMP. <u>65°</u>	TOWNSHIP <u>AMBOY</u>
		SECTION <u>7</u>
		T <u>9</u> N R <u>4</u> E


TYPE MONUMENT MAG/WASHER
 ON SURFACE - ~~BELOW~~ ON
 LEFT - CL PAV'T - RIGHT ON
10' TO LT EDGE PAVEMENT
 S.L.M. 535+34
 Grid: Northing: 748241.778 Easting: 1562743.973

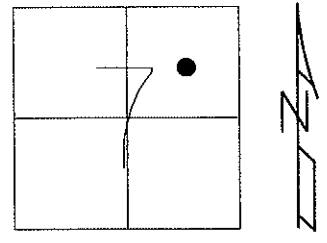

SET MAG/WASHER
8/18/03, DCH

 FD MAG/WASHER
5/20/11, RJL

 GPS, REF B14
5/23/11, RJL

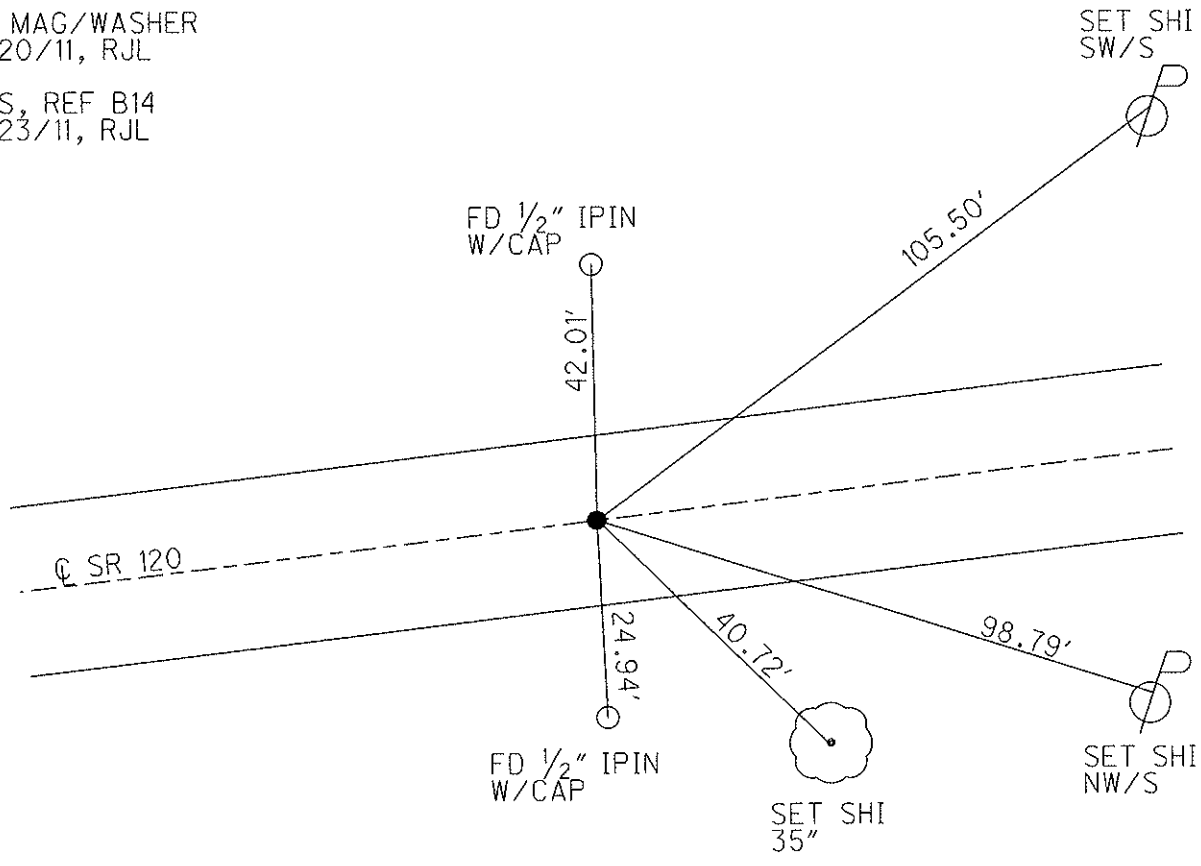

O.D.O.T. DISTRICT 2 SURVEY OFFICE

PERSONNEL _____

REFERENCE NO. 148

SHEET 10 OF 18

NOTES _____

DATE 8-18-03

ROUTE SR 120

H.C. HOMAN

WEATHER SUNNY

COUNTY FULTON

R.C. MEYERS

TEMP. 85°

TOWNSHIP AMBOY

SECTION 7

T 9 S R 4 E


TYPE MONUMENT PK NAIL & WASHER

ON SURFACE - ~~BELOW~~ _____ ON _____


~~LEFT - C~~ PAV'T - ~~RIGHT~~ _____ ON _____

10' TO LT EDGE PAVEMENT

S.L.M. 535+34

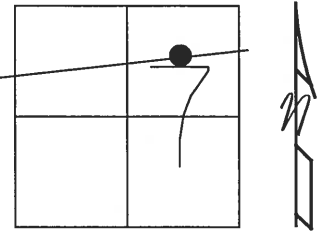

SET MAG NAIL & WASHER
8-18-03
DCH

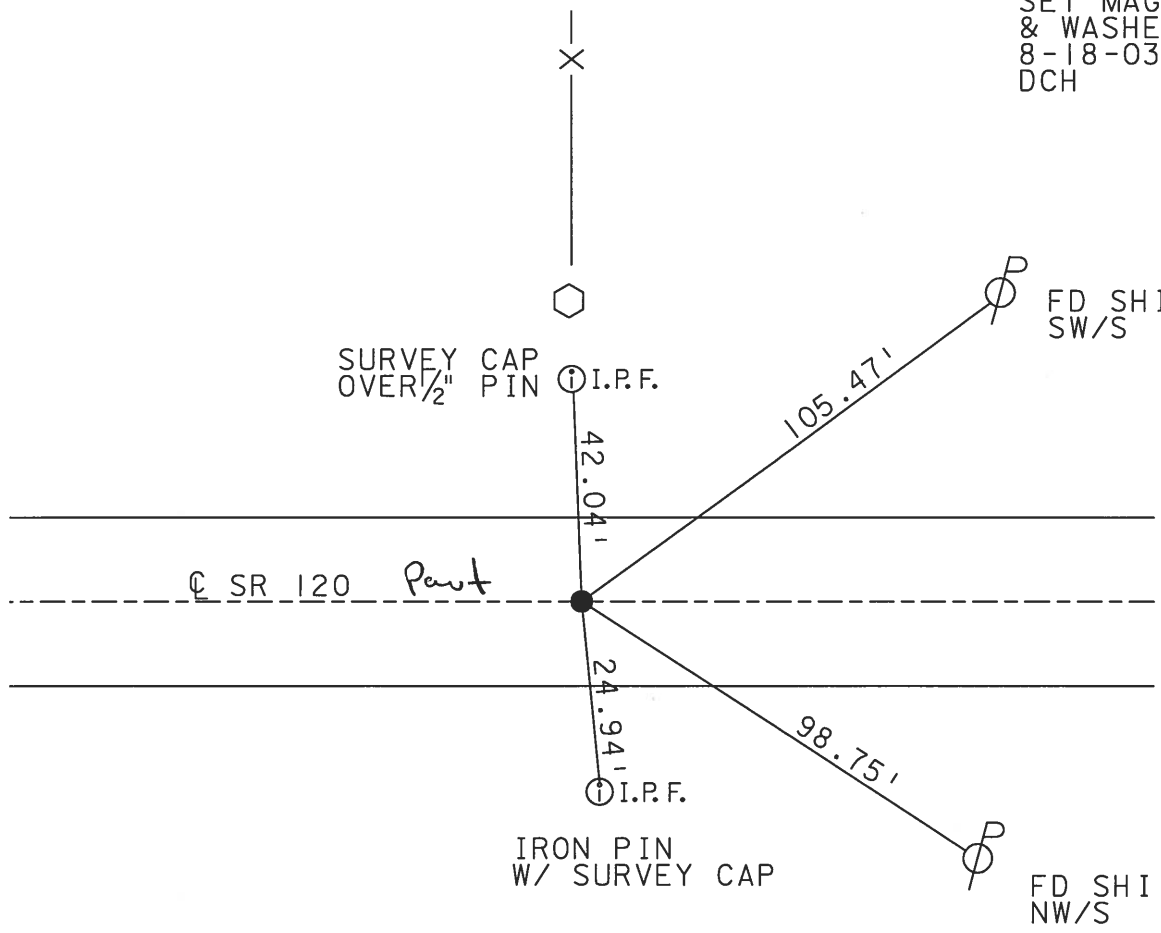

IRON PIN W/ SURVEY CAP

FD SHI NW/S

O.D.O.T. DISTRICT 2 SURVEY OFFICE

PERSONNEL _____

REFERENCE NO. 14-8

SHEET 5 OF _____

NOTES 1. Stone

H.C. D. Curtis

R.C. J. Houschilder

DATE 18 April 91

WEATHER Cool

TEMP. 48°

ROUTE SR #120

COUNTY Fulton

TOWNSHIP Ambog

SECTION 7

T. _____ R. _____

TYPE MONUMENT PK Nail Set P.K. /w ASHLER

ON SURFACE - BELOW Surface 3-18-92

LEFT - & PAV'T. - RIGHT Yes

10' TO Lt EDGE PAVEMENT

S.L.M. 535+39

