

O.D.O.T. DISTRICT 2 SURVEY OFFICE (USE ONLY)

PERSONNEL

REFERENCE NO. 15 A

SHEET 36 OF 47

NOTES RHOADES

DATE 4/29/19

ROUTE SR 120

H.C. O'DONNELL

WEATHER CLOUDY

COUNTY FULTON

R.C. RHOADES

TEMP. 42°

TOWNSHIP AMBOY

DWG BY NASON

PID 101243

SECTION 8

T 9 N R 4 E

TYPE MONUMENT MAG/WASHER

ON SURFACE - ~~BELOW~~ ON

OFFSET 0.4' LT : RT
10' TO LT EDGE PAVEMENT



STATION: 574+83.2

HORZ. DATUM: NAD83 (2011)

GEOID: 2012A

GRID: NORTHING: 74859.333

EASTING: 1566644.668

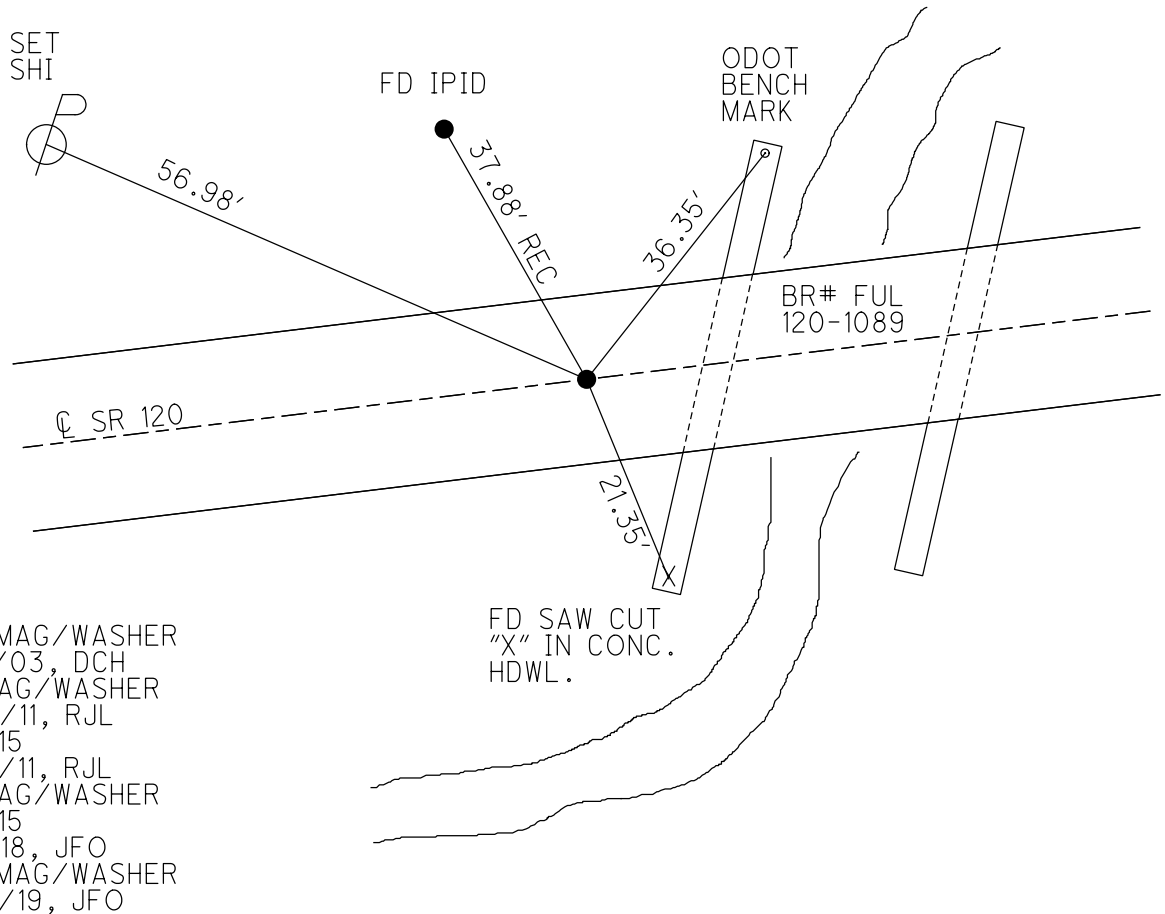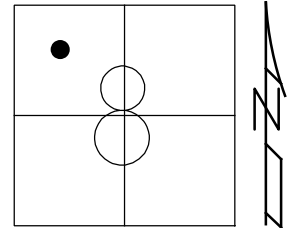

SET MAG/WASHER
 8/18/03, DCH
 FD MAG/WASHER
 5/20/11, RJL
 REFA15
 5/23/11, RJL
 FD MAG/WASHER
 REFA15
 3/5/18, JFO
 SET MAG/WASHER
 7/26/19, JFO

O.D.O.T. DISTRICT 2 SURVEY OFFICE

PERSONNEL

REFERENCE NO. 15 A

SHEET 36 OF 45

NOTES FINGER

DATE 5/20/11

ROUTE SR 120

H.C. LUMBREZER

WEATHER CLOUDY

COUNTY FULTON

R.C. MOSER

TEMP. 65°

TOWNSHIP AMBOY

SECTION 8

T 9 N R 4 E

TYPE MONUMENT MAG/WASHER



ON SURFACE - ~~BELOW~~ ON

LEFT - C PAV'T - ~~RIGHT~~ 0.4'

10' TO LT EDGE PAVEMENT

S.L.M. 574+50

Grid: Northing: 748593.293 Easting: 1566644.570

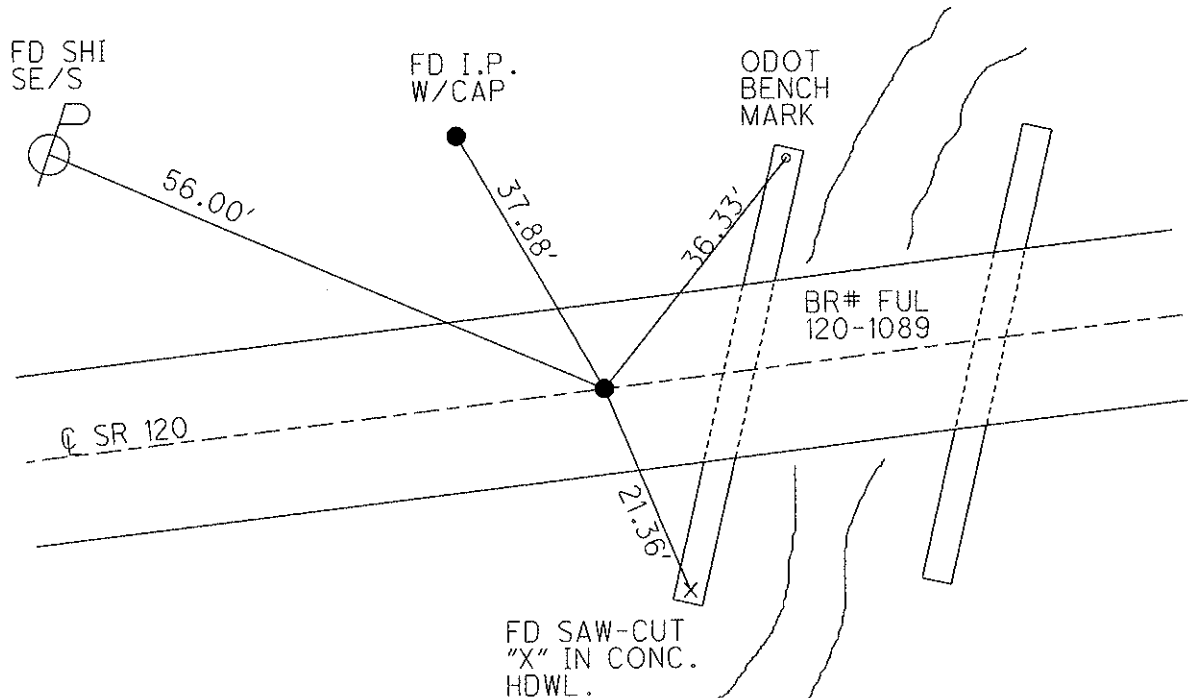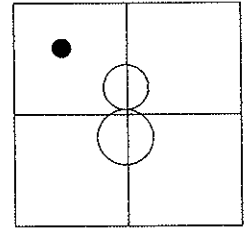

SET MAG/WASHER
8/18/03, DCH

FD MAG/WASHER
5/20/11, RJL

GPS, REFA15
5/23/11, RJL

O.D.O.T. DISTRICT 2 SURVEY OFFICE

PERSONNEL

REFERENCE NO. 15-A

SHEET 12 OF 18

NOTES HOMAN

DATE 8-18-03

ROUTE SR 120

H.C. NUHFER

WEATHER SUNNY

COUNTY FULTON

R.C. MEYERS

TEMP. 75°

TOWNSHIP AMBOY

SECTION 8

T 9 S R 4 E


TYPE MONUMENT IRON ROD

~~ON SURFACE~~ - BELOW 5"


~~LEFT - Q PAVT - RIGHT~~ ON

10.4 TO LT EDGE PAVEMENT

S.L.M. 574+50

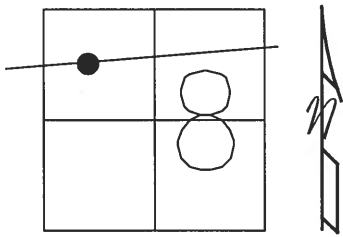

SET MAG NAIL
& WASHER
8-18-03
DCH

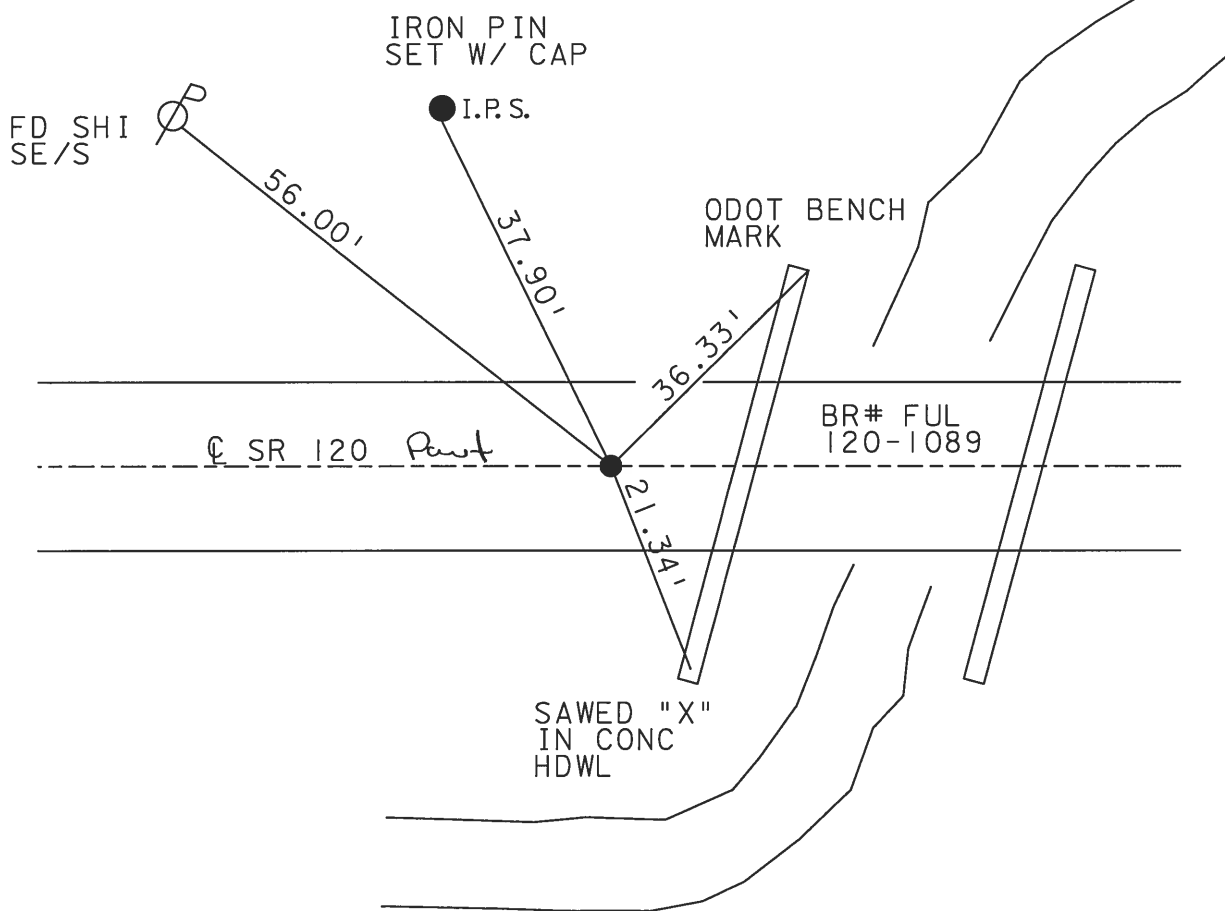

O.D.O.T. DISTRICT 2 SURVEY OFFICE

PERSONNEL _____

REFERENCE NO. 15-1A

SHEET 7 OF _____

NOTES 1. Stone

H.C. D. Curtis

R.C. J. Householder

DATE 18 April 91

WEATHER Cool

TEMP. 49°

ROUTE SR #120

COUNTY Fulton

TOWNSHIP Ambury

SECTION 8

T _____ R _____

TYPE MONUMENT PK Nail

ON SURFACE - BELOW Surface

~~LEFT~~ - & PAV'T. - RIGHT Yes

10.4 to Lt EDGE PAVEMENT

S.L.M. 574+50

Set P.K./WASHER
3-18-92

